



BENCHMARK:
HOOVER ROAD AND 35TH STREET SOUTH
CITY OF WICHITA - BENCHMARK DISC.
NE CORNER OF DECK ON R.C.B.C. ON
35TH ST. S., 100.00 FEET WEST OF HOOVER RD.
ELEV. = 1297.24 NGVD29

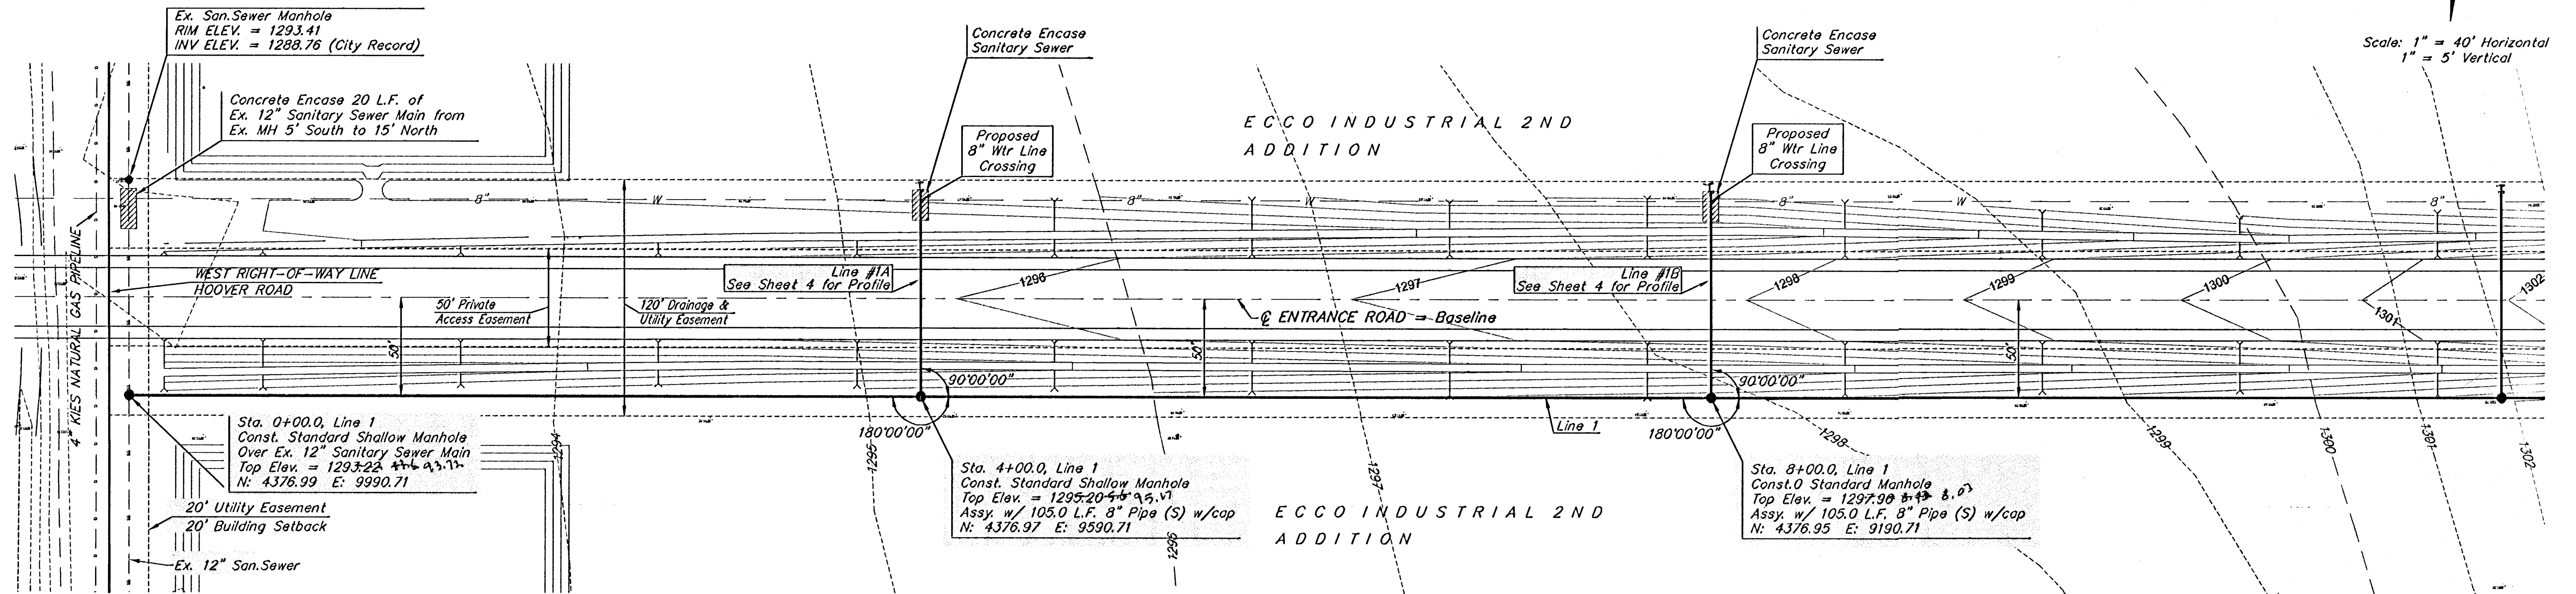


As Built 3/12/07 KR

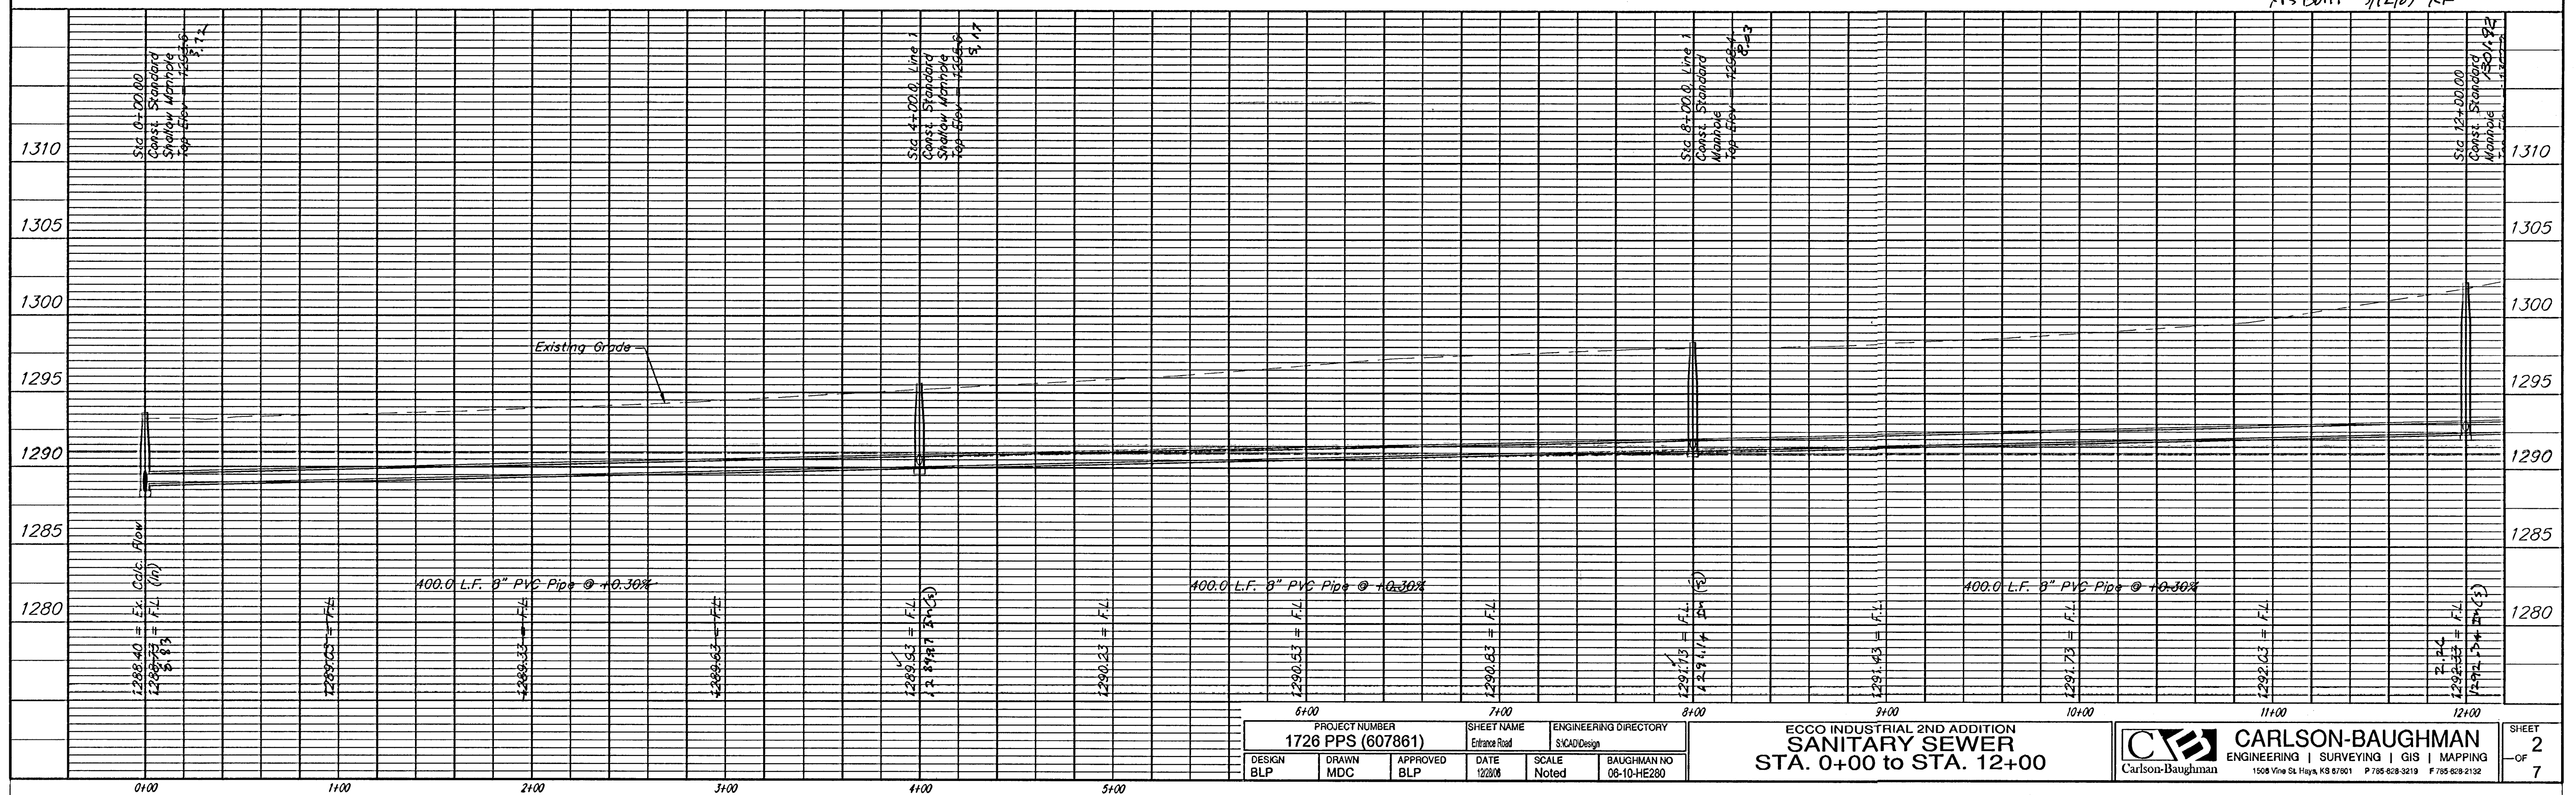

PROJECT NUMBER 1726 PPS (607861)			SHEET NAME Entrance Road		ENGINEERING DIRECTORY SICAD Design	
DESIGN BLP	DRAWN MDC	APPROVED BLP	DATE 12/28/08	SCALE Noted	BAUGHMAN NO 08-10-HE280	

ECCO INDUSTRIAL 2ND ADDITION
SANITARY SEWER
STA. 0+00 to STA. 12+00

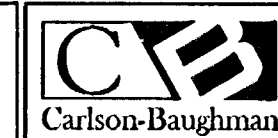

CARLSON-BAUGHMAN
ENGINEERING | SURVEYING | GIS | MAPPING
1508 Vine St. Hwy. 103 67061 P 785-629-3219 F 785-629-2132

SHEET
2
OF
7