



BENCHMARK:
HOOVER ROAD AND 35TH STREET SOUTH
CITY OF WICHITA - BENCHMARK DISC.
NE CORNER OF DECK ON R.C.B.C. ON
35TH ST. S., 100.00 FEET WEST OF HOOVER RD.
ELEV. = 1297.24 NGVD29

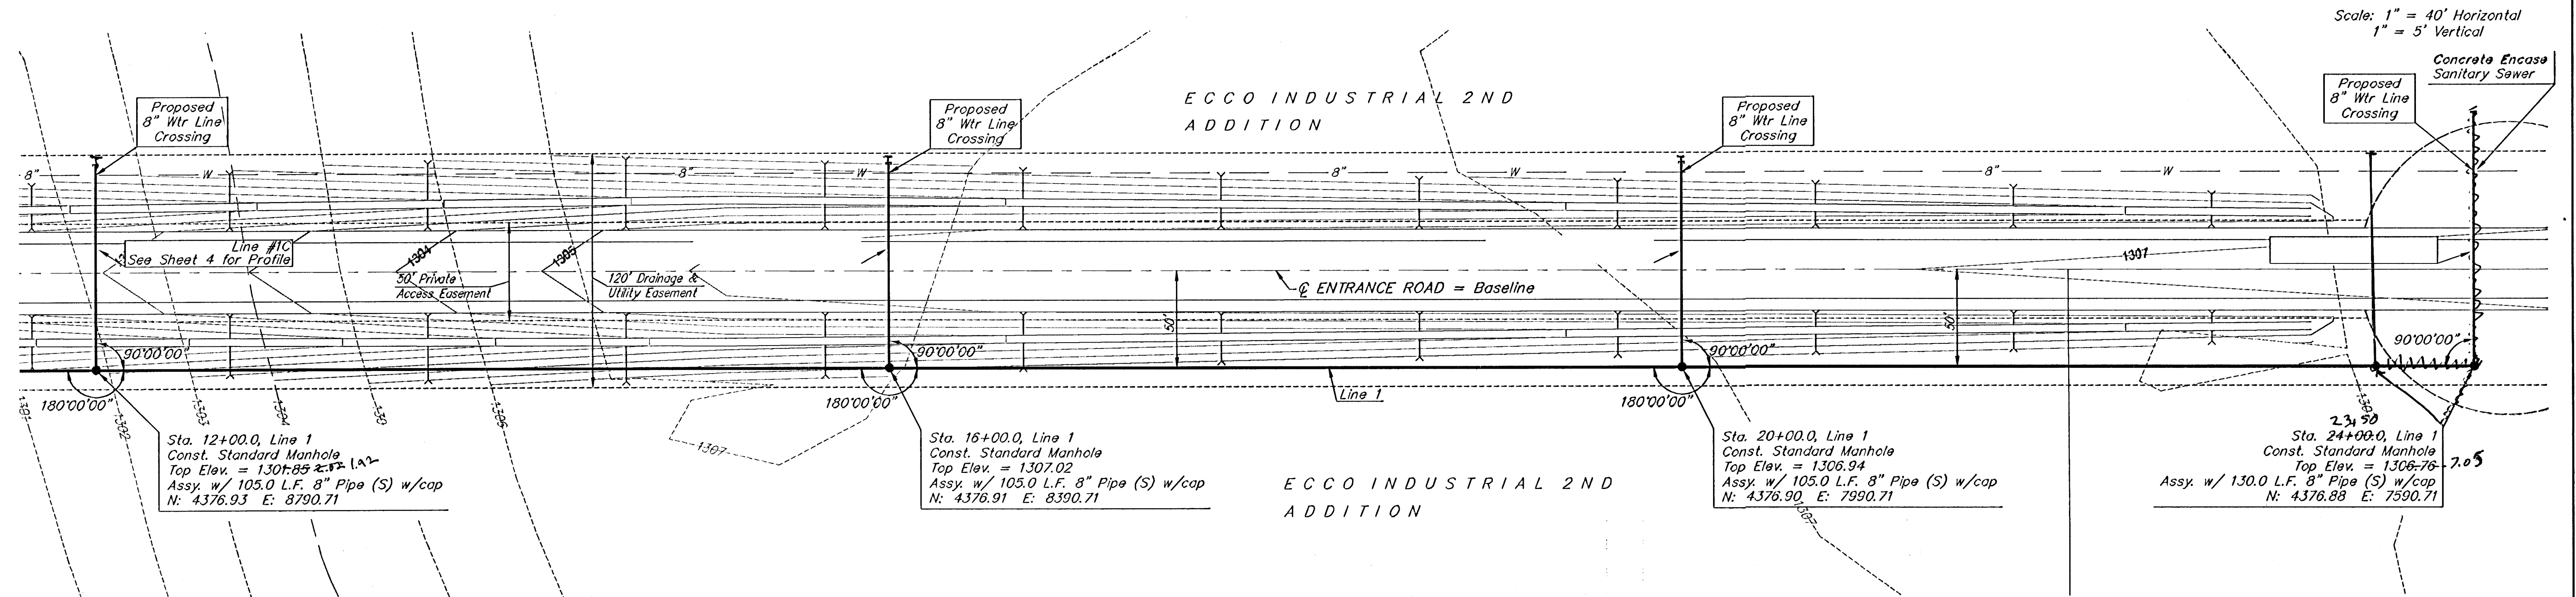

Scale: 1" = 40' Horizontal
1" = 5' Vertical

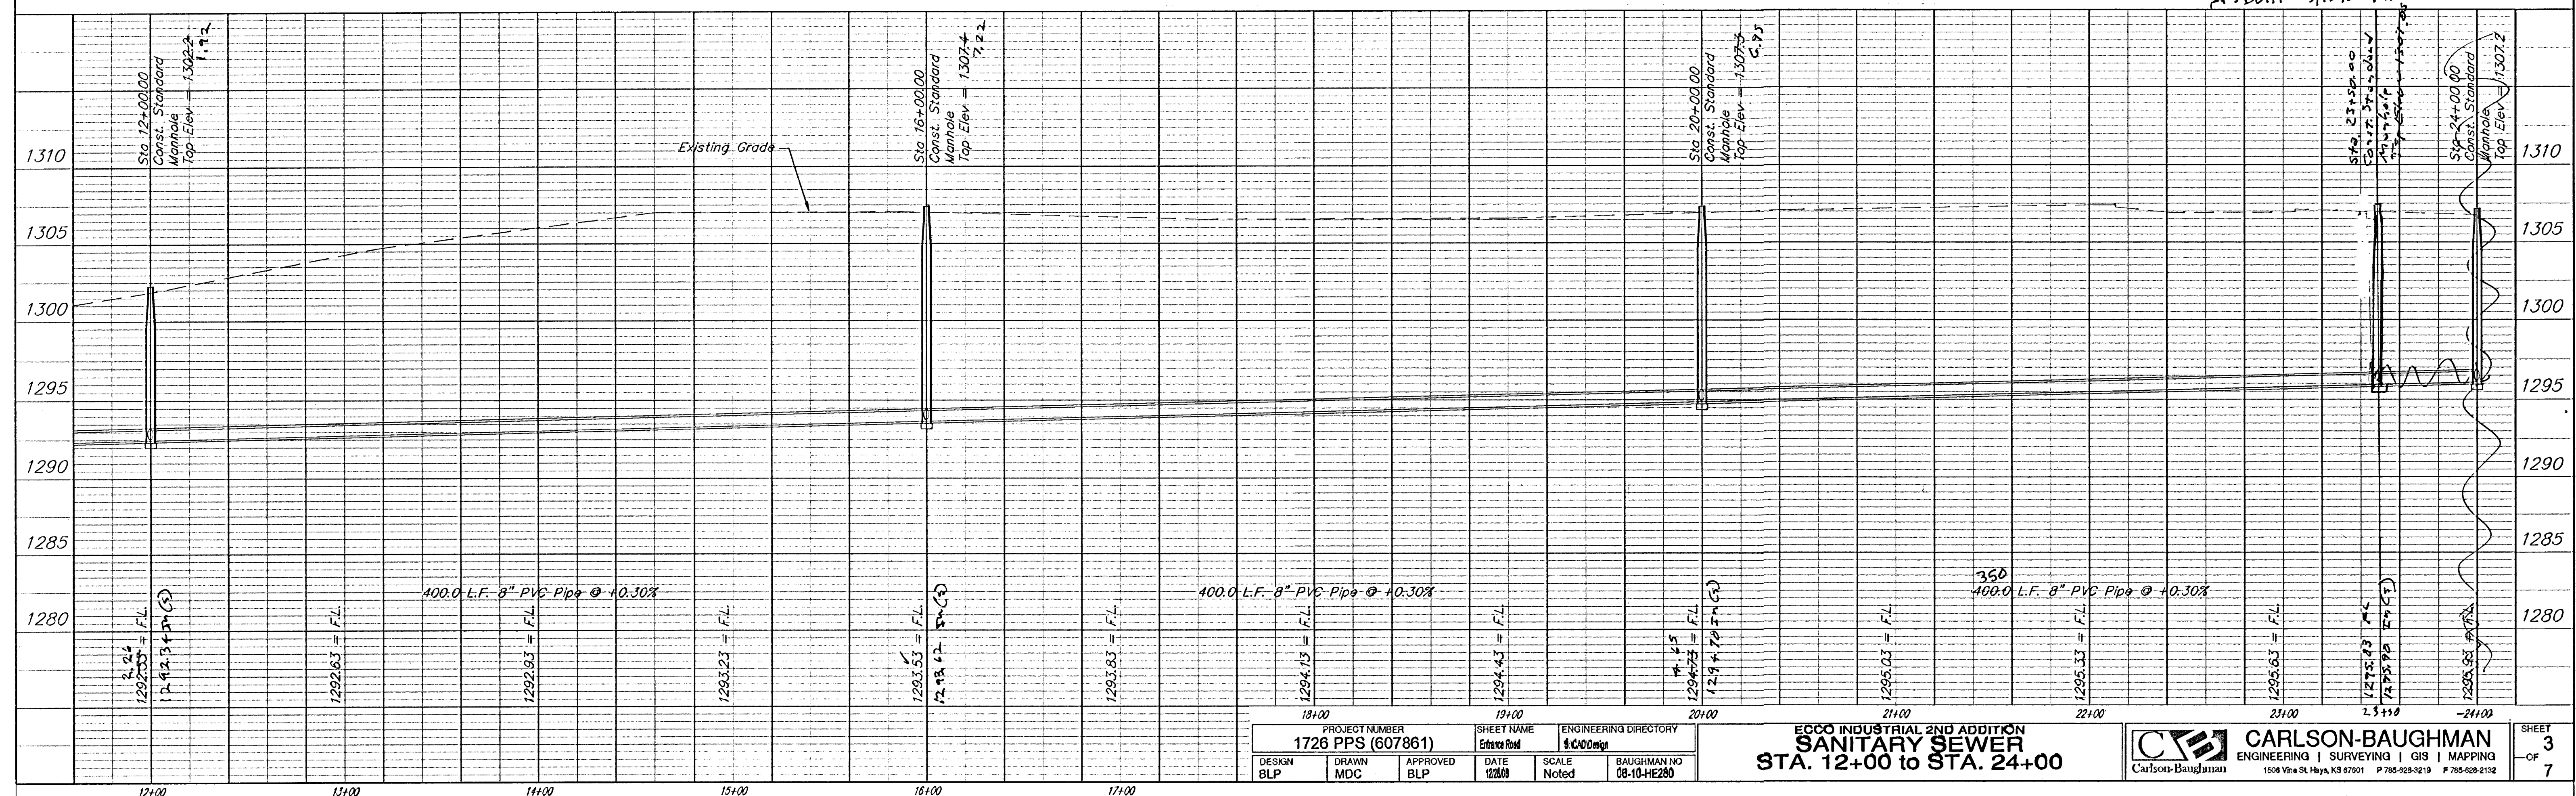

As Built 3/12/07

PROJECT NUMBER 1726 PPS (607861)			SHEET NAME Entrance Road		ENGINEERING DIRECTORY KAC/Design	
DESIGN BLP	DRAWN MDC	APPROVED BLP	DATE 12/26/08	SCALE Noted	BAUGHMAN NO 08-10-HE280	

ECCO INDUSTRIAL 2ND ADDITION
SANITARY SEWER
STA. 12+00 to STA. 24+00

CARLSON-BAUGHMAN
ENGINEERING | SURVEYING | GIS | MAPPING
1506 W. 1st St., Suite 101, P.O. Box 219, P.O. Box 219, P.O. Box 219

SHEET
3
OF
7