

GENERAL NOTES

- UNLESS SHOWN OR STATED OTHERWISE ON THESE DRAWINGS, MATERIALS AND CONSTRUCTION SHALL BE IN ACCORDANCE WITH CITY OF WICHITA STANDARD SPECIFICATIONS.
- CONTRACTOR WILL BE REQUIRED TO PROVIDE A MINIMUM ADVANCE NOTICE OF SEVENTY-TWO (72) HOURS TO UTILITY COMPANIES PRIOR TO STARTING ANY EXCAVATION AS FOLLOWS:

KANSAS ONE-CALL 1-800-344-7233
or 687-2470 (LOCAL WICHITA)

THE CONTRACTOR MUST NOTIFY THE FOLLOWING IN CASE OF AN EMERGENCY:


SBC (TELEPHONE) 800-870-8390
COX COMMUNICATIONS (CABLE) 262-0661
KANSAS GAS SERVICE (GAS) 832-3101
CITY OF WICHITA WATER & SEWER 262-6000
WESTAR (ELECTRIC) 261-6734
AQUILA (GAS) 800-303-0357

- THE CONTRACTOR SHALL BE RESPONSIBLE FOR PRESERVING PROPERTY IRONS. THE CONTRACTOR WILL BE REQUIRED TO RE-ESTABLISH ANY PROPERTY IRONS WHICH ARE DAMAGED OR DESTROYED BY HIS CONSTRUCTION OPERATIONS. SUCH IRONS SHALL BE RE-ESTABLISHED BY A LICENSED LAND SURVEYOR IN ACCORDANCE WITH STATE LAWS.
- EXISTING UTILITIES AND THEIR LOCATIONS, AS SHOWN ON THE PLANS, REPRESENT THE BEST INFORMATION OBTAINABLE FOR DESIGN. LOCATION INFORMATION HAS BEEN OBTAINED FROM THE VARIOUS UTILITY COMPANIES AND IS EITHER FROM COMPANY RECORD DRAWINGS OR COMPANY PROVIDED FIELD LOCATIONS. THE SALVATION ARMY'S RECORDS REGARDING EXISTING UTILITIES AND THEIR LOCATIONS HAVE ALSO BEEN INCORPORATED INTO THE PLANS. THE PLAN LOCATIONS SHOWN ARE NOT GUARANTEED. ADDITIONAL EXISTING UTILITIES MAY ALSO BE ENCOUNTERED.
- RUBBLE FROM THE REMOVAL OF MISCELLANEOUS STRUCTURES AND EXCESS EXCAVATION WHICH IS TO BE WASTED SHALL BE DISPOSED OF ON SITES TO BE PROVIDED BY THE CONTRACTOR. THESE SITES SHALL BE APPROVED BY THE ENGINEER AS TO SUITABILITY, APPEARANCE AND SITE LOCATION. LOCATIONS THAT, IN THE OPINION OF THE ENGINEER, WILL LEAVE AN UNSIGHTLY APPEARANCE WILL NOT BE APPROVED. ALL DISPOSAL SITES MUST BE APPROVED BY THE KANSAS DEPARTMENT OF HEALTH AND ENVIRONMENT. MATERIAL EITHER STOCKPILED OR DISPOSED OF IN A FLOOD PLAIN WOULD REQUIRE A KANSAS STATE BOARD OF AGRICULTURE PERMIT. ANY MATERIAL DUMPED IN WATERS OF THE UNITED STATES OR WETLANDS IS SUBJECT TO U.S. CORPS OF ENGINEERS PERMITTING REGULATIONS. ANY MATERIAL BURIED OR STOCKPILED BEYOND APPROVED CONSTRUCTION LIMITS WOULD REQUIRE ADDITIONAL ARCHAEOLOGICAL INVESTIGATIONS UNLESS BURIED IN A PREVIOUSLY APPROVED BORROW LOCATION.
- COST OF EXCAVATION, HAULING, AND DUMPING OF EXCESS EXCAVATION SHALL BE SUBSIDIARY TO THE PROJECT.
- A PORTION OF EXCESS EXCAVATED MATERIAL SHALL BE MOUNDED AROUND MANHOLES WHICH EXTEND MORE THAN ONE (1) FOOT ABOVE THE EXISTING GROUND. SUCH MOUNDS SHALL BE CONSTRUCTED WITH A SIX (6) FOOT DIAMETER FLAT TOP WITH 4 TO 1 SIDE SLOPES DOWN TO THE ORIGINAL GROUND. THE ELEVATION OF THE FLAT TOP OF THE MOUND SHALL BE 0.4 FOOT BELOW THE TOP OF THE MANHOLE.
- ALL STUBS AND PLUGGED PIPES SHALL BE LOCATED WITH GREEN PLASTIC TAPE IN THE SAME MANNER AS RISERS.
- CONNECTING TO EXISTING MANHOLES:
PRIOR TO LAYING SEWER LINES USING EXISTING STUBS IN EXISTING MANHOLES, THE CONTRACTOR SHALL EXPOSE AND VERIFY THE ELEVATION, GRADE AND ALIGNMENT OF EXISTING STUBS AND NOTIFY THE ENGINEER OF ANY DEVIATION FROM THE PLAN. WHERE CONNECTION TO AN EXISTING MANHOLE THAT DOES NOT HAVE AN EXISTING STUB OR THE STUB IS UNUSABLE DUE TO ELEVATION GRADE OR ALIGNMENT, THE CONTRACTOR SHALL BORE CUT INTO EXISTING MANHOLE WALL TO MAKE CONNECTION USING APPROVED WATER STOP GASKET, AND RESHAPE THE EXISTING MANHOLE INVERT TO PROVIDE SMOOTH FLOW. THE COST OF CONNECTING TO EXISTING MANHOLES IS INCIDENTAL TO THE PROJECT.
- TREES AND SHRUBS IN PUBLIC RIGHT-OF-WAY WHICH ARE IN DIRECT CONFLICT WITH PROPOSED NEW CONSTRUCTION SHALL BE REMOVED BY THE CONTRACTOR WITH THE ENGINEER'S APPROVAL. TREES AND SHRUBS WHICH ARE NOT IN DIRECT CONFLICT WITH PROPOSED NEW CONSTRUCTION SHALL BE SAVED AND PROTECTED FROM DAMAGE.
- ALL AREAS DISTURBED BY CONSTRUCTION OF THE PROPOSED IMPROVEMENTS SHALL BE RESTORED WITH THE SAME GRASS/SOD AS EXISTING. RESTORATION OF DISTURBED AREAS SHALL INCLUDE, BUT BE LIMITED TO, TOP SOIL PREPARATION, SEEDING, MULCH AND/OR RESEEDING. ALL COSTS FOR THIS WORK SHALL BE SUBSIDIARY TO THE LUMP SUM PRICE FOR "SITE CLEARING AND RESTORATION".
- CONTRACTOR SHALL COORDINATE ALL WORK, INCLUDING IRRIGATION REPAIRS, WITH OWNER'S REPRESENTATIVE. CONTACT RON WHITE AT 641-5535. IRRIGATION REPAIR AND/OR REPLACEMENT SHALL BE SUBSIDIARY TO SITE CLEARING AND RESTORATION.
- THE CONTRACTOR SHALL PROVIDE TRENCH DEWATERING AS REQUIRED TO CONSTRUCT THE SANITARY SEWER. THE OWNER'S GEOTECHNICAL ENGINEER ENCOUNTERED GROUND WATER AT A DEPTH OF APPROXIMATELY 18" BELOW EXISTING GRADE. THE CONTRACTOR IS REFERRED TO THE GEOTECHNICAL REPORT FOR FURTHER INFORMATION.
- TREES TO BE REMOVED ARE MARKED WITH AN 'X'. ALL TREES WHICH, IN THE OPINION OF THE FIELD ENGINEER CAN BE SAVED, SHALL BE SAVED.
- THE SANITARY SEWER MAIN SHALL BE TELEVIEWED AND AIR TESTED PRIOR TO MAKING ANY SERVICE CONNECTIONS TO THE NEW MAIN.
- THE CONTRACTOR SHALL OBTAIN A SEWER SERVICE CONNECTION PERMIT FROM THE CITY OF WICHITA OFFICE OF CENTRAL INSPECTION PRIOR TO MAKING ANY SERVICE CONNECTIONS TO THE SANITARY SEWER MAIN. CONTACT BETTY ROARK AT 268-4341.
- ALL EXISTING SERVICE LINES TO REMAIN IN PLACE AND BE CONNECTED TO THE NEW SANITARY SEWER MAIN SHALL REQUIRE TV INSPECTION AND ACCEPTANCE BY THE CITY OF WICHITA OFFICE OF CENTRAL INSPECTION PRIOR TO CONNECTION BEING MADE.
- SANITARY SEWER SERVICES SHALL BE INSTALLED BY A LICENSED DRAIN LAYER.

PRIVATE SANITARY SEWER PLANS FOR SALVATION ARMY - HIAWATHA CAMPUS LOT 1, BLOCK 1 CAMP HIAWATHA ADDITION

CITY OF WICHITA, KANSAS
JAMES L. ARMOUR, CITY ENGINEER

PROJECT NO. 1724 PPS
OCA 607861

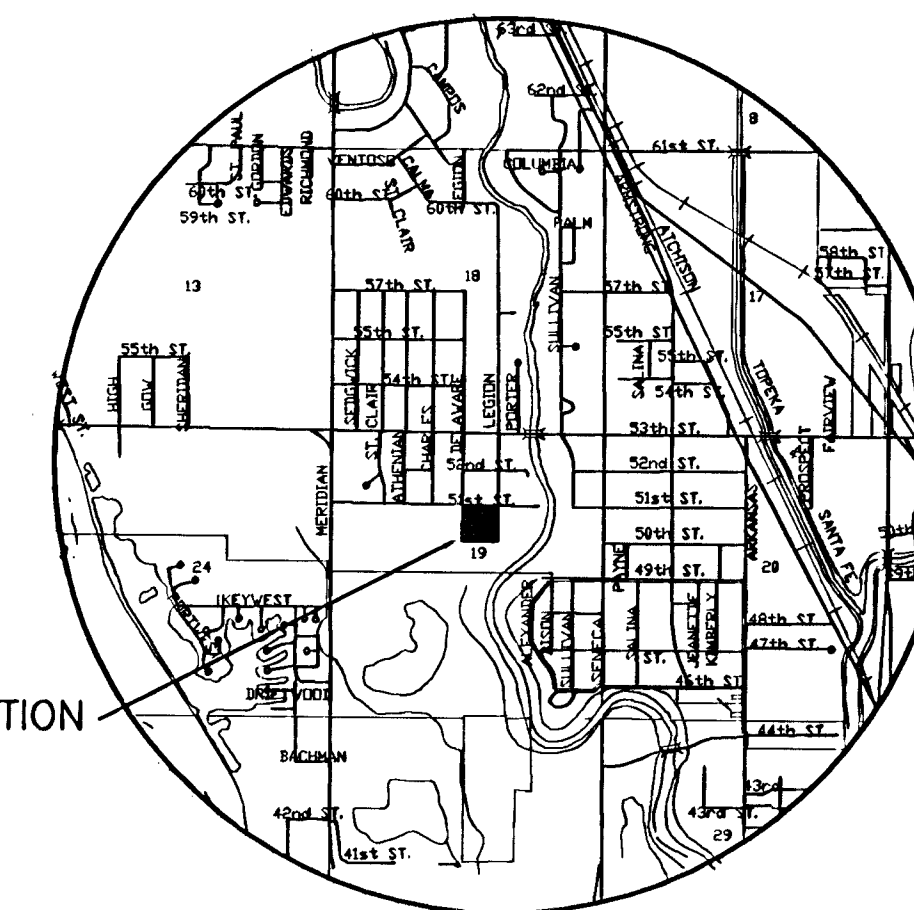

SITE LOCATION

LOCATION MAP

INDEX TO DRAWINGS

SHEET NO.	DESCRIPTION
1	TITLE SHEET
2	MANHOLE DETAILS
3	REMOVAL PLAN
4	SANITARY SEWER SERVICE
5-6	LINE 1
7	BUBBLE MAP
8-9	EROSION CONTROL DETAILS
10	FINAL PLAT

BENCHMARKS


- BM #1 PK Nail and Washer at the Intersection of Delaware and 51st Street North. 3 feet north of the south edge of 51st Street. ELEV.= 143.86'
- BM #2 PK Nail and Washer at the southeast side of Legion and 51st Street North. 3 feet north of the south edge of 51st. ELEV.= 141.44'
- BM #3 RR Spike SE face of power pole at northwest corner of Legion and 51st Street North. ELEV.= 142.39'

APPROVED AS NOTED
BY CITY ENGINEER OF WICHITA

SANITARY SEWERS VRH 3/7/07

NOTE TO CONTRACTOR

INSPECTION AND TESTING FOR THIS PROJECT IS TO BE PROVIDED BY A LICENSED CONSULTING ENGINEERING FIRM UNDER CONTRACT WITH THE OWNER/DEVELOPER. SAID INSPECTION TO BE IN ACCORDANCE WITH THE CITY OF WICHITA STANDARD CONSTRUCTION ENGINEERING PRACTICES AND CERTIFIED BY A LICENSED PROFESSIONAL ENGINEER. NO WORK SHALL BE PERFORMED IN DEDICATED EASEMENTS OR THE PUBLIC RIGHT-OF-WAY BY THE CONTRACTOR WITHOUT SUCH INSPECTION NOR SHALL ANY WORK BE COMMENCED IN DEDICATED EASEMENTS OR PUBLIC RIGHT-OF-WAY WITHOUT WRITTEN AUTHORIZATION BY THE CITY ENGINEER.

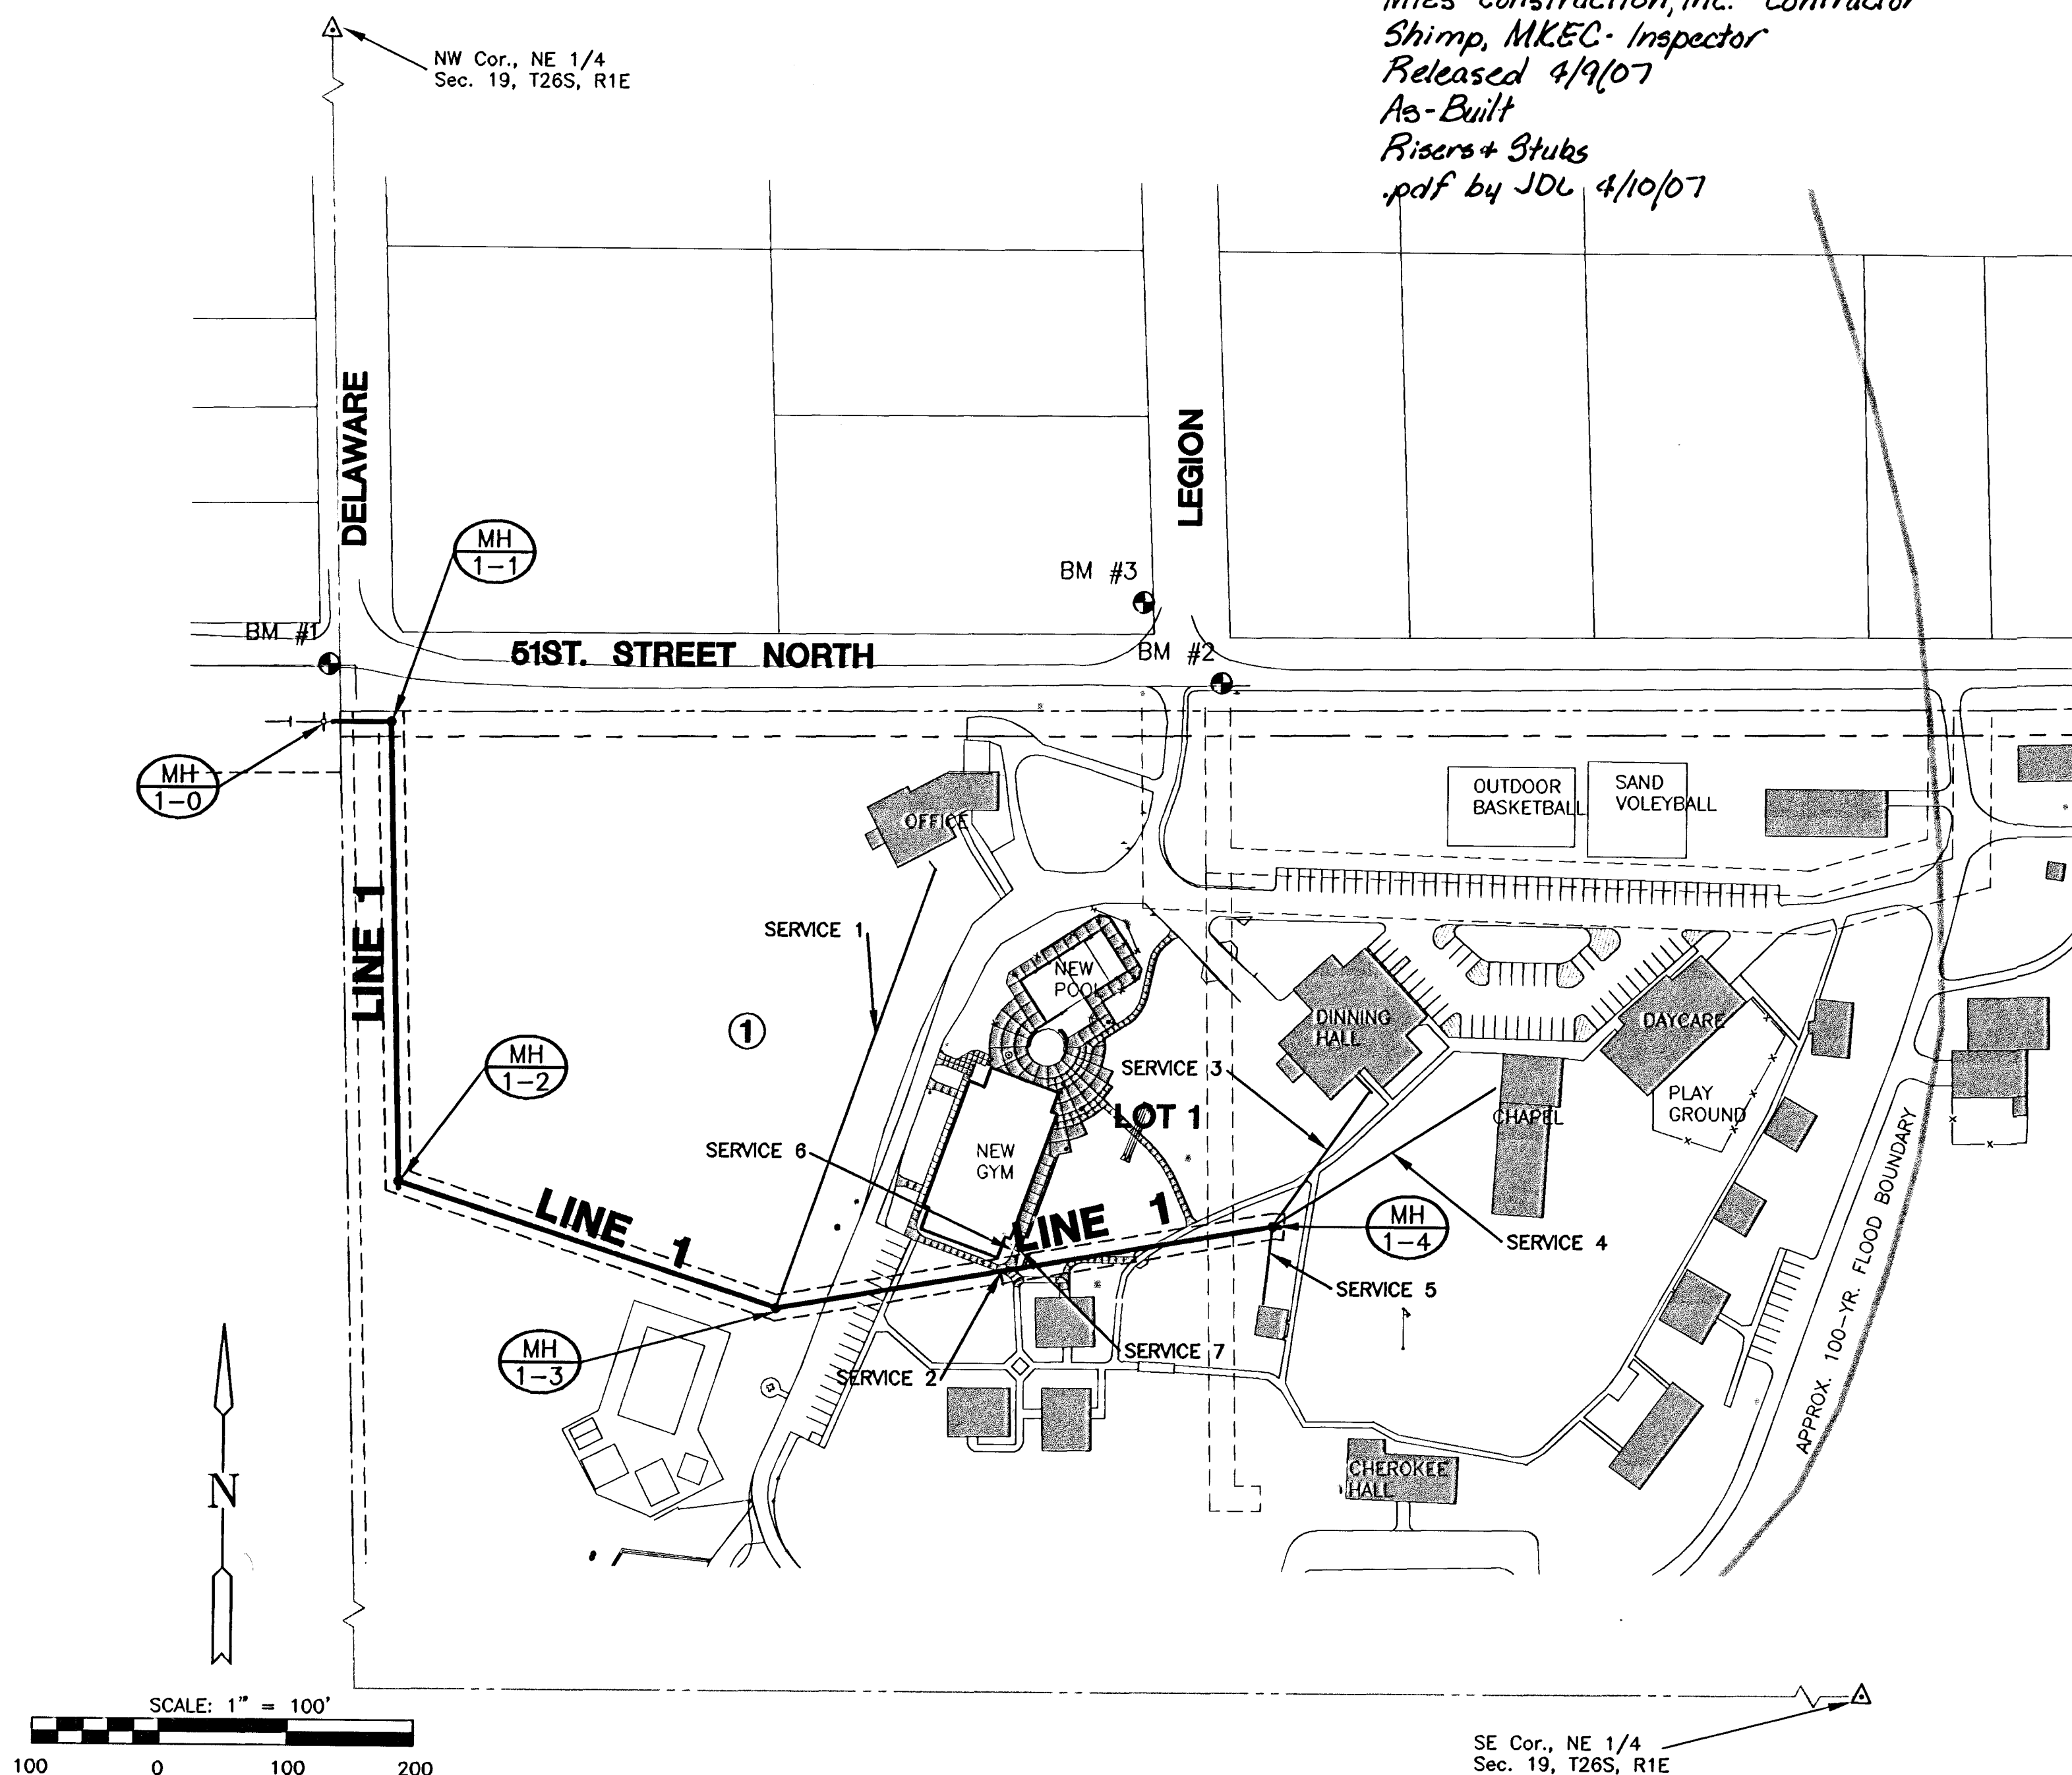

SE Cor., NE 1/4
Sec. 19, T26S, R1E

MKEC
ENGINEERING
CONSULTANTS, INC.

411 N. WEBB ROAD
WICHITA, KS. 67206
316-684-9600

SANITARY SEWER PLANS FOR
SALVATION ARMY
HIAWATHA CAMPUS

TITLE SHEET

SHEET TITLE
06635
PROJECT NUMBER

SRS / DM / MAB
DESIGNED DRAWN CHECKED

ISSUED
December 2006

REVISED

SHEET NO.

1 of 10