


PLAN LINE 1

= TREE TRIMMING

AS-BUILT APRIL 2007

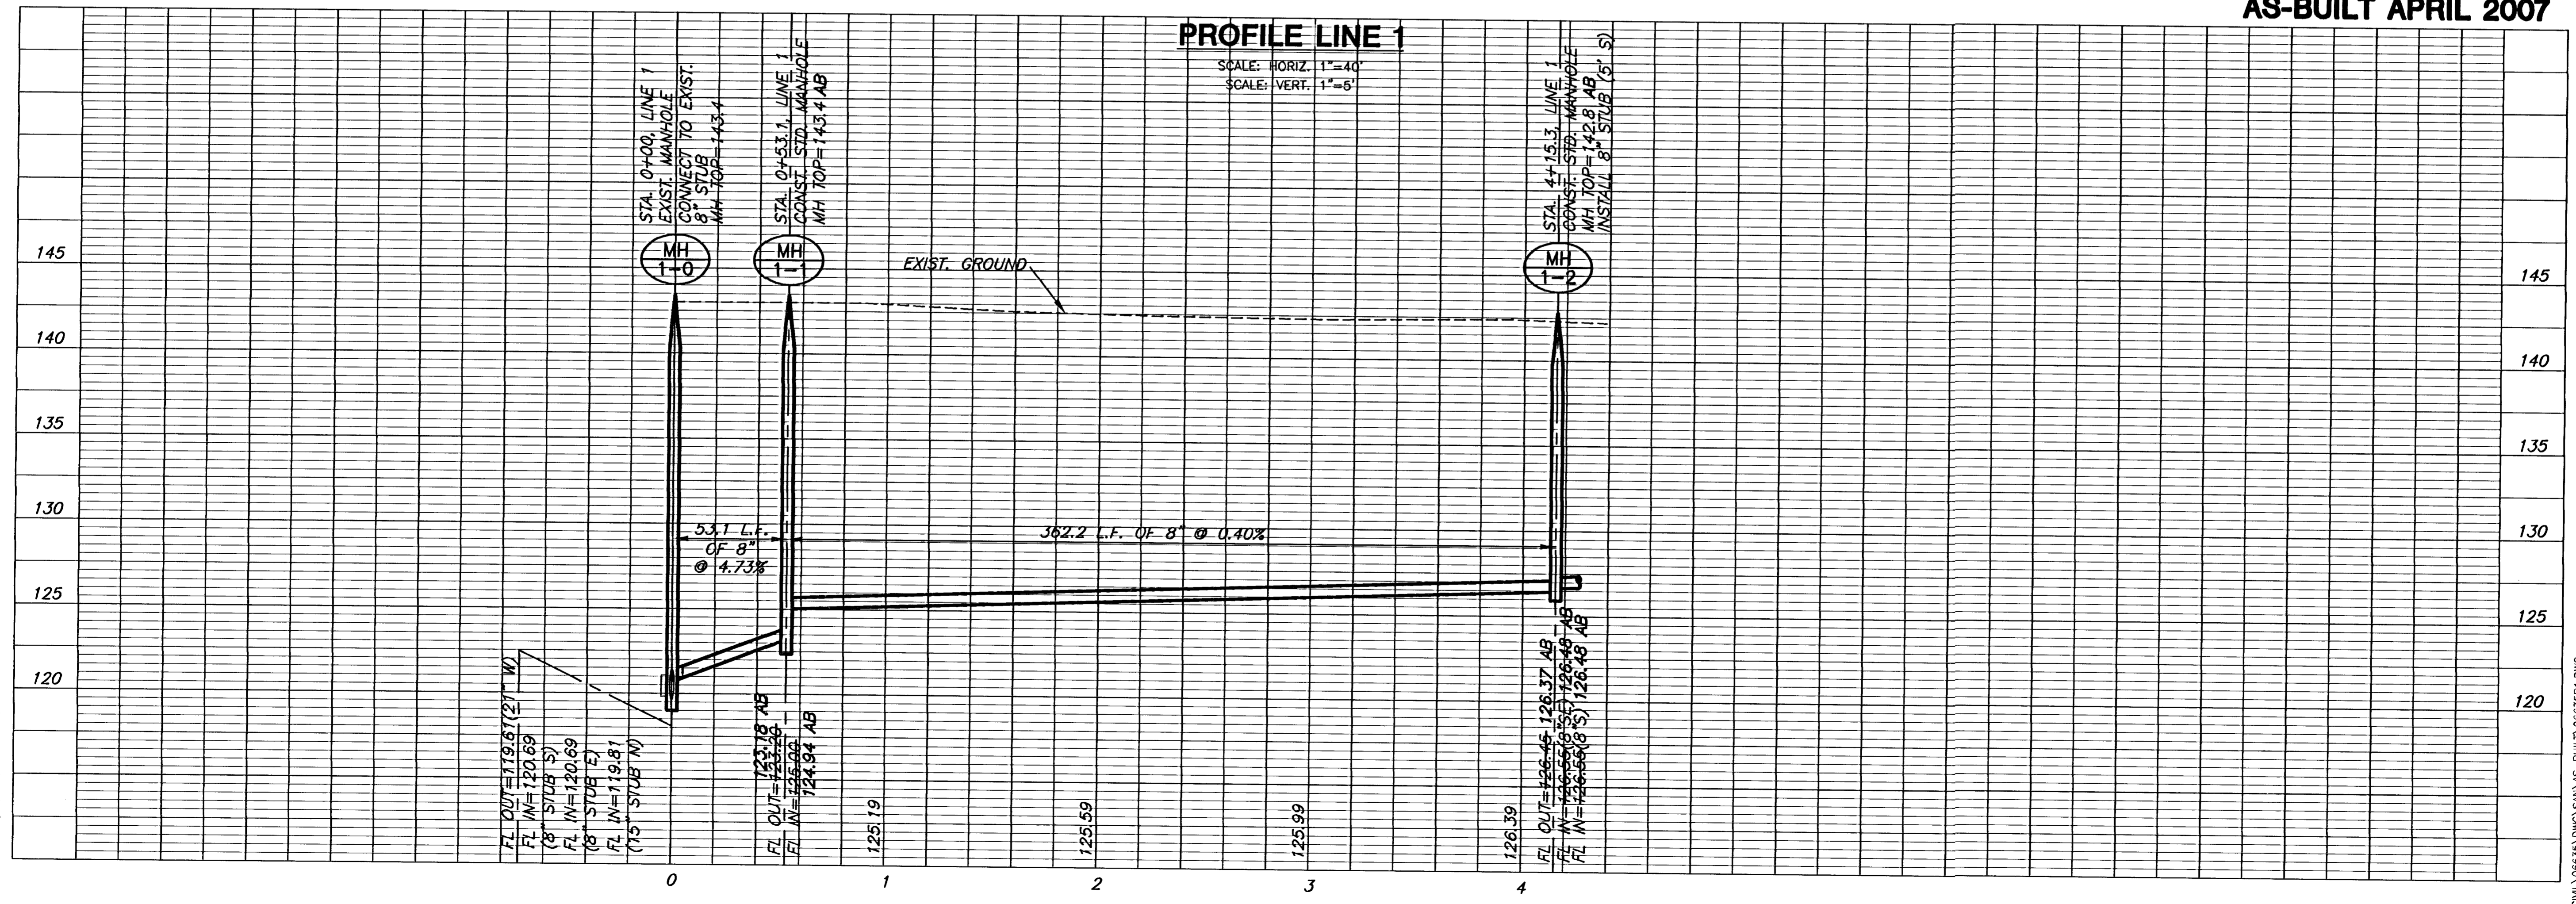

PROFILE LINE 1

SCALE: HORIZ. 1"=40'
SCALE: VERT. 1"=5'

LINE 1
SHEET TITLE
06635
PROJECT NUMBER

SRS
DESIGN BY
DM
DRAWN BY
MAB
CHECKED BY

ISSUED
December 2006
REVISED
2/28/07 PROFILE RAISE 2;
REMOVE FLOWABLE FILL

SHEET NO.
5 of 10

PLOTTED: Wednesday, April 04, 2007 @ 08:43AM

J:\CIVIL\06635\DWG\SAN\AS-BUILT\06635S1.DWG