


STA. 5+15 to STA 5+35, LINE 37  
 INSTALL 20 L.F. HDPE CASING  
 PIPE WITH RUBBER BOOT  
 SEALS AROUND WATERLINE.  
 FIELD ADJUST WATERLINE TO  
 MAINTAIN A MINIMUM OF  
 12" FROM MH.

N 1671125.77 E 1656968.33  
 STA. 7+05.73, LINE 37 =  
 STA. 8+24.37 MARION, 27.00' RT.  
 1-8" MJ BEND 11.25"  
 (TOTAL DEFLECTION 14')

Bl Station	Lt./Rt.	Service (Long or Short)	Address	As Built
4+70	Rt.	Short	1927 E MARION	
5+18	Rt.	Short	1933 E MARION	
5+69	Lt.	Long	1938 E MARION	
6+17	Lt.	Long	1948 E MARION	
6+23	Rt.	Short	1947 E MARION	← NOT FOUND WHEN SURVEYED
6+31	Lt.	Long	1952 E MARION	
7+23	Lt.	Long	1958 E MARION	

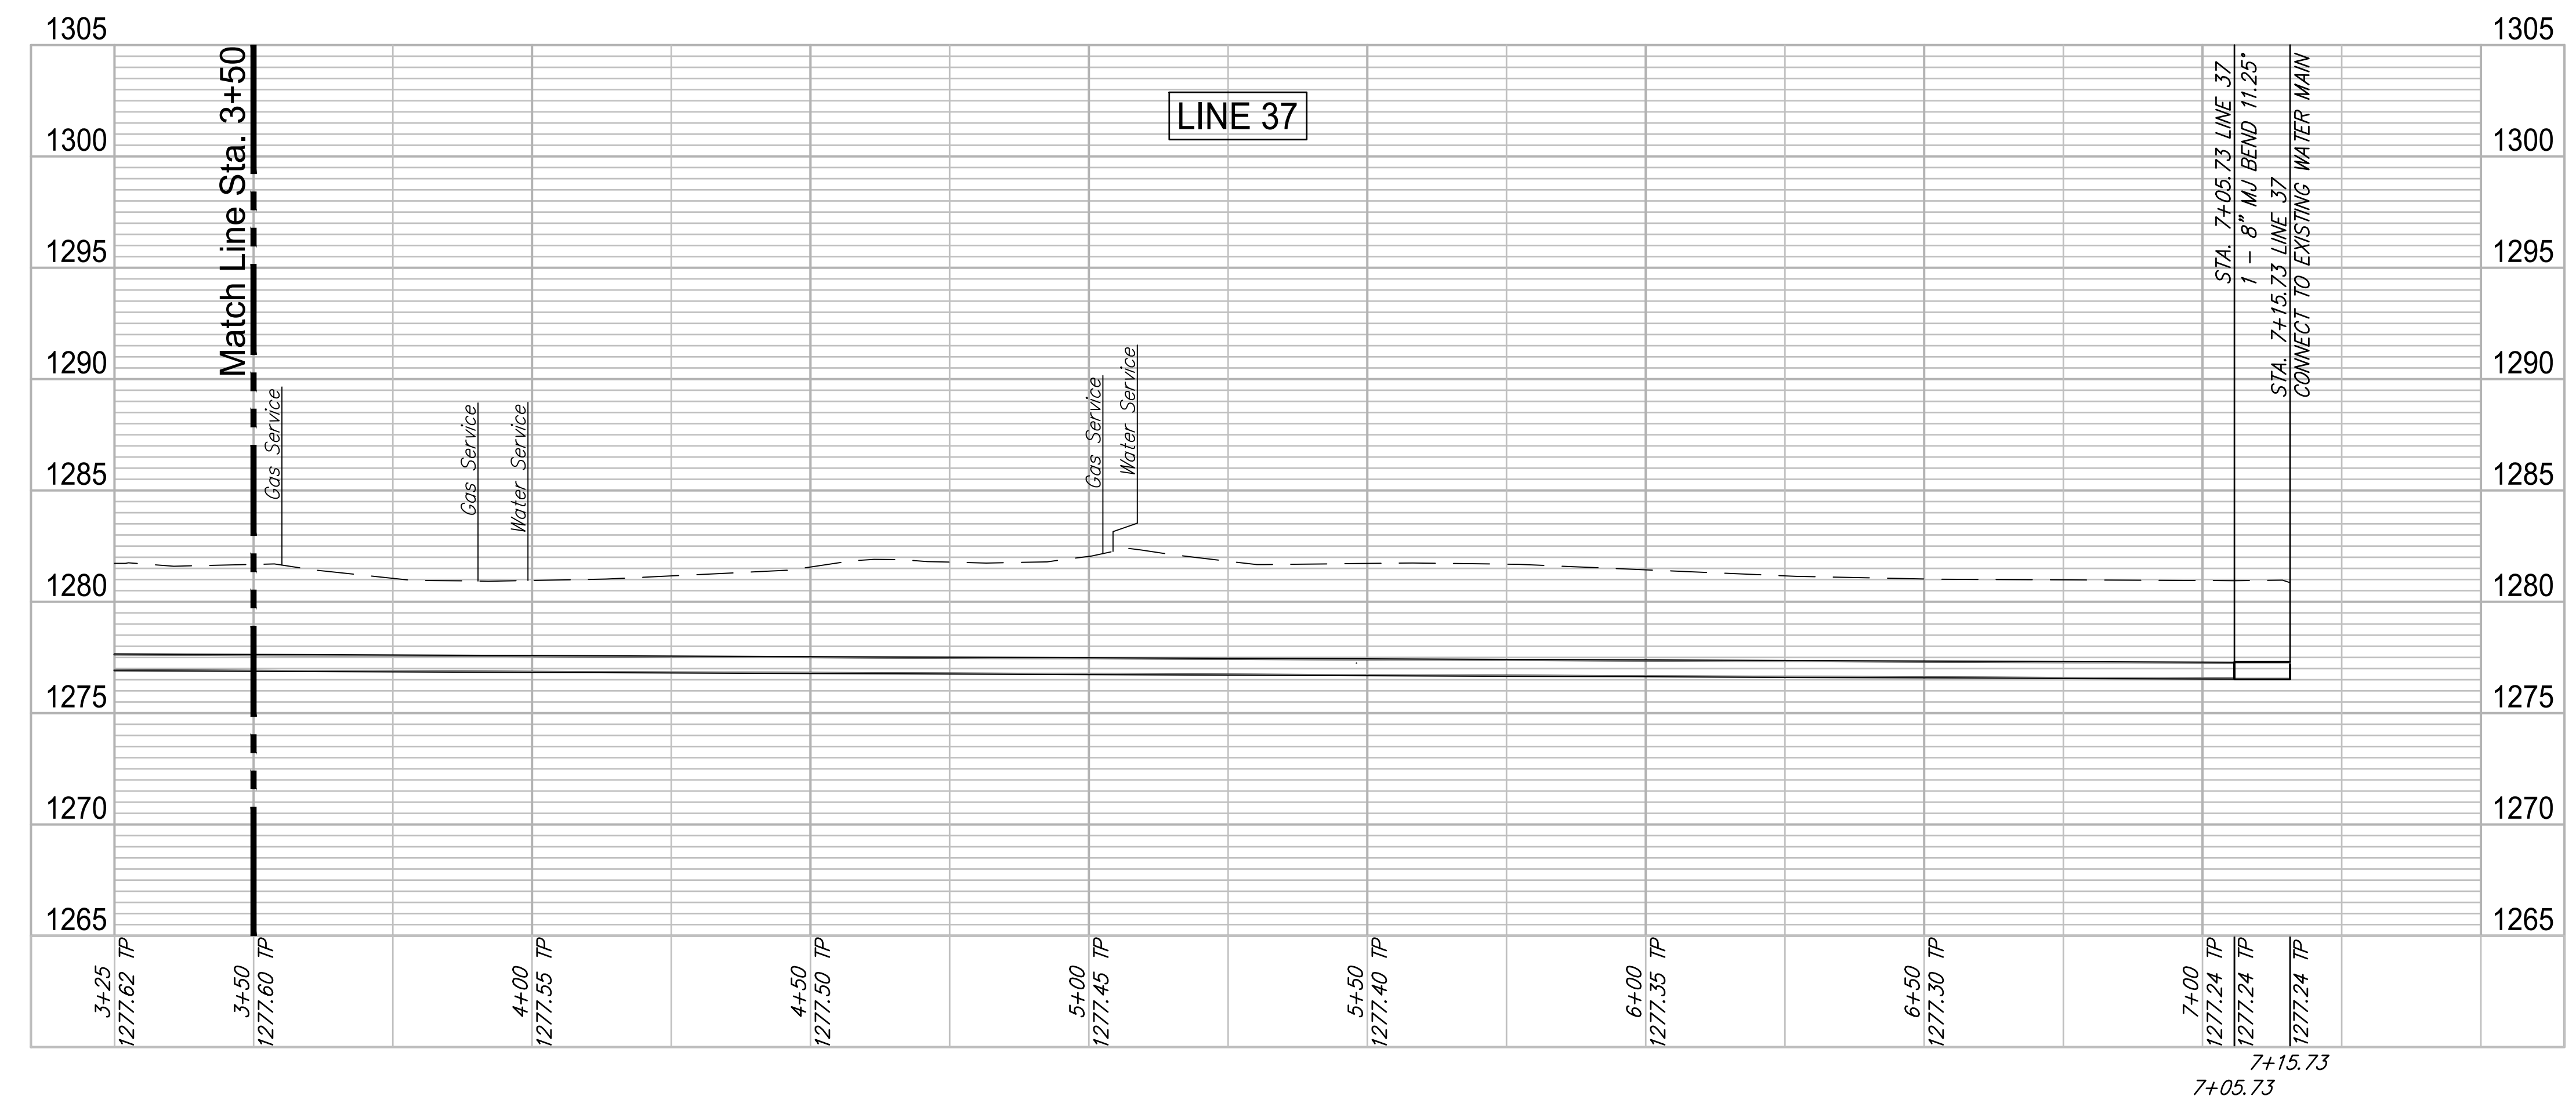

**ROSE MARIE WATER - Part B**  
**Marion - Line 37 (2 of 2)**  
 Wichita, Kansas

PROJECT NUMBER: 448-30721  
 DRAWING FILE: 4701W Engineering Base Area 1

DESIGN: CMB / RA  
 DRAWN: DRS / RA

REVIEW: 5-24-2017  
 DATE: 4/2/2018

GARVER LICENSE NO. 16264701  
 SHEET: 43 OF 53  
 © Copyright 2018, Garver