

South Seneca Gardens 4th Addition



Tree Removal Notes

1. When necessary for Sanitary Sewer construction, trees shall be completely removed.
2. Trees that are removed and trimmings from other trees shall be properly disposed of in accordance with local, state, and federal regulators.
3. Trimming of trees shall be done with suitable equipment that leaves the tree in healthy condition.

SS SS-1
N 1652455.65 E 1645599.26
STA:0+00.00, SS
CONSTRUCT DOGHOUSE MANHOLE
OVER EXISTING 8" SANITARY SEWER
D = 4.0'

SS SS-2
N 1652091.34 E 1645603.33
STA:3+64.33, SS
CONSTRUCT SHALLOW MANHOLE
D = 4.0'

South Seneca Gardens 4th Addition

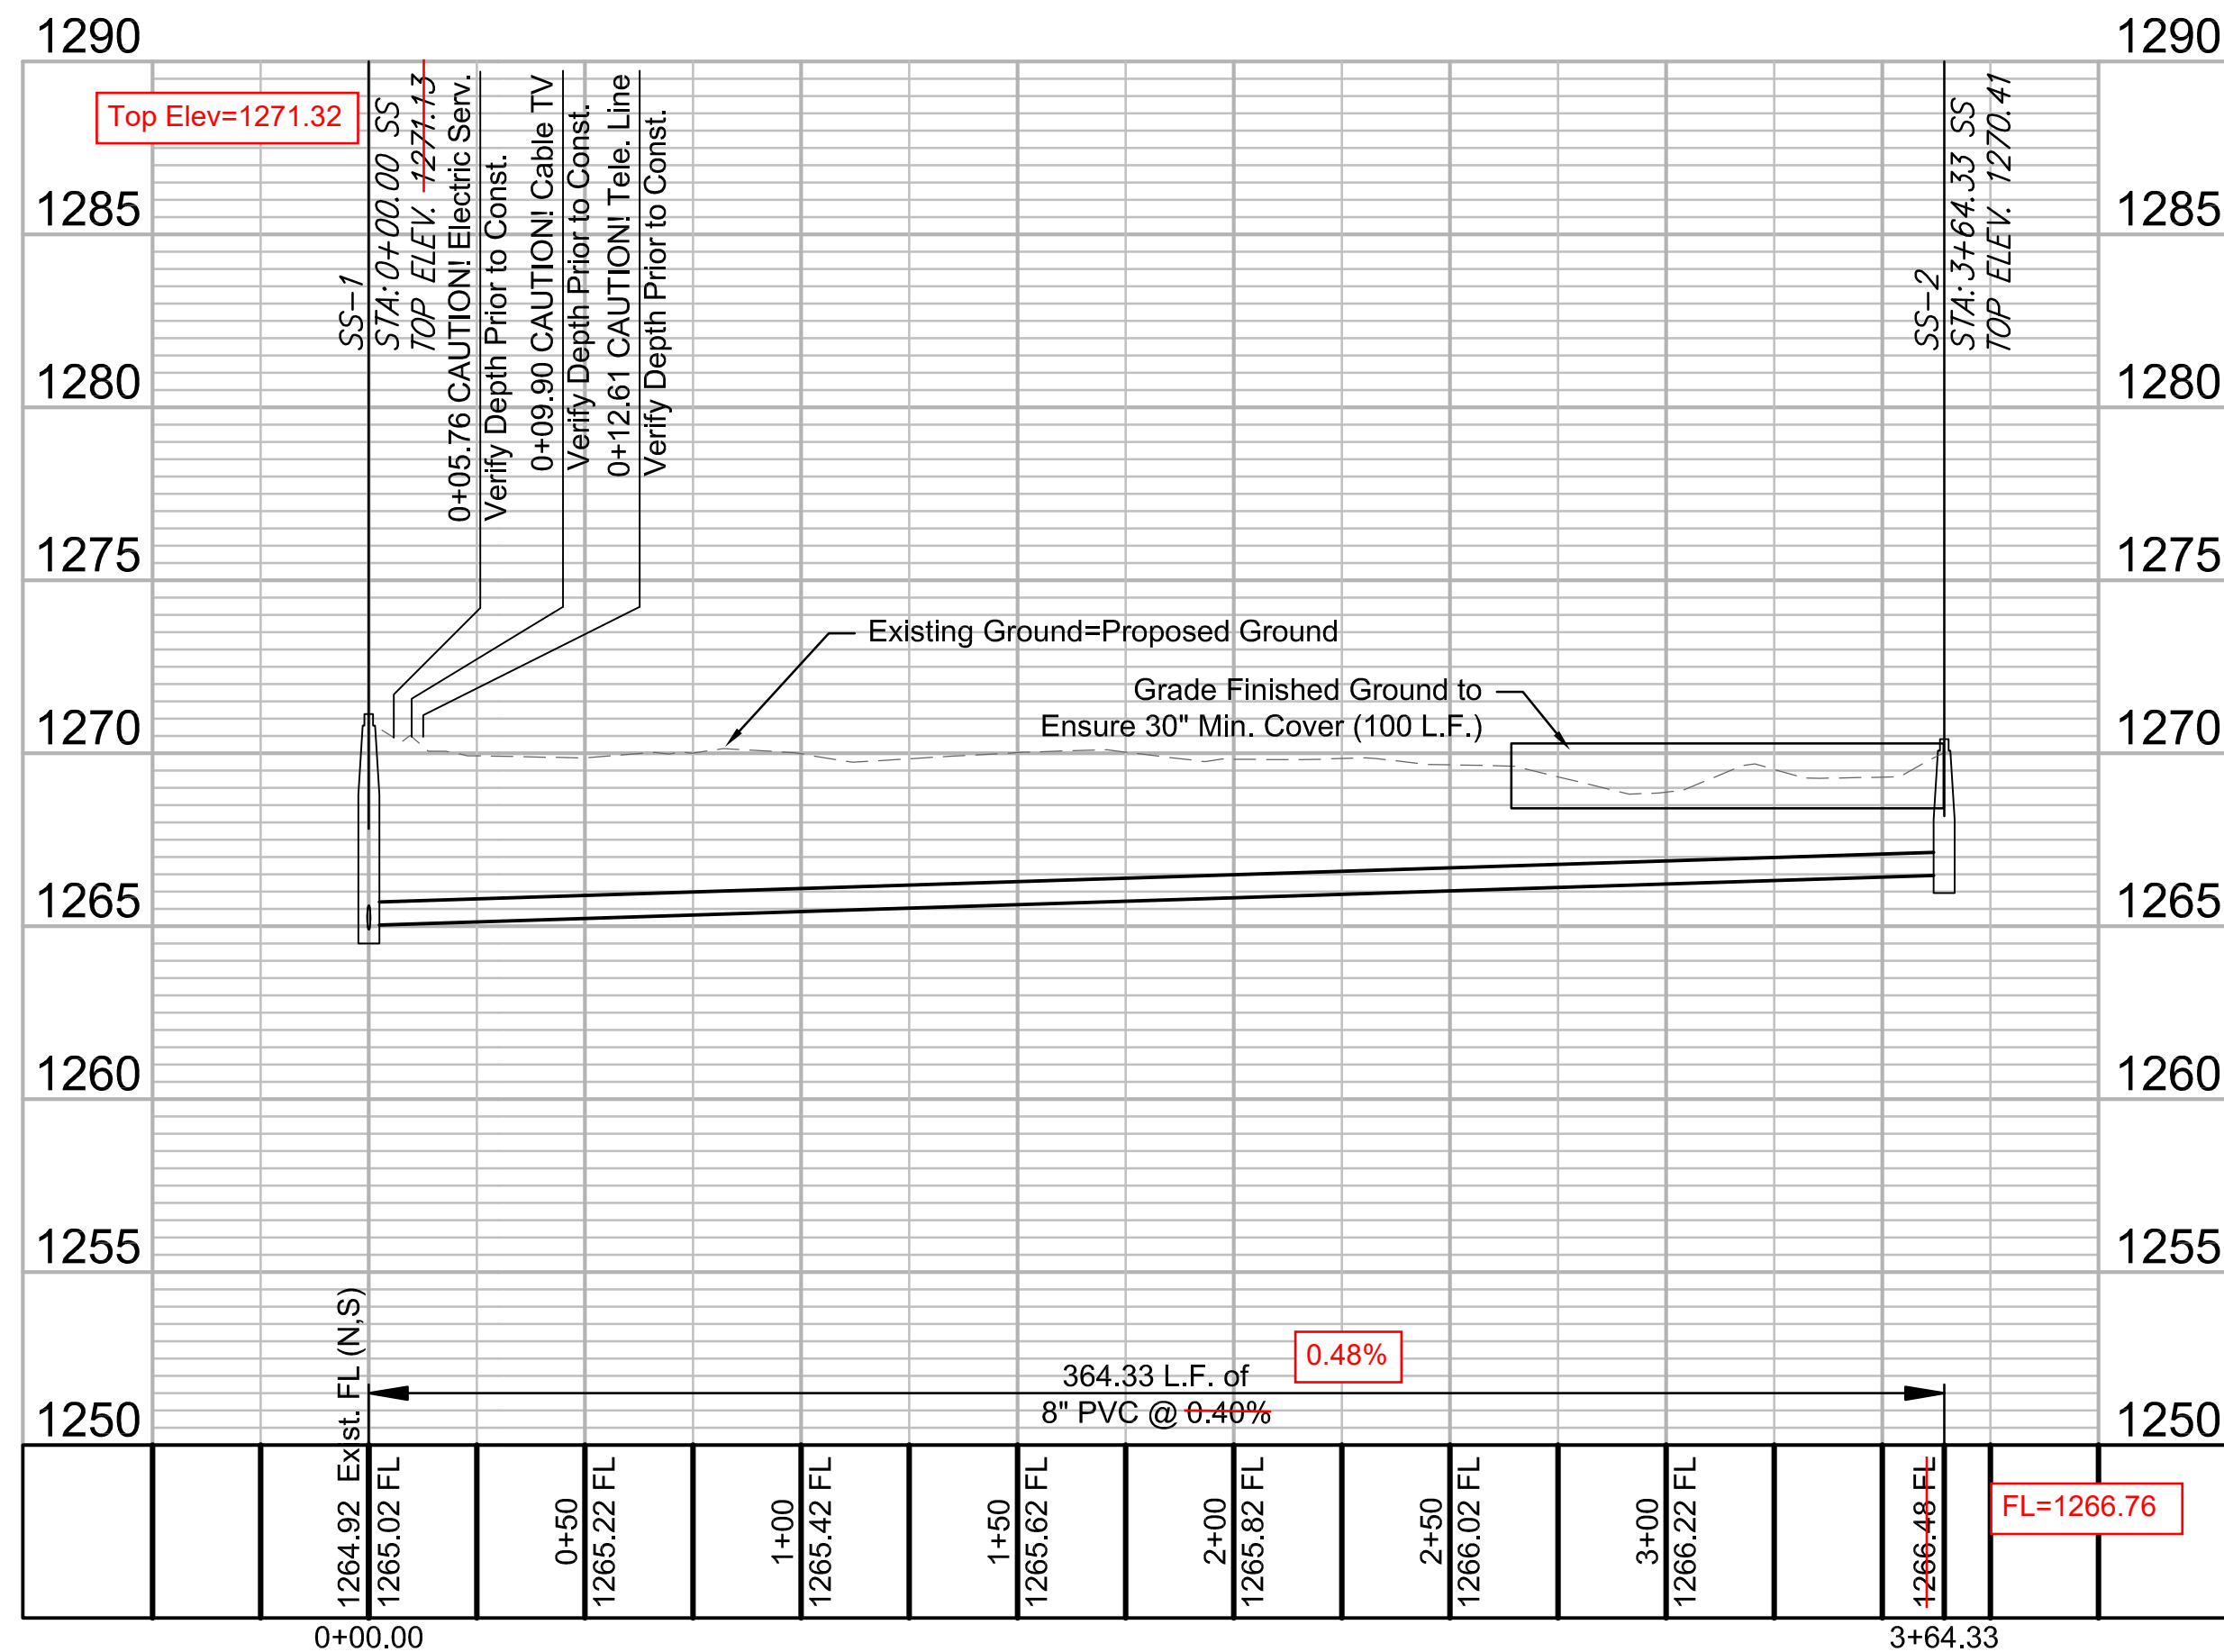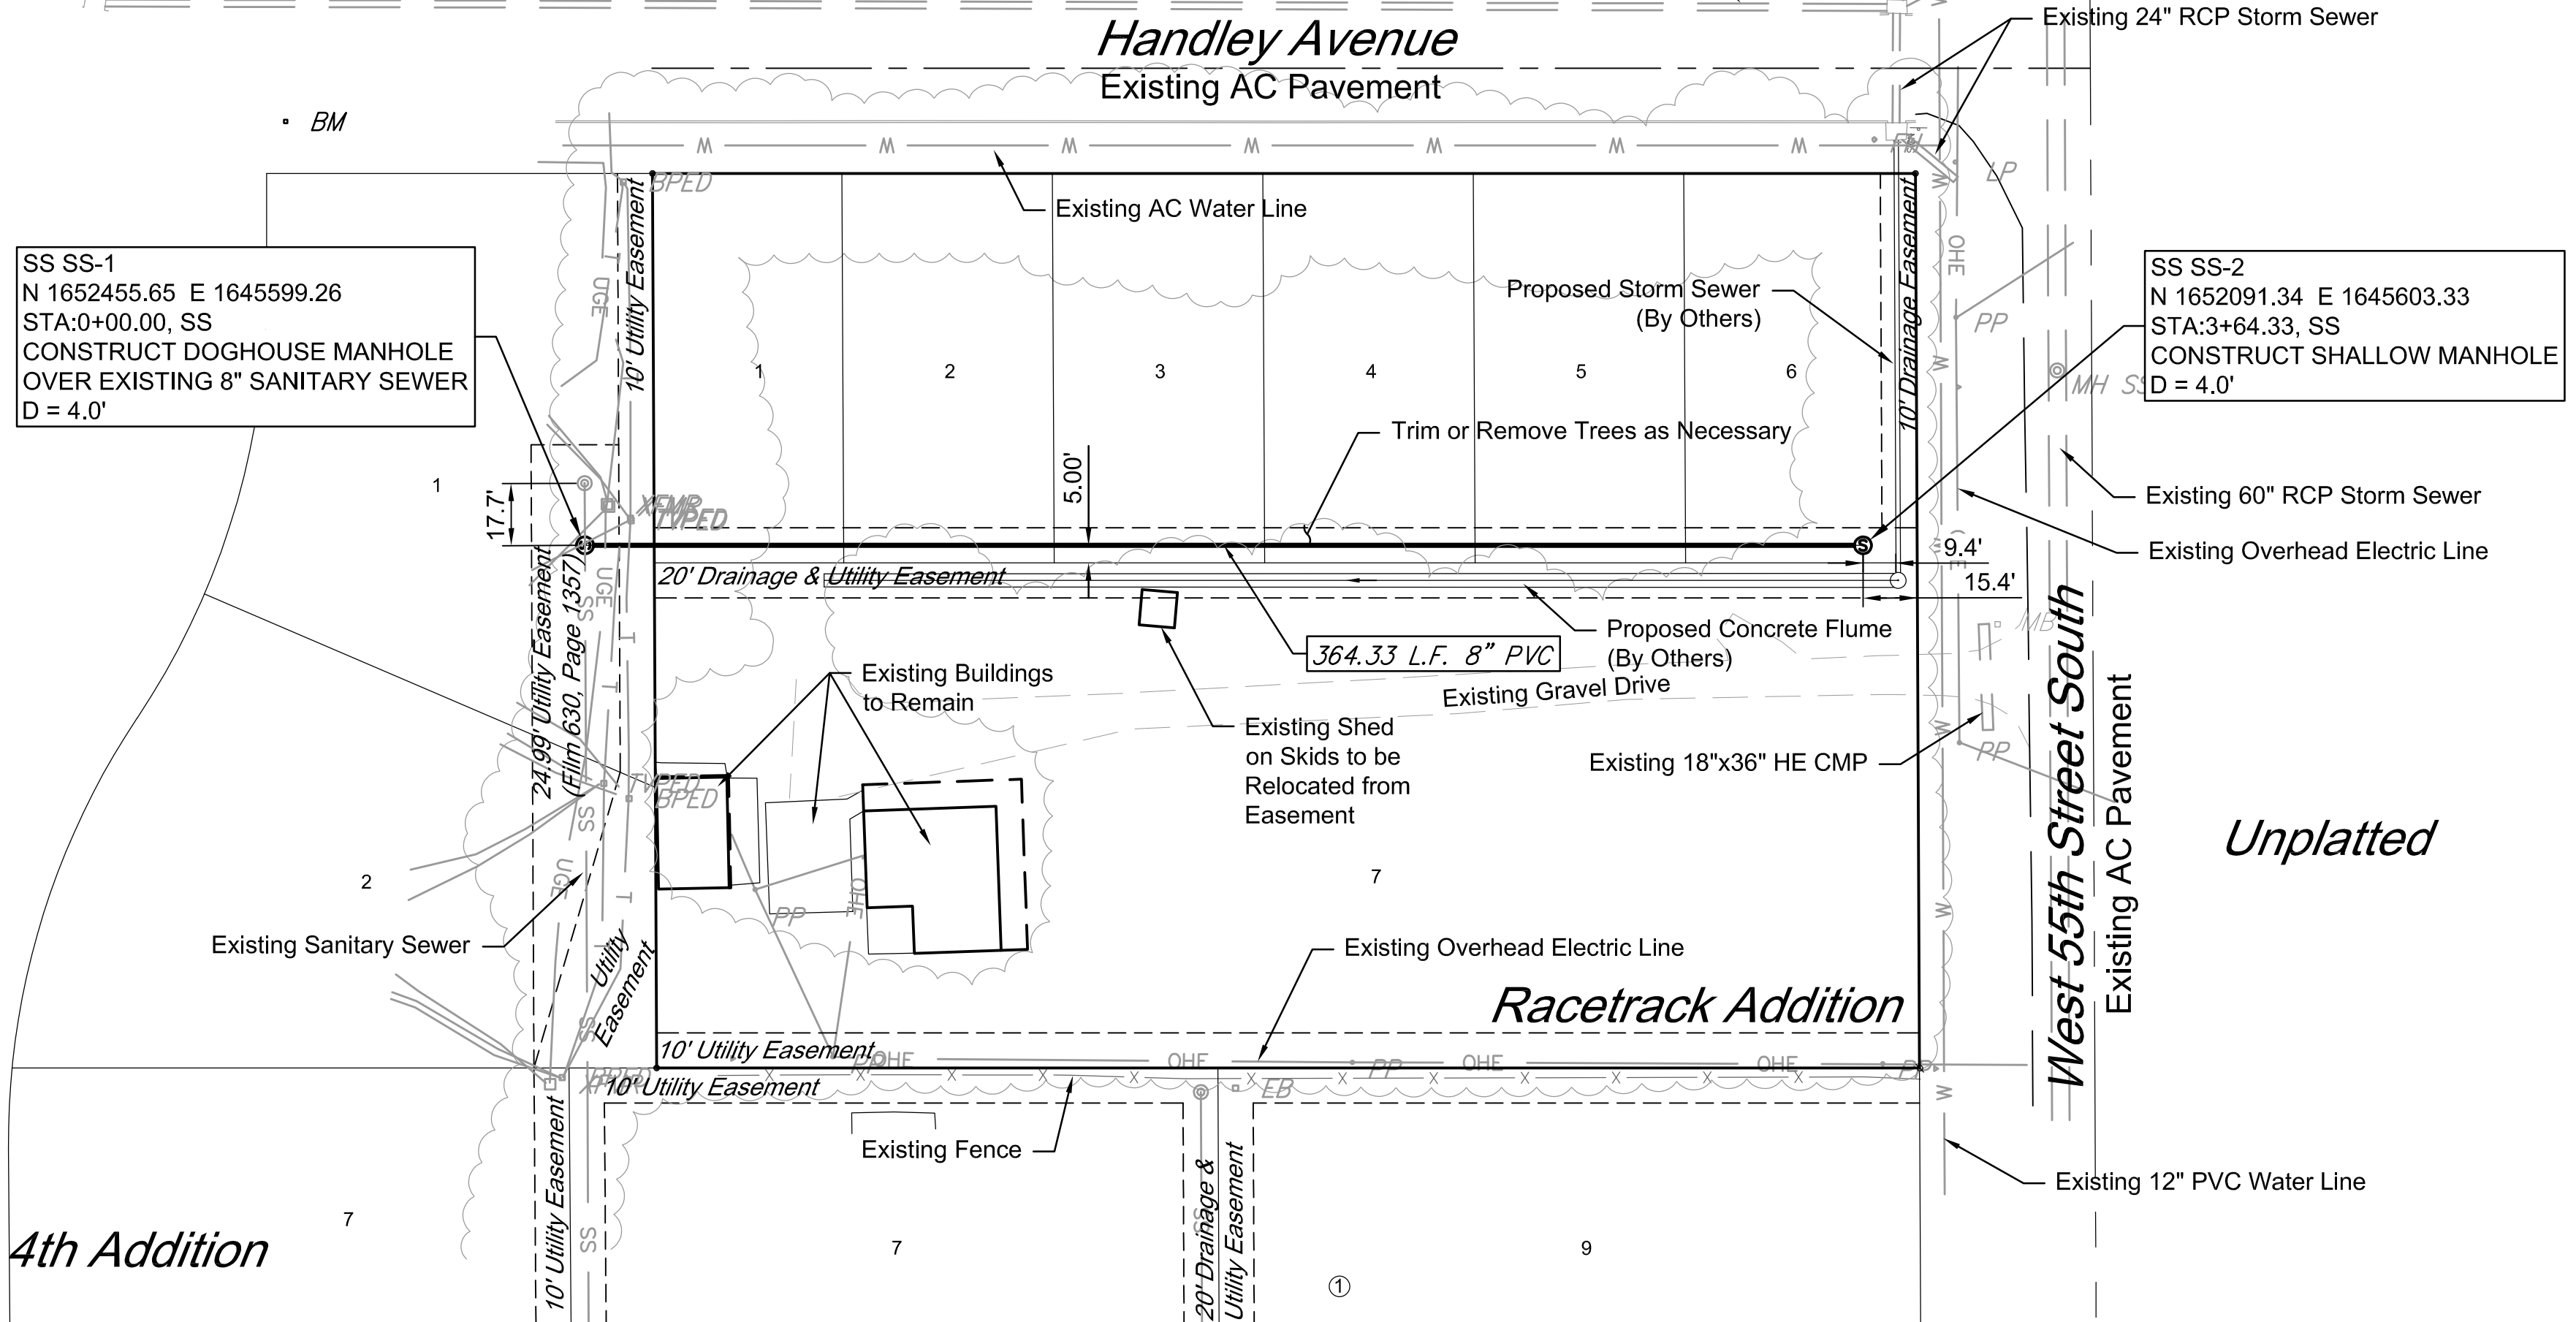

AS BUILT PLANS
Inspector: Caleb Jurey
Garver, LLC
Contractor: Wilks Underground
Super: Chad Davis
PDF By: CDJ 07/16/2018



© 2017 GARVER, LLC
THIS DOCUMENT, ALONG WITH THE IDEAS AND DESIGNS CONVEYED HEREIN, SHALL BE CONSIDERED INSTRUMENTS OF PROFESSIONAL SERVICE AND ARE PROPERTY OF GARVER, LLC. ANY USE, REPRODUCTION, OR DISTRIBUTION OF THIS DOCUMENT, ALONG WITH THE IDEAS AND DESIGN CONTAINED HEREIN, IS PROHIBITED UNLESS AUTHORIZED IN WRITING BY GARVER, LLC OR EXPLICITLY ALLOWED IN THE GOVERNING PROFESSIONAL SERVICES AGREEMENT FOR THIS WORK.



REV.	DATE	DESCRIPTION	BY

CITY OF WICHITA
WICHITA, KS

RACETRACK ADDITION
Sanitary Sewer

JOB NO.: 17267001
DATE: DEC 2017
DESIGNED BY: KWL
DRAWN BY: CDJ


BAR IS ONE INCH ON ORIGINAL DRAWING
IF NOT ONE INCH ON THIS SHEET, ADJUST SCALES ACCORDINGLY.
DRAWING NUMBER
17267001
SHEET NUMBER **2** OF **7**

File: L:\2017\17267001 - Race Track Engineering\Drawings\C3D\Sanitary\7001SS-C105-SP.dwg, Last Save: 1/29/2018 1:56 PM, Last saved by: CDJurey, Last plotted by: Jurey, Caleb D., Plot Style: AECmono.ctb, Plot Scale: 1:2,849, Plot Date: 1/29/2018 1:59 PM, Plotter used: None


File: L:\2017\17267001 - Race Track Engineering\Drawings\C3D\Sanitary\7001SS-106-SS.dwg Last Save: 1/8/2018 5:20 PM Last saved by: CDJurey
 Last plotted by: Jurey, Caleb D. Plot Style: AECmono.ctb Plot Scale: 1/29/2018 1:59 PM Plotter used: None

Point Table			
Point #	Northing	Easting	Description
100	1652070.27	1645451.23	BLK CNR
101	1652430.24	1645447.21	BLK CNR
102	1652432.52	1645591.19	BLK CNR
103	1652378.52	1645591.79	LOT CNR
104	1652318.53	1645592.46	LOT CNR
105	1652258.53	1645593.13	LOT CNR
106	1652198.54	1645593.80	LOT CNR
107	1652138.54	1645594.47	LOT CNR
108	1652072.54	1645595.21	LOT CNR
109	1652074.30	1645706.20	BLK CNR
110	1652140.30	1645705.46	LOT CNR
111	1652200.29	1645704.79	LOT CNR
112	1652260.29	1645704.12	LOT CNR
113	1652320.28	1645703.45	LOT CNR
114	1652380.28	1645702.78	LOT CNR
115	1652434.28	1645702.17	BLK CNR
600	1652452.34	1645595.97	SS 0+00 MH
601	1652088.03	1645600.04	SS 3+64 MH

All coordinates listed are modified NAD83 Kansas State Plane Zone South unless otherwise noted. To convert listed coordinates to NAD83 Kansas State Plane Zone South coordinates, multiply the northing and easting by the project scale factor of 0.99989549. Elevation datum is NAVD88 Geoid 12B unless otherwise noted.

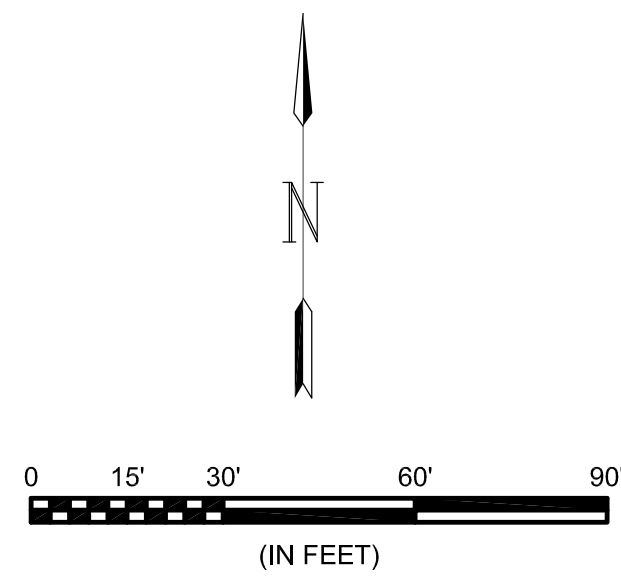

*South Seneca Gardens
Fourth Addition*

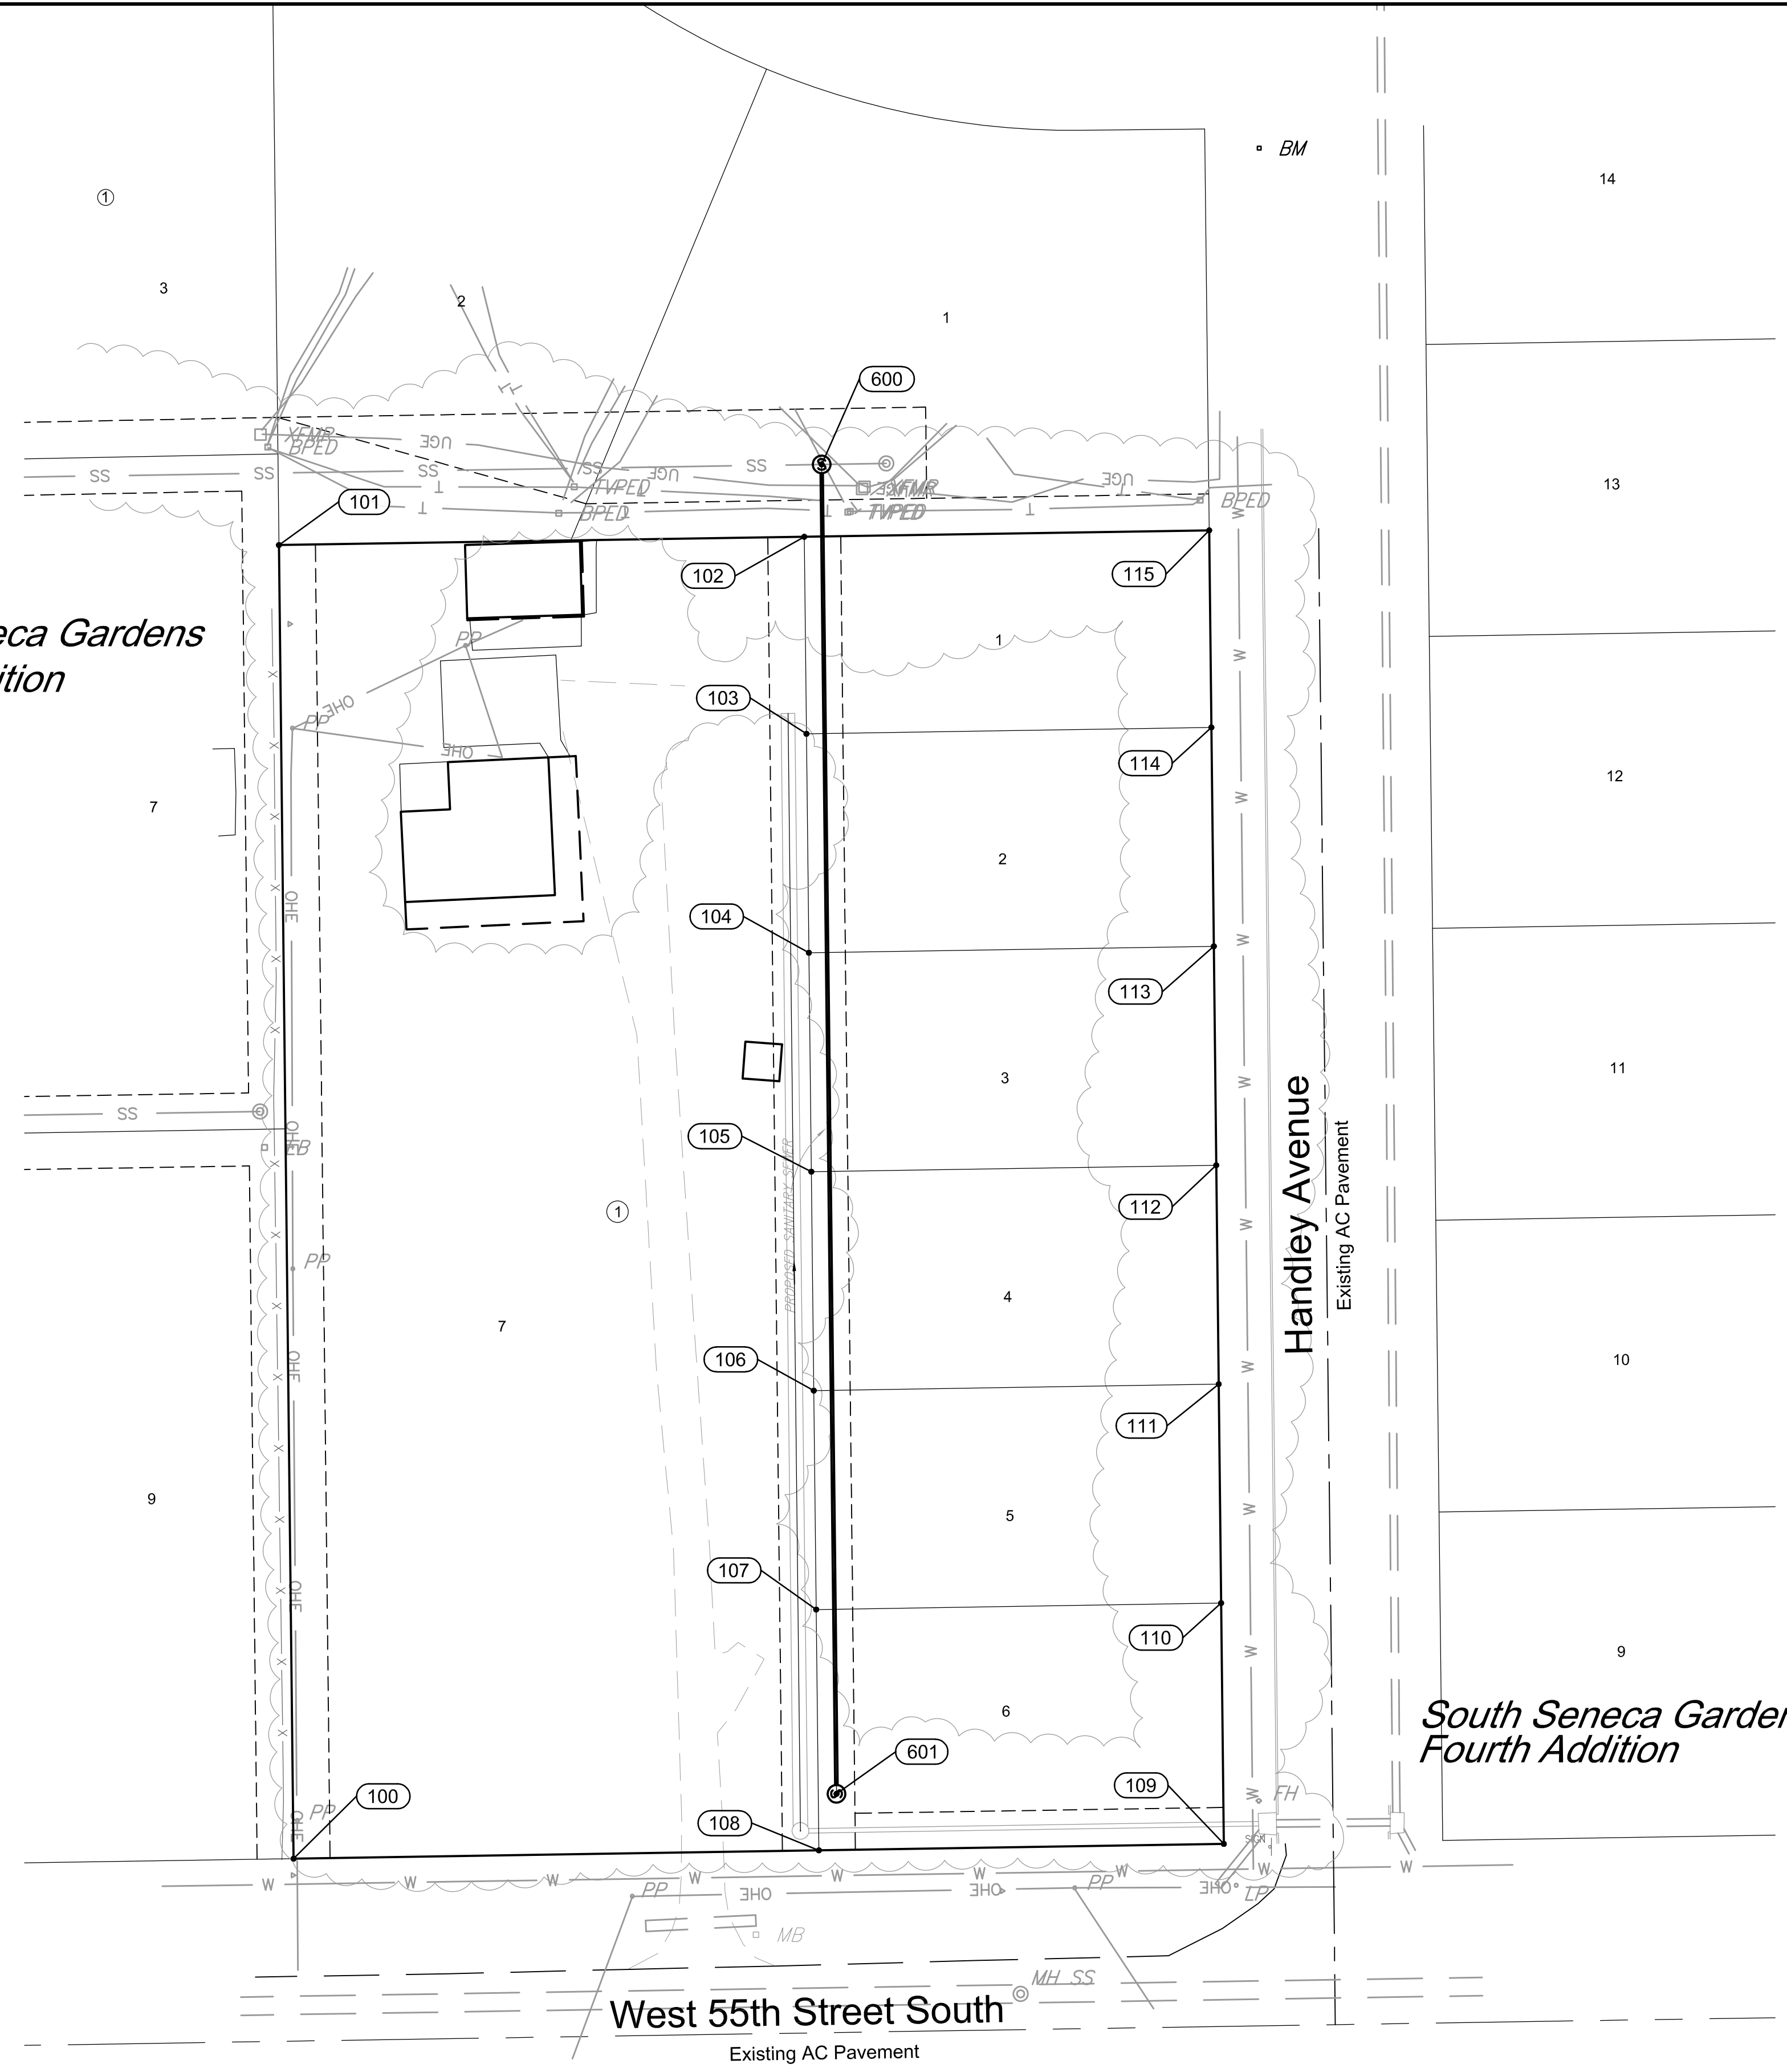

GARVER
 © 2017 GARVER, LLC
 THIS DOCUMENT, ALONG WITH THE IDEAS AND DESIGNS CONVEYED HEREIN, SHALL BE CONSIDERED INSTRUMENTS OF PROFESSIONAL SERVICE AND ARE PROPERTY OF GARVER, LLC. ANY USE, REPRODUCTION, OR DISTRIBUTION OF THIS DOCUMENT, ALONG WITH THE IDEAS AND DESIGN CONTAINED HEREIN, IS PROHIBITED UNLESS AUTHORIZED IN WRITING BY GARVER, LLC OR EXPLICITLY ALLOWED IN THE GOVERNING PROFESSIONAL SERVICES AGREEMENT FOR THIS WORK.



REV.	DATE	DESCRIPTION	BY

CITY OF WICHITA
WICHITA, KS
RACETRACK ADDITION

Bubble Map

JOB NO.: 17267001
 DATE: DEC 2017
 DESIGNED BY: KWL
 DRAWN BY: CDJ

BAR IS ONE INCH ON ORIGINAL DRAWING
 IF NOT ONE INCH ON THIS SHEET, ADJUST SCALES ACCORDINGLY.

DRAWING NUMBER
17267001
 SHEET NUMBER **5** OF **7**

