


• BM #6 - RR Spike in West face of HLP, East side of Hydraulic,
South of Georgia St. Sta. 147+70, 43' Rt.
Elev. 84.51 (City Datum)

BM #7 - RR Spike in West face of HLP, East side of Hydraulic,
South of Alta Street. Sta. 155+07, 41' Rt.
Elev. = 86.12 (City Datum)

FRANK & BARBARA A.
RUGGIERO
B - 12266 - 1
Part of Lot 1

5+97.14
W.L. Sta. ~~5+04.14~~, End Line 4 =
B.L. Sta. ~~154+00.00~~, 30.50' Rt.
1 - 16" 45° C.I.M.J. Bend (E)
Roll Vertical to Match
Block as Necessary

SCALE: 1" = 20'

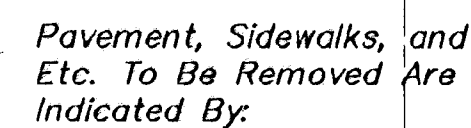

BM #6 - RR Spike in West face of HLP, East side of Hydraulic,
South of Georgia St. Sta. 147+70, 43' Rt.
Elev. 84.51 (City Datum)

W.L. Sta. 1+03.25, Line 5 =
B.L. Sta. 148+83.47, 67.75' Lt.
~~1 - 45° C.I.M.J. Bend (V)~~

SCALE: 1" = 20'

CAUTION!
*Existing
& Proposed
U/G SWB
Crossing*

W.L. Sta. ~~11+0.00~~, Line 5 =
B.L. Sta. 148+83.47, 74.50' Lt
1 - 8"x6" PE x MJ Reducer
~~1 - 6" C.I.M. 90° Bend~~
(Rolled) 2 - 8" C.I.M. 45° B
13" o.d B" DILL PIPE
8" to 6" Reducer
6" Tapping Valve V# 372

NEW HOPE ADDITION
CITY OF WICHITA VI
C - 36612

CAUTION!
Existing
U/G Bell
30" San Sewer
Crossings

Install 103.25 L.F.
8" Pipe

CAUTION!
*Proposed
2" Gas in
Vicinity*

1421.5

W.L. Sta. 144+60, End Line 5 =
B.L. Sta. 148+87.50, 74.50' Lt.
Connect to Ex. 6" A.C. Line
1 - 6"x6" Tapping Sleeve
1 - 6" Tapping Valve
1 - 6" Valve Box
To Be Furnished & Installed
By The City of Wichita,
Valve Box Elev. = 83.00
Cap Existing 6" Line (East)


Ex Work

CHURCH
BLDG

Install 6.75 L.F.
8" D.I.C.L. Pipe

6" V" 37271

LOUIS 4TH ADDITION
SOUTH RIVERSIDE
BAPTIST CHURCH
B - 12291

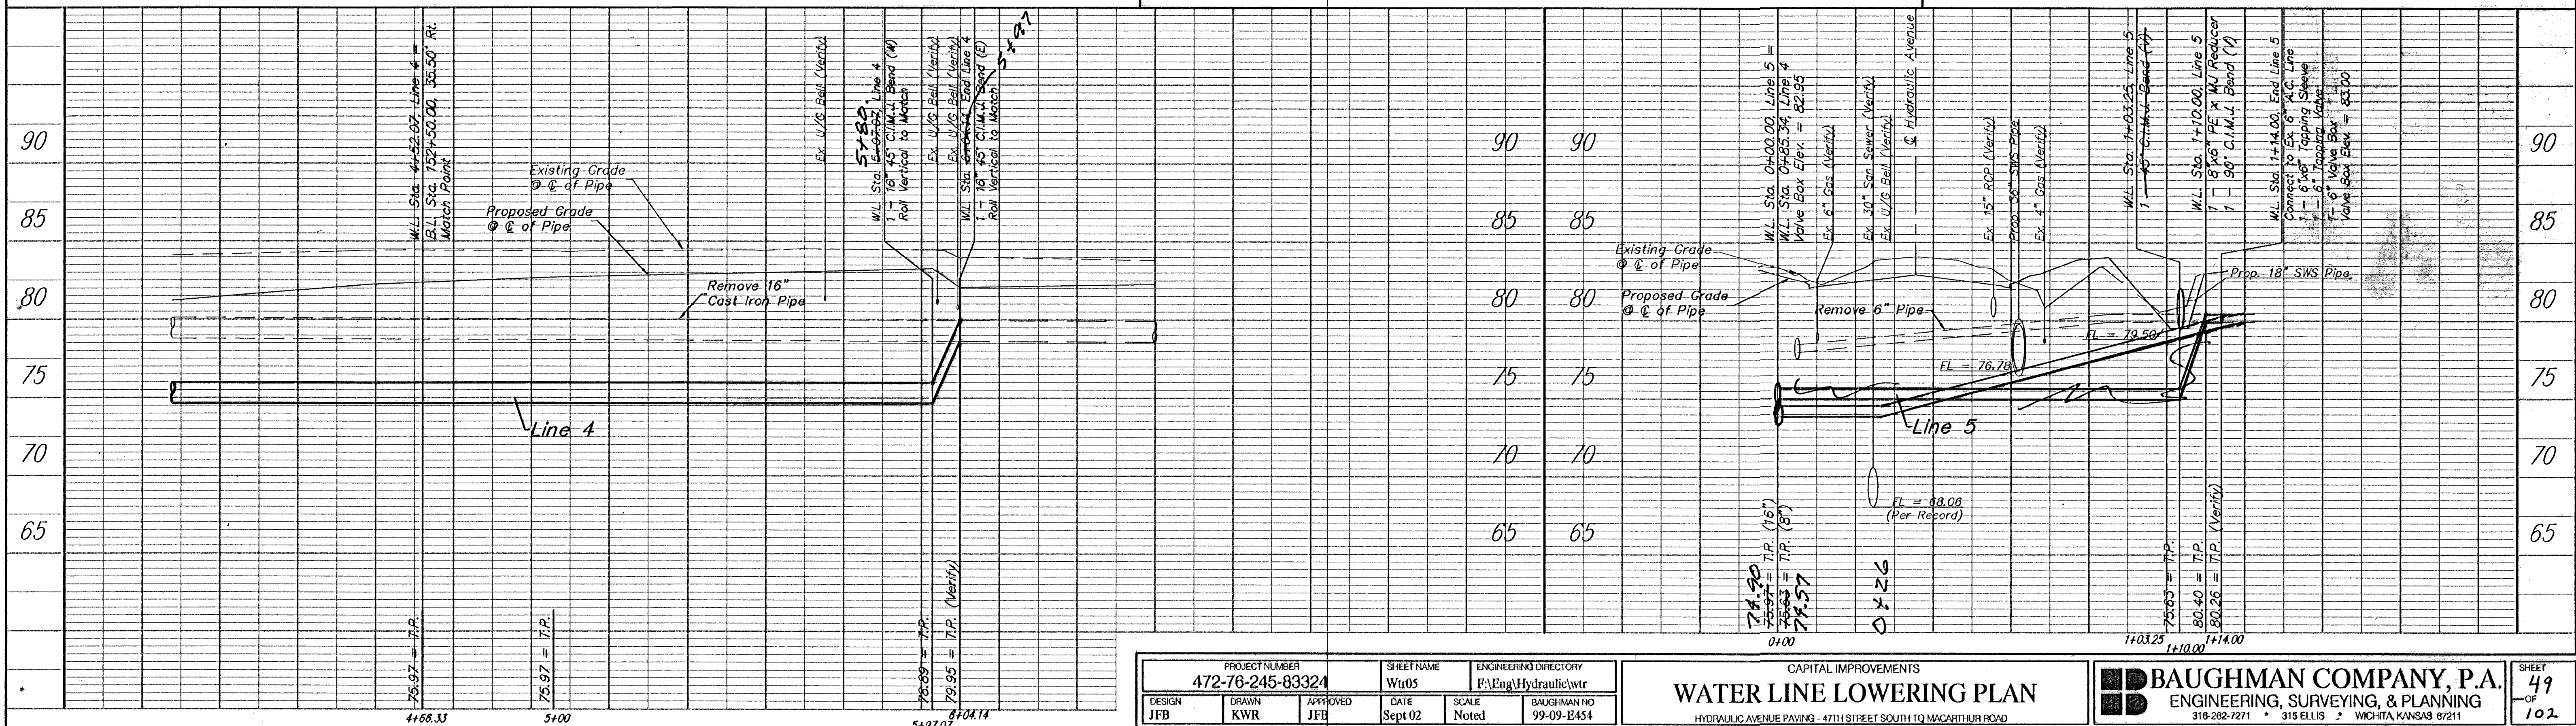

PROJECT NUMBER 472-76-245-83324			SHEET NAME Wtr05		ENGINEERING DIRECTORY F:\Eng\Hydraulic\wtr	
DESIGN JFB	DRAWN KWR	APPROVED JFB	DATE Sept 02	SCALE Noted	BAUGHMAN NO 99-09-P454	

CAPITAL IMPROVEMENTS

WATER LINE LOWERING PLAN

HYDRAULIC AVENUE PAVING - 47TH STREET SOUTH TO MACARTHUR ROAD

BAUGHMAN COMPANY, P.A.
ENGINEERING, SURVEYING, & PLANNING
318-262-7271 * 315 ELLIS * WICHITA KANSAS 67211

SHEET
49
-OF
102