



OLD TOWN PARKING DISTRICT PARKING LOTS #9 AND #10

SRB

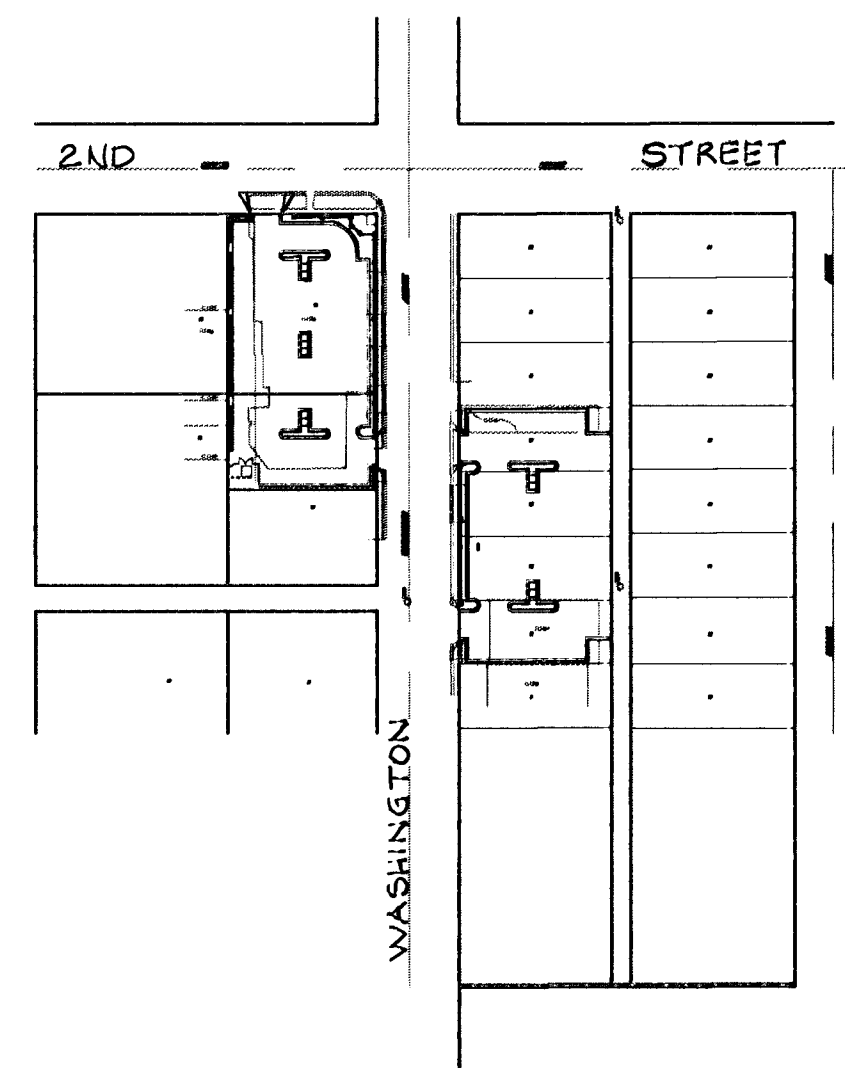

INDEX OF SHEETS

1. TITLE SHEET
2. GENERAL NOTES & DETAILS
3. TYPICAL SECTIONS
4. SCREEN WALL DETAILS
5. PLAN - LOT #9
6. PLAN - LOT #10
- 7-10. LIGHTING PLANS & DETAILS
- 11-12. LANDSCAPE PLANS & DETAILS
- 13-14. IRRIGATION PLANS & DETAILS (NOT INCLUDED)

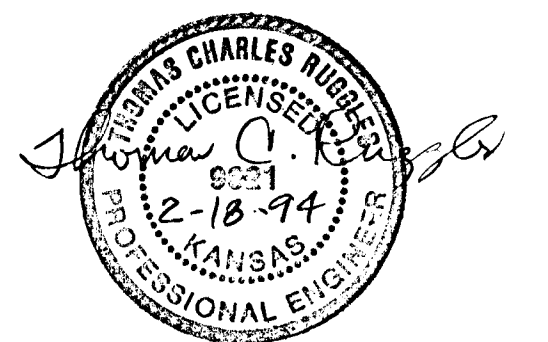

CITY OF WICHITA, KANSAS
MICHAEL E. LINDEBAK - CITY ENGINEER

RECORD COPY REVISED 7-11-94

SRB 841 SOUTH HILLSIDE 316-652-7754
WICHITA, KANSAS 67211 FAX 652-7932
SAVOY, RUGGLES & BOHM, P. A.
ENGINEERING & SURVEYING