


BENCH MARK #1: "□" cut on top of curb
50.4' N. of N.W. corner of Lot 17 on Washington,
Mathewson's 2nd Addition Elev. 109.65

SCALE: 1" = 20'

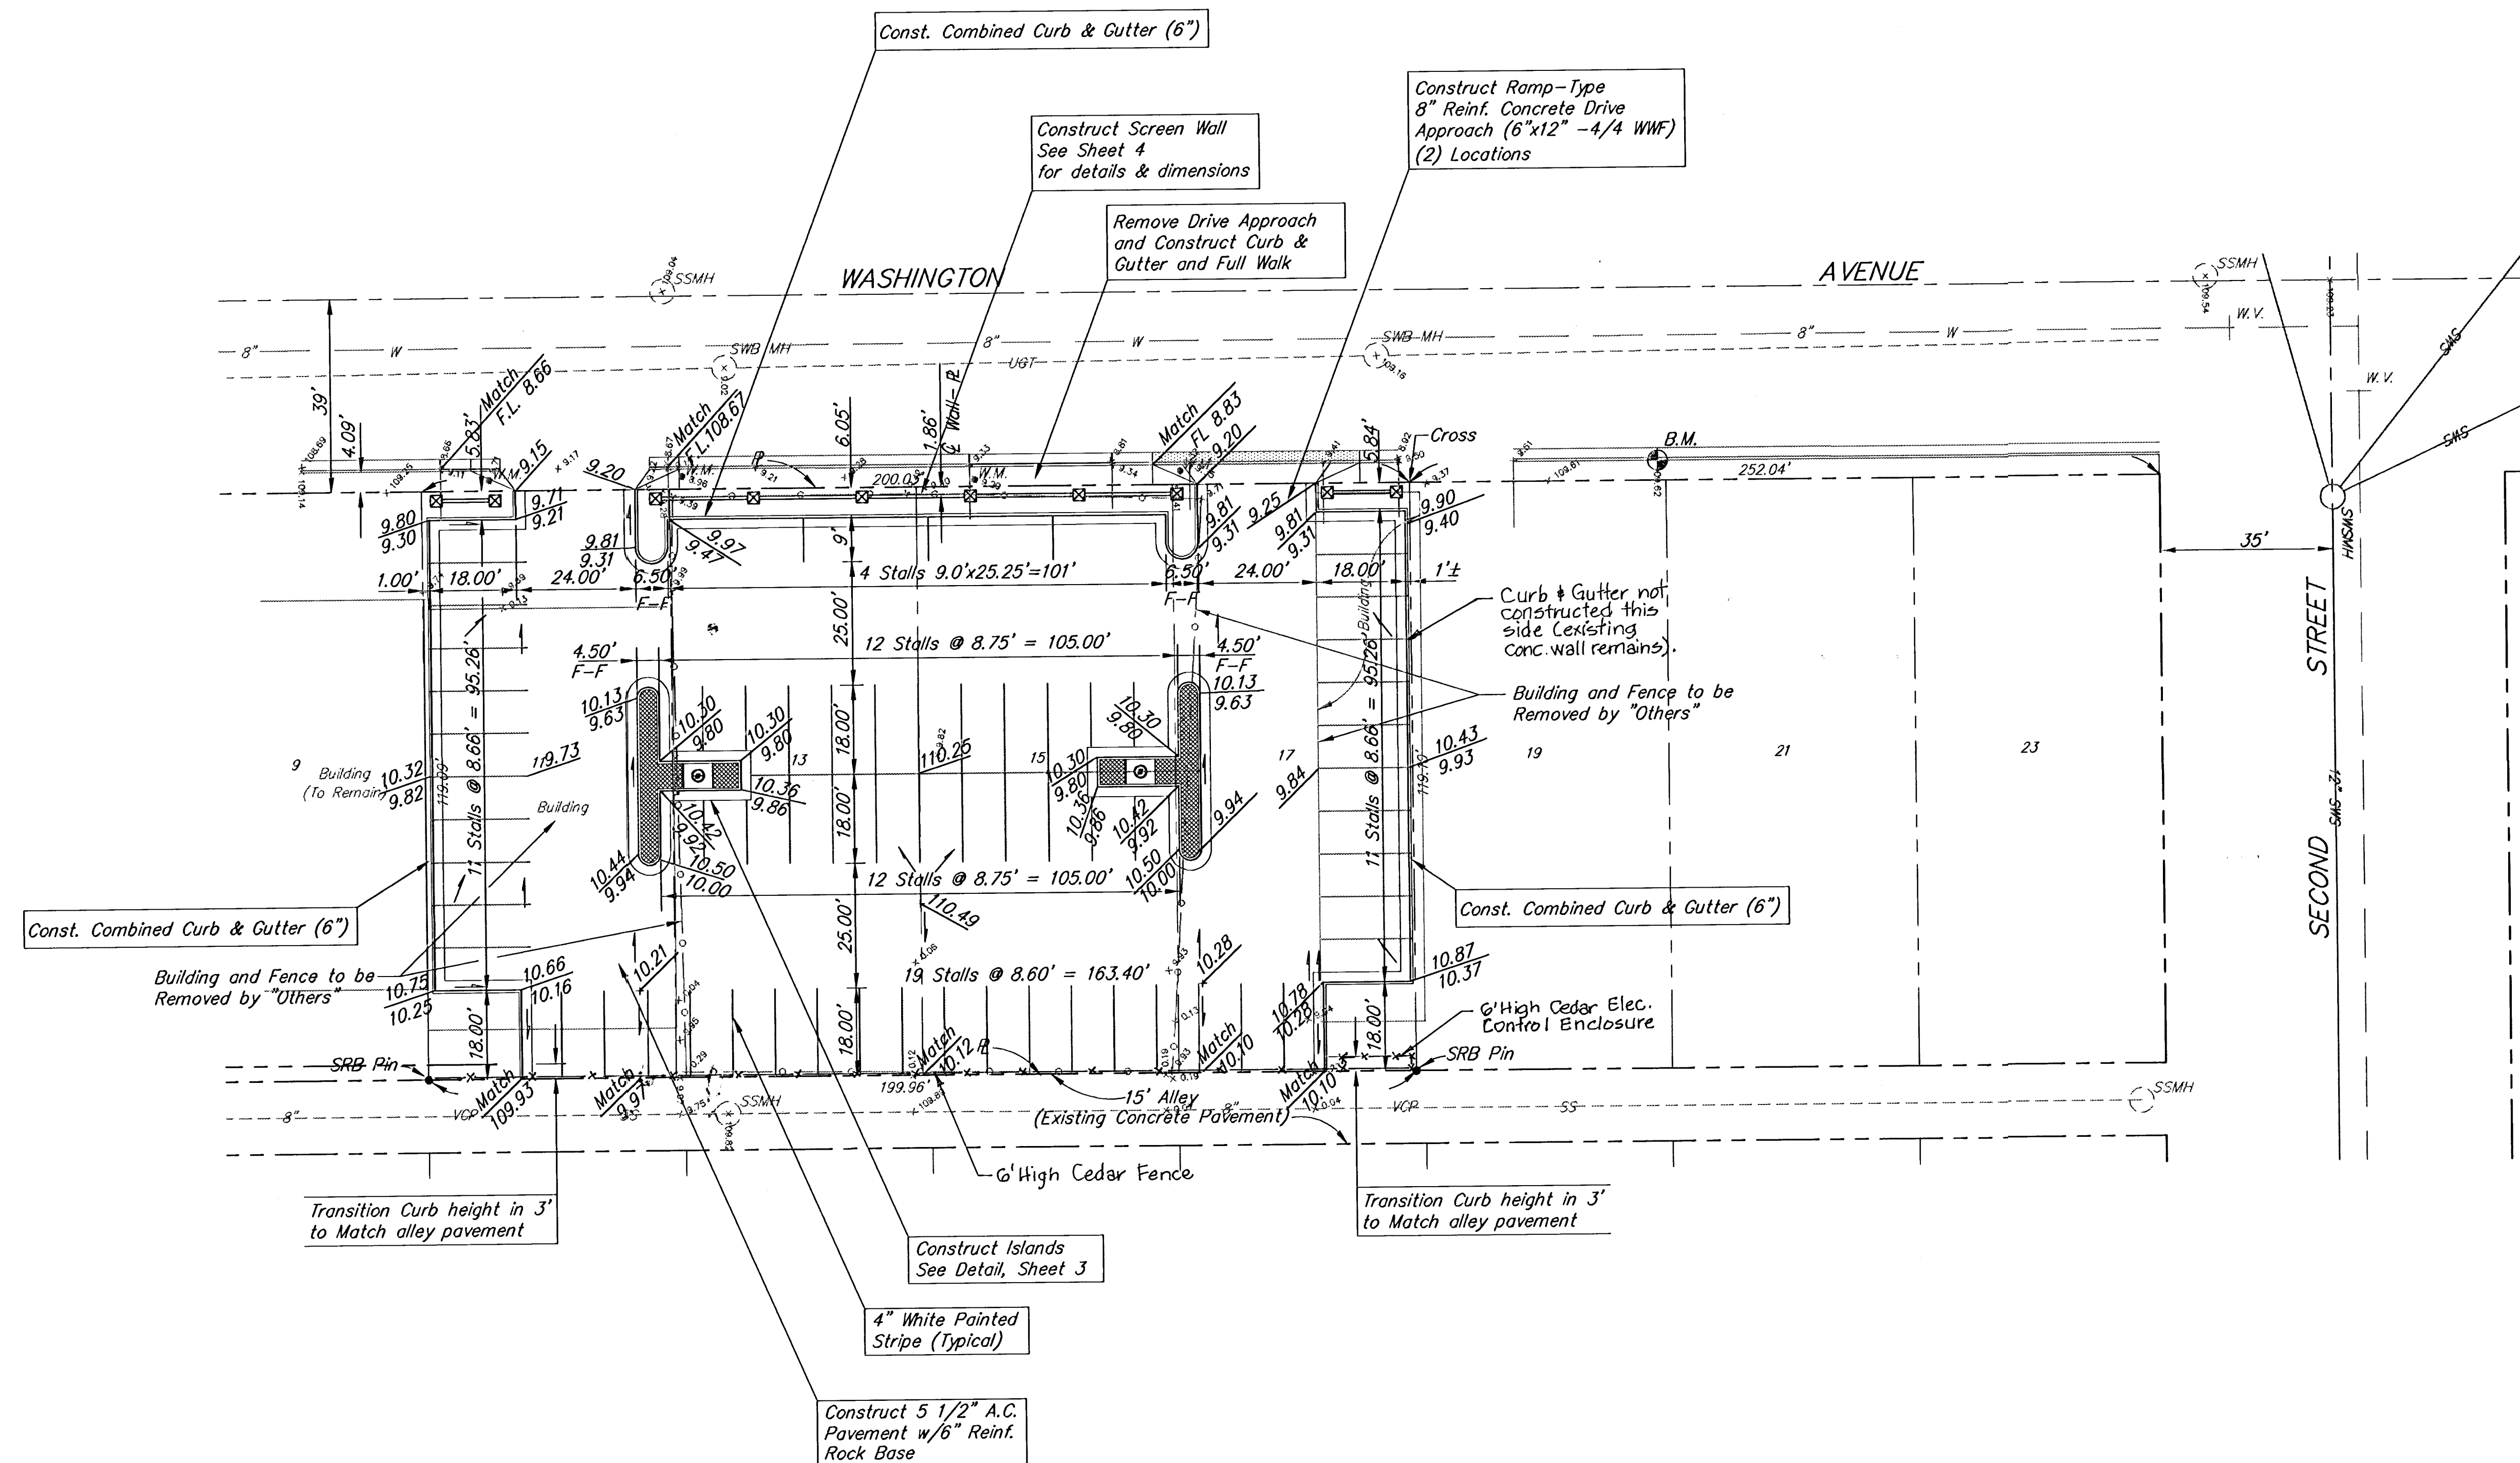

NOTE:
Dimensions are to face of curb except where noted otherwise.

LEGAL DESCRIPTION:
Lots 11, 13, 15, and 17, Washington Avenue, in Mathewson's 2nd Addition to the City of Wichita, Sedgwick County, Kansas, except the West nine (9) feet thereof.

SITE PLAN - PARKING LOT #9
OLD TOWN PARKING DISTRICT

SRB 841 SOUTH HILLSIDE 316-652-775
WICHITA, KANSAS 67211 FAX 652-793

SAVOY, RUGGLES & BOHM, P. A.
ENGINEERING & SURVEYING

PROJECT NUMBER _____

REVISED 7-11-94
RECORD COPY

DRAWN <i>T. Brooks</i>	DESIGN <i>T. Ruggles</i>	REVIEW	DATE <i>2-23-94</i>	UTILITY	SRB JOB <i>101E</i>
---------------------------	-----------------------------	--------	------------------------	---------	------------------------

FILE 01E/P2