



PLOTED: Monday, March 22, 2021 @ 10:58AM

SEWER SERVICE RISER TABLE						FOR INFORMATION ONLY		
NO.	TYPE	LOCATION			STATION	DIRECTION	APPROXIMATE LENGTH	
		LOT NO.	BLOCK NO.	LINE NO.			VERTICAL (FT)	HORIZONTAL (FT)
1	6" TEE	N/A	N/A	1	11+91/RT.	W	11'	9'
2	6" TEE	N/A	N/A	1	13+00/LT.	E	7.5'	11'
3	6" MH CONNECTION	N/A	N/A	1	13+95/RT.	S	4'	12'

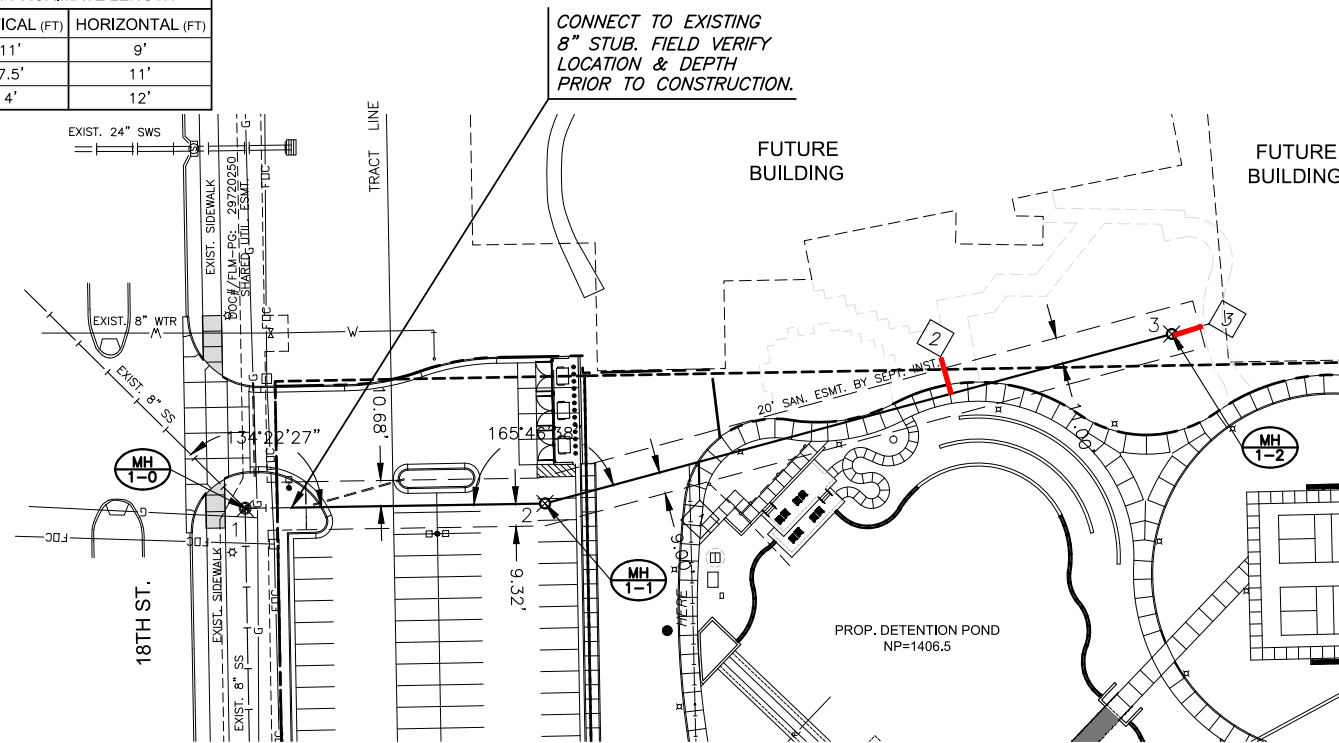


SANITARY POINTS			
Point #	Northing	Easting	Desc.
1	1697611.63	1664782.14	1-0
2	1697486.71	1664784.13	1-1
3	1697225.54	1664854.76	1-2

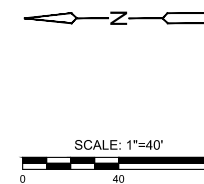

NOTE:
CONTRACTOR TO VERIFY THE DEPTH AND LOCATION OF EXISTING UTILITIES PRIOR TO CONSTRUCTION.

AS-BUILT PER PLANS - FEBRUARY 2021

**PLAN SAN LINE 1
PROFILE SAN LINE 1**

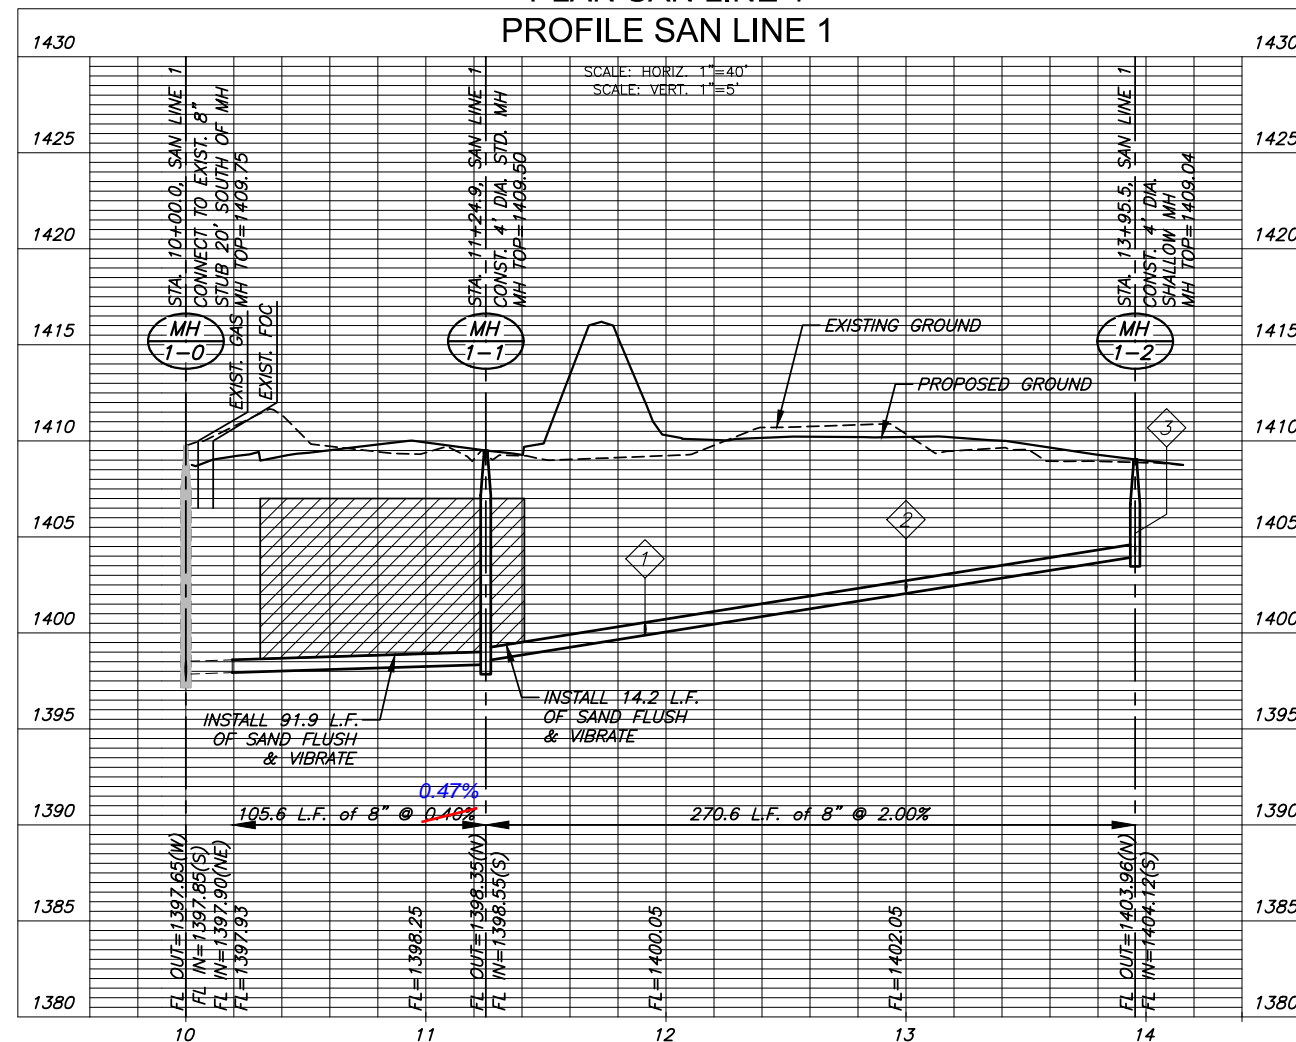

PRIVATE SANITARY SEWER PLANS FOR
WICHITA STATE UNIVERSITY
 PARTNERSHIP BUILDING 4 (NETAPP)

©2021 MKEC Engineering
 All Rights Reserved
 www.mkec.com
 These drawings and their contents, including, but not limited to, all concepts, designs, & ideas are the exclusive property of MKEC Engineering (MKEC), and may not be used or reproduced in any way without the express consent of MKEC.

SAN LINE 1

PROJECT NO.	PPS-2020-012072	
DATE	APRIL 2020	
SCALE	1"=40'	
DESIGNED	DRAWN	CHECKED
SPE	LM	SPE

NO.	REVISION	DATE

SHEET NO.
05 OF 05

J:\PROJECTS\2020\01\010696_CROSSLAND_VISU_NETAPP_20200 CAD\SHOTS\SUBS\CIVIL\SANPPS\20200 SAN 01.DWG