

BENCHMARK:
Railroad Spike in East Face of
Power Pole, East of the NE Corner
of Lot 3, Northridge Plaza Addition
on East Side of Ridge Road
Elev. = 1335.05 M.S.L.



NORTHRIDGE
PLAZA
ADDITION
LOT #4

LOT #2

NORTHRIDGE
PLAZA
ADDITION
LOT #3



Scale: 1" = 20' Horizontal
1" = 5' Vertical
● = Iron

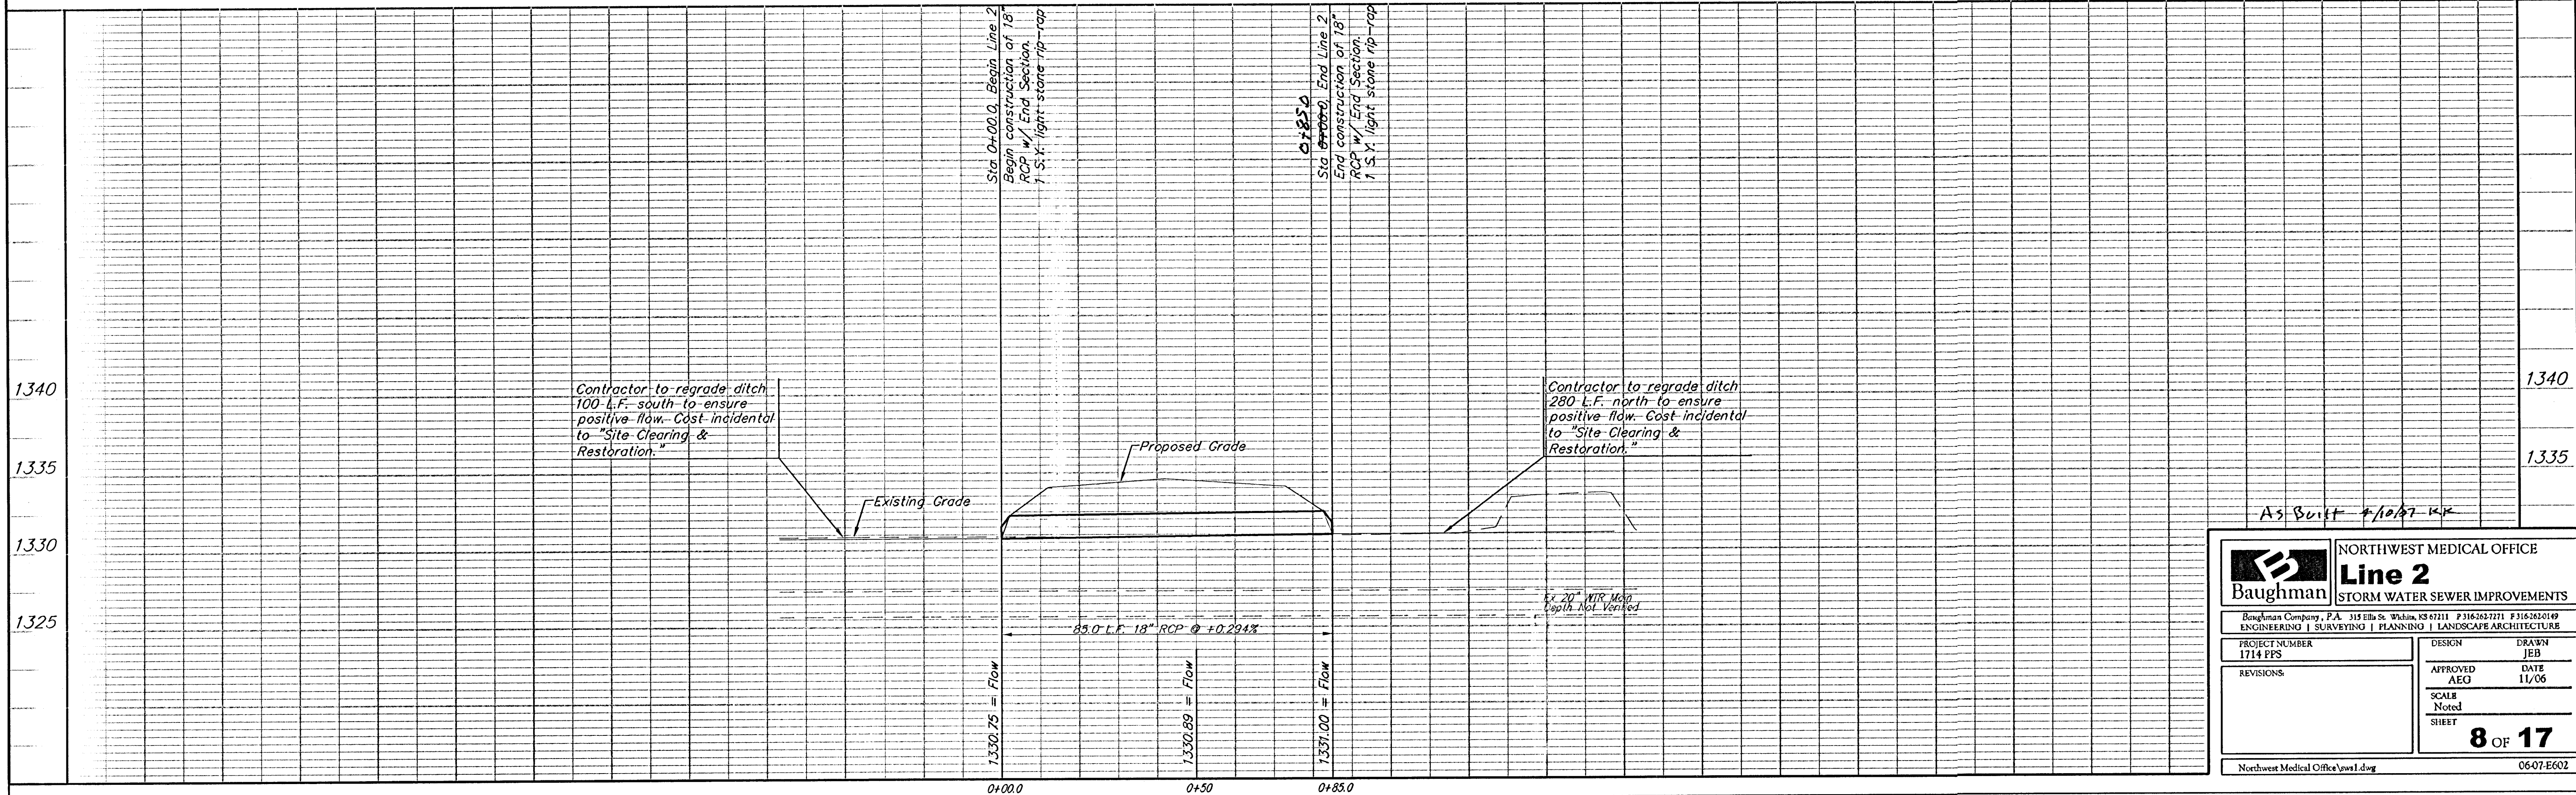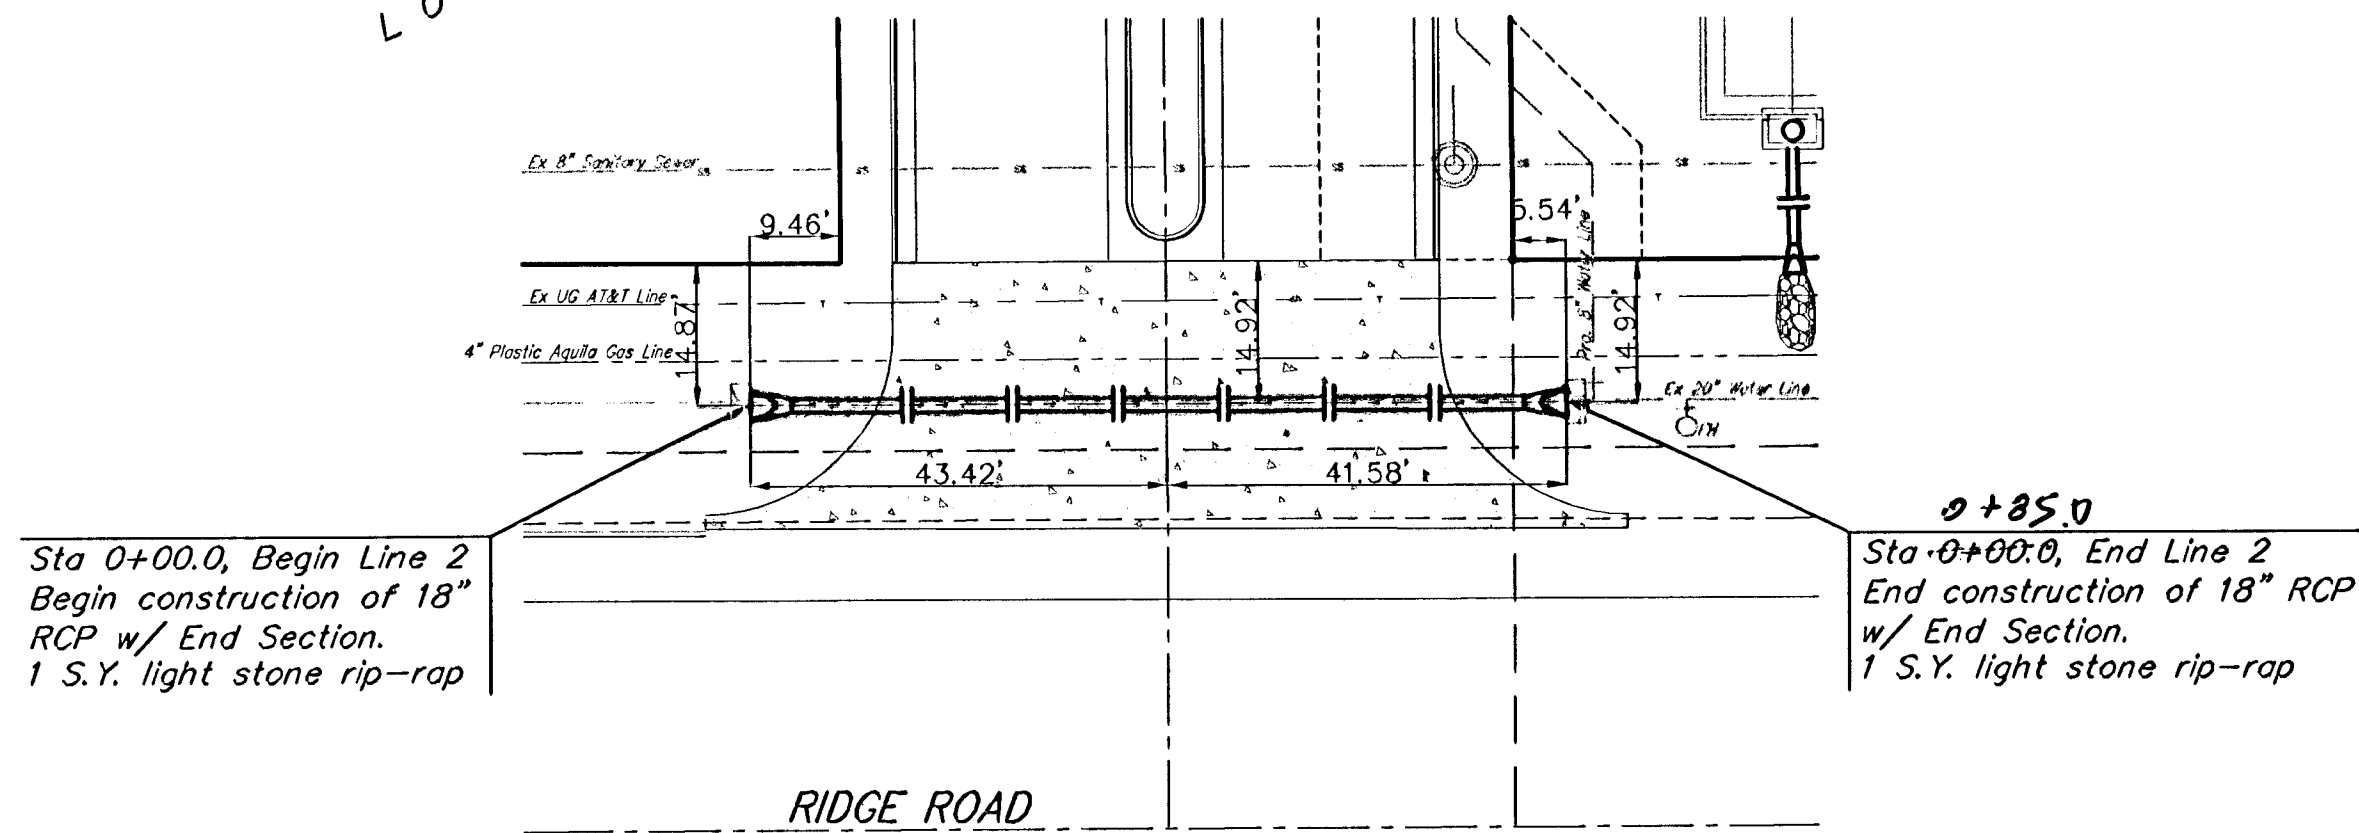

AS Built 4/10/17 KZ

		NORTHWEST MEDICAL OFFICE	
Line 2		STORM WATER SEWER IMPROVEMENTS	
Baughman Company, P.A. 315 E. 1st St., Waco, TX 76711 P 316.363.7171 F 316.363.8149 ENGINEERING SURVEYING PLANNING LANDSCAPE ARCHITECTURE			
PROJECT NUMBER 1714 PFS	DESIGN AEO	DRAWN JEB	DATE 11/06
REVISIONS	SCALE Noted	SHEET 8 OF 17	
Northwest Medical Office\sws1.dwg		06-07-E602	