




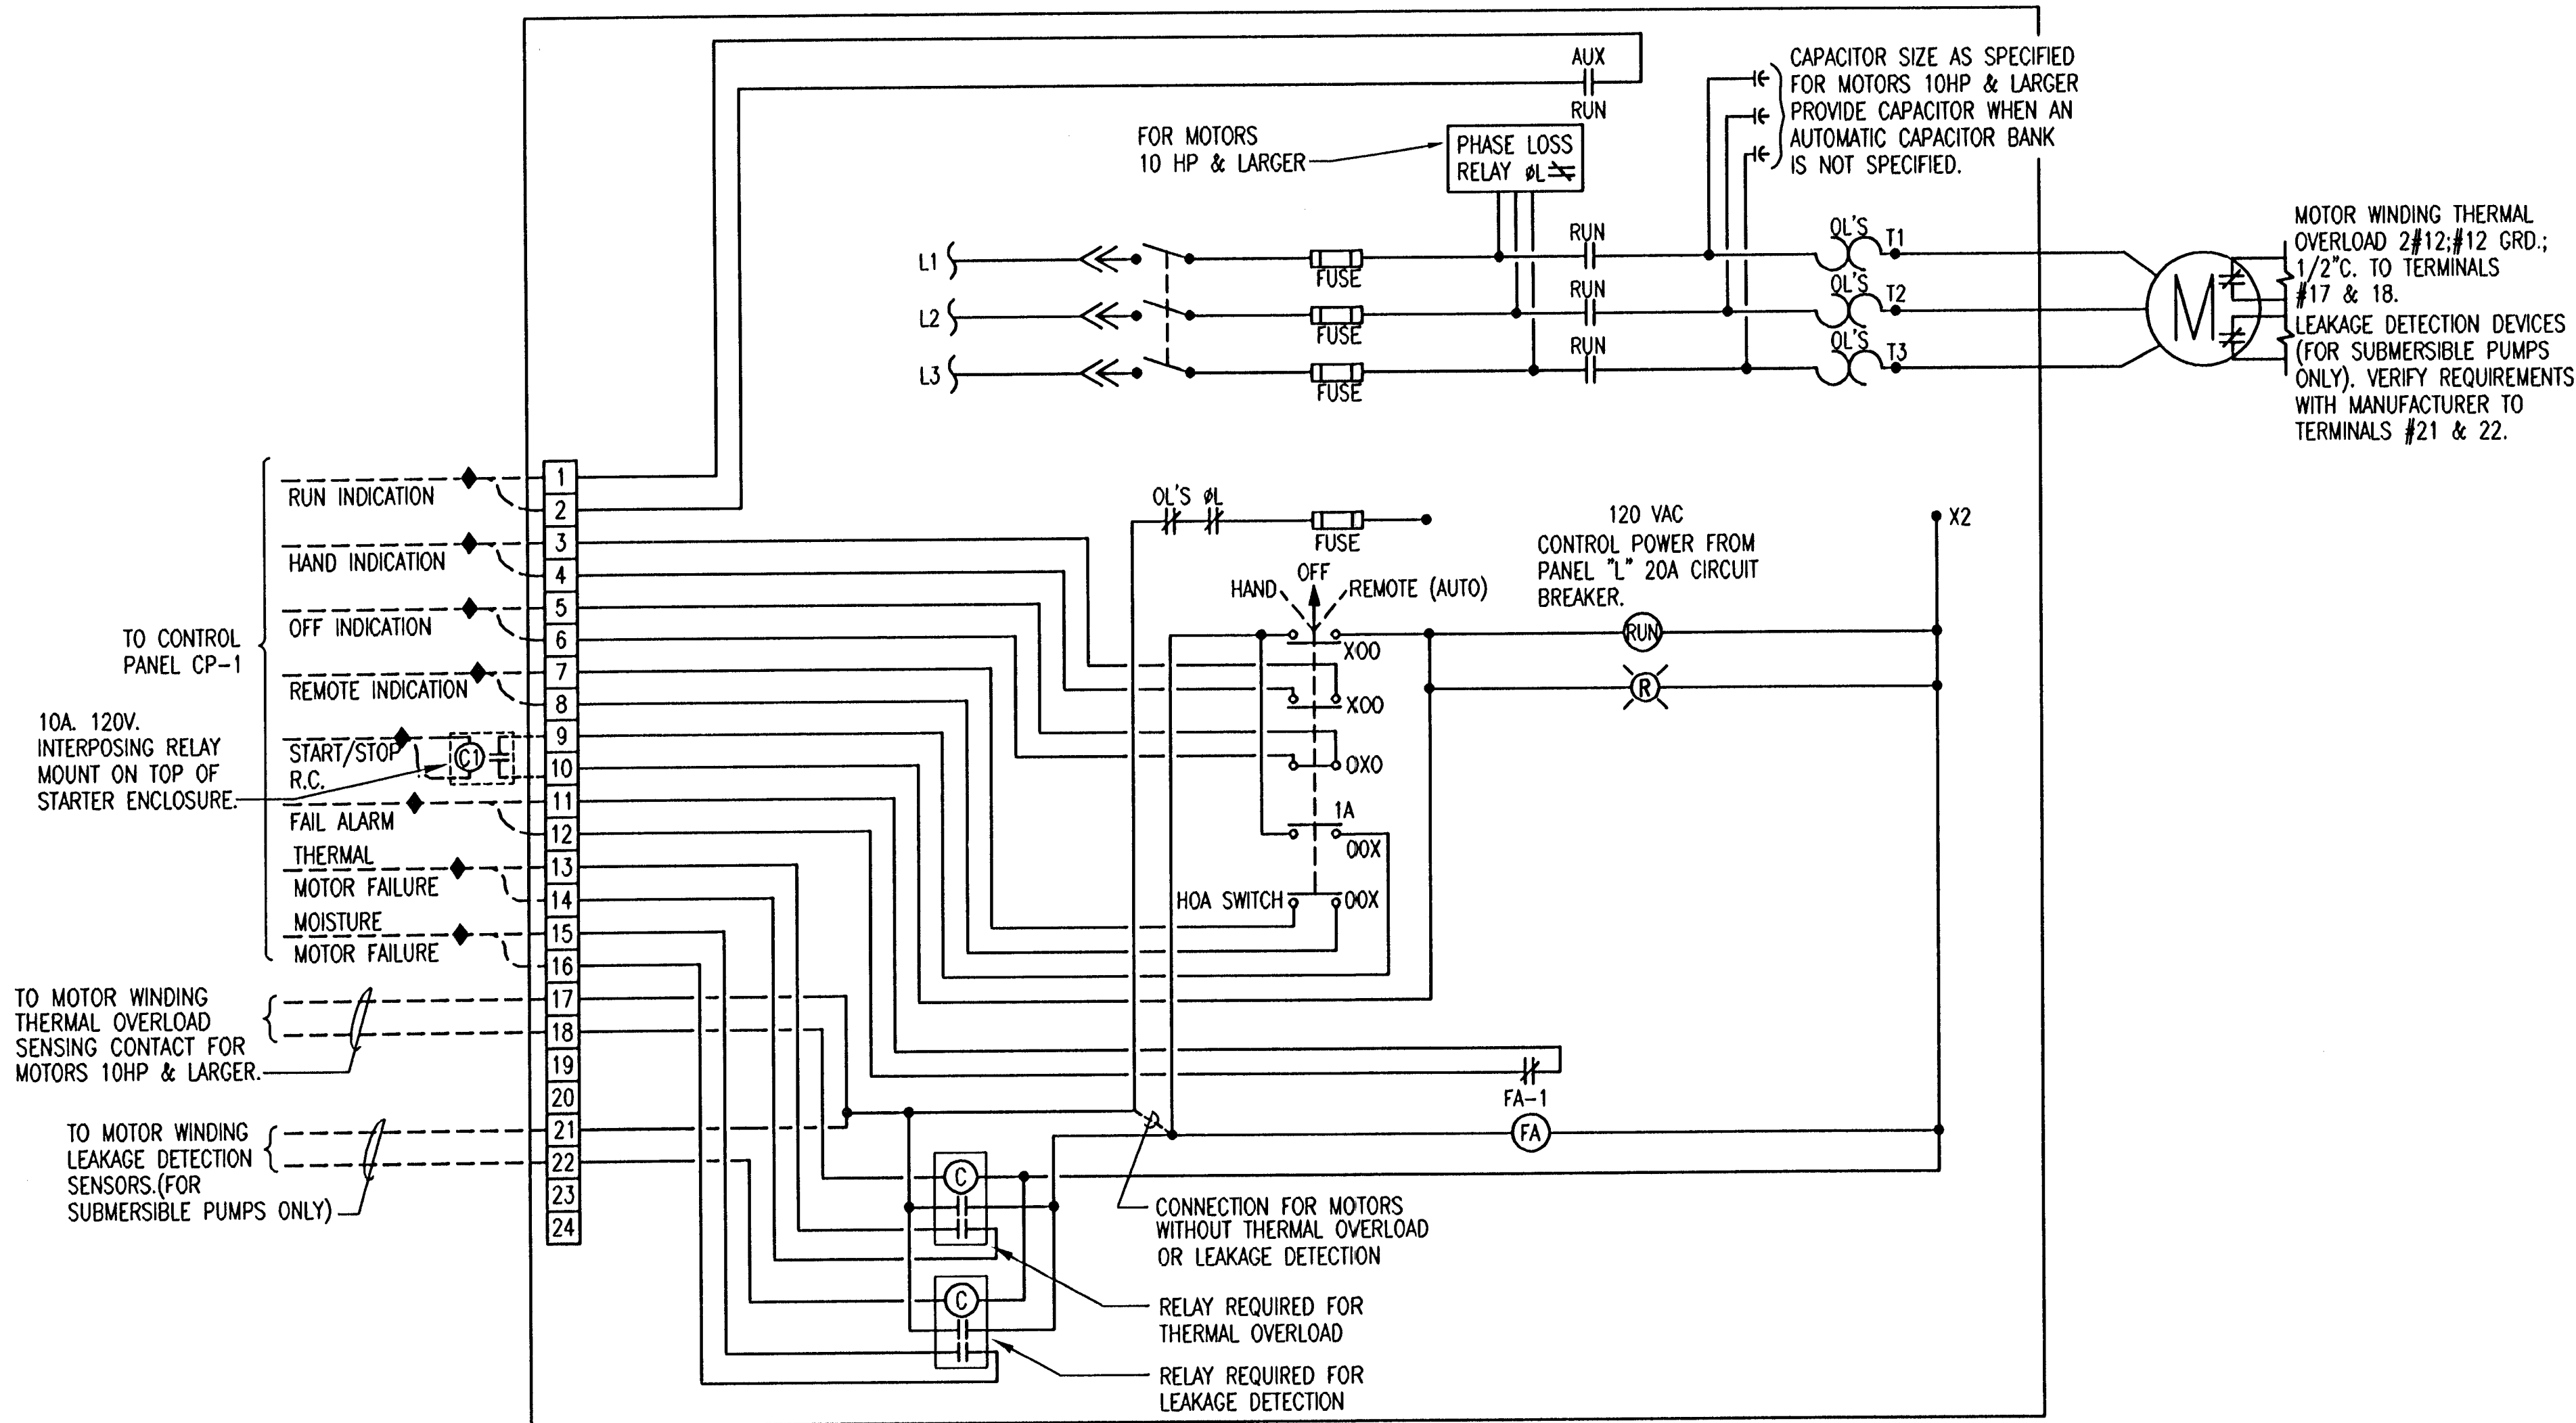


1 TYPICAL ACROSS-THE-LINE STARTER WIRING DIAGRAM
NO SCALE (NOTE: ALLOW ADDITIONAL 3" OF HEIGHT PER STARTER FOR RELAYS).

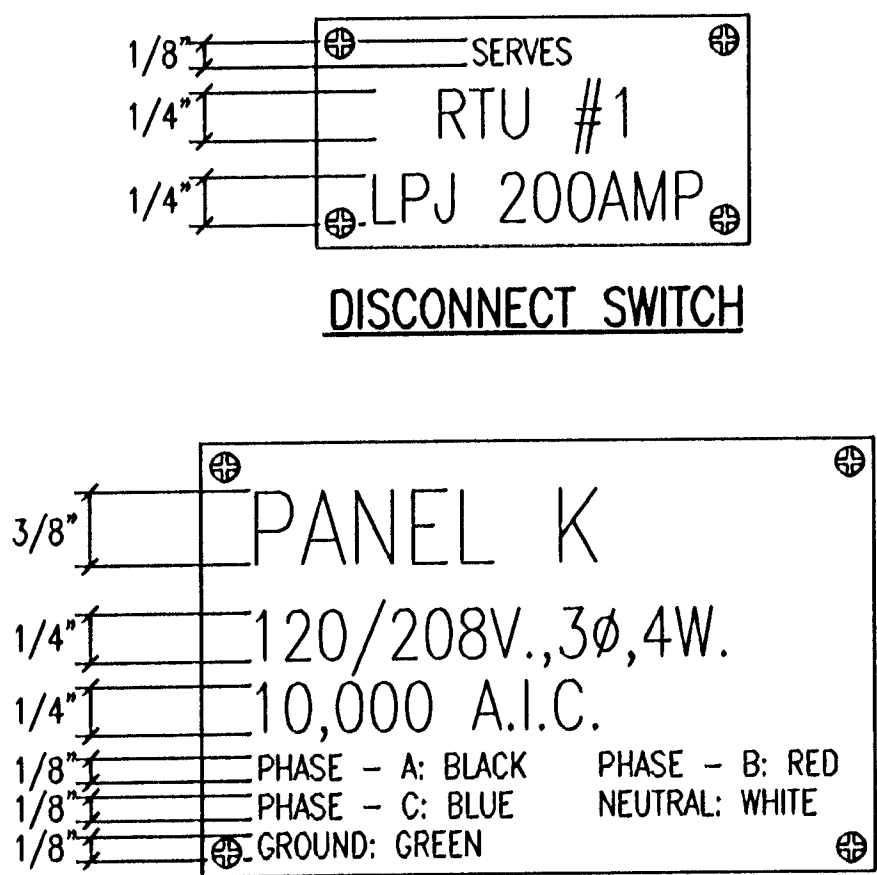

2 TYPICAL NAME PLATES
NO SCALE

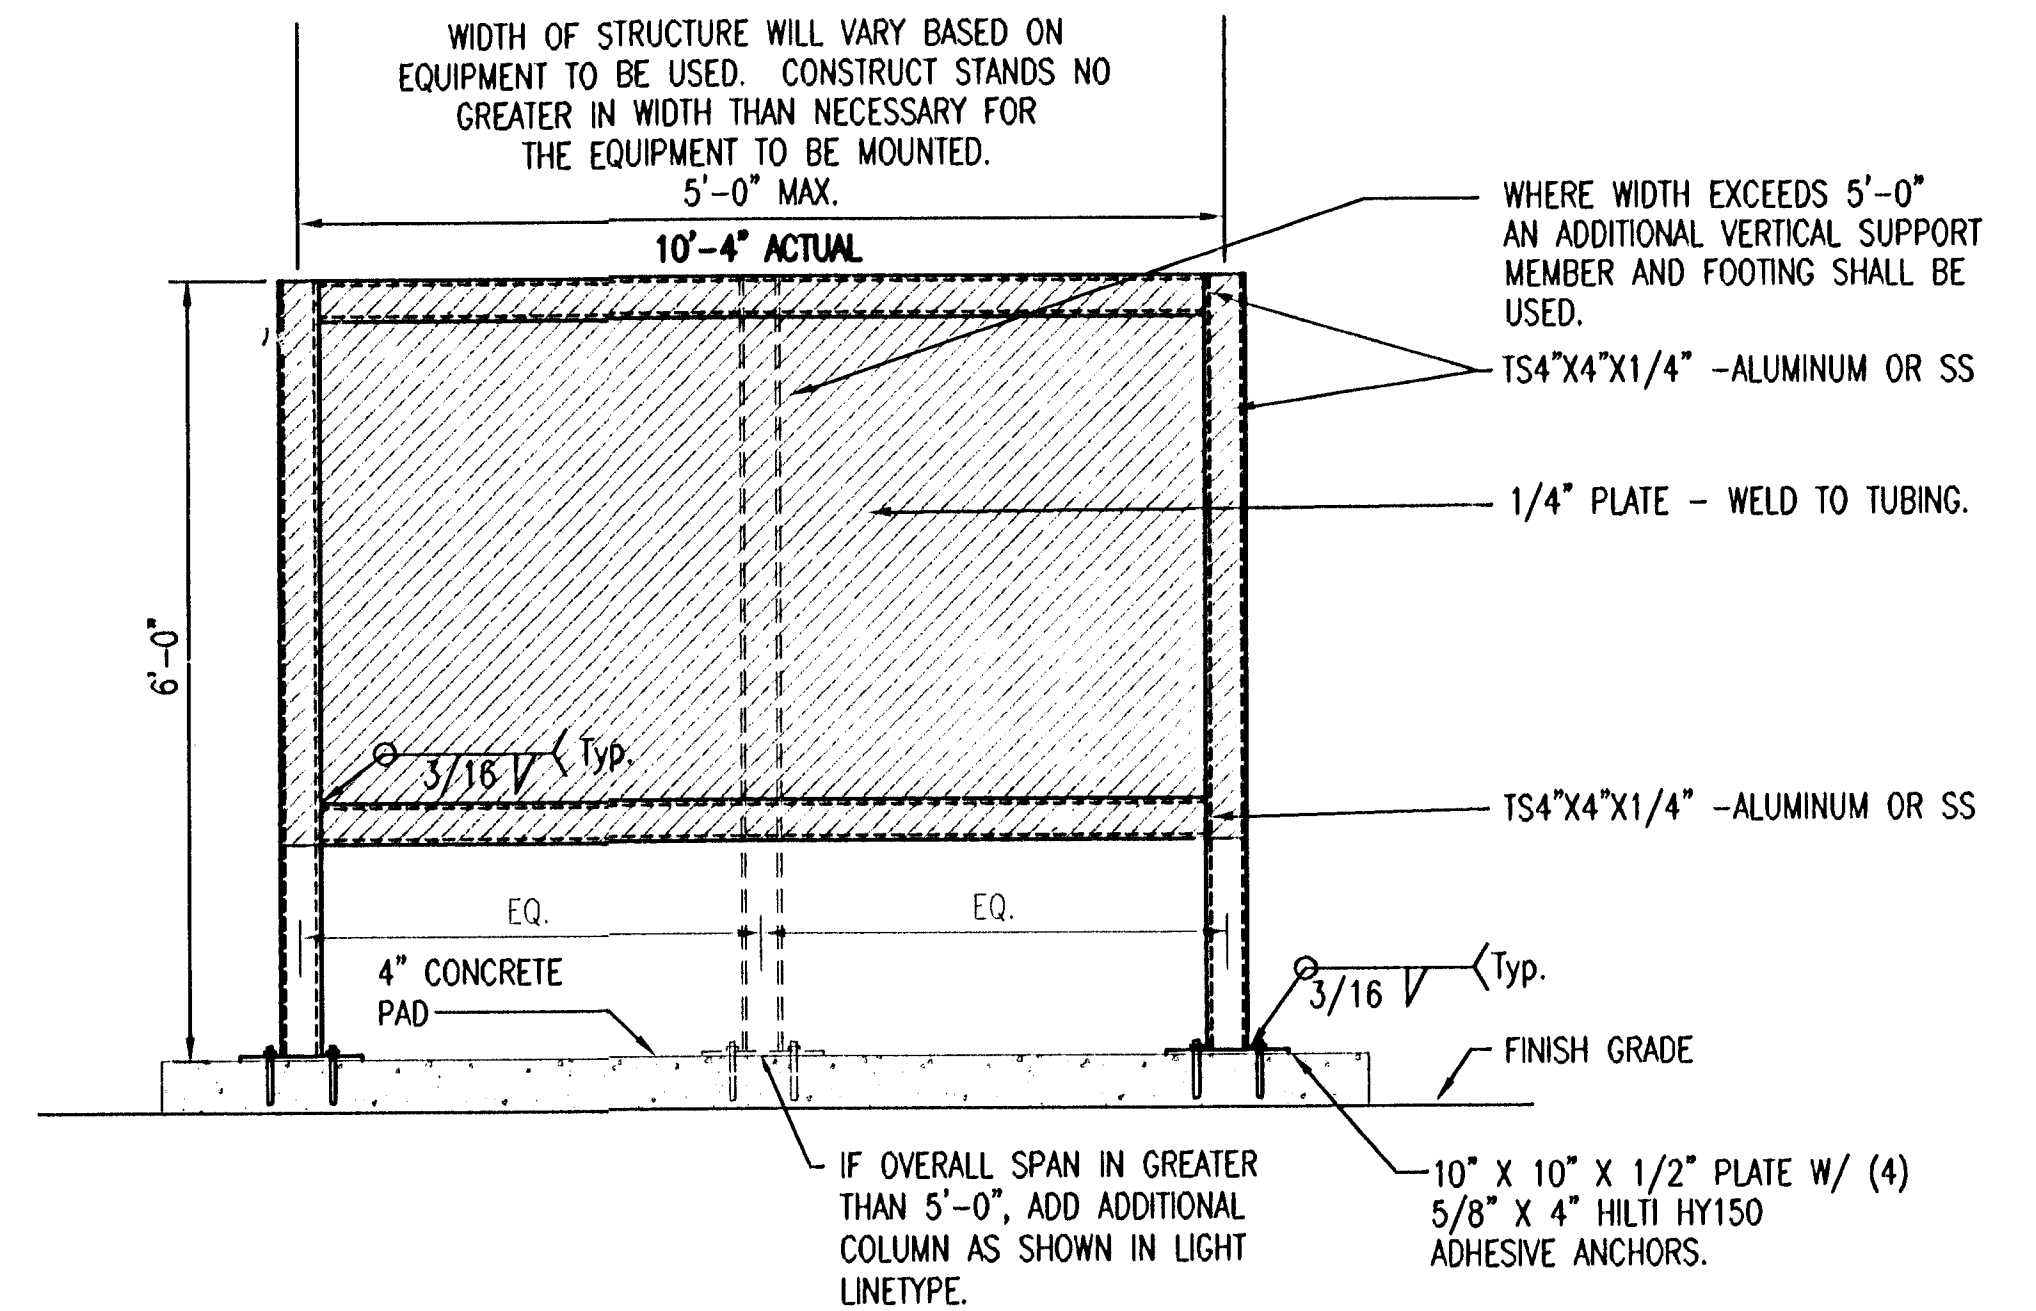

3 TYPICAL ELECTRICAL STRUCTURE DETAIL
NO SCALE

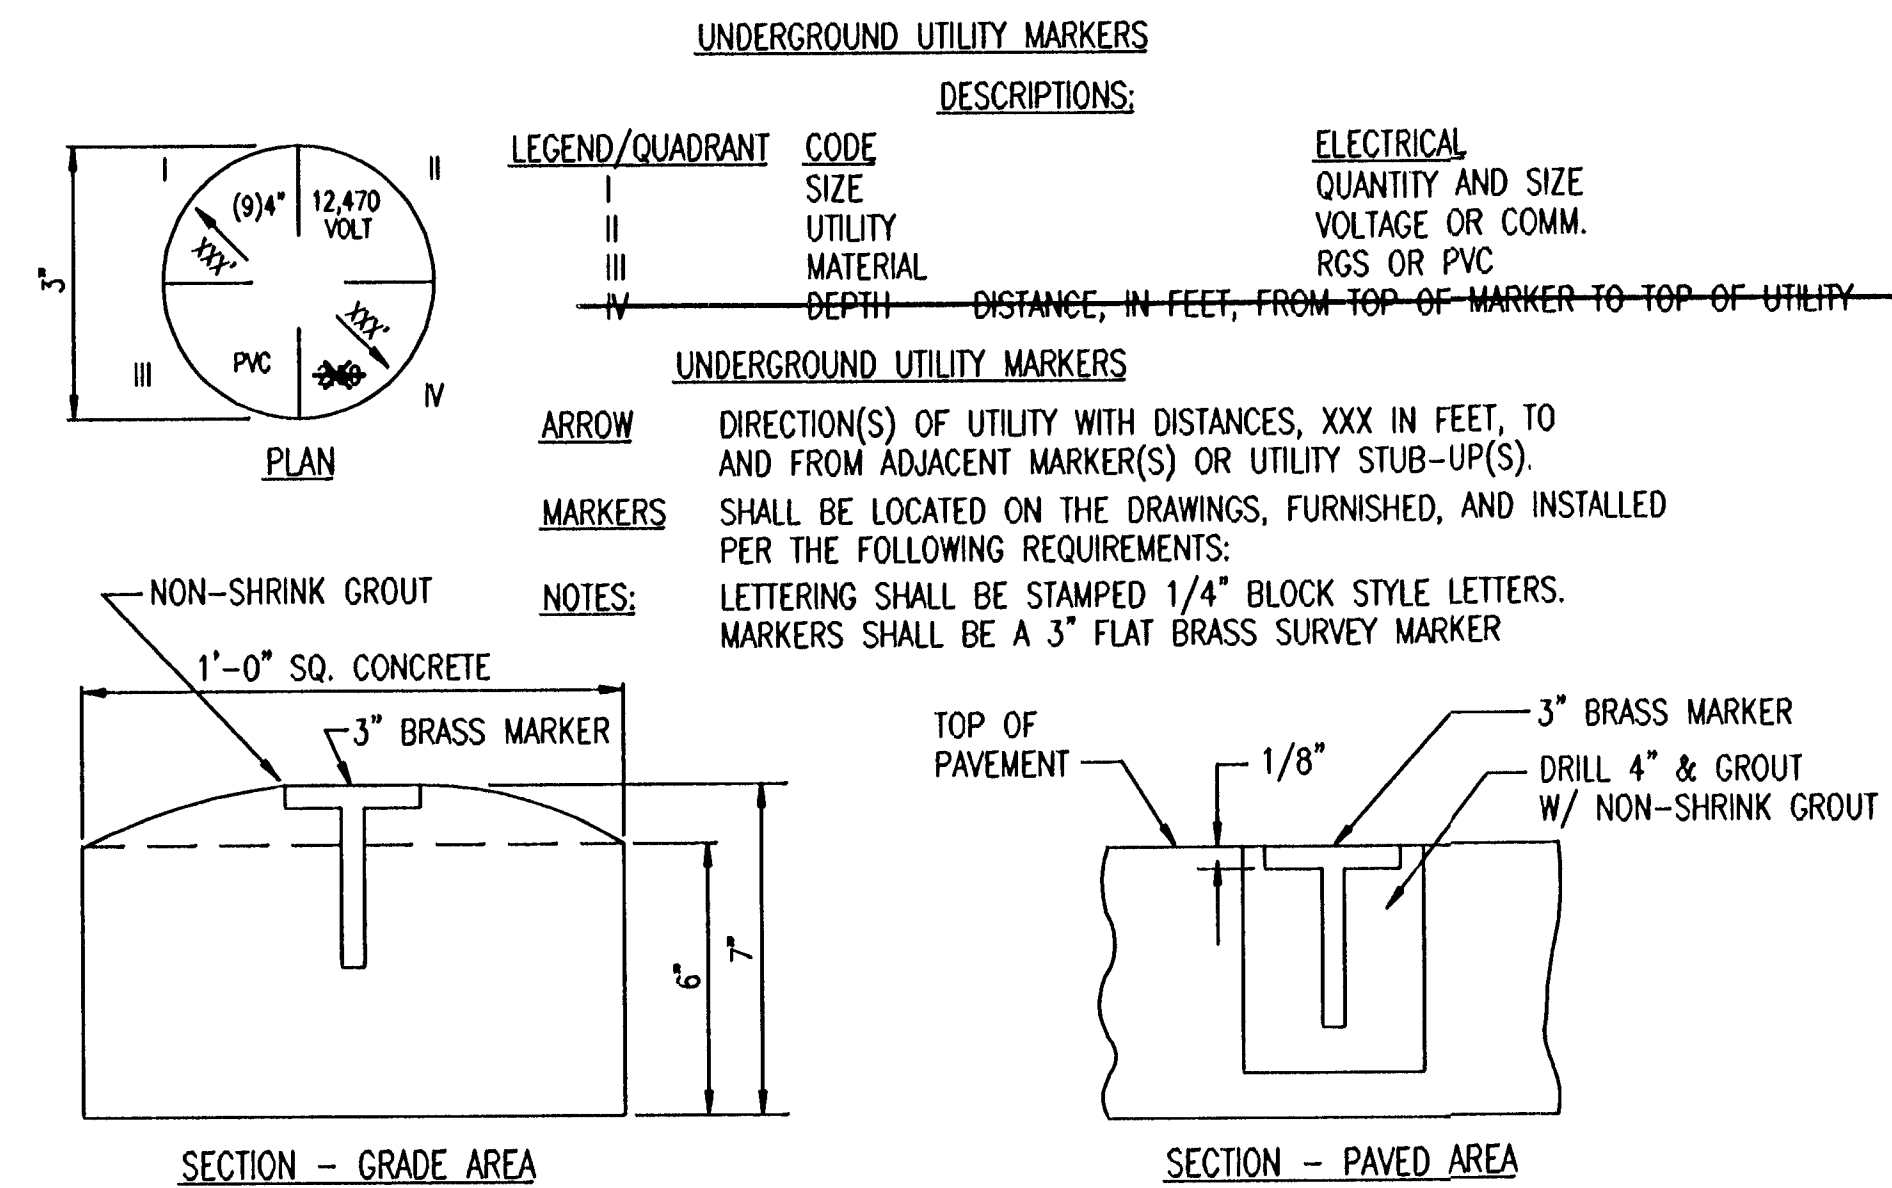

4 UTILITY MARKER DETAIL
NO SCALE

Bob E. E. E.
26 JAN 07
RECORD DRAWING

THE WICHITA AIRPORT AUTHORITY
COLONEL JAMES JABARA AIRPORT
**ELECTRICAL
DETAILS**

SANITARY SEWER AND WATER DISTRIBUTION SYSTEM
SOUTHWEST AREA SITE DEVELOPMENT IMPROVEMENTS



Professional Engineering Consultants, P.A.
303 S. TOPEKA • WICHITA, KANSAS 67202
316-262-2691 • FAX 316-262-3003

Date SEPTEMBER 2005 Job No. 05471-019