


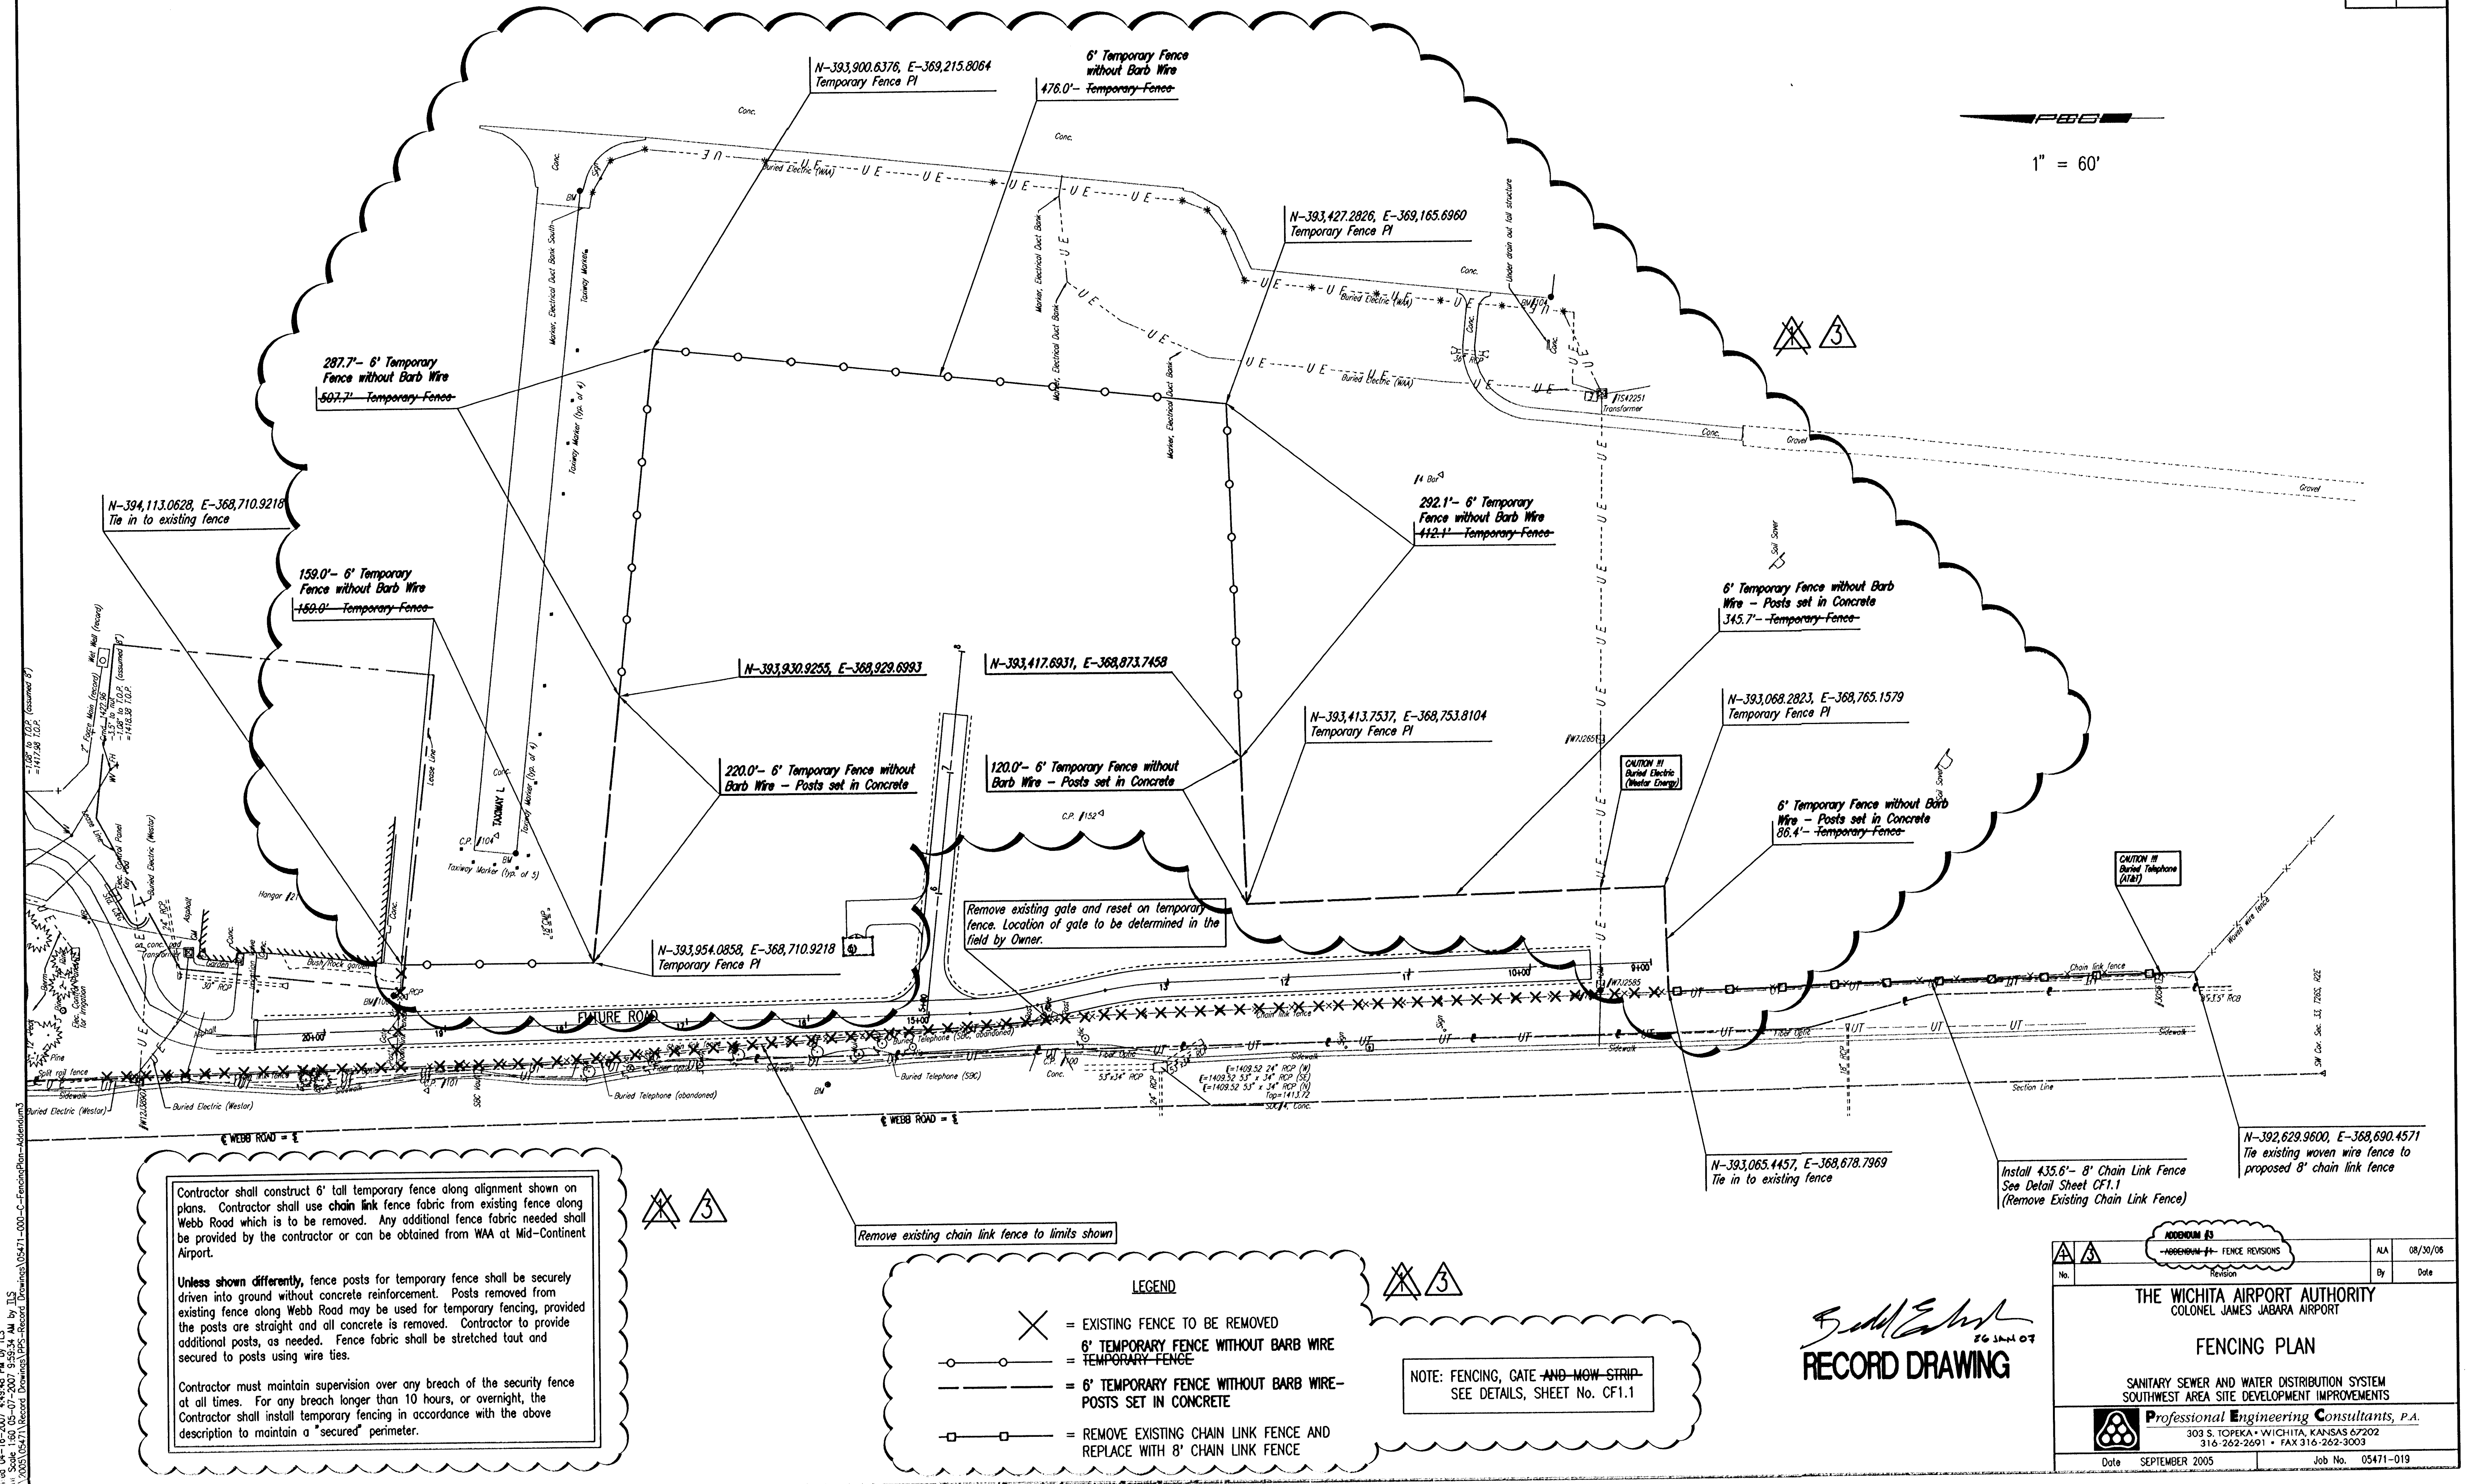

1" = 60'

Contractor shall construct 6' tall temporary fence along alignment shown on plans. Contractor shall use chain link fence fabric from existing fence along Webb Road which is to be removed. Any additional fence fabric needed shall be provided by the contractor or can be obtained from WAA at Mid-Continent Airport.

Unless shown differently, fence posts for temporary fence shall be securely driven into ground without concrete reinforcement. Posts removed from existing fence along Webb Road may be used for temporary fencing, provided the posts are straight and all concrete is removed. Contractor to provide additional posts, as needed. Fence fabric shall be stretched taut and secured to posts using wire ties.

Contractor must maintain supervision over any breach of the security fence at all times. For any breach longer than 10 hours, or overnight, the Contractor shall install temporary fencing in accordance with the above description to maintain a "secured" perimeter.

- LEGEND**
- ✕ = EXISTING FENCE TO BE REMOVED
 - = 6' TEMPORARY FENCE WITHOUT BARB WIRE
 - = 6' TEMPORARY FENCE WITHOUT BARB WIRE - POSTS SET IN CONCRETE
 - = REMOVE EXISTING CHAIN LINK FENCE AND REPLACE WITH 8' CHAIN LINK FENCE

NOTE: FENCING, GATE AND MOW STRIP - SEE DETAILS, SHEET No. CF1.1

RECORD DRAWING

REVISIONS		ALA	08/30/06
No.	Revision	By	Date
1	1		
THE WICHITA AIRPORT AUTHORITY COLONEL JAMES JABARA AIRPORT			
FENCING PLAN			
SANITARY SEWER AND WATER DISTRIBUTION SYSTEM SOUTHWEST AREA SITE DEVELOPMENT IMPROVEMENTS			
Professional Engineering Consultants, P.A. 303 S. TOPEKA • WICHITA, KANSAS 67202 316-262-2691 • FAX 316-262-3003			
Date SEPTEMBER 2005		Job No. 05471-019	