


BENCHMARK:
Railroad Spike in East Face of
Power Pole, East of the NE Corner
of Lot 3, Northridge Plaza Addition
on East Side of Ridge Road
Elev. = 1335.05 M.S.L.


NORTH RIDGE PLAZA
ADDITION
LOT #3

Sta 0+00.0, Begin Line 2
Begin construction of 15"
RCP w/ end section.

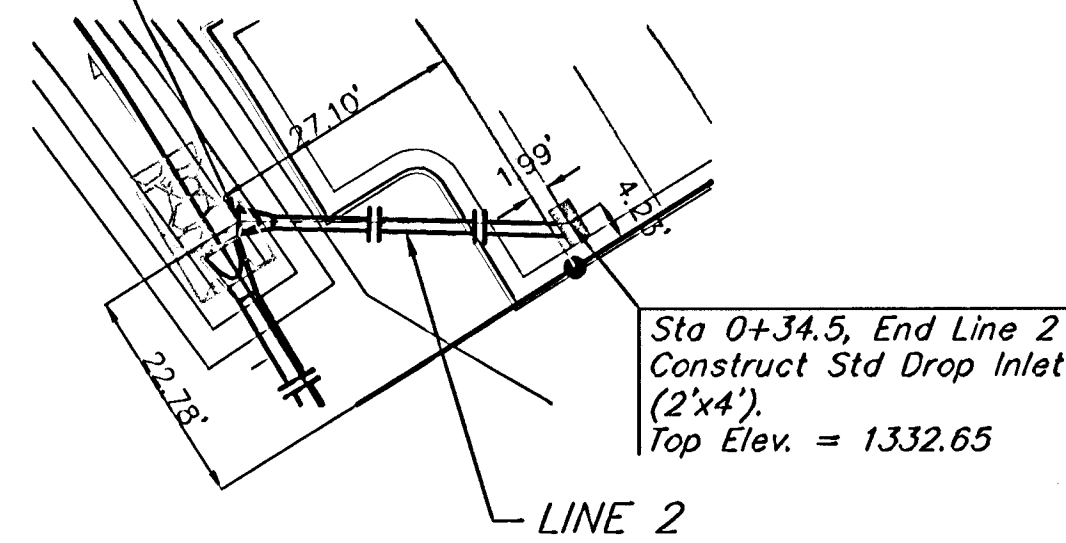

Sta 0+00.0, Begin Line 3
Begin construction of 12"
RCP w/ end section.
5 S.Y. light stone rip-rap.


CAUTION!
Ex. 10" SS
Crossing

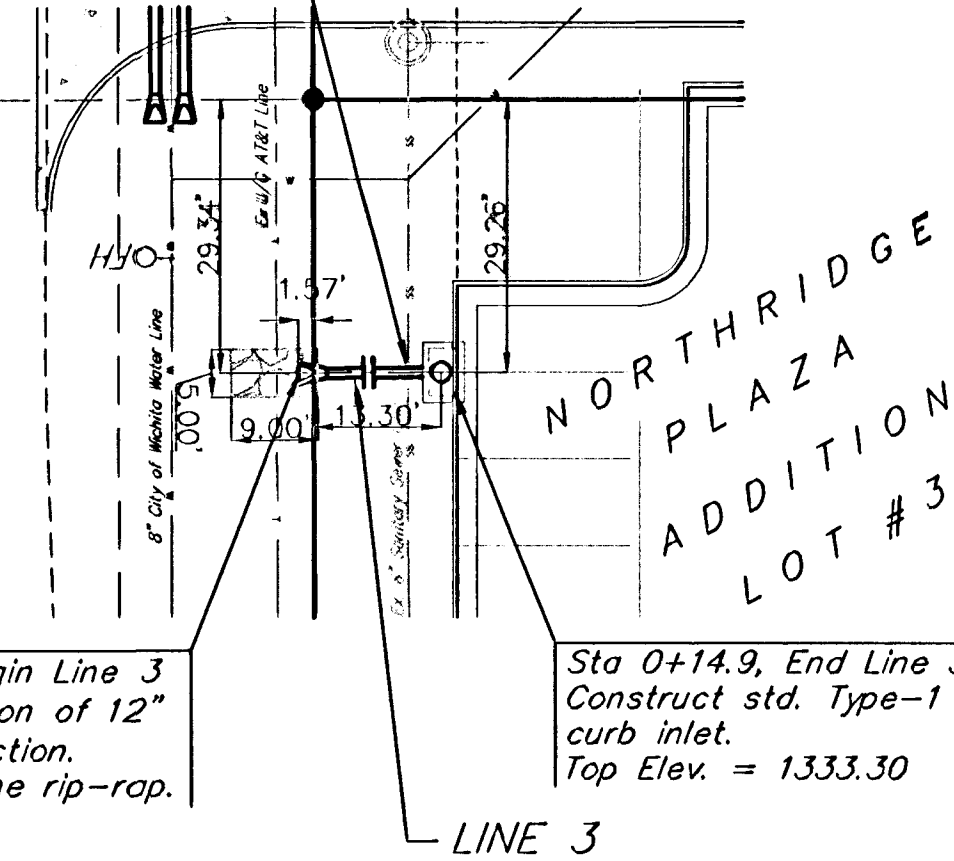

Sta 0+14.9, End Line 3
Construct std. Type-1
curb inlet.
Top Elev. = 1333.30

Sta 0+00.0, Begin Line 3
Begin construction of 12"
RCP w/ end section.
5 S.Y. light stone rip-rap.


CAUTION!
Ex. 10" SS
Crossing

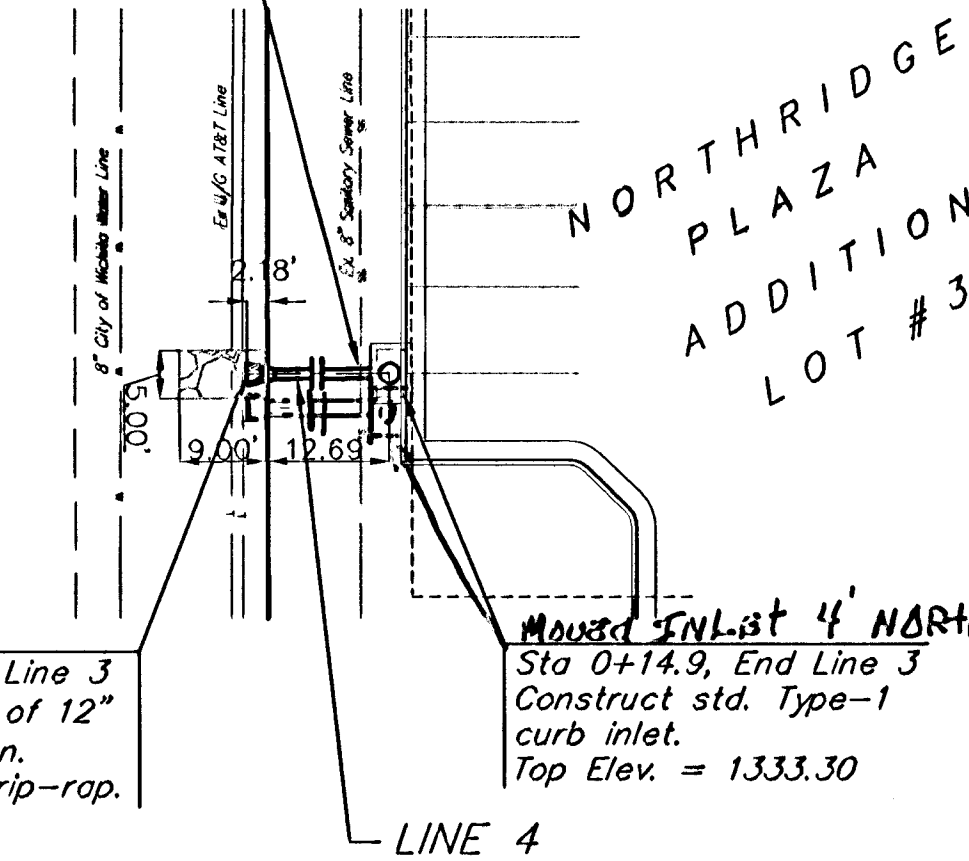

Sta 0+14.9, End Line 3
Construct std. Type-1
curb inlet.
Top Elev. = 1333.30

Sta 0+00, Begin Line 5
Extend 15" RCP Pipe North


CAUTION!
Ex. 8" WTR
Crossing

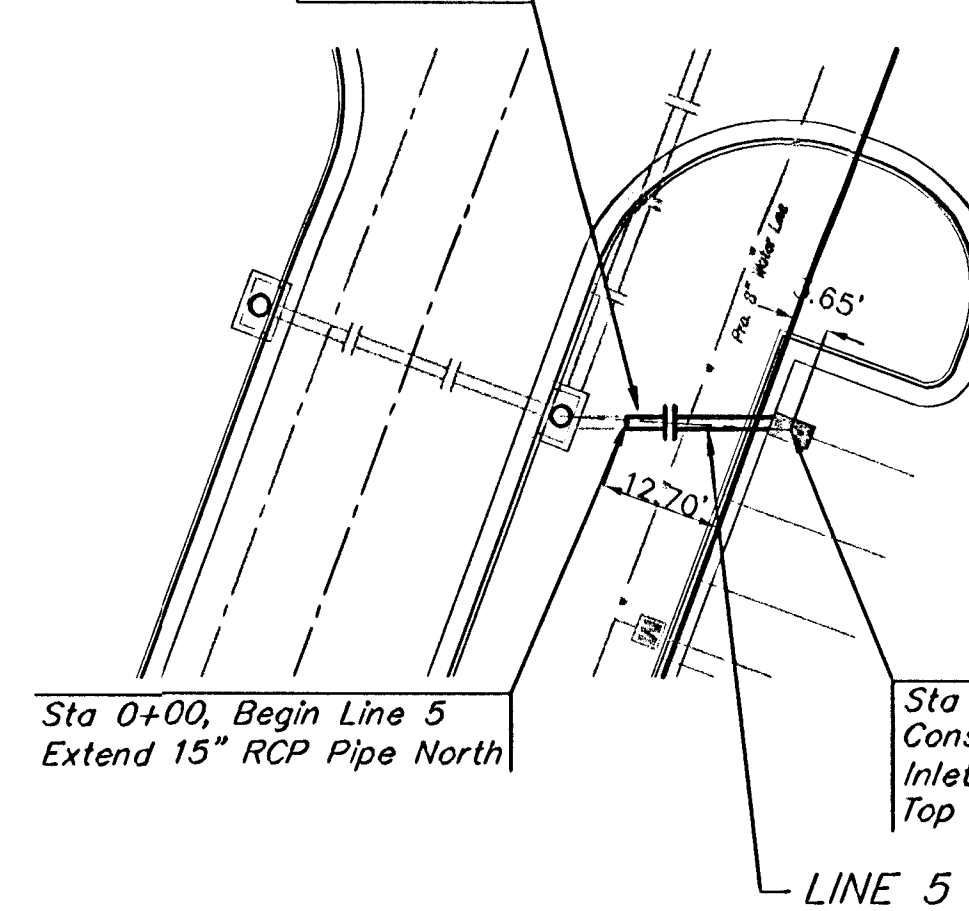

Sta 0+19, End Line 5
Construct Std. Drop
Inlet (2'x4')
Top Elev. = 1332.65

Scale: 1" = 20' Horizontal
1" = 5' Vertical
● = Iron

NORTH RIDGE PLAZA
ADDITION
LOT #3

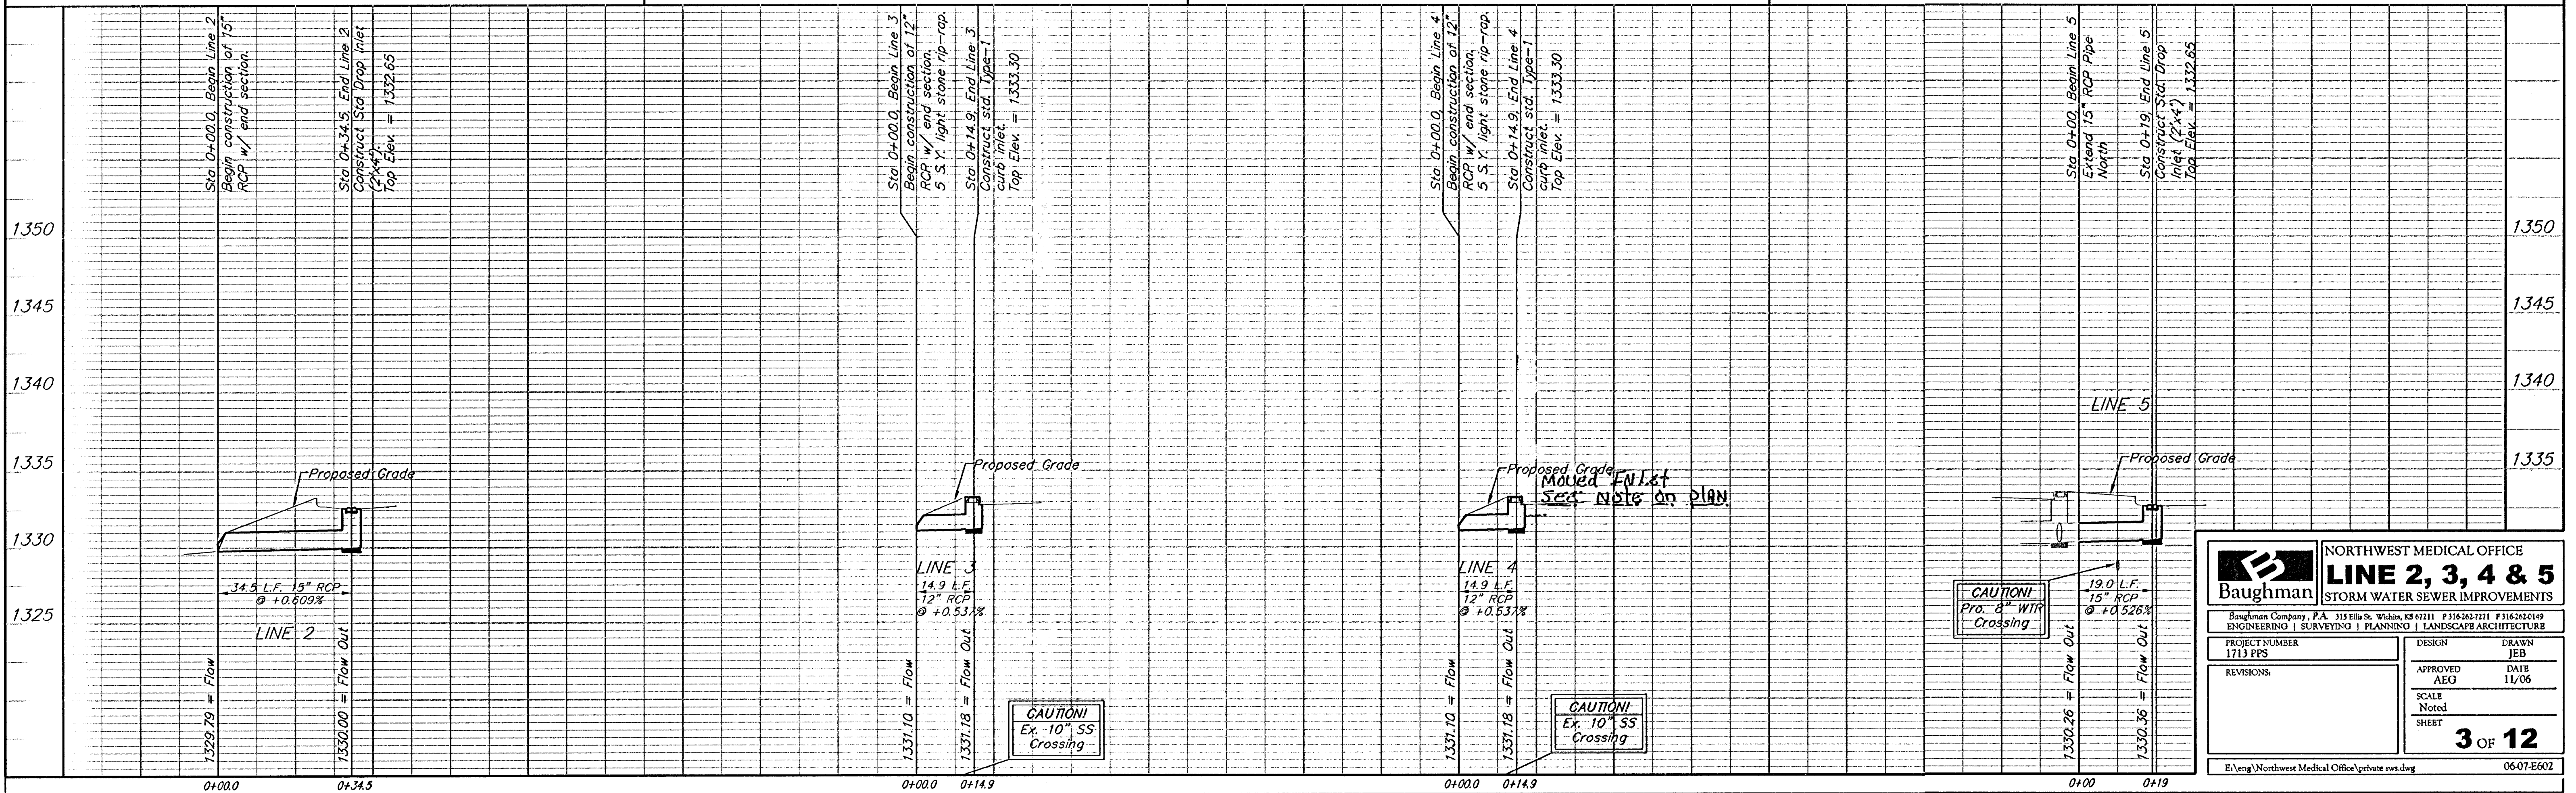

NORTHWEST MEDICAL OFFICE LINE 2, 3, 4 & 5 STORM WATER SEWER IMPROVEMENTS	
Baughman Company, P.A. 315 Ellis St. Wichita, KS 67211 P 316-262-7271 F 316-262-0149 ENGINEERING SURVEYING PLANNING LANDSCAPE ARCHITECTURE	
PROJECT NUMBER 1713 PPS	DESIGN JEB
REVISIONS	APPROVED AEO
SCALE Noted SHEET	
3 OF 12	
\\Veng\Northwest Medical Office\private swn.dwg 06-07-E602	

NORTHWEST MEDICAL OFFICE AS-BUILTS 5-7-07
T.H./CED