

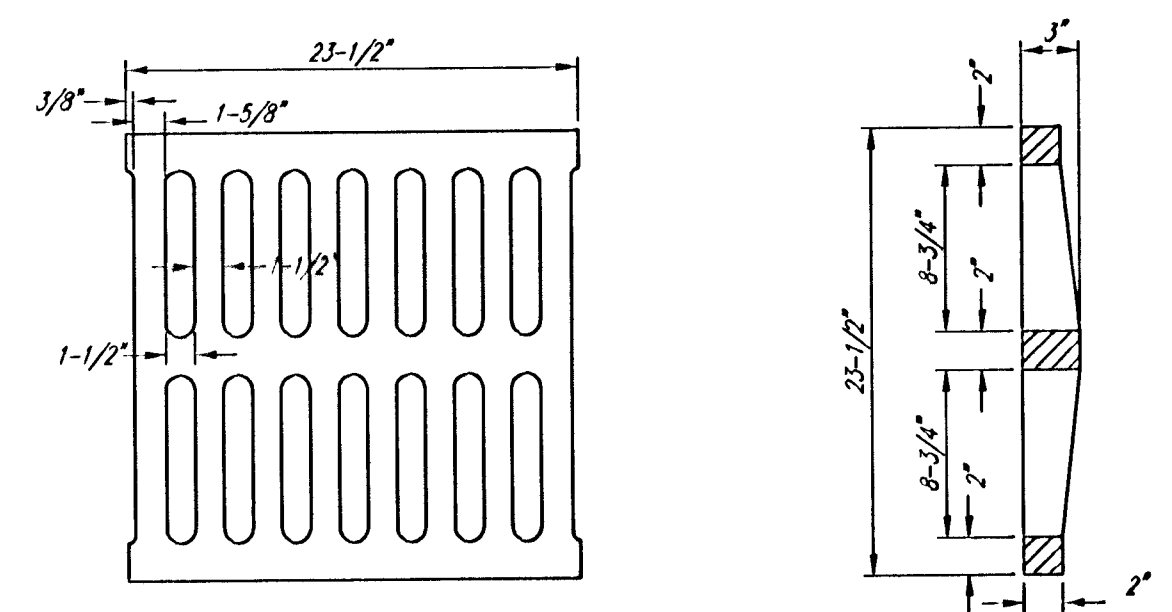


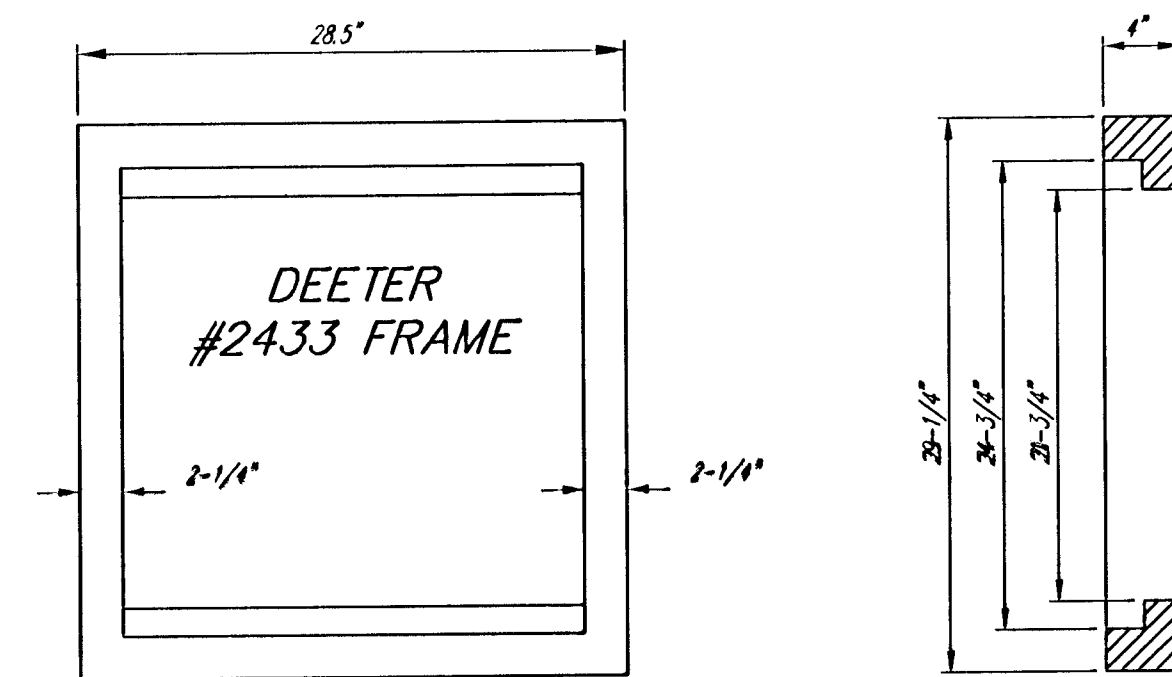




DEETER #2433 GRATE

24" x 24" Frame and Grate Detail

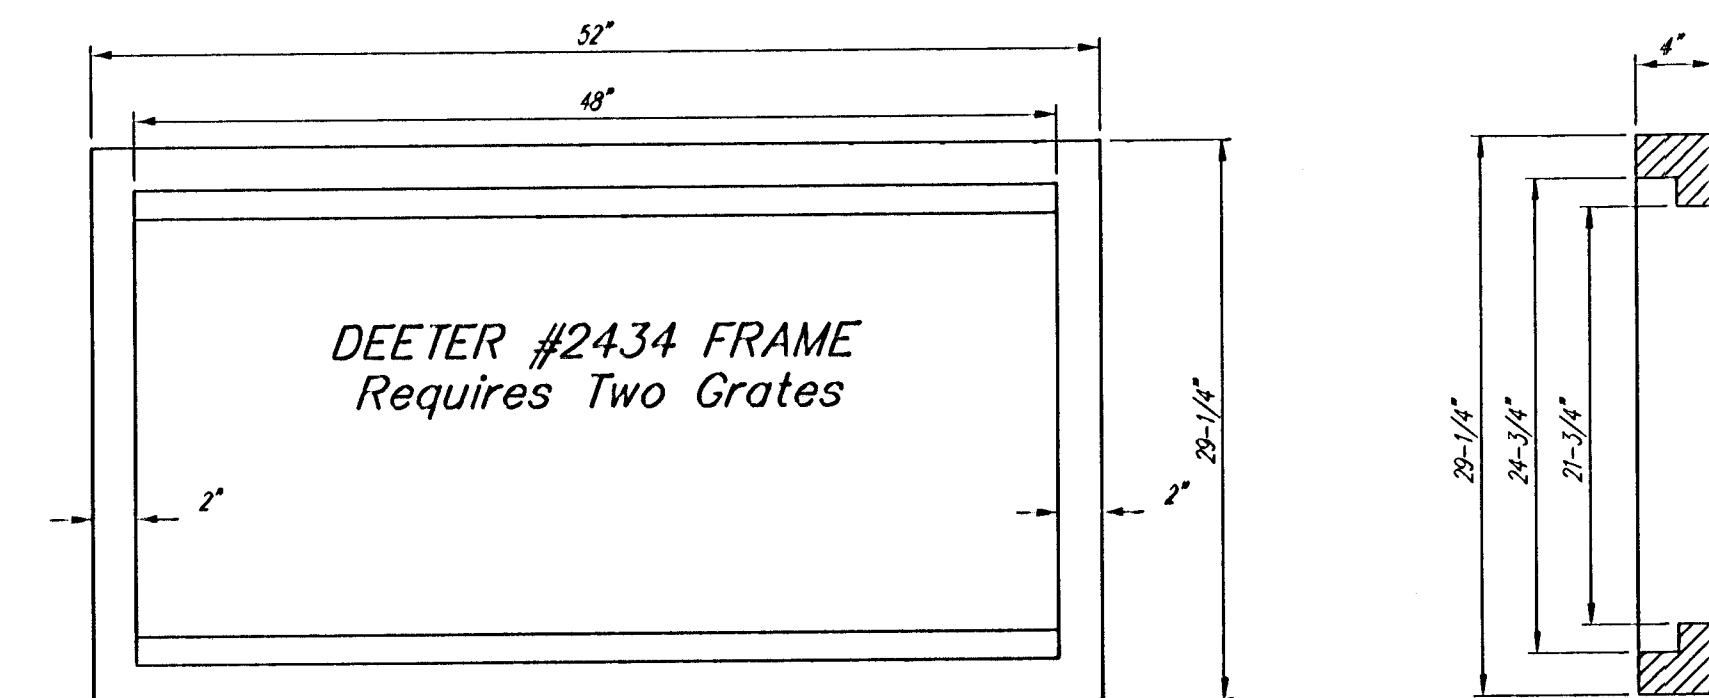

Double 24" x 24" Frame Detail

NOTE: Grates shall be imprinted on the top surface with "CITY OF WICHITA" using letters at least 1" in height. Other marking methods may be approved by the engineer.

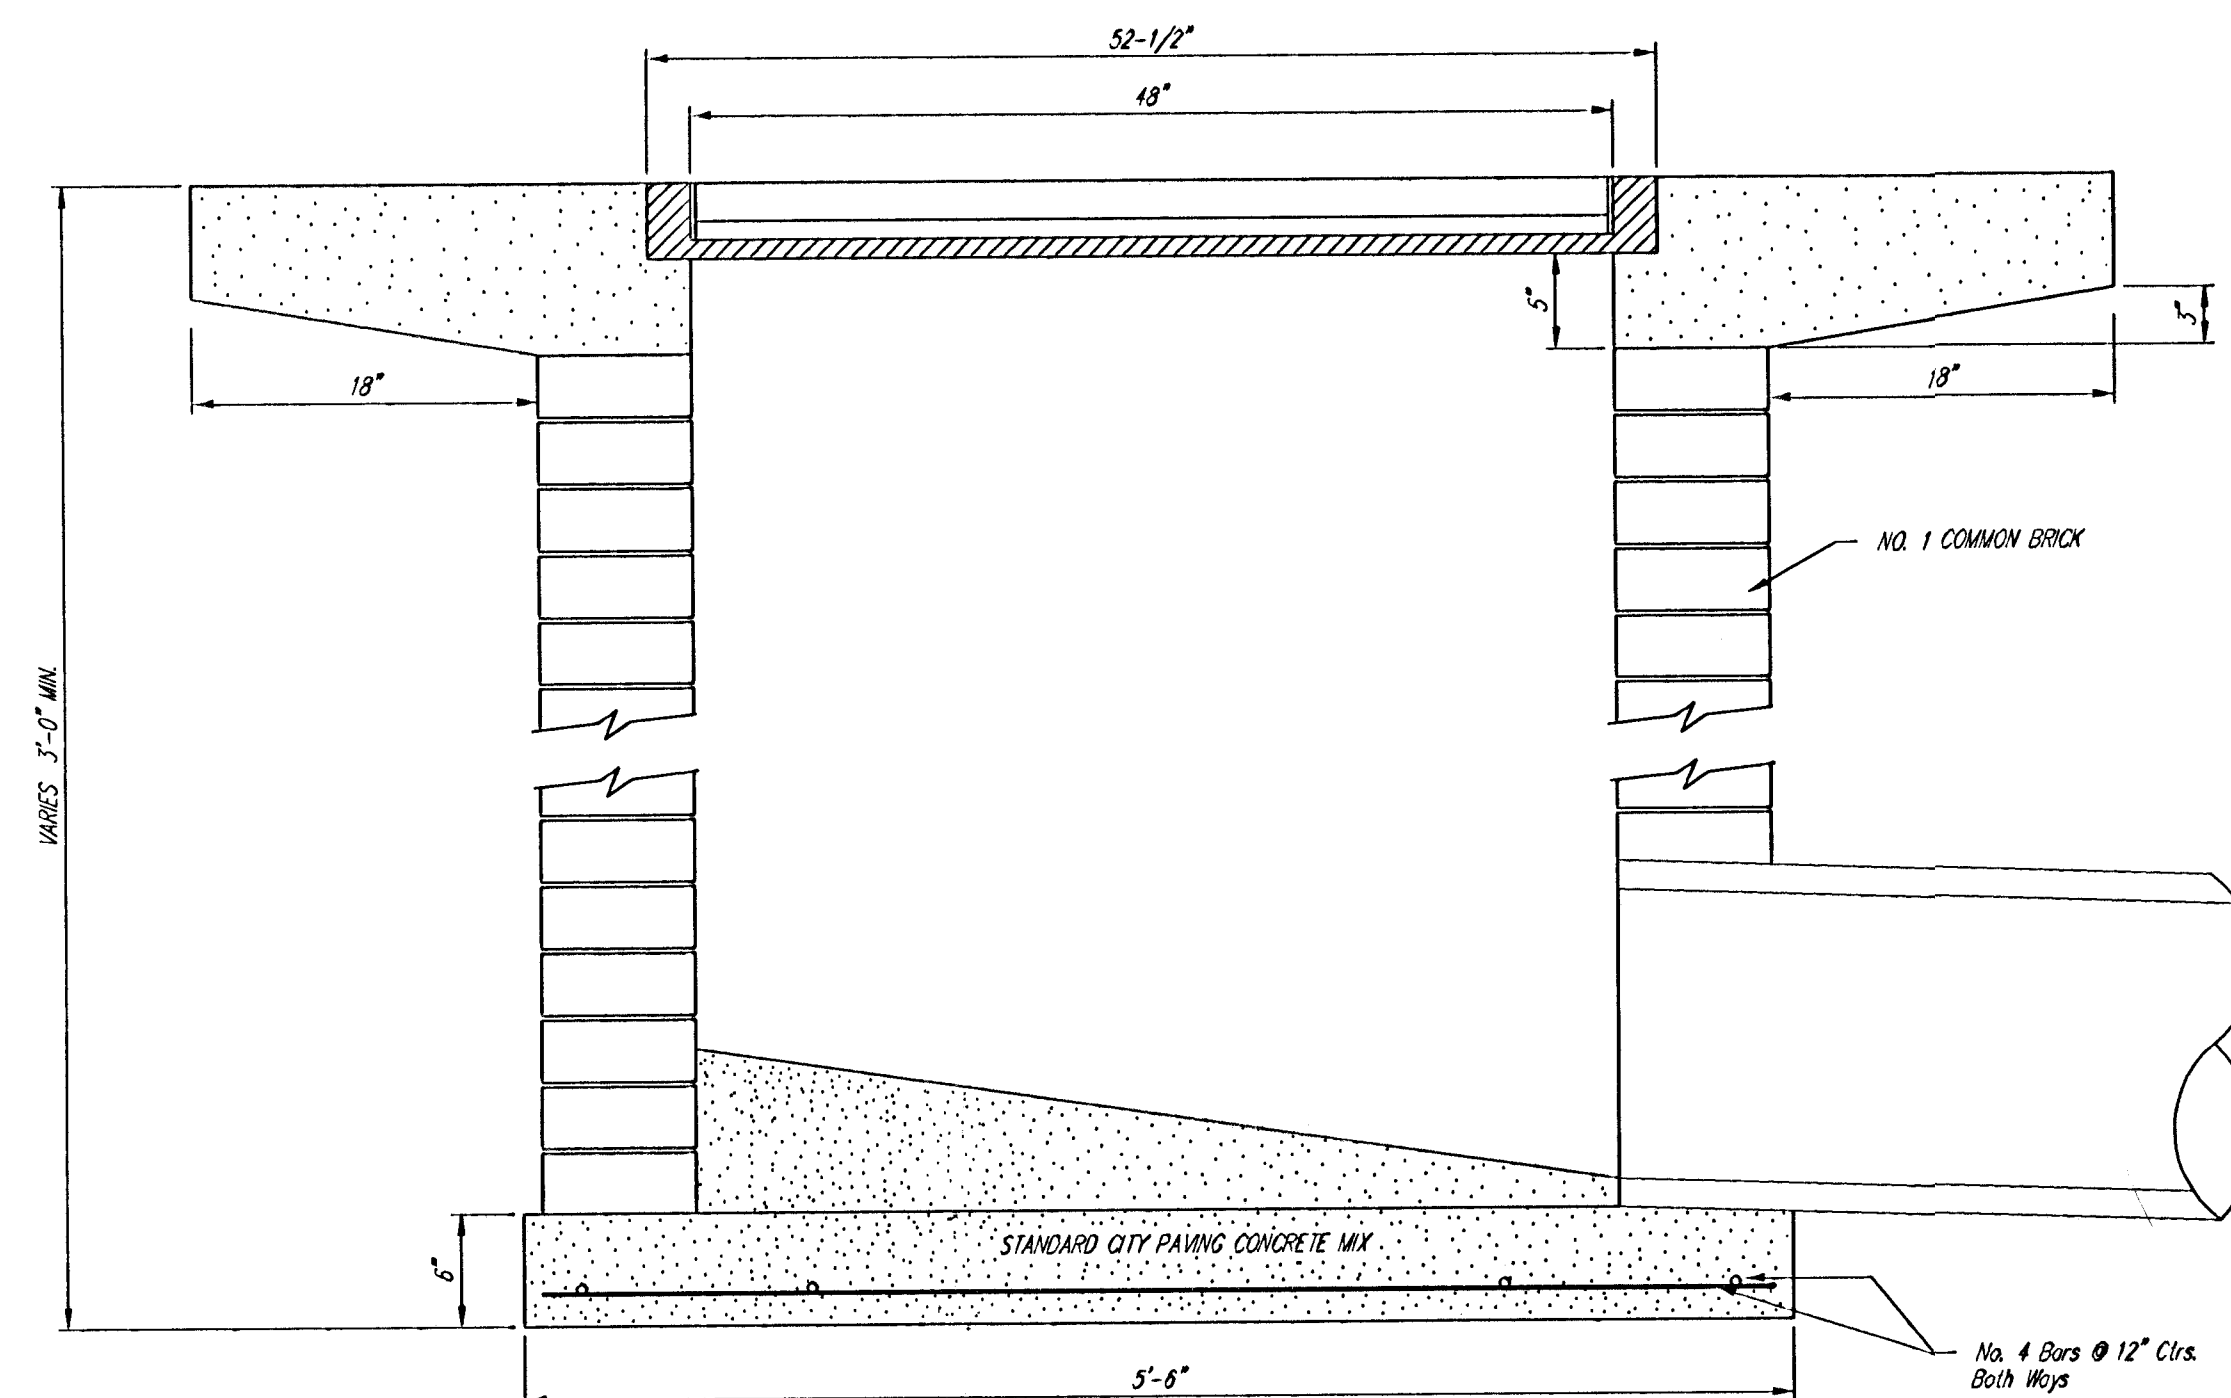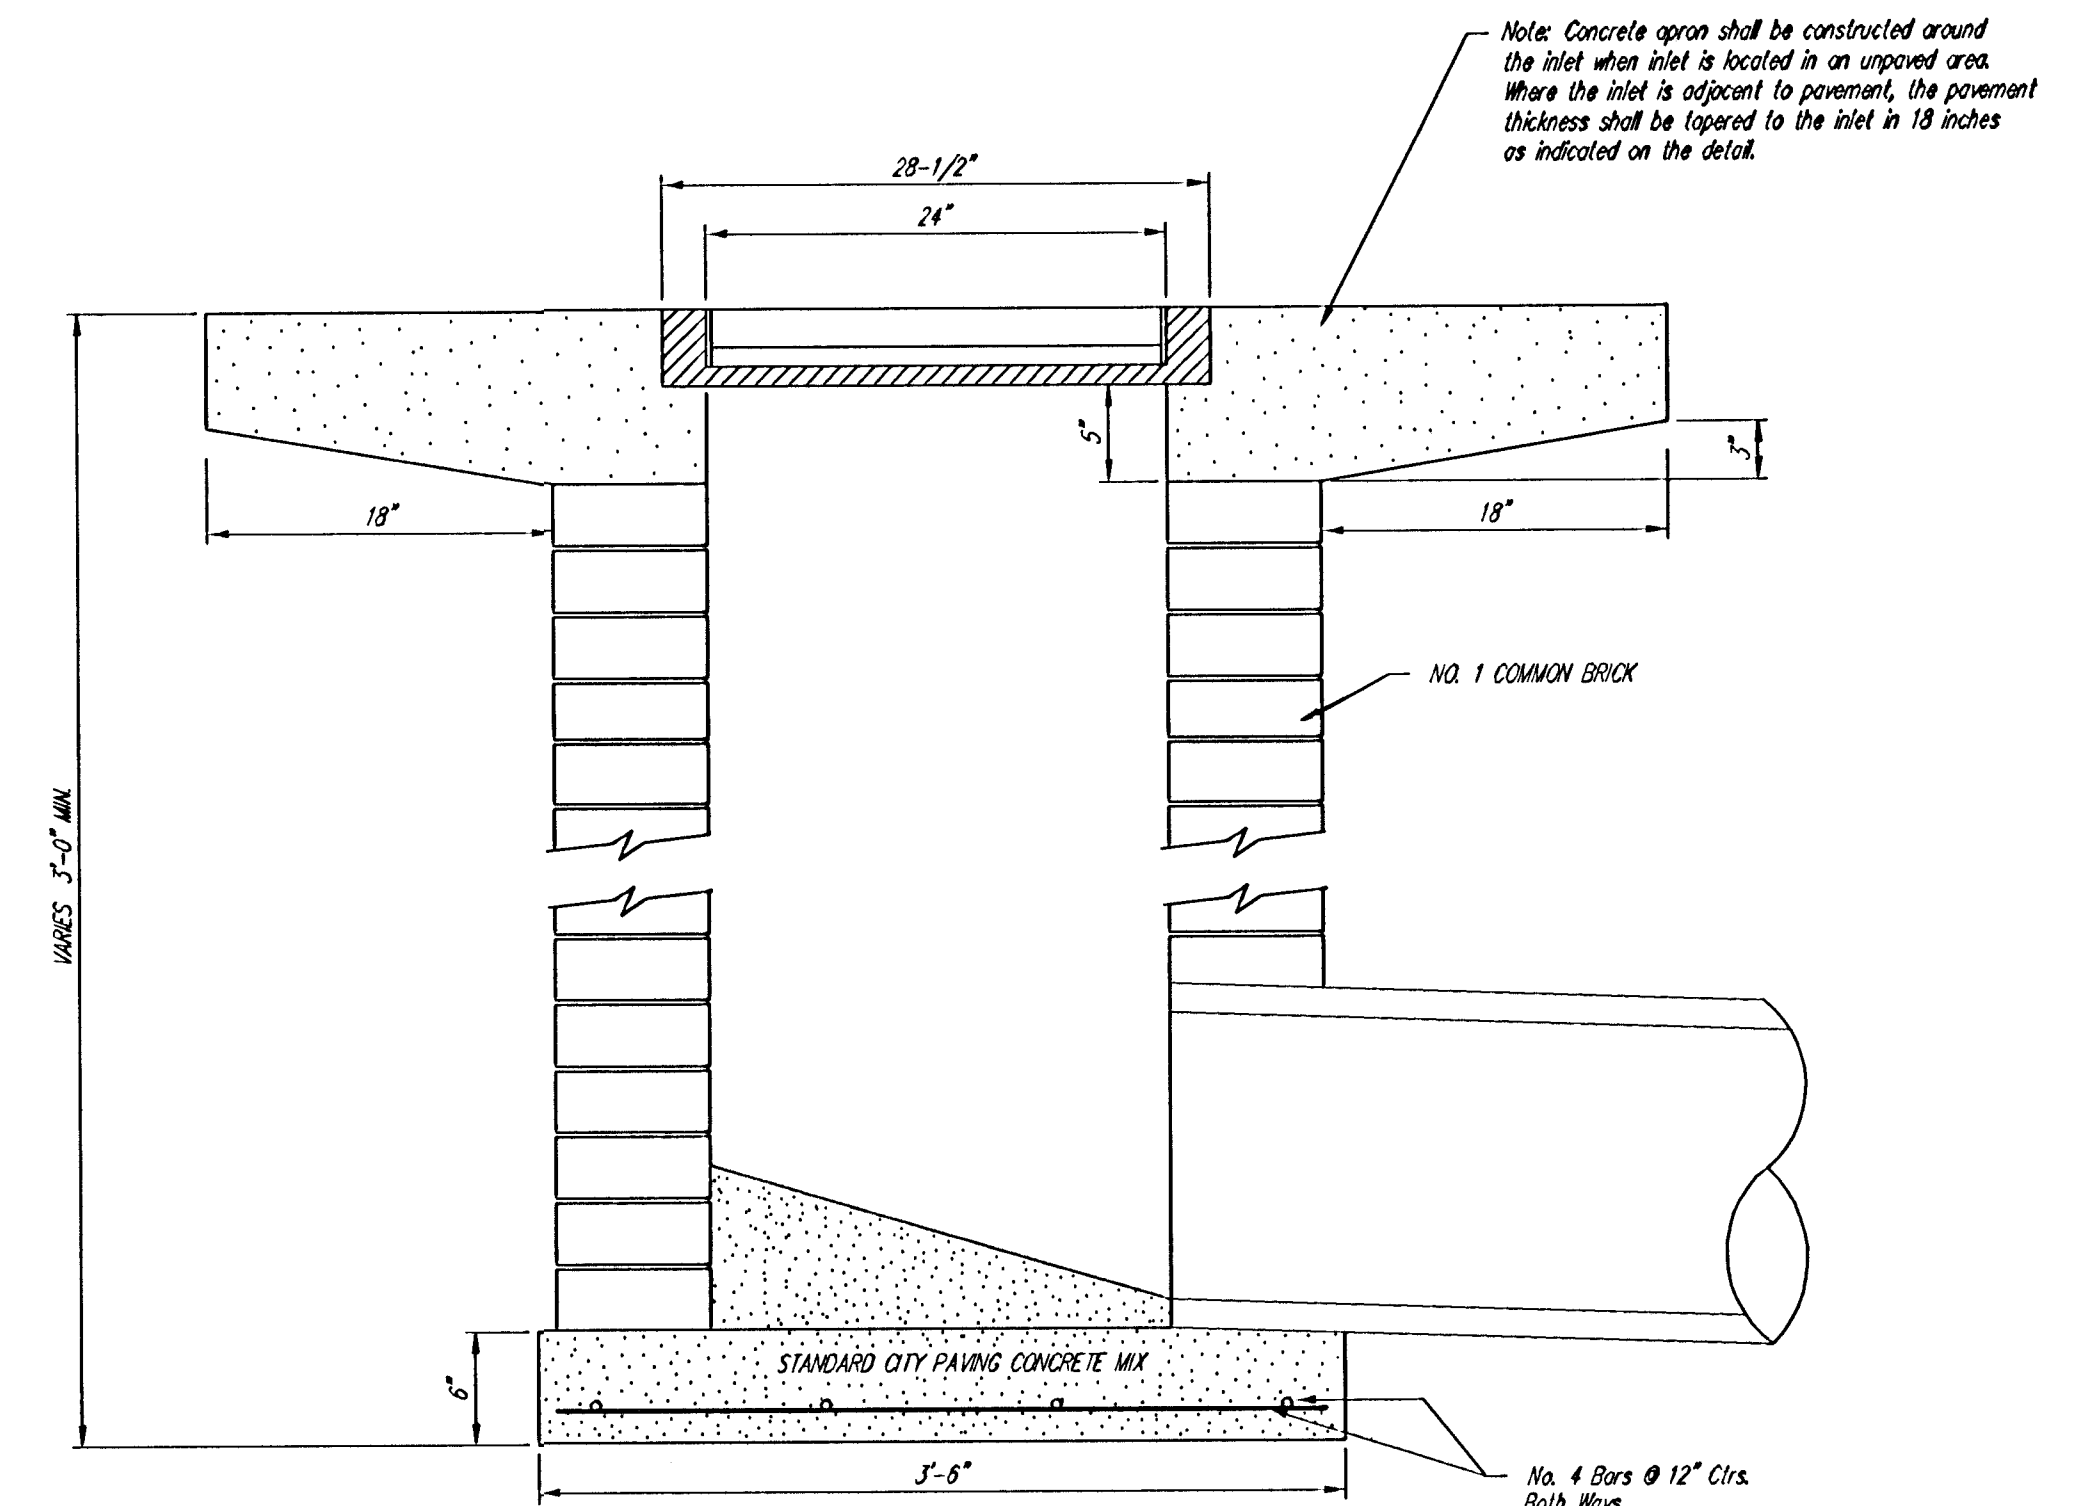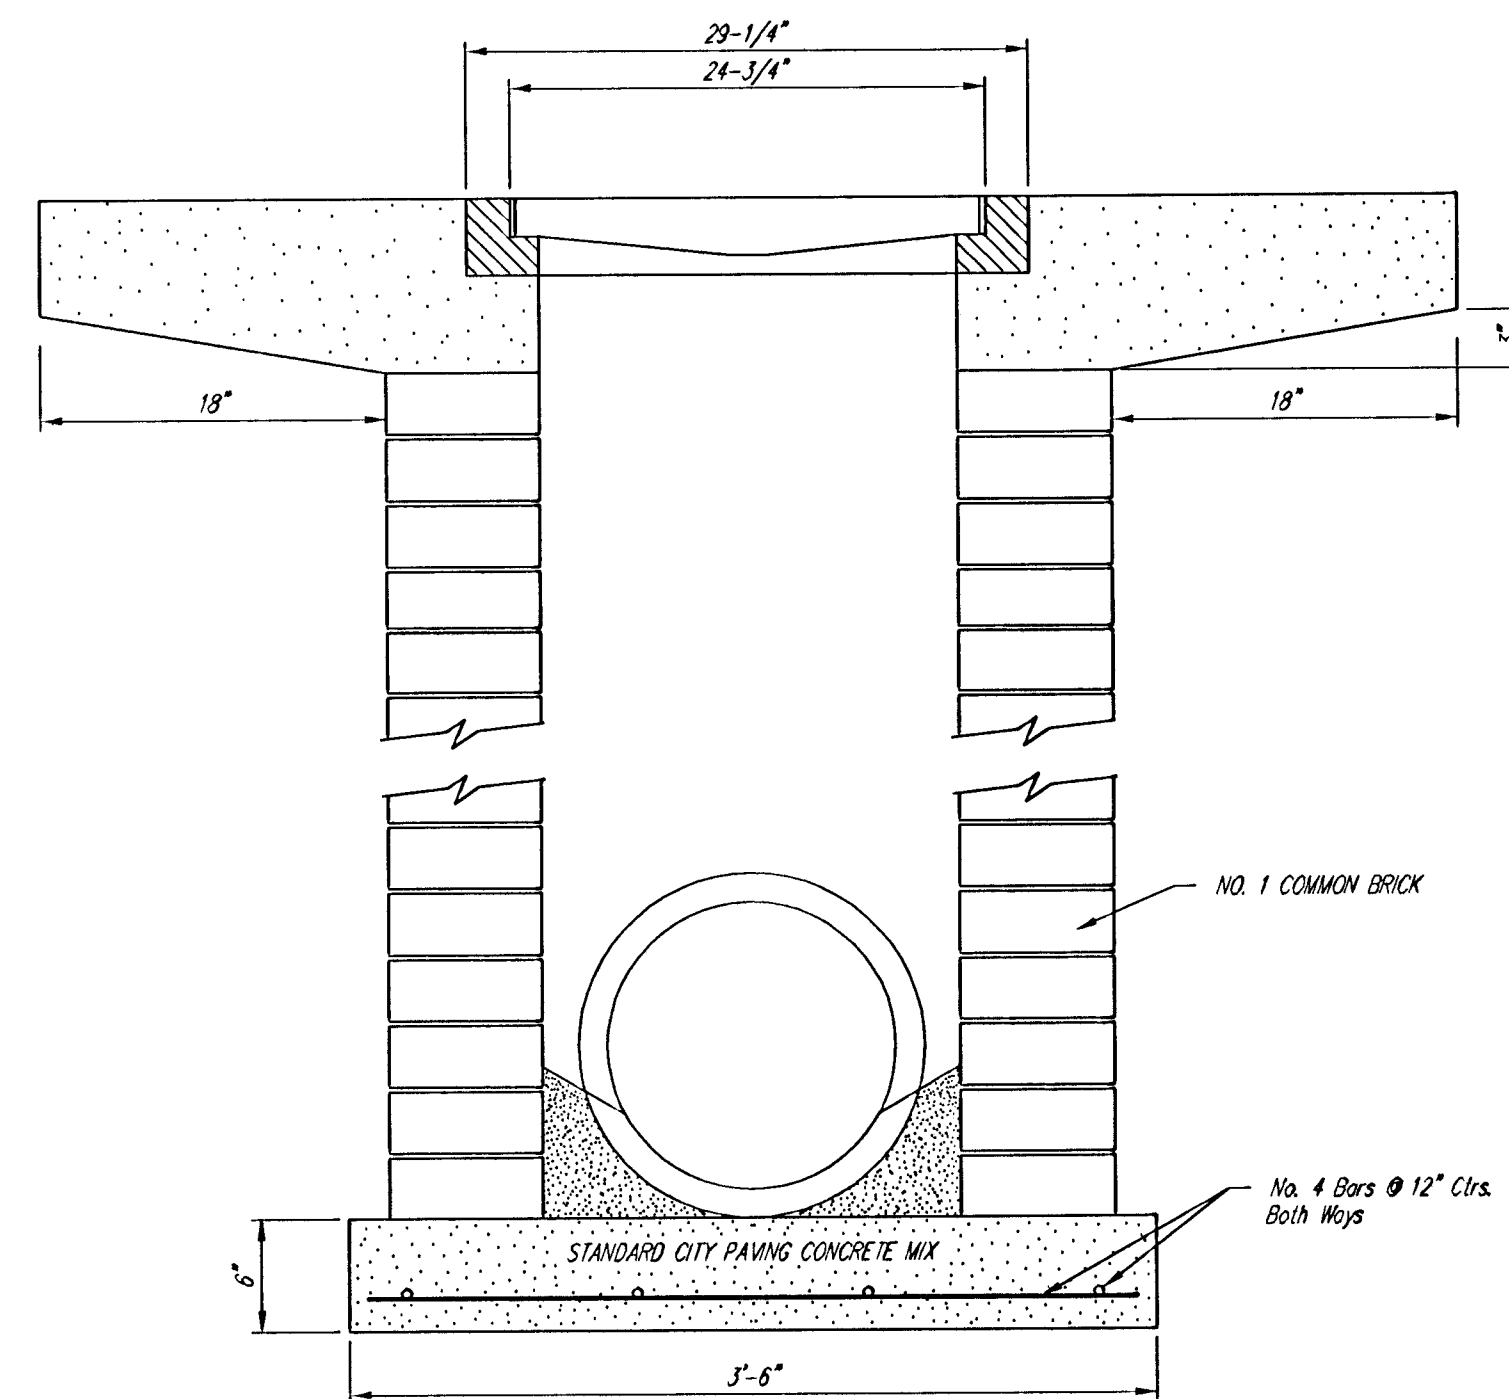

		City of Wichita Standard	
		Drop Inlet Detail	
Baughman Company, P.A. 3151 Lila St. Wichita, KS 67211 F 316-263-7271 F 316-263-8149 ENGINEERING SURVEYING PLANNING LANDSCAPE ARCHITECTURE			
PROJECT NUMBER 1713 FPS	DESIGN C.O.W.	DRAWN Staff	
REVISIONS:	APPROVED	DATE 11/06	
	SCALE None	SHEET	
		6 OF 12	
F:\Eng\Details\Sewer\DROPINT2.dwg 06-07-E602			

NORTHWEST MEDICAL OFFICE AS-BUILTS
T.H./C.E.D 5-7-07