


WATER VALVE BOX ELEVATIONS			
STREET	STATION	OFFSET	PROPOSED ELEVATION
PALMETTO	66+91.08	25.0' LI.	152.7

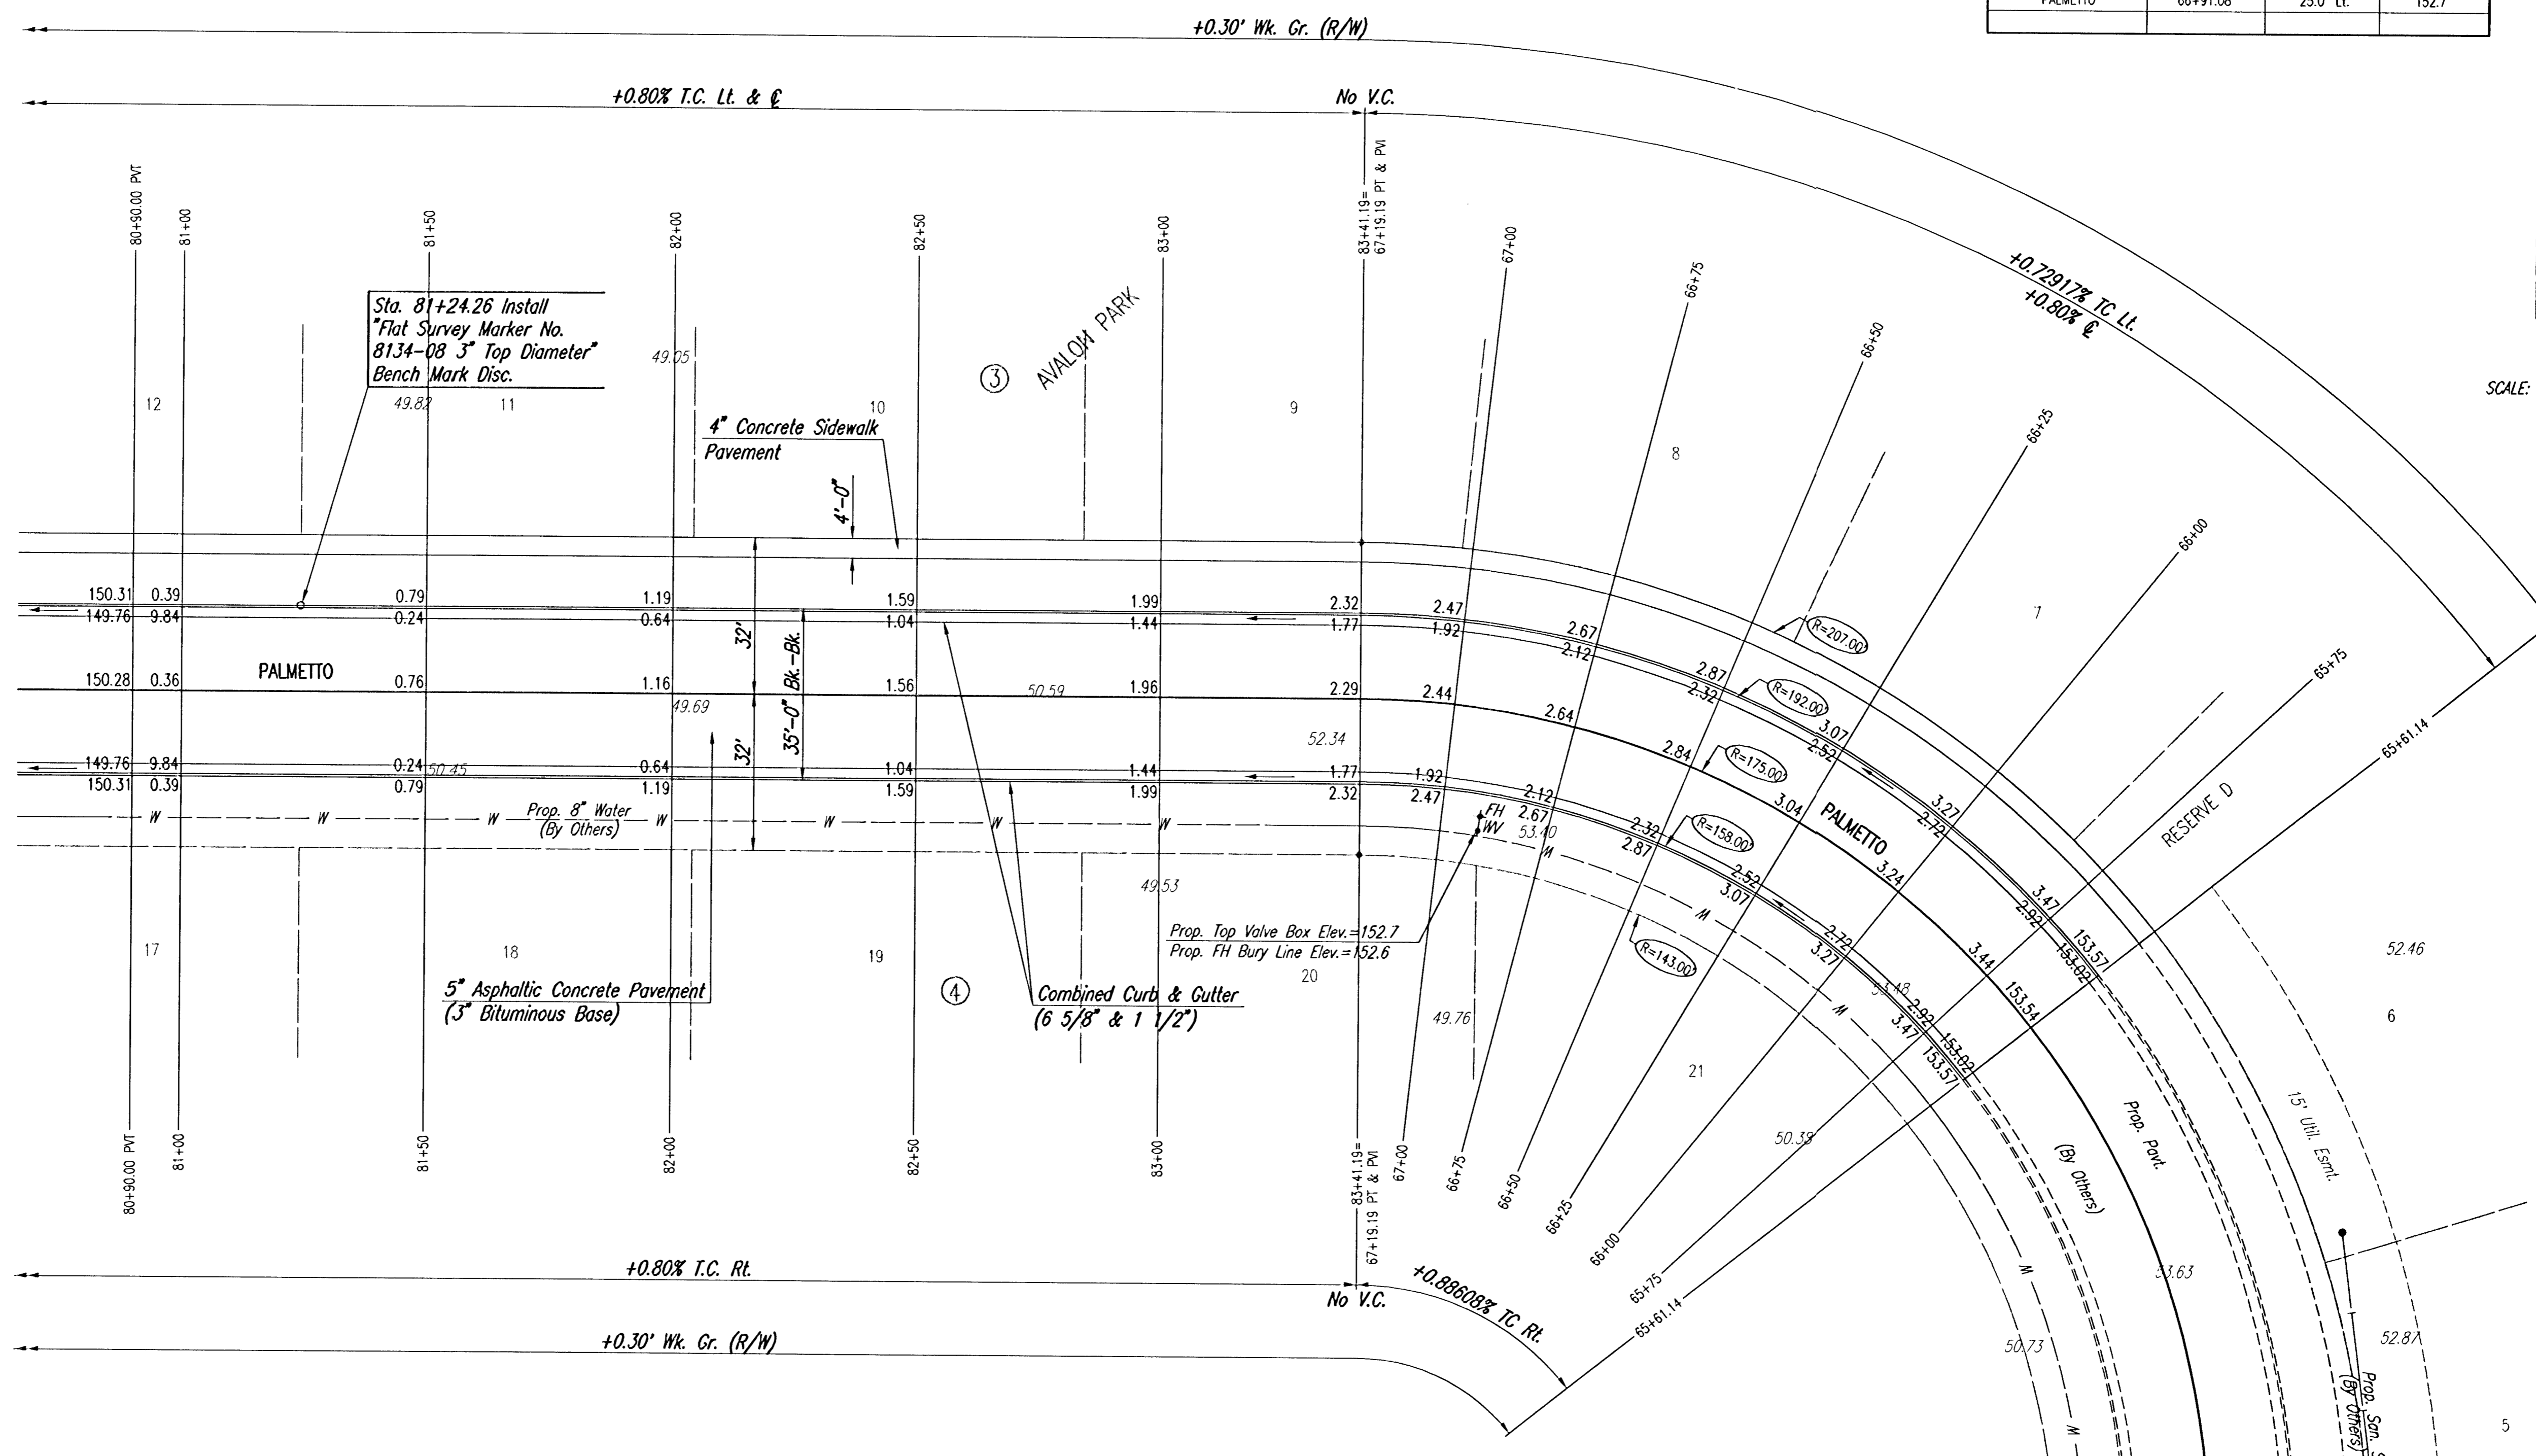

SCALE: 1"=20'

**Q CURVE DATA**


A=90°19'33.5" L D=32' 44" 25.6" R=175.00' L=275.88' T=176.00' E=73.19'

CURVE DATA BASED ON Q radius Δ/2= 45° 9' 46.5"

Q STATION	Q ARC LENGTH	FACE CURB LENGTH		CHORD LENGTH		DEFLECTION ANGLE	Q TOTAL DEFLECTION
		LEFT CURB	RIGHT CURB	8' OFF LEFT FACE CURB	8' OFF RIGHT FACE CURB		
64+43.31						0°00'00.0"	0°00'00.0"
64+50.00	6.69'	6.04'	7.34'	5.73'	7.65'	01°05'42.6"	01°05'42.6"
64+65.00	15.00'	13.54'	16.46'	12.85'	17.14'	02°27'19.9"	03°33'02.5"
64+75.00	10.00'	9.03'	10.97'	8.57'	11.43'	01°38'13.3"	05°11'15.8"
65+00.00	25.00'	22.57'	27.43'	21.41'	28.55'	04°05'33.2"	09°16'49.0"
65+25.00	25.00'	22.57'	27.43'	21.41'	28.55'	04°05'33.2"	13°22'22.2"
65+50.00	25.00'	22.57'	27.43'	21.41'	28.55'	04°05'33.2"	17°27'55.5"
65+61.14	11.14'	10.06'	12.22'	9.55'	12.73'	01°49'25.1"	19°17'20.6"
65+75.00	13.86'	12.51'	15.21'	11.88'	15.84'	02°16'08.1"	21°33'28.7"
66+00.00	25.00'	22.57'	27.43'	21.41'	28.55'	04°05'33.2"	25°39'01.9"
66+25.00	25.00'	22.57'	27.43'	21.41'	28.55'	04°05'33.2"	29°44'35.1"
66+50.00	25.00'	22.57'	27.43'	21.41'	28.55'	04°05'33.2"	33°50'08.3"
66+75.00	25.00'	22.57'	27.43'	21.41'	28.55'	04°05'33.2"	37°55'41.5"
67+00.00	25.00'	22.57'	27.43'	21.41'	28.55'	04°05'33.2"	42°01'14.7"
67+19.19	19.19'	17.33'	21.06'	16.44'	21.93'	03°08'29.2"	45°09'46.6"
TOTAL	275.88'	249.08'	302.68'				

Defl./ft. = 9.822134 min.

*Ed Eder*  
02 OCT 06  
**RECORD DRAWING**

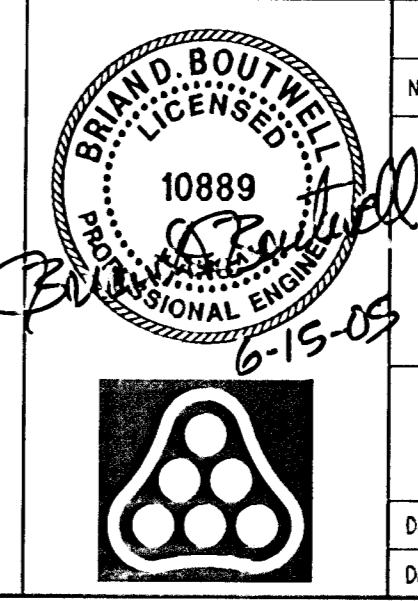

Revision		By	Date
AVALON PARK-PHASE 5			
<b>PALMETTO</b>			
STA. 80+90.00 TO STA. 83+41.19			
JAMES L. ARMOUR, P.E.-CITY ENGINEER			
CITY OF WICHITA PROJECT NO. 472-83839			
<b>Professional Engineering Consultants, P.A.</b>			
303 S. TOPEKA • WICHITA, KANSAS 67202			
316-262-2691 • FAX 316-262-3003			
Designed by	BOB, BLB	Job No.	35-05060-000
Drawn by	BJS	Date	February 2005
			Sht. 8 of 22

DSNR: BLB OPER: BJS SCALE: 1"=20.00  
 02/2005 05:06:00 05:06:00-C-ST081-84 06-13-2005 03:34:11 pm