


|                      |                      |              |
|----------------------|----------------------|--------------|
| Designed by BDB, BLB | Job No. 35-05059-000 | Sht. 4 of 22 |
| Drawn by BJS         | Date February 2005   |              |

|                                                                                     |                   |
|-------------------------------------------------------------------------------------|-------------------|
|  | STD. BASEMENT     |
|  | WALK-OUT BASEMENT |
|  | VIEW-OUT BASEMENT |
|  | STORM WATER FLOW  |
|  | SPOT ELEVATION    |
| W.O.                                                                                | WALK-OUT          |
| V.O.                                                                                | VIEW-OUT          |
| T.F.                                                                                | TOP OF FOUNDATION |

| <u>MINIMUM OPENINGS</u> | <u>ELEVATION (N.G.V.D.)</u> | <u>CITY DATUM</u> |
|-------------------------|-----------------------------|-------------------|
| <u>BLOCK 1</u>          |                             |                   |
| LOTS 1-6, 18-19         | 1336.0                      | 148.6             |
| LOTS 36-37, 46-52       | 1349.6                      | 149.6             |
| LOTS 7-17, 20-22, 33-35 | 1338.2                      | 150.8             |
| LOTS 38-45              | 1338.3                      | 150.9             |
| LOTS 23, 31-32          | 1339.0                      | 151.6             |
| LOTS 24-30              | 1339.7                      | 152.3             |
| <br><u>BLOCK 2</u>      |                             |                   |
| LOTS 1-4, 10-13         | 1336.0                      | 148.6             |
| LOTS 5-9                | 1336.2                      | 148.8             |
| <br><u>BLOCK 3</u>      |                             |                   |
| LOTS 1-6                | 1336.0                      | 148.6             |
| LOTS 7-18               | 1349.6                      | 149.6             |
| <br><u>BLOCK 4</u>      |                             |                   |
| LOTS 4-9, 22-25         | 1336.0                      | 148.6             |
| LOTS 1-3, 26-28         | 1336.8                      | 149.4             |
| LOTS 10-21              | 1349.6                      | 149.6             |

# RECORD DRAWING

|             |          |         |               |             |
|-------------|----------|---------|---------------|-------------|
| Designed by | BDB, BLB | Job No. | 35-05059-000  | SM. 4 of 22 |
| Checked by  | BJS      | Date    | February 2005 |             |

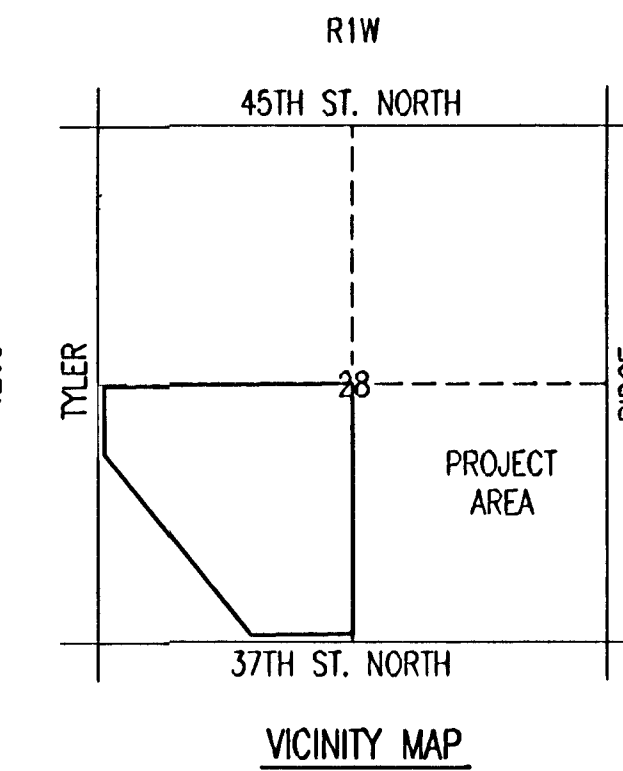

*er Outfall*

