


PLAN	CHECKED	BY	DATE
	CHECKED		

PROFILE	CHECKED	BY	DATE
	CHECKED		

DSNR: BLB OPER. BUS SCALE: 1"=20.00
Q:\2005\05160\000\05160-000-C-SWSLINE 06-13-2005 09:48:47 am

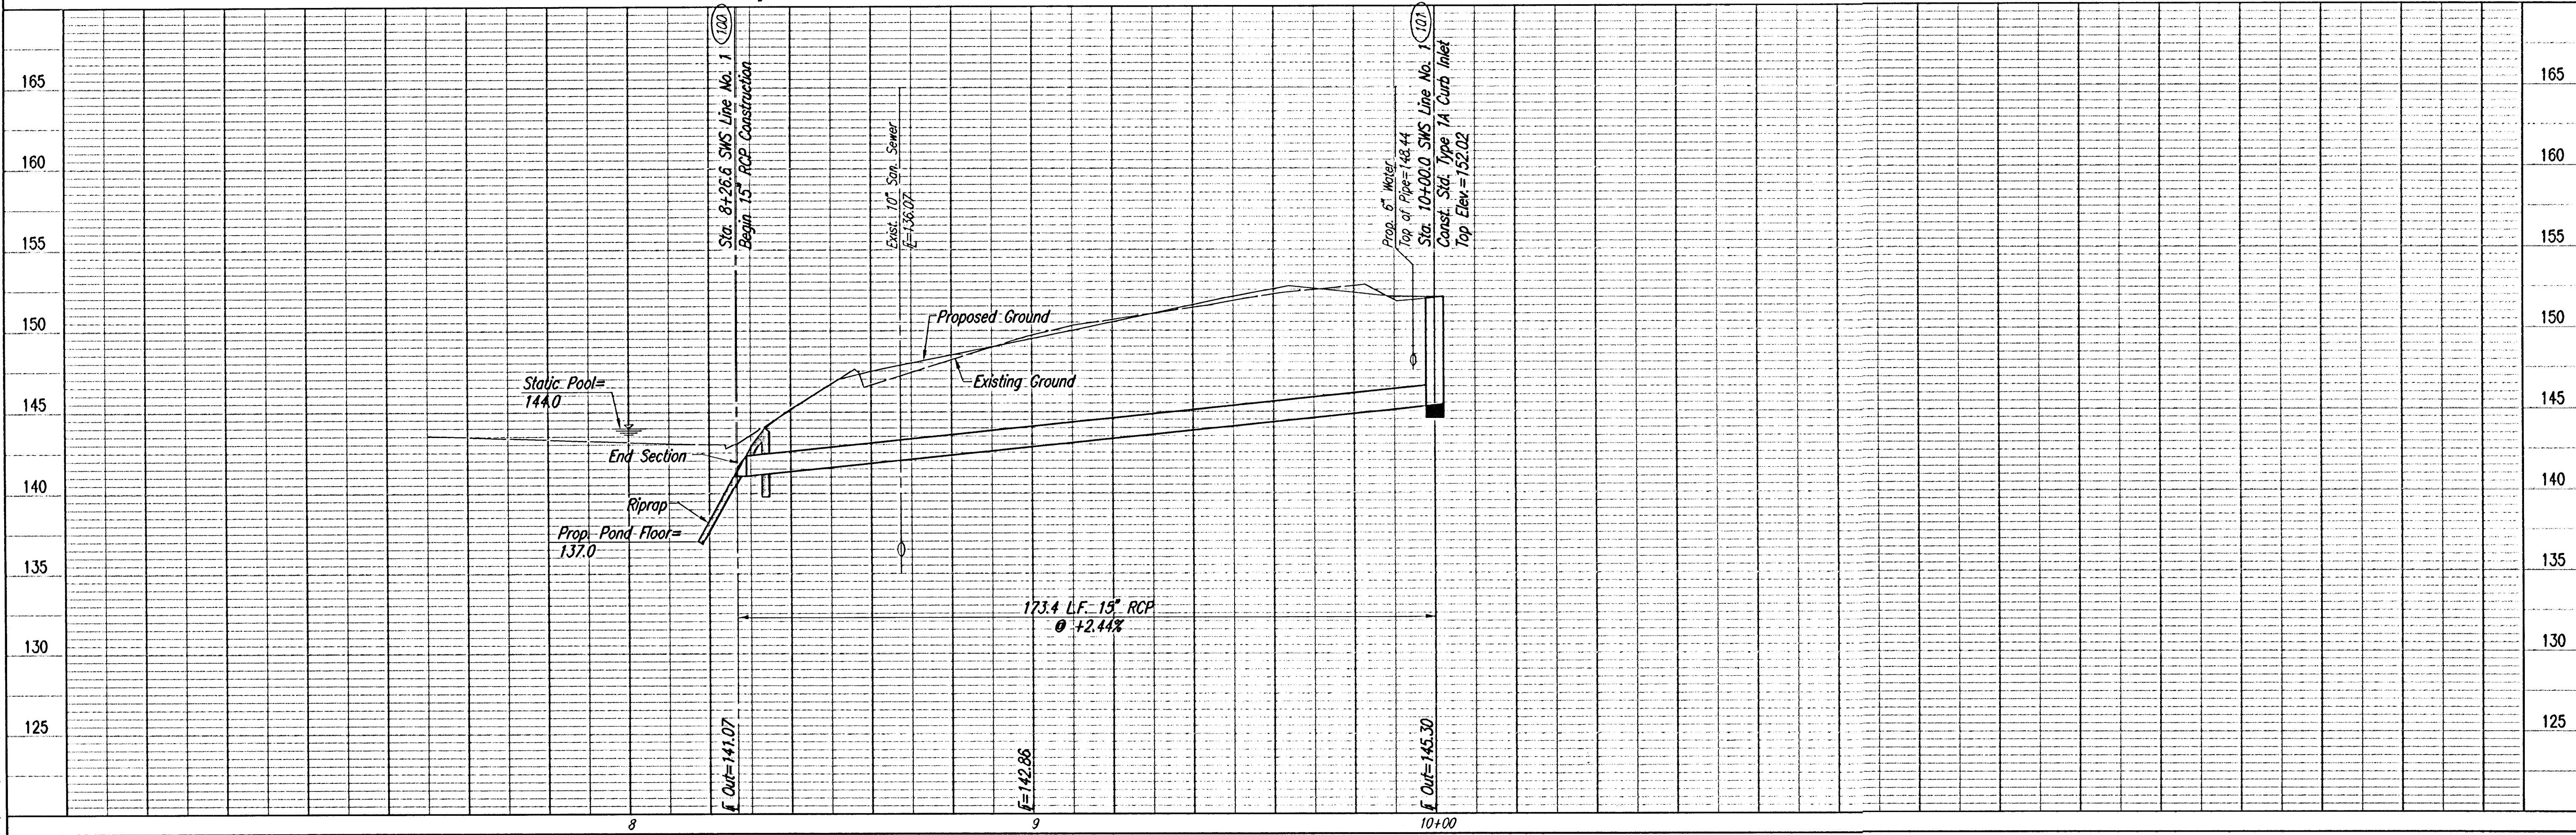

SWD #265 (By Others)
(COW Proj. No. 468-84012)
Static Pool=144.0
DWS₁₀₀=146.6

Install 16 S.Y.
Light Stone Riprap
See Sheet No. 11.

Sta. 71+32.27 @ Palmetto Cir.=
Ctr. of Cul-de-sac

Sta. 8+26.6 SWS Line No. 1
Begin 15" RCP Construction
Install 173.4 L.F. 15" RCP (NE)
(Including End Section)

CAUTION !!!
Existing 10" San. Sewer
City of Wichita

CAUTION !!!
Proposed 6" Water
City of Wichita

Sta. 10+00.0 SWS Line No. 1
Const. Std. Type 1A Curb Inlet
L=5'-0", W=3'-0"
Top Elev.=152.02
See Sheet No. 9.

Excavate Only as Necessary for Installation
of RCP and Riprap. At Contractor's option,
timing of Riprap placement may be Coordinated
with SWD #265 Contractor.

See Title Sheet for Construction
Schedule/Sequence Note.

COORDINATE LIST		
POINT	NORTH	EAST
100	10,955.2641	11,074.6436
101	11,094.1245	11,178.4961

(100) = COORDINATE POINT NO.
SEE SHEET NO. 3 FOR PLAT COORDINATES

RECORD DRAWING
6-15-05
BRIAN D. BOUTWELL
10889
LICENSED PROFESSIONAL ENGINEER

AVALON PARK-PHASE 3
SWS LINE NO. 1

Professional Engineering Consultants, P.A.
303 S. TOPEKA • WICHITA, KANSAS 67202
316-262-2691 • FAX 316-262-3003

JAMES L. ARMOUR, P.E.-CITY ENGINEER
CITY OF WICHITA PROJECT NO. 477-3337

Designed By: BDB, BLB
Drawn By: BUS
Job No.: 35-05160-000
Date: February 2005