


BM #3: "□" Cut in top of curb at the NW corner of Lot 1, Block B, Hunter's Ridge Addition.
Elev. = 146.63 (City Datum)

SCALE:
1" = 20' HORIZONTAL
1" = 5' VERTICAL
● = IRON

FLAT CREEK ADDITION

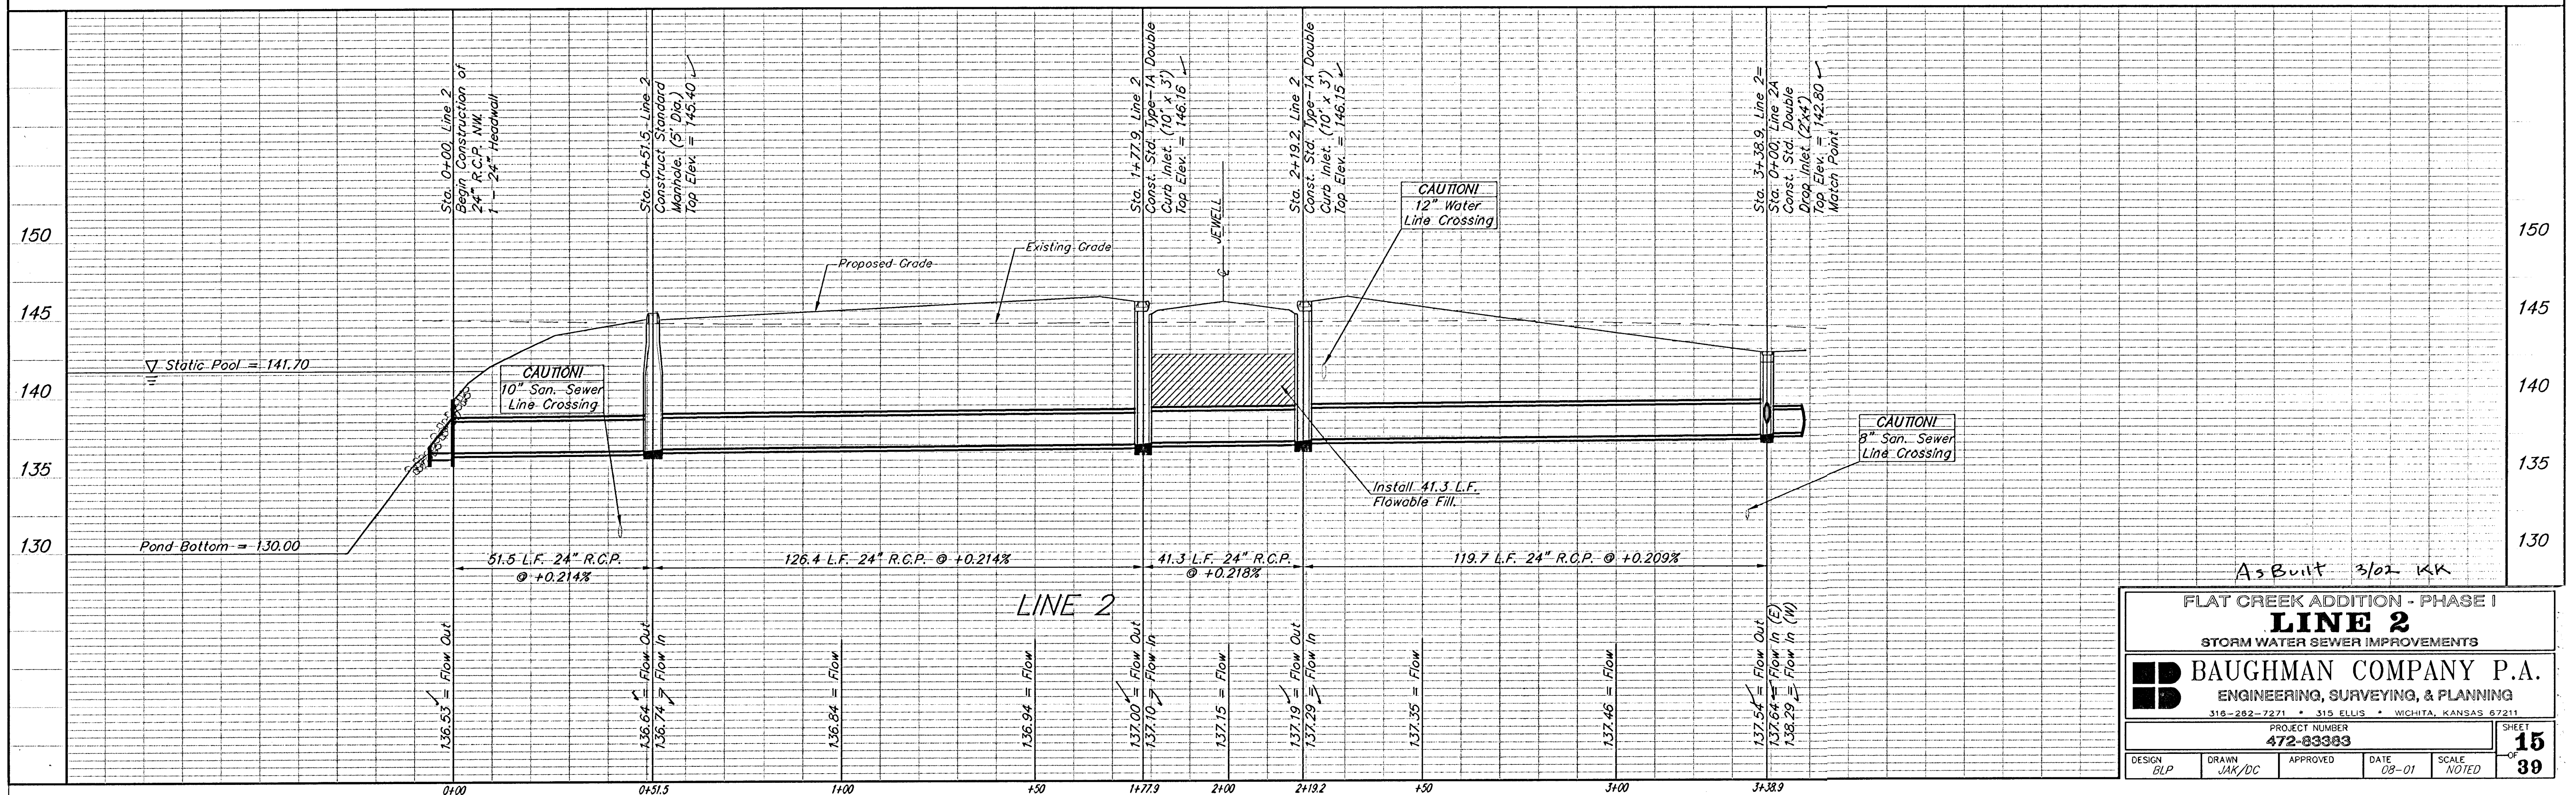

As Built 3/02 KK

FLAT CREEK ADDITION - PHASE I

LINE 2

STORM WATER SEWER IMPROVEMENTS

BAUGHMAN COMPANY P.A.
ENGINEERING, SURVEYING, & PLANNING

PROJECT NUMBER
472-83383

HEET
15

DESIGN BLP	DRAWN JAK/DC	APPROVED	DATE 08-01	SCALE NOTED	OF 39
---------------	-----------------	----------	---------------	----------------	----------