
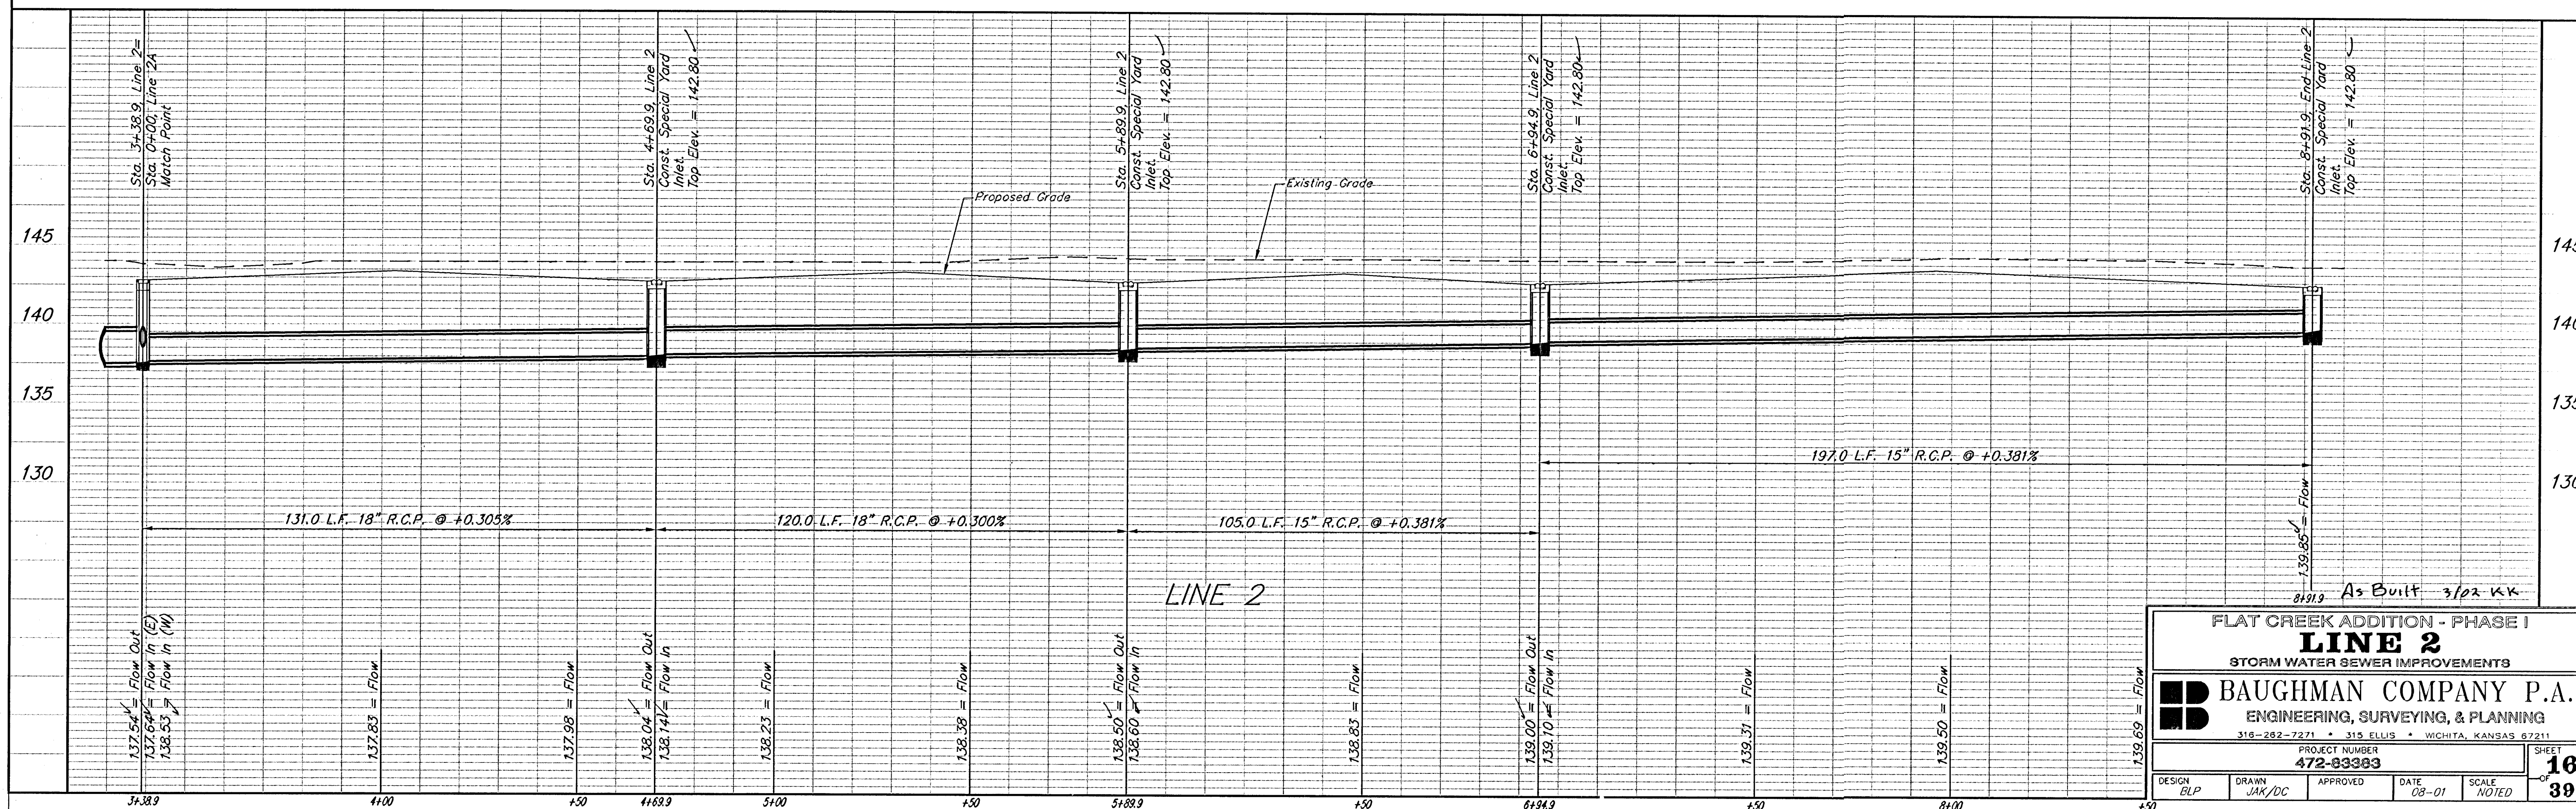


BENCHMARKS:
BM #1: "□" Cut in top of curb, east
return of SE corner of Lotus &
Parkridge.
Elev. = 145.99 (City Datum)

BM #2: "X" Cut on walk at NW corner
of Lot 1, Block F, Flat Creek Addition
Elev. = 146.22 (City Datum)

BM #3: "□" Cut in top of curb at the
NW corner of Lot 1, Block B, Hunter's
Ridge Addition.
Elev. = 146.63 (City Datum)

SCALE:
1" = 20' HORIZONTAL
1" = 5' VERTICAL
• = IRON

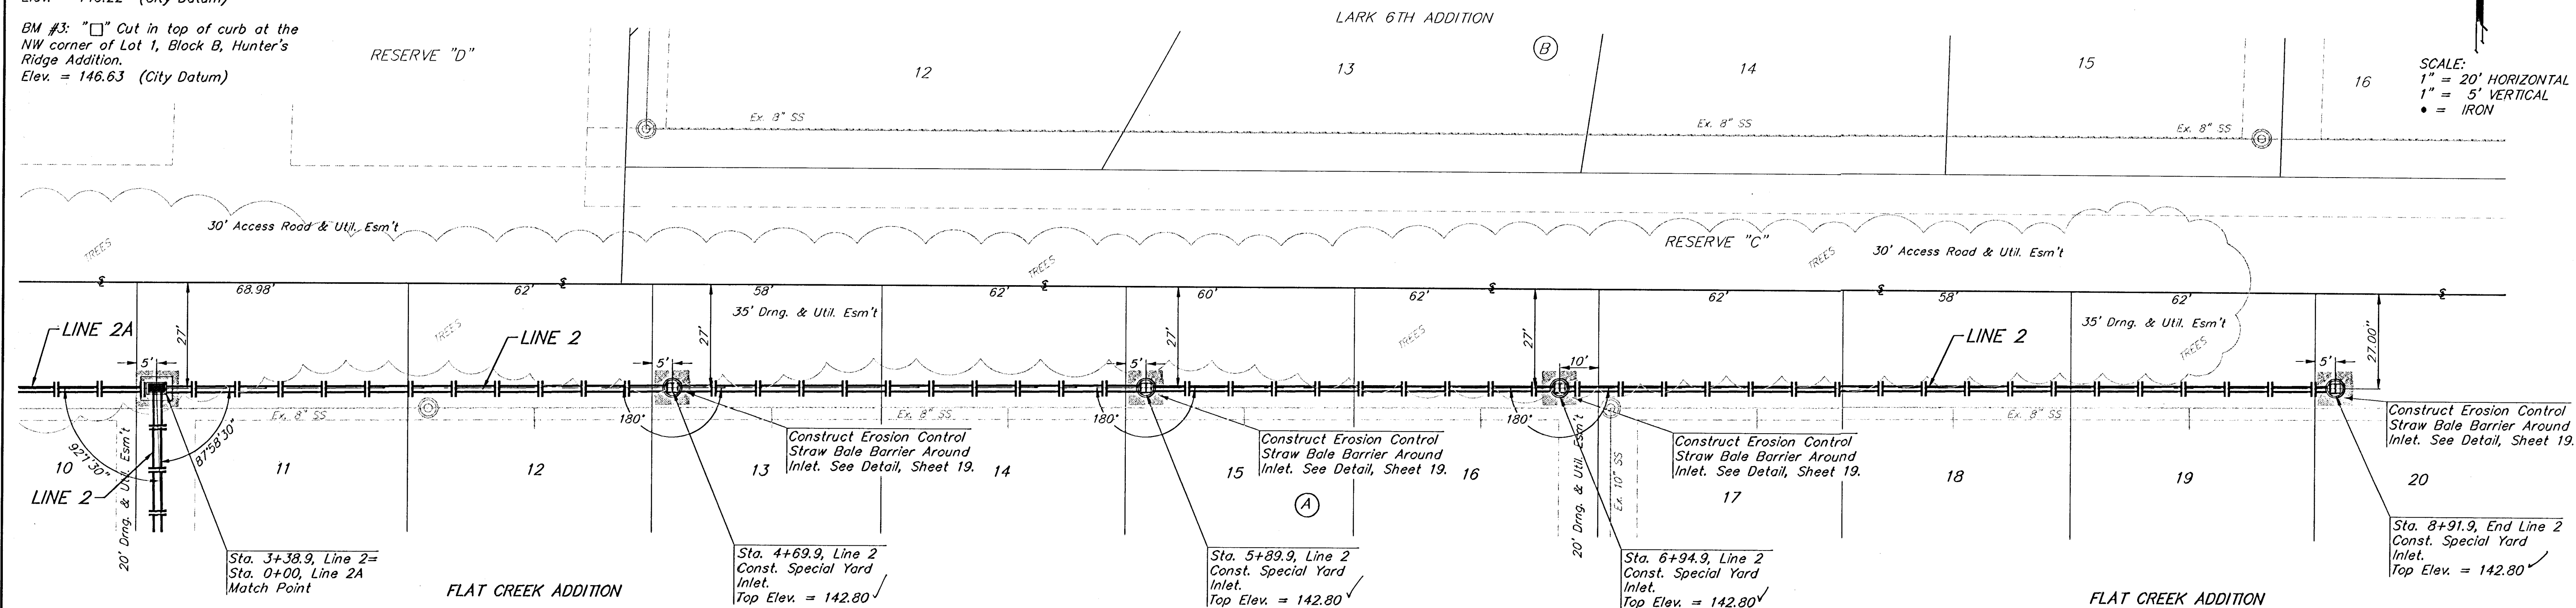

FLAT CREEK ADDITION - PHASE I				
LINE 2				
STORM WATER SEWER IMPROVEMENTS				
BAUGHMAN COMPANY P.A.				
ENGINEERING, SURVEYING, & PLANNING				
316-282-7271 • 315 ELLIS • WICHITA, KANSAS 67211				
PROJECT NUMBER 472-89383				
DESIGN ELP	DRAWN JAK/DC	APPROVED	DATE 08-01	SCALE NOTED
				SHEET 16 OF 39