


BENCHMARKS:
BM#1: "□" Cut in top of curb, east
return of SE corner of Lotus &
Parkridge.
Elev. = 145.99 (City Datum)



BM #2: "X" Cut on walk at NW corner
of Lot 1, Block F, Flat Creek Addition
Elev. = 146.22 (City Datum)

BM #3: "□" Cut in top of curb at the
NW corner of Lot 1, Block B, Hunter's
Ridge Addition.
Elev. = 146.63 (City Datum)

Sta. 3+36.98, Line 5
Begin Construction of
Ditch As Shown. (See
Detail, This Sheet).
Cost of ditch to be
incidental to "Site
Clearing & Restoration".

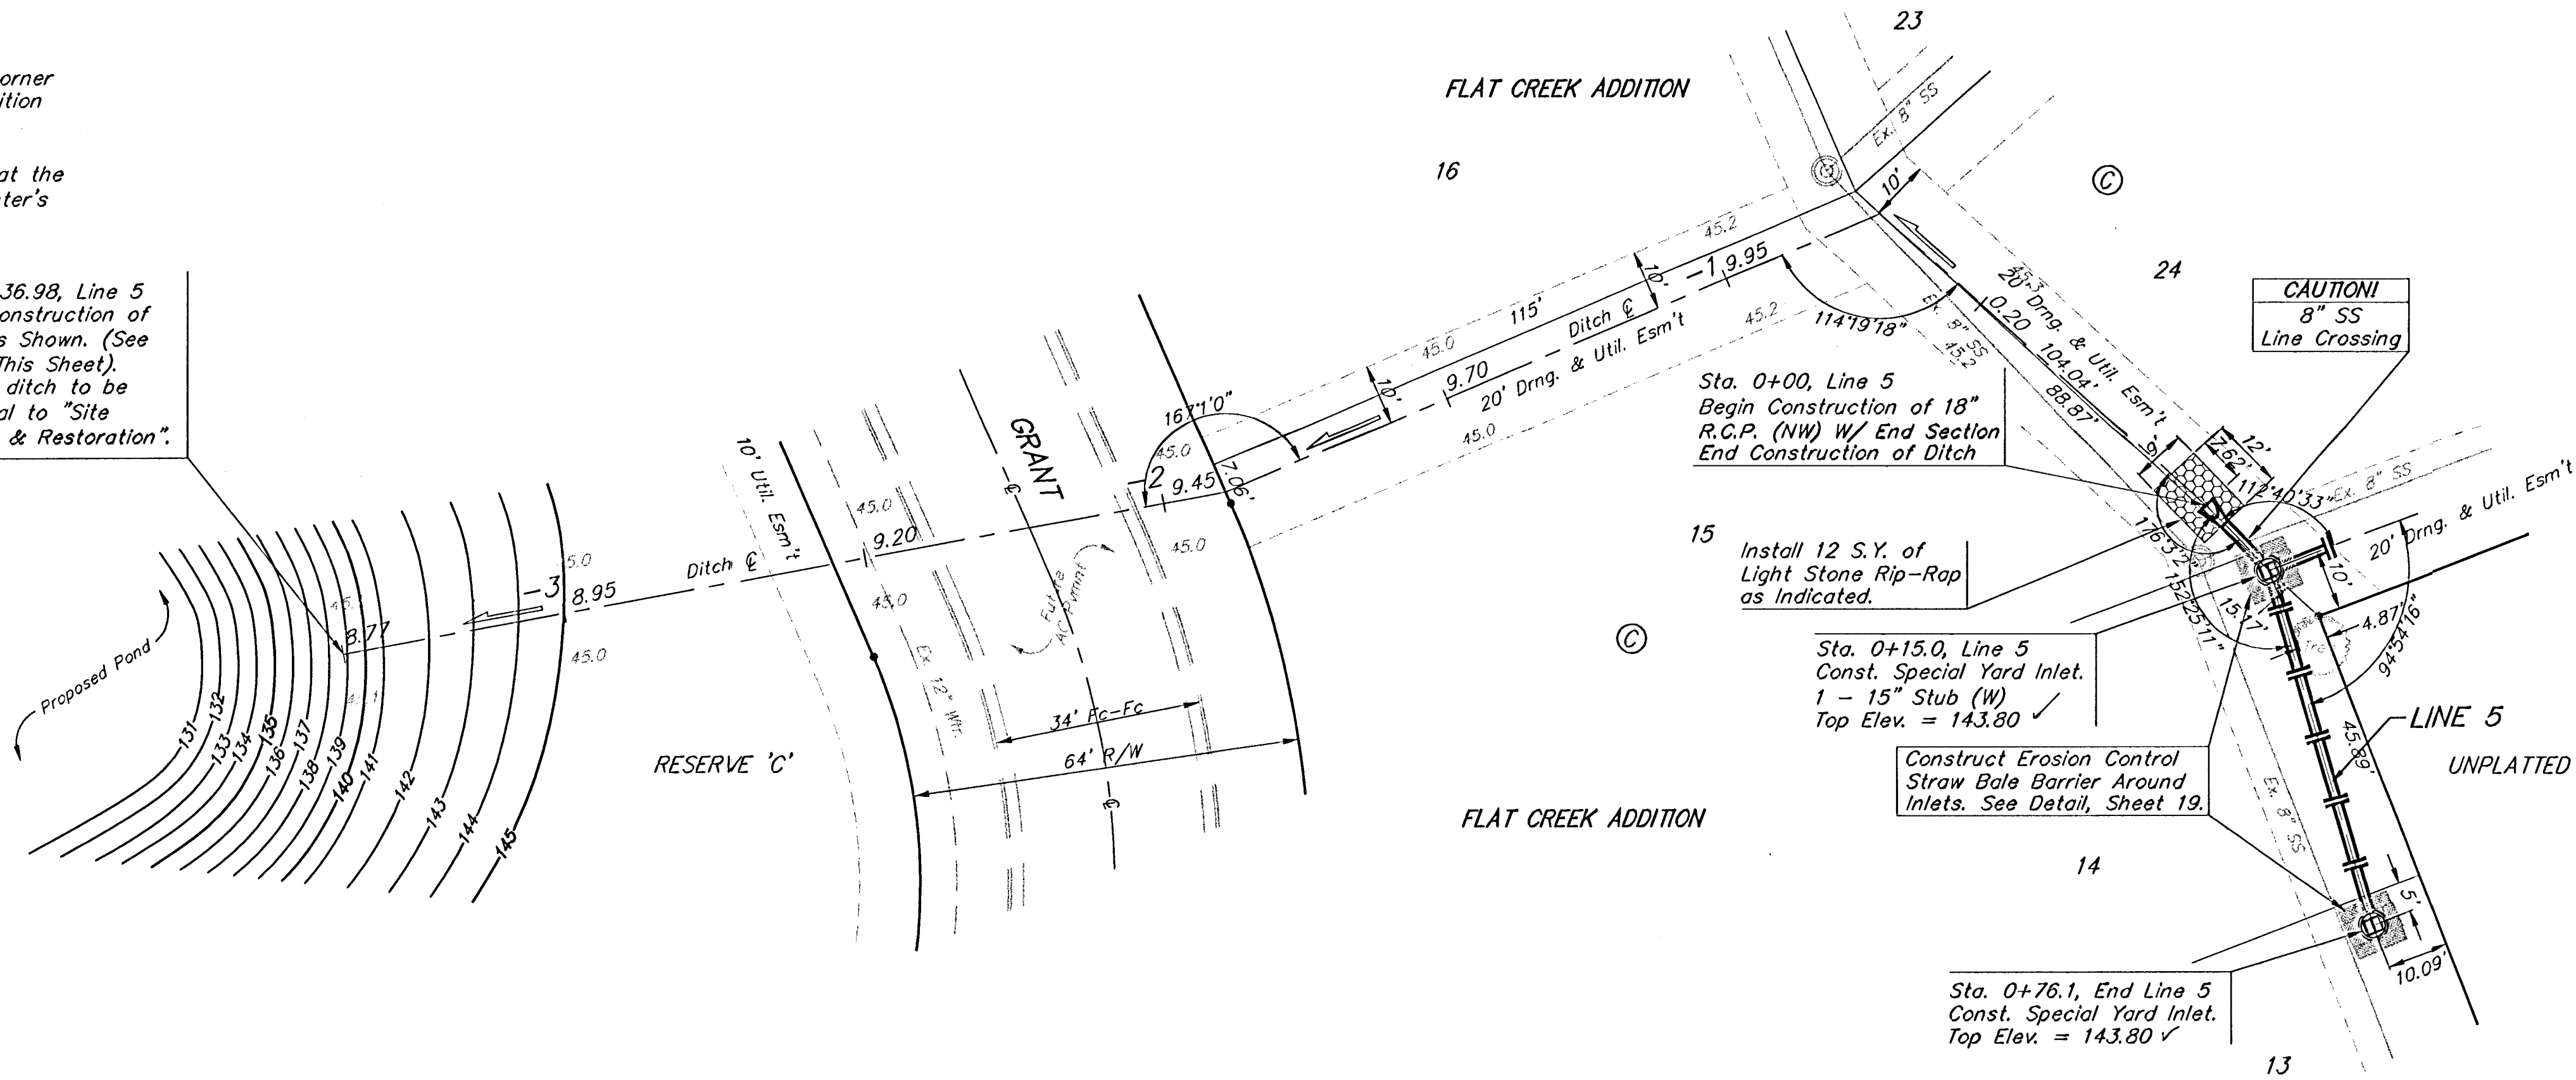

SCALE:
1" = 20' HORIZONTAL
1" = 5' VERTICAL
• = IRON

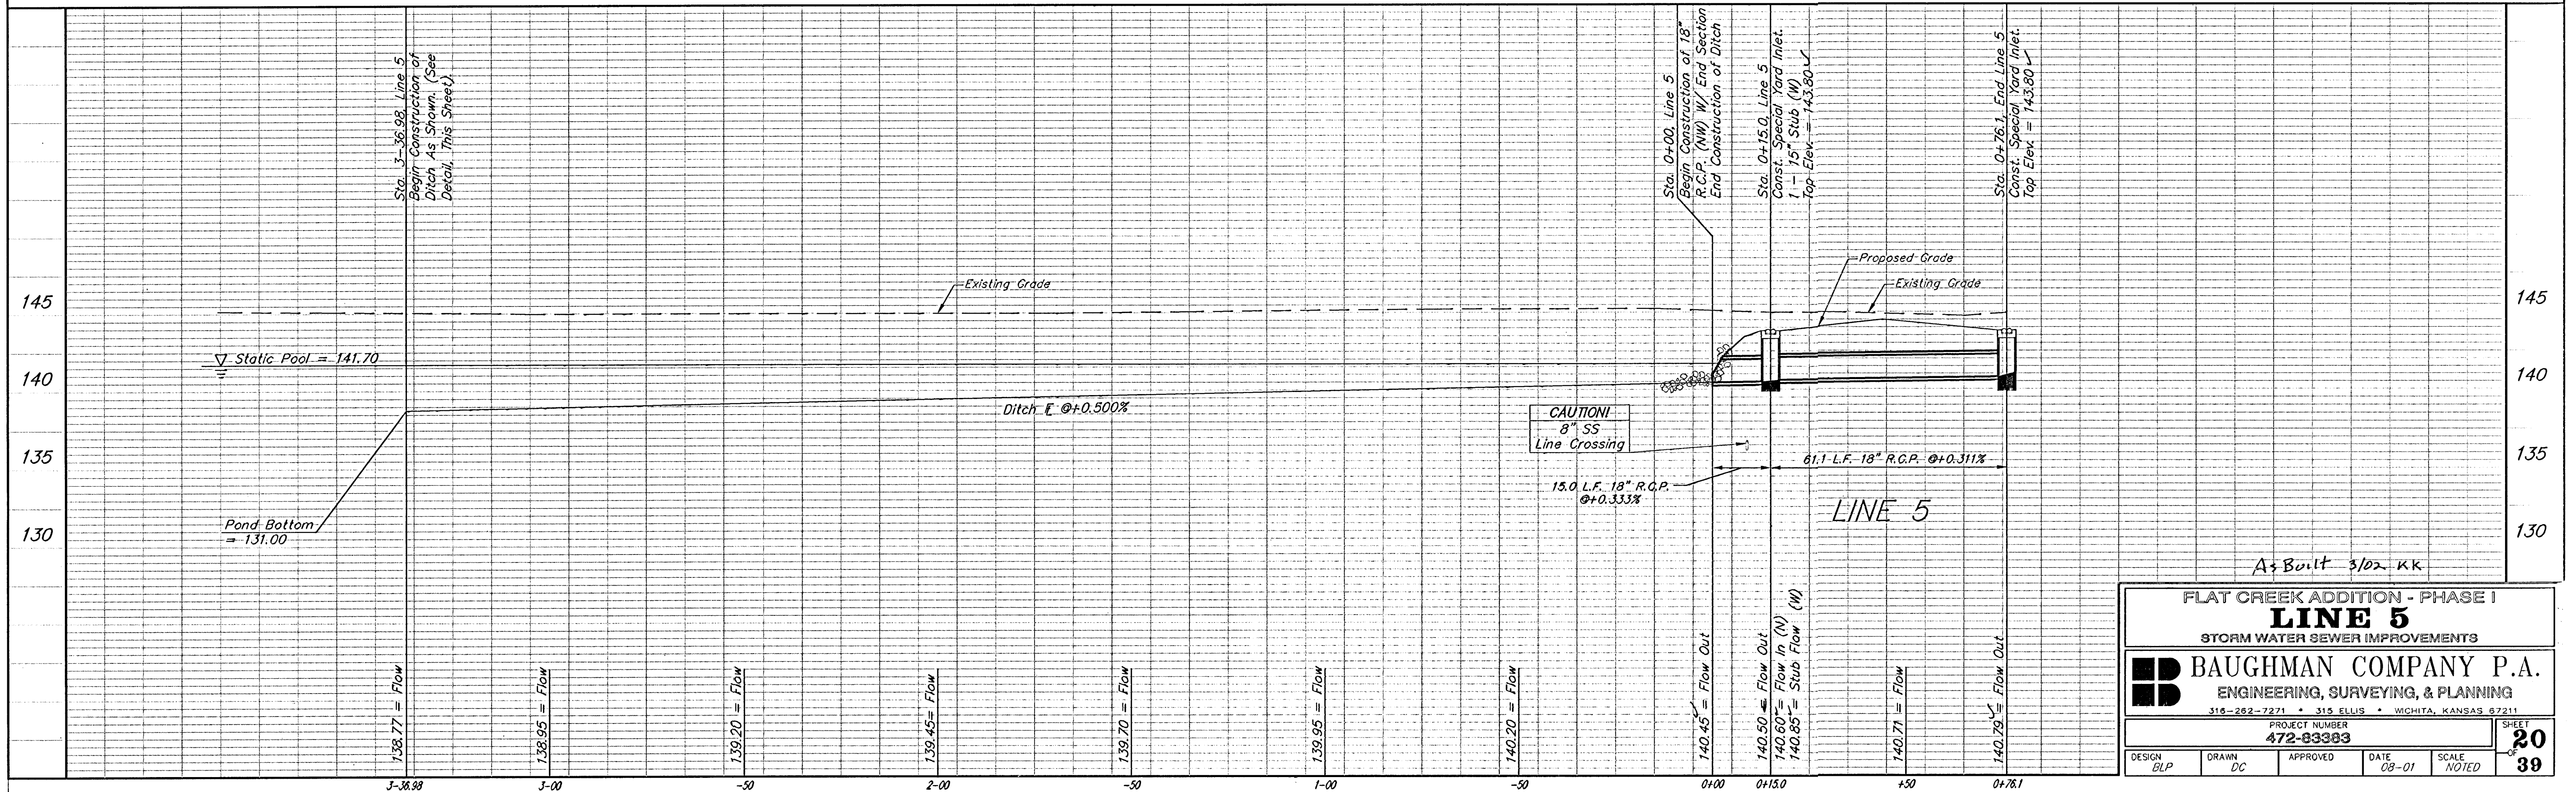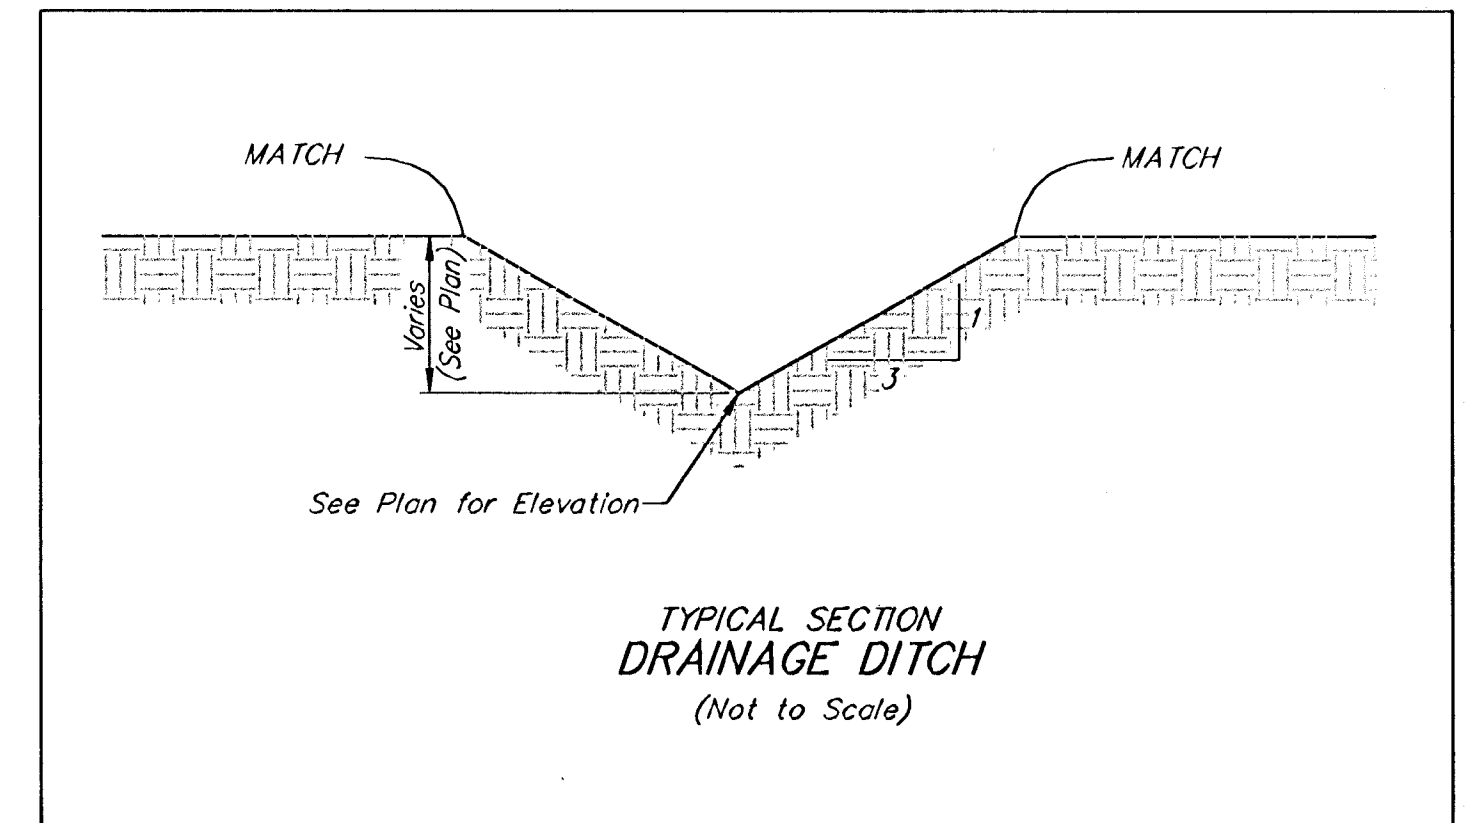

A+Built 3/02 KK

FLAT CREEK ADDITION - PHASE I			
LINE 5			
STORM WATER SEWER IMPROVEMENTS			
BAUGHMAN COMPANY P.A.			
ENGINEERING, SURVEYING, & PLANNING			
315-262-7271 • 315 ELLIS • WICHITA, KANSAS 67211			
PROJECT NUMBER			
472-83383			
DESIGN	DRAWN	APPROVED	DATE
BLP	DC		08-01
SCALE			NOTED
SHEET			20
OF			39