

MAIN 20 SOUTHWEST INTERCEPTOR SEWER


CITY OF WICHITA, KANSAS
JIM L. ARMOUR, P.E. - CITY ENGINEER

SHEET INDEX

- 1 TITLE, LOCATION MAP, SHEET INDEX & LEGEND
- 2 KEY MAP & GENERAL NOTES
- 3-9 PLAN & PROFILE
- 10-11 MANHOLE DETAILS
- 12-14 EROSION CONTROL BMP DETAILS




Miss Construction, Inc. - Contractor
Shaarer, City - Inspector
Released 9/30/05
As-Built
Stubs
.pdf by JDL 3/14/06

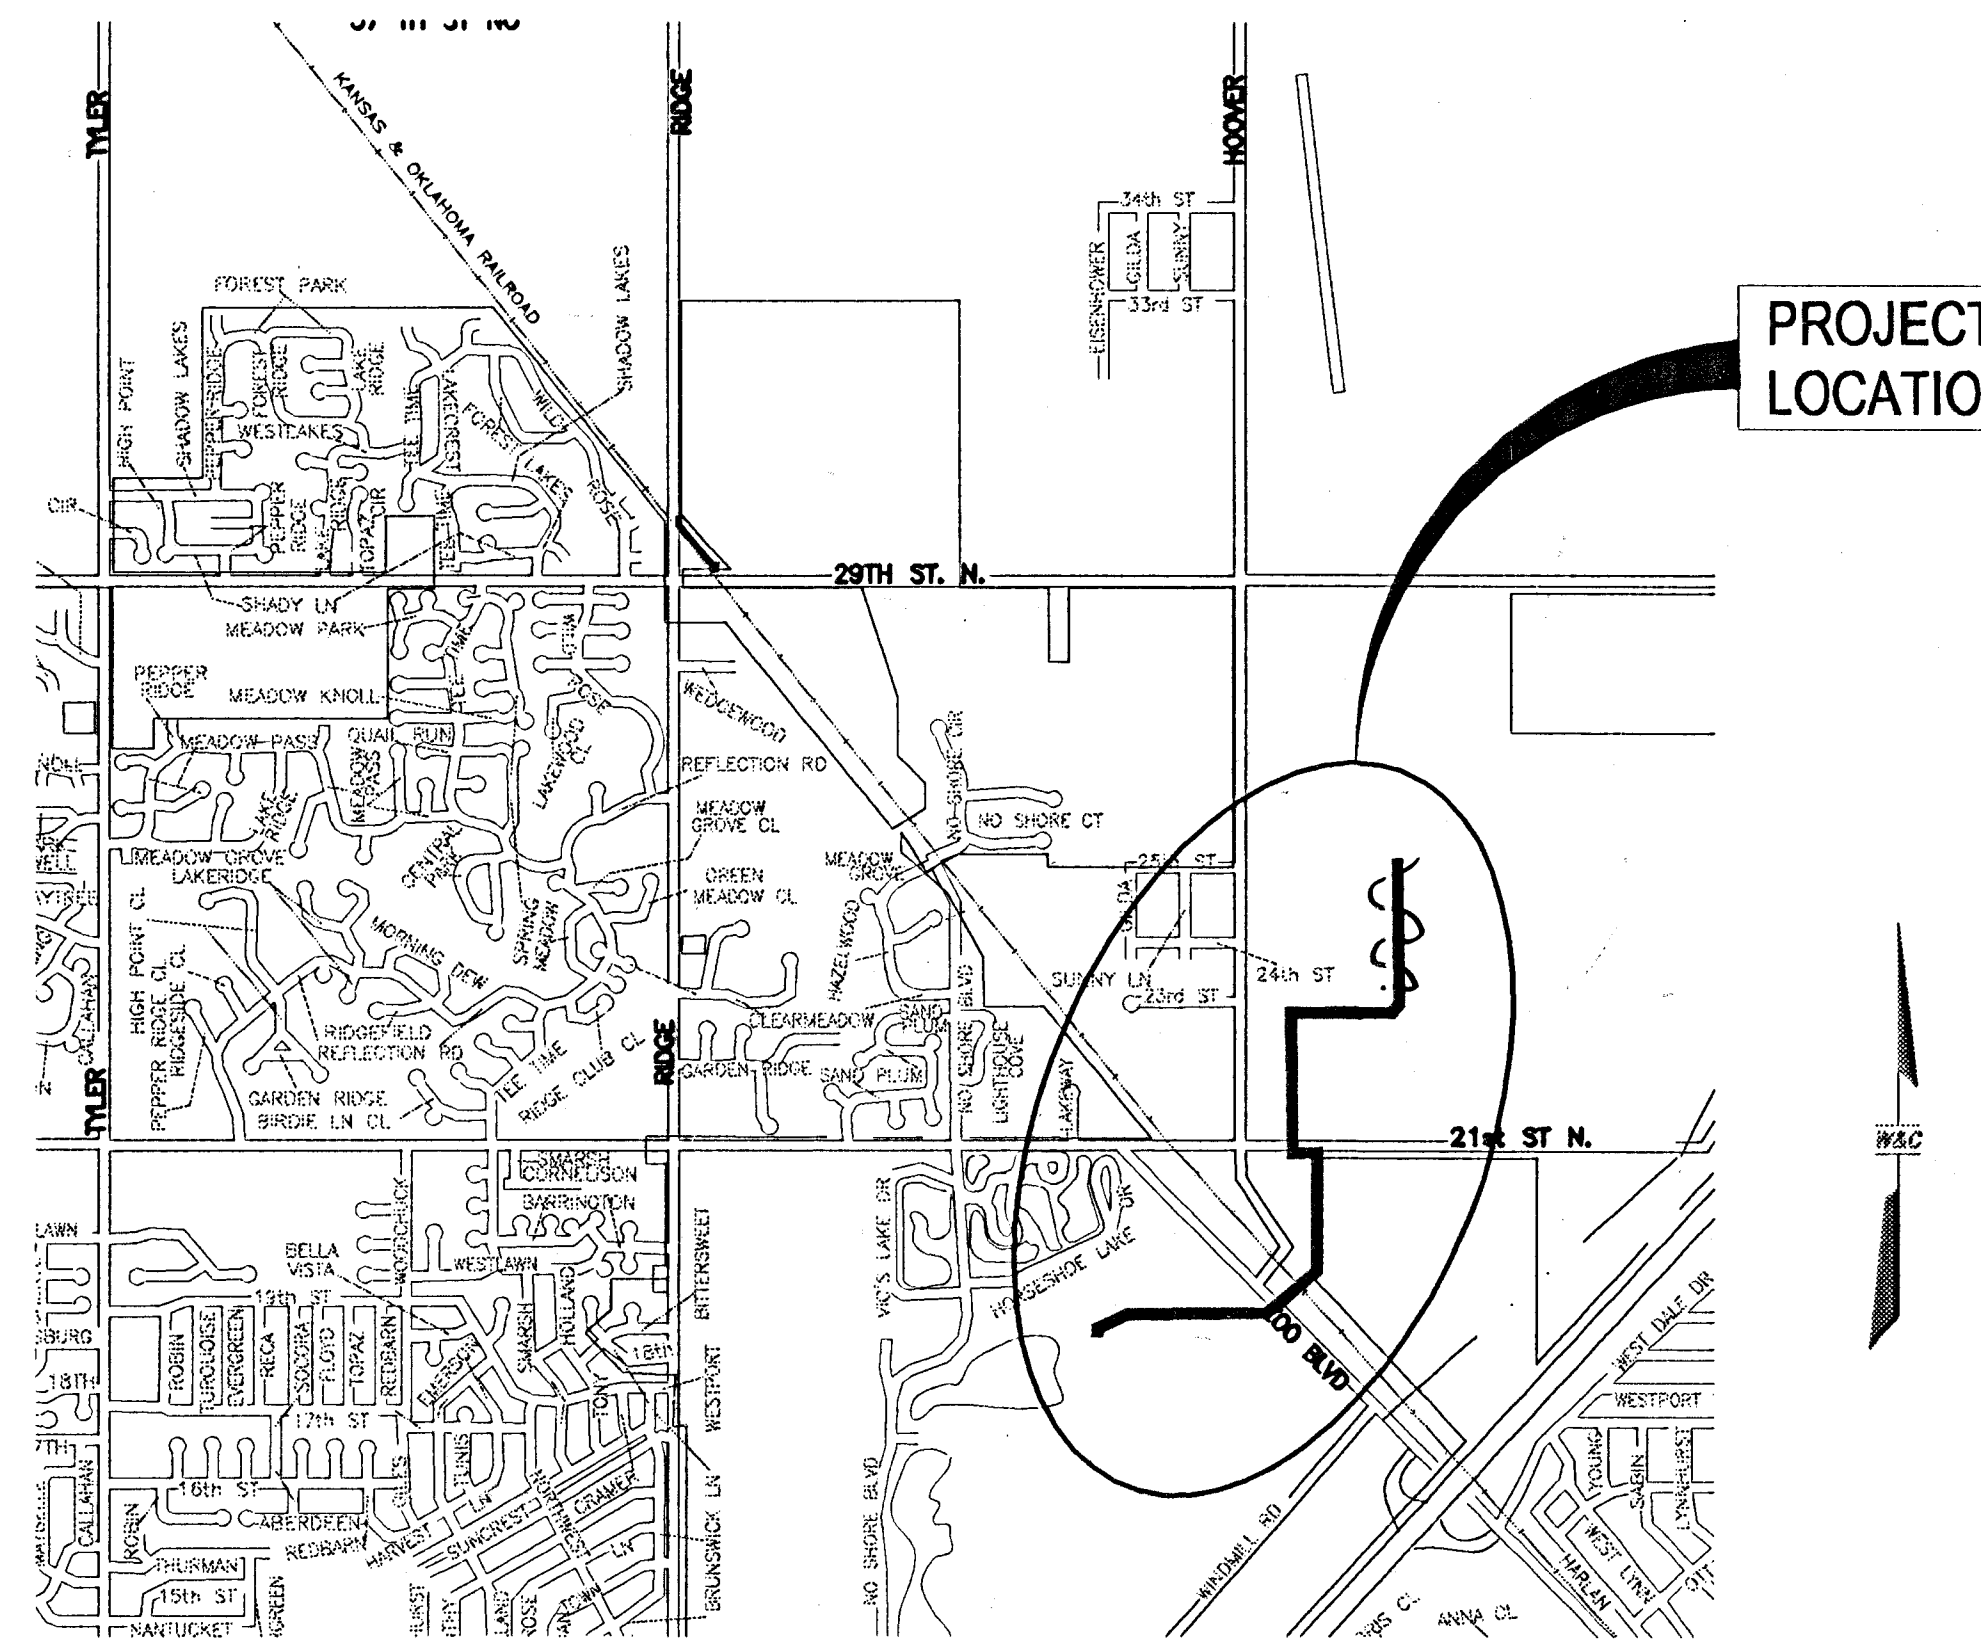

LOCATION MAP
 NOT TO SCALE

SYMBOL	DESCRIPTION
[Hatched Box]	BUILDING / STRUCTURE
[Double Line]	RAILROAD TRACKS
[Dashed Line]	EDGE OF PAVEMENT
[Dashed Line]	CURB AND GUTTER
[Dashed Line]	GRAVEL SURFACING
[Dashed Line]	WATER LINE
○ W.M.	WATER METER
○ W.V.	WATER VALVE
○ F.H.	FIRE HYDRANT
○	GAS LINE
○ GAS REG.	GAS REGULATOR
○ G.V.	GAS VALVE
— SWS	STORM WATER SEWER LINE
[Box]	STORM WATER INLET
○ M.H.	MANHOLE
— 24" CUP	CULVERT PIPE
— SS	SANITARY SEWER LINE
— FM	SANITARY SEWER FORCE MAIN
— T	UNDERGROUND TELEPHONE LINE
— USE	UNDERGROUND ELECTRIC LINE
— OHE	OVERHEAD ELECTRIC LINE
— FO	FIBER OPTIC LINE
■	UTILITY POLE
[Box]	TELEPHONE PEDESTAL
○ U.D.	UTILITY DEADMAN/GUY WIRE
— CATV	CABLE TELEVISION LINE
○ BUSH	BUSH
○ TREE	TREE
—	TREE LINE EDGE
—	SIGN POST
—	ROADWAY GUARD RAIL
—	STREAM FLOW DIRECTION
x 132.8	SPOT ELEVATION
○ 24-1	SOIL BORING LOCATION
—	WOOD FENCE
—	WROUGHT IRON FENCE
—	BARBED WIRE FENCE
—	CHAIN LINK FENCE
—	PROPERTY LINE / RIGHT-OF-WAY LINE
—	LOT LINE
---	EASEMENT LINE (EXISTING)
---	EASEMENT LINE (PROPOSED)

OCA NO. 744056
CITY OF WICHITA
PROJECT NO. 468-83796
APRIL 2004

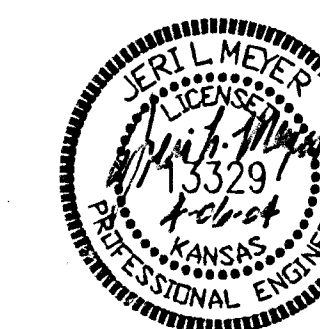

WILSON & COMPANY
 Engineers & Architects

Revised 4/12/05 P.T.