


- LEGEND
- ⊠ TSP TRAFFIC SIGNAL POLE
 - ⊡ TSM TRAFFIC SIGNAL MANHOLE
 - ⊙ WM WATER METER
 - ⊙ WV WATER VALVE
 - ⊙ FH FIRE HYDRANT
 - ⊙ BM BENCH MARK
 - ⊙ LP LIGHT POLE

POINT	NORTHING	EASTING	IMPRV'T
001	5570.85	5035.00	
002	5571.90	5230.14	
003	5411.89	5230.14	
004	5412.14	5276.21	
005	5303.37	5313.99	
006	5282.35	5313.99	
007	5282.44	5330.21	
008	5280.77	5035.00	
009	5287.90	5319.47	WATER
010	5371.25	5319.47	WATER
011	5447.04	5319.47	WATER
012	5528.80	5319.47	WATER
013	5541.55	5319.47	WATER
014	5572.37	5319.47	WATER
015	5368.88	5294.96	SWS
016	5435.75	5295.32	SWS
017	5543.87	5283.18	SWS

This area dedicated to City of Wichita for Highway Purposes.

B.M.: C.O.W. BENCH MARK ON N.W. CORNER TRAFFIC SIGNAL LIGHT BASE AT S.W. CORNER DOUGLAS AND HYDRAULIC. ELEV.=108.91 CITY DATUM

B.M.: CHISELED "d" IN TOP OF CURB AT WEST END CURB RETURN AT S.E. CORNER DOUGLAS AND MINNEAPOLIS. ELEV.=109.24

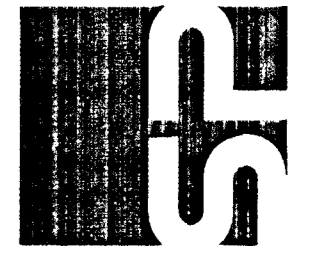

SPANGENBERG PHILLIPS
ARCHITECTURE
 121 N. Mead, Suite 201, Wichita, KS 67202
 TEL: 316.267.4002 FAX: 316.267.1509
 www.spangenbergphillips.com

KANSAS FOODBANK WAREHOUSE
STORM WATER SEWER IMPROVEMENTS

DOUGLAS AND I-135 WICHITA, KANSAS

CED PROJ. NO.: 20051344
CERTIFIED ENGINEERING DESIGN, P.A.

CED	810 WEST DOUGLAS, SUITE C	SHEET	C6.1
	WICHITA, KANSAS 67203	TOTAL	C6.3
	PH: (316) 262-8808 FAX: (316) 262-1669		

AS-BUILT 6-13-04 HOF/WCED

PERMIT
 00 JAN 06
 SITE PLAN

C6.1