

GENERAL NOTES:

- The Contractor shall comply with all applicable safety regulations. All construction shall be completed following current City Standard Specifications and Special Provisions.
- Contractor will be required to provide notice to utility companies a minimum of seventy-two (72) hours prior to any excavation, as follows:
 Kansas One-Call 687-2470
 The Contractor must notify the following in case of an emergency:
 AT&T 1-800-246-8464
 Black Hills Energy 1-800-694-8989
 City of Wichita Water & Sewer 1-316-219-8921
 City of Wichita Stormwater 1-316-268-4090
 City of Wichita Traffic 1-316-268-4034
 Cox Communications 1-888-249-3530
 Kansas Gas Service 1-888-482-4950
 Evergy 1-800-544-4857
- Utility service lines, poles, etc. are to be adjusted as necessary by others prior to construction unless the plans specifically call for their adjustment by the Contractor or unless the plans specifically identify a utility to be adjusted by its owner during construction. Existing utilities and their location, as shown on the plans, represent the best information obtainable for design. The Contractor will be required to work around existing utilities within the right-of-way which do not conflict with proposed construction.
- Rubble from the removal of miscellaneous structures and excess excavation which is to be wasted shall be disposed of on sites to be provided by the Contractor. These sites shall be approved by the Engineer as to suitability, appearance and site location. Locations, in the opinion of the Engineer, that will leave an unsightly appearance will not be approved. All disposal sites must be approved by the Kansas Department of Health and Environment. Material either stockpiled or disposed of in a flood plain will require a Kansas State Board of Agriculture permit. Any material dumped in waters of the United States or wetlands is subject to U.S. Corps of Engineers permitting regulations. Any material buried or stockpiled beyond approved construction limits will require additional archaeological investigations unless buried in a previously approved borrow location.
- Trees and shrubs in public right-of-way which are in direct conflict with proposed new construction shall be removed by the Contractor with the City Engineer's approval. Trees and shrubs which are not in direct conflict with proposed new construction shall be saved and protected from damage.
- The Contractor shall give all property owners and/or tenants of developed property adjoining the construction of this project a minimum of ten (10) days notice prior to start of construction.
- The Contractor shall be responsible for preserving property irons. The Contractor will be required to re-establish any property irons which are damaged or destroyed by his construction operations. Such irons shall be re-established by a licensed land surveyor in accordance with state laws.
- The Engineering Division shall field locate water valves one time during construction when requested by the Contractor. It shall be the Contractor's responsibility to preserve such field locations during the construction process. Water valves, valve boxes or fire hydrants damaged during construction shall be repaired by Contractor at his own expense. Valve boxes and water meters within the project limits shall be adjusted to match final grades by the contractor.
- The Contractor shall notify the inspecting engineer and Dawnita Reihardt at 316-268-4574 with the City of Wichita with the anticipated construction start date and notify them of project completion. Staking and inspection for this project will be the responsibility of the Contractor.
- If traffic will be impacted by construction, a traffic control plan must be submitted and approved by the City Traffic Engineer, Mike Armour at traffic@wichita.gov, before construction can begin. The Contractor shall be responsible for all traffic control measures to facilitate construction. All construction zone markings and signage shall conform to the latest version of the Manual on Uniform Traffic Control Devices (MUTCD) as published by the US Dept. of Transportation, Federal Highway Administration. All costs associated with construction markings and signage shall be the Contractors responsibility.
- All elevations shown are NAVD 88.
- All areas disturbed during construction that will not be under proposed pavement shall be restored to match existing conditions.
- Any sidewalk, drive approach, curb, or street pavement removed to construct project must have a pavement cut permit and be replaced by the City contractor. Permits can be obtained by calling 316-268-4501 or 316-268-4480.
- All applicable fees (tap, equity, in lieu of & main benefit) must be paid before any connections can be made on this project. Quotes can be obtained on fees by calling 316-268-4555.
- City maintenance of water mains ends at right-of-way or easement line or within two feet of vault.
- Opening and closing of water valves shall be done slowly to prevent damage to the water distribution system from water hammer. All valves closed by the contractor must be reopened as new construction permits. The project inspector must ascertain that any valve closed by the Contractor is reopened. The contractor will be permitted to operate water valves only when the project inspector assigned to the project is present.
- The Contractor shall lay a Tracer Wire and Set Test Stations along all water pipe installed in accordance with City Specifications and Tracer Wire Detail on detail sheet WL-101, cost is subsidiary to pipe installation.
- The contractor shall provide materials for temporary blowoff of waterlines. Connections to the existing waterline(s) shall be made with clean, swabbed pipe and flushed upon completion of tie-ins.
- Requests for short term water interruptions shall be made to the City Water Distribution Division and be subject to their approval. The Contractor shall give written notice to any property owner, business, and/or tenants that will have water service interrupted at least 5 days in advance. Such notifications should indicate the time and date that the water will be turned off and when the service will be restored. No business, property owner, and/or tenants shall be without water service for more than 8 hours. Proposed tie in locations which will affect water service to property owners shall be performed during non-peak hours.
- The Contractor must schedule the connections to the existing main with the City such that there is a minimum disruption of service. Connections shall be made during periods of low water usage. The Contractor shall submit his proposed schedule for completing work for City approval at least 10 days prior to beginning construction.
- Deflections at pipe joint or couplings shall not exceed the pipe manufactures recommended maximum. Where deflections are greater than the maximum allowed, the contractor shall utilize fittings.
- Any existing joint exposed during excavation shall be replaced if within four feet of proposed joint.
- Valves 12 inch and larger are to be operated by the City Water Distribution Division, 48 hours of advance notice is required with the water Dispatch at 316-291-8921.
- All wet taps shall be installed by the City of Wichita. The Contractor will reimburse the City for tapping fees prior to tap being made. Unless noted on plans.
- The Contractor shall protect from damage and support existing utilities through construction as approved by the utility owner and the Engineer at the contractors expense.
- Contractor shall limit the extent of trench openings overnight and weekends to less than 50 feet.
- Wichita Fire Department inspections may be scheduled by calling 316-268-4441 (Dawnita Reihardt)

CIVIL PLANS McDONALD'S


6420 E. CENTRAL AVE.
WICHITA, KS
L/C: 015-0101

GARY JANZEN, P.E. CITY ENGINEER

PROJECT NUMBER

PPW-2021-010091 (54030980)

R 2 E

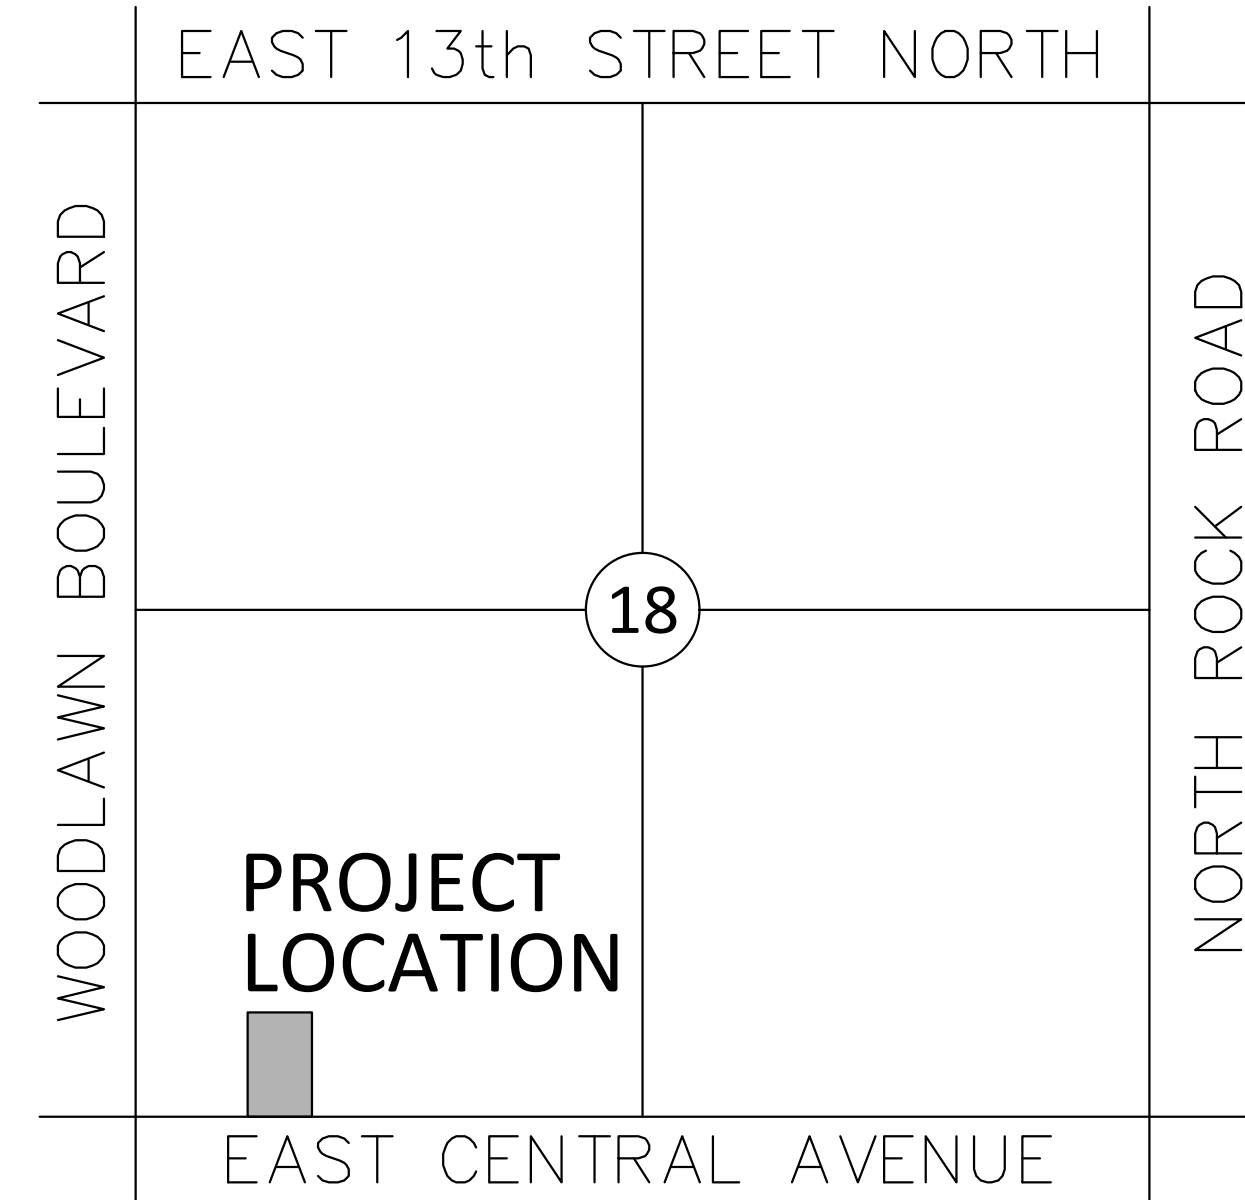

LOCATION MAP

1" = 2000'

MAY 2021

PLAN SUBMITTAL LOG

DESCRIPTION	SUBMITTAL DATE
CITY SUBMITTAL	12/31/2020
CITY SUBMITTAL	5/10/2021
CITY SUBMITTAL	5/25/2021


ENGINEER

ENGINEERING

KANSAS REGISTRATION #001559545
 1903 CENTRAL DR.
 SUITE #406
 BEDFORD, TX 76021
 PH. 817.281.0572
 FAX 817.281.0574
 CONTACT: DREW DONOSKY, PE
 EMAIL: DREW@CLAYMOOREENG.COM

DEVELOPER
 MCDONALD'S CORPORATION
 511 E. CARPENTER FRWY.,
 SUITE 375
 IRVING, TX 75062
 PH. 972.869.1888
 CONTACT: PATRICK PEIHL

ARCHITECT
 ROGUE ARCHITECTS
 513 MAIN ST. SUITE 300
 FORT WORTH, TX 76102
 PH: 817.820.0433
 CONTACT: ROWDY DURHAM

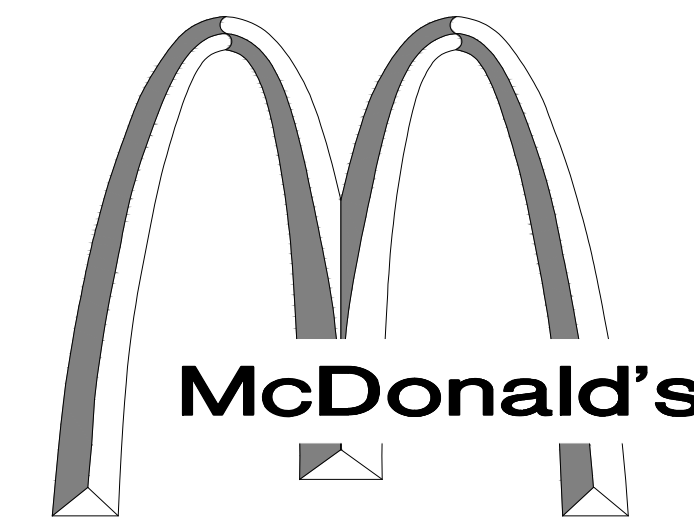

SHEET LIST TABLE

SHEET NUMBER	SHEET TITLE	REVISION DATE
C-0	COVER	5/25/2021
C-1	GENERAL NOTES	5/25/2021
C-2	EROSION CONTROL PLAN	5/25/2021
C-4	PPW UTILITY PLAN	5/25/2021
C-5	PPW WATER PROFILES	
	CITY DETAIL WL103	
	CITY DETAIL WL105	
	CITY DETAIL SW-501	
	CITY DETAIL SW-502	
	CITY DETAIL SW-503	
	CITY DETAIL SW-504	
	CITY DETAIL SW-505	

AS BUILTS

Contractor: Ewertz Excavation
 Project Inspector: Larry Gann
 10/20/2021

 117 E. Lewis, Wichita, KS 67202 (316)264-0242

FOUND BLOWOFF VALVE OF EXISTING WATER LINE AT 238' EAST & 66.7' NORTH OF CENTER LINE OF CENTRAL & WOODLAWN. REMOVED 12' OF EXISTING PIPE AND PUT LONG SLEEVE, FROM LONG SLEEVE NORTH 2.5' TO SOUTH SIDE OF VAULT.

WCP VAULT NORTHERN PIPE PRODUCTS C-900 SIP MJ GLAND PACKS AND FITTINGS US PIPE DICL PRO-TRACE WIRE

FROM CENTER LINE OF CENTRAL 59.14' NORTH TO CENTER OF VAULT LID

Vault Lid Location: 61.5' N Centerline of Central, 238' E. of Woodlawn.

**METER #: 200426531
 METER READING: 000000
 ERT SERIAL #: 70884140**

APPROVED AS NOTED
 BY WICHITA PUBLIC WORKS
 ENGINEERING DIVISION
 & BY WICHITA FIRE DEPARTMENT

Engineering Shawn Mellies 5/26/2021
 Utilities Greg Lollies 5/26/2021
 Fire Dept. Jose Ocadiz 5/26/2021

NOTE TO CONTRACTORS

Public Property:
 Inspection and testing for the waterline is to be provided by a Licensed Consulting Engineering Firm under contract with the Owner/Developer. Said inspection is to be in accordance with the City of Wichita standard construction engineering practices and certified by a Professional Engineer Licensed in the state of Kansas. No work shall be performed in dedicated easements or public right-of-way by the Contractor without such inspection nor shall any work be commenced without written authorization by City Engineering. All Construction and Materials shall comply with the City or Wichita Specifications and Standards and Special Provision (on file and available in the City Engineer's Office) or on the City's Website.

Private Property:
 Installation and testing for the fire protection line is to be performed by a City of Wichita licensed fire protection contractor in accordance with the fire codes as adopted by the City of Wichita. All material and construction practices for the fire protection line shall comply with the fire codes as adopted by the City of Wichita (available from the City of Wichita Fire Department). The Contractor shall not commence work without notification and approval of the Wichita Fire Department. Inspection of the fire protection line is to be provided by a licensed Engineering Firm under contract with the Owner/Developer and the Fire Department. The contractor shall not start work until the project inspector is assigned to the project and present on the site. Any work done without inspection will be required to be uncovered for inspection.

An approved copy of these plans signed by City staff are required on-site.

BM = SET 1/2" IRON PIN WITH LS1540 CAP OR MAG NAIL WITH LS1540 TAG UNLESS OTHERWISE NOTED.

**STOP!
 CALL BEFORE YOU DIG**
 DIG TESS
 1-800-DIG-TESS
 (@ LEAST 72 HOURS PRIOR TO DIGGING)

LEGAL DESCRIPTION:
 PART OF LOT 1, NORMANDIE CENTER ADDITION
 PC15-10

ADDITION:
 NEW CONSTRUCTION

ADDRESS:
 6420 E. CENTRAL AVENUE

CITY: WICHITA STATE: KANSAS

L/C NUMBER: 015-0101 SHEET NAME: COVER PPW SHEET NO.: C-0

ISSUE REF. BY DESCRIPTION REV. DATE

1903 CENTRAL DR.
 SUITE #406
 BEDFORD, TX 76021
 WWW.CLAYMOOREENG.COM
 KS REGISTRATION #001559545

CLAY MOORE ENGINEERING

DREW DONOSKY
 LICENSED PROFESSIONAL ENGINEER
 27852
 5/26/2021

McDONALD'S

511 E. JOHN CARPENTER FRWY SUITE 375, IRVING, TX 75062

THESE PLANS AND SPECIFICATIONS ARE THE PROPERTY OF MCDONALD'S CORPORATION AND SHALL NOT BE REPRODUCED WITHOUT THEIR WRITTEN CONSENT.

McDONALD'S L/C: 015-0101
 CLAYMOORE ENG. NO. 2020-150

6420 E. CENTRAL AVENUE WICHITA, KS

PLAN APPROVALS

REGIONAL MGR.	CONST. MGR.	OPERATIONS DEPT.	REAL ESTATE DEPT.	CONTRACTOR OWNER

STATUS DATE BY

DATE DRAWN 5/26/2021 CWP

PLAN CHECKED 5/26/2021 CLC

ASBUILT

PLOTTED BY: remih PLOT DATE: May 26, 2021 4:13pm
 LOCATION: Z:\Projects\2020-150 McDonald's Wichita\CADD\SHEETS\C-C COVER.PPW.dwg
 LAST SAVED: 5/26/2021 4:12 PM

GENERAL NOTES

- 1. ALL MATERIAL AND CONSTRUCTION SHALL CONFORM TO THE CITY'S DESIGN STANDARDS.
2. THE CONTRACTOR SHALL BE RESPONSIBLE TO FURNISH ALL MATERIALS AND LABOR TO CONSTRUCT THE FACILITY AS SHOWN AND DESCRIBED IN THE CONSTRUCTION DOCUMENTS IN ACCORDANCE WITH THE APPROPRIATE APPROVING AUTHORITIES, SPECIFICATIONS AND REQUIREMENTS. ALL WORK REQUIRED BY THESE PLANS SHALL BE CONDUCTED IN CONFORMANCE WITH CURRENT SAFETY CODES AND STANDARDS WITH JURISDICTION OVER THIS PROJECT.
3. THE CONTRACTOR SHALL CONTACT ALL FRANCHISE UTILITY COMPANIES TO HAVE THEM LOCATE EXISTING UTILITIES PRIOR TO CONSTRUCTION. THE CONTRACTOR SHALL COORDINATE THE EXACT LOCATION AND DEPTH OF ALL FRANCHISE UTILITY SERVICES AND ANY REQUIRED RELOCATION AND/OR EXTENSIONS. SERVICES SHOWN ON THE PLANS, IF ANY, ARE CONCEPTUAL.
4. THE CONTRACTOR SHALL PROTECT ALL PUBLIC AND PRIVATE UTILITIES IN THE CONSTRUCTION OF THIS PROJECT. ALL MANHOLES, CLEANOUTS, VALVE BOXES, POWER POLES, SIGNS, FIRE HYDRANTS, ETC., MUST BE ADJUSTED TO PROPER GRADE BY THE CONTRACTOR PRIOR TO AND AFTER PLACING OF PERMANENT PAVING. UTILITIES MUST BE MAINTAINED TO PROPER LINE AND GRADE DURING CONSTRUCTION OF THE PAVING FOR THIS PROJECT.
5. BRACING OF UTILITY POLES MAY BE REQUIRED BY UTILITY COMPANIES WHEN TRENCHING OR EXCAVATION IS IN CLOSE PROXIMITY TO THE POLES. THE COST OF BRACING POLES WILL BE BORNE BY THE CONTRACTOR. THERE IS NO SEPARATE PAY ITEM FOR THIS WORK. THE COST IS INCIDENTAL TO THE VARIOUS PAY ITEMS FOR INSTALLATION OF PIPE.
6. THE LOCATIONS, ELEVATIONS, AND DIMENSIONS OF EXISTING UTILITIES SHOWN ON THE PLANS WERE OBTAINED FROM AVAILABLE RECORDS AND ARE CONSIDERED APPROXIMATE. IT SHALL BE THE CONTRACTOR'S RESPONSIBILITY TO VERIFY LOCATIONS, ELEVATIONS, AND DIMENSIONS OF ADJACENT AND/OR CONFLICTING UTILITIES SUFFICIENTLY IN ADVANCE OF CONSTRUCTION IN ORDER THAT ADJUSTMENTS CAN BE MADE TO PROVIDE ADEQUATE CLEARANCES. THE CONTRACTOR SHALL PRESERVE AND PROTECT PUBLIC UTILITIES AT ALL TIMES DURING CONSTRUCTION. ANY DAMAGE TO UTILITIES RESULTING FROM CONTRACTOR'S OPERATIONS SHALL BE RESTORED AT THE CONTRACTOR'S EXPENSE. THE ENGINEER SHALL BE NOTIFIED WHEN PROPOSED FACILITY GRADES CONFLICT WITH EXISTING UTILITY GRADES.
7. THE CONTRACTOR SHALL IMMEDIATELY REPAIR OR REPLACE ANY PHYSICAL DAMAGE TO PRIVATE PROPERTY, INCLUDING, BUT NOT LIMITED TO FENCES, WALLS, PAVEMENT, GRASS, TREES, AND LAWN SPRINKLER AND IRRIGATION SYSTEMS AT NO COST TO THE OWNER. THIS WORK SHALL BE SUBSIDIARY TO THE CONTRACT (UNLESS OTHERWISE NOTED) AND IS NOT A SEPARATE PAY ITEM.
8. THE CONTRACTOR SHALL REMOVE SURPLUS MATERIAL FROM THE PROJECT AREA. THIS WORK SHALL BE SUBSIDIARY TO THE CONTRACT AND IS NOT A SEPARATE PAY ITEM.
9. THE CONTRACTOR SHALL BE RESPONSIBLE FOR OBTAINING ALL NECESSARY PERMITS PRIOR TO CONSTRUCTION.
10. THE CONTRACTOR SHALL HAVE AVAILABLE AT THE JOB SITE AT ALL TIMES A COPY OF THE CONTRACT DOCUMENTS INCLUDING PLANS, SPECIFICATIONS, AND SPECIAL CONDITIONS, COPIES OF ANY REQUIRED CONSTRUCTION PERMITS, EROSION CONTROL PLANS, SWPPP AND INSPECTION REPORTS.
11. ANY DISCREPANCIES ON THE DRAWINGS SHALL BE IMMEDIATELY BROUGHT TO THE ATTENTION OF THE ARCHITECT AND ENGINEER BEFORE COMMENCING WORK. NO FIELD CHANGES OR DEVIATIONS FROM DESIGN SHALL BE MADE WITHOUT PRIOR APPROVAL OF THE OWNER AND NOTIFICATION TO THE ENGINEER. NO CONSIDERATION WILL BE GIVEN TO CHANGE ORDERS FOR WHICH THE OWNER AND ENGINEER WERE NOT CONTACTED PRIOR TO CONSTRUCTION OF THE AFFECTED ITEM.
12. ALL COPIES OF COMPACTION, CONCRETE AND OTHER REQUIRED TEST RESULTS SHALL BE SENT TO THE ARCHITECT, CIVIL ENGINEER, CONTRACTOR AND OWNER DIRECTLY FROM THE TESTING AGENCY.
13. ALL NECESSARY INSPECTIONS AND/OR CERTIFICATIONS REQUIRED BY CODES, JURISDICTIONAL AGENCIES AND/OR UTILITY SERVICE COMPANIES SHALL BE OBTAINED BY THE CONTRACTOR PRIOR TO BUILDING POSSESSION AND THE FINAL CONNECTION OF SERVICES.
14. CONTRACTOR SHALL VERIFY BENCHMARKS AND DATUM PRIOR TO COMMENCING CONSTRUCTION OR STAKING OF IMPROVEMENTS.
15. CONTRACTOR SHALL THOROUGHLY CHECK COORDINATION OF CIVIL, LANDSCAPE, MEP, ARCHITECTURAL, AND OTHER PLANS PRIOR TO COMMENCING CONSTRUCTION. OWNER AND ENGINEER SHALL BE NOTIFIED OF ANY DISCREPANCY PRIOR TO COMMENCING WITH CONSTRUCTION.
16. ALL HORIZONTAL DIMENSIONS GIVEN ARE TO FACE OF CURB AND TO PIPE CENTERLINES UNLESS OTHERWISE NOTED ON PLANS.
17. THE CONTRACTOR IS RESPONSIBLE FOR COORDINATING RELOCATION AND INSTALLATION OF FRANCHISE UTILITIES NECESSARY FOR ON AND OFF SITE CONSTRUCTION. PAYMENT FOR RELOCATION AND INSTALLATION WILL BE NEGOTIATED ONE IDENTIFIED.
18. ALL CUT OR FILL SLOPES SHALL BE 3:1 OR FLATTER UNLESS OTHERWISE SHOWN.
19. THE CONTRACTOR SHALL BE RESPONSIBLE FOR THE CONTROL OF DUST AND DIRT RISING AND SCATTERING IN THE AIR DURING CONSTRUCTION AND SHALL PROVIDE WATER SPRINKLING OR OTHER SUITABLE METHODS OF CONTROL. THE CONTRACTOR SHALL COMPLY WITH ALL GOVERNING REGULATIONS PERTAINING TO ENVIRONMENTAL PROTECTION.
20. UPON COMPLETION OF CONSTRUCTION, THE CONTRACTOR SHALL PROVIDE THE CIVIL ENGINEER A COPY OF RECORD DRAWINGS IDENTIFYING ALL DEVIATIONS OR VARIATIONS FROM THE ORIGINAL PLANS.
21. CONTRACTOR SHALL GIVE NOTICE TO ALL AFFECTED PARTIES AND ALL AUTHORIZED INSPECTORS, SUPERINTENDENTS, OR PERSONS IN CHARGE OF PRIVATE AND PUBLIC UTILITIES OR RAILROADS AFFECTED BY HIS OPERATIONS, AT LEAST 48 HOURS PRIOR TO COMMENCEMENT OF WORK.
22. ALL "RECORD" DIMENSIONS SHALL CONFORM TO THE DESIGN DIMENSIONS PLUS OR MINUS 0.02 FEET. ALL "RECORD" SLOPES SHALL CONFORM TO THE DESIGNED SLOPES PLUS OR MINUS 0.005 FOOT/FOOT.
23. CONTRACTOR SHALL CONTACT CITY BUILDING OFFICIAL TO LEARN OF ANY UNUSUAL CONSTRUCTION SEQUENCING REQUIREMENTS THAT THE CITY MAY REQUIRE. THE CONTRACTOR IS CAUTIONED THAT THIS AND PERHAPS OTHER SUCH REQUIREMENTS MAY EXIST AND IT IS THE CONTRACTOR'S RESPONSIBILITY TO INVESTIGATE AND COMPLY WITH THEM.

PAVING AND STRIPING NOTES

- 1. THE REINFORCED PORTLAND CEMENT CONCRETE SHOULD HAVE A MINIMUM 28 DAY COMPRESSIVE STRENGTH OF 4,000 PSI AND A MINIMUM REINFORCING THAT SHOULD BE IN ACCORDANCE WITH ACCEPTED CODES AND SHALL STRICTLY ADHERE TO DETAILS INCLUDED IN THIS SET. A BASE SUB-GRADE PER THE GEOTECHNICAL REPORT IS REQUIRED BENEATH ALL PAVING.
2. TESTING OF MATERIALS REQUIRED FOR THE CONSTRUCTION OF THE PAVING IMPROVEMENTS SHALL BE PERFORMED BY AN AGENCY, APPROVED BY THE OWNER, FOR TESTING MATERIALS. PROCUREMENT OF THE TESTING LABORATORY AND THE PAYMENT OF SUCH TESTING SERVICES SHALL BE MADE BY THE OWNER. IT SHALL BE THE CONTRACTOR'S RESPONSIBILITY TO ENSURE, BY THE STANDARD TESTING PROCEDURES, THAT THE WORK CONSTRUCTED MEETS THE REQUIREMENTS OF THE CITY AND PROJECT SPECIFICATIONS.
3. ALL SIGNS, PAVEMENT MARKINGS, AND OTHER TRAFFIC CONTROL DEVICES SHALL CONFORM TO THE "KANSAS MANUAL ON UNIFORM TRAFFIC CONTROL DEVICES".
4. THE CONTRACTOR SHALL REVIEW LOCATION OF ALL TRAFFIC CONTROL DEVICES WITH THE OWNER PRIOR TO INSTALLATION.
5. SEE M.E.P. PLANS FOR LOCATION OF PROPOSED SLEEVING AND CONDUITS.
6. ALL HANDICAP RAMPING, STRIPING, AND PAVEMENT MARKINGS SHALL CONFORM TO THE MOST RECENT VERSION OF THE AMERICANS WITH DISABILITIES ACT OF 1994, AND ALL ADDENDUMS OR UPDATES.
7. CONTRACTOR SHALL SUBMIT A PAVEMENT JOINTING PLAN TO THE ENGINEER AND OWNER PRIOR TO THE BEGINNING OF ANY CONCRETE PAVING WORK.
8. ANY EXISTING CONCRETE OR ASPHALT SHOWN TO BE REMOVED SHALL BE PROPERLY DISPOSED OF BY THE CONTRACTOR OFF SITE. THIS WORK SHALL BE SUBSIDIARY TO THE CONTRACT AND IS NOT A SEPARATE PAY ITEM.
9. CONSTRUCTION JOINTS SHALL BE REQUIRED AT INTERRUPTIONS OF PAVING OPERATIONS SUCH AS THOSE OCCURRING AT THE END OF THE DAY OR DUE TO WEATHER OR EQUIPMENT BREAKDOWN. PLACE AT LONGITUDINAL CONSTRUCTION OR ISOLATION JOINT LOCATIONS.
10. CONTRACTOR TO INSTALL CONSTRUCTION JOINTS IN CONCRETE PAVEMENT AT ALL PC'S AND AS CONVENIENT TO PHASING OF POURS. CONCRETE PAVEMENT TO BE CONSTRUCTED WITH ISOLATION JOINTS AROUND THE PERIMETER OF ANY BLOCK OUT IN PAVEMENT AND SAWED DUMMY JOINTS EVERY 12' IN BOTH DIRECTIONS.
11. ALL JOINTS ARE TO CONTINUE THROUGH THE CURB.
12. RADIAL JOINTS SHALL BE NO SHORTER THAN 24".
13. ALL CONSTRUCTION JOINTS SHALL BE SAVED, CLEANED OF DEBRIS, BLOWN DRY AND IMMEDIATELY SEALED WITH HOT POURED RUBBER JOINT SEALING COMPOUND.

STORM SEWER NOTES

- 1. CONTRACTOR SHALL FIELD VERIFY THE VERTICAL AND HORIZONTAL LOCATIONS OF ALL EXISTING UTILITIES PRIOR TO START OF CONSTRUCTION. THE CONTRACTOR SHALL NOTIFY THE ENGINEER AND CONSTRUCTION MANAGER IMMEDIATELY IF A CONFLICT IS DISCOVERED.
2. CONTRACTOR SHALL VERIFY AND COORDINATE ALL DIMENSIONS SHOWN, INCLUDING THE HORIZONTAL AND VERTICAL LOCATION OF CURB INLETS, GRATE INLETS, AND ALL UTILITIES CROSSING THE STORM SEWER FLOW LINES AND RIMS OF PROPOSED INLETS SHALL BE VERIFIED WITH THE PROPOSED GRADE PRIOR TO CONSTRUCTION.
3. THE END OF ALL STORM SEWER LATERALS THAT CONNECT TO WORK BY PLUMBER SHALL BE TIGHTLY PLUGGED OR CAPPED AND MARKED 5.0 FEET OUTSIDE THE BUILDING UNTIL FINAL CONNECTIONS ARE MADE BY PLUMBING CONTRACTOR.
4. THE SITE UTILITY CONTRACTOR SHALL PROVIDE ALL MATERIALS AND APPURTENANCES NECESSARY FOR COMPLETE INSTALLATION OF THE STORM SEWER.
5. CONTRACTOR IS RESPONSIBLE FOR OBTAINING ALL CONSTRUCTION PERMITS.
6. THE GENERAL CONTRACTOR AND ALL SUBCONTRACTORS SHALL VERIFY THE SUITABILITY OF ALL EXISTING AND PROPOSED SITE CONDITIONS INCLUDING GRADES AND DIMENSIONS BEFORE COMMENCEMENT OF CONSTRUCTION. THE ENGINEER SHALL BE NOTIFIED IMMEDIATELY OF ANY DISCREPANCIES.
7. EXISTING MANHOLE TOPS AND ALL OTHER DRAINAGE FACILITIES SHALL BE ADJUSTED AS REQUIRED TO MATCH FINAL GRADES AS SHOWN ON GRADING PLAN. NO SEPARATE PAY ITEM.
8. ALL RCP SHALL BE CLASS 3 OR APPROVED EQUAL.

STORM SEWER DISCHARGE AUTHORIZATION

- 1. IF THE TOTAL DISTURBED AREA EXCEEDS ONE (1) ACRE A NOTICE OF INTENT (N.O.I.) SHALL BE SUBMITTED BY THE CONTRACTOR TO THE TCEQ NO LESS THAN 48 HOURS PRIOR TO COMMENCEMENT OF CONSTRUCTION ACTIVITIES.
2. ALL CONTRACTORS AND SUBCONTRACTORS PROVIDING SERVICES RELATED TO THE SWPPP SHALL SIGN A CONTRACTOR CERTIFICATION STATEMENT ACKNOWLEDGING THEIR RESPONSIBILITIES AS SPECIFIED IN THE SWPPP.
3. A COPY OF THE SWPPP, INCLUDING CONTRACTOR CERTIFICATIONS AND ANY REVISIONS, SHALL BE SUBMITTED TO THE CITY AND FILED WITH THE CONSTRUCTION PLANS, AND SHALL BE RETAINED ON-SITE DURING CONSTRUCTION.
4. A NOTICE OF TERMINATION (N.O.T.) SHALL BE SUBMITTED TO THE TCEQ BY THE CONTRACTOR WHEN THE SITE HAS 100% OF THE DISTURBED AREAS STABILIZED AND THE SITE NO LONGER HAS STORM WATER DISCHARGE ASSOCIATED WITH INDUSTRIAL ACTIVITIES (CONSTRUCTION), OR THE N.O.T. PERMITTEE OR CO-PERMITTEE NO LONGER HOLDS OPERATIONAL CONTROL OF THE CONSTRUCTION.

WATER NOTES

- 1. EXISTING UTILITY DATA IS PROVIDED FOR INFORMATION ONLY. ALTHOUGH THIS DATA IS SHOWN AS ACCURATELY AS POSSIBLE, THE CONTRACTOR IS CAUTIONED THAT THE DEVELOPER AND THE ENGINEER NEITHER ASSUMES NOR IMPLIES ANY RESPONSIBILITY FOR THE ACCURACY OF THIS DATA.
2. THE CONTRACTOR IS TO VERIFY LOCATION AND ELEVATION OF EXISTING UTILITIES PRIOR TO CONSTRUCTION.
3. HORIZONTAL AND VERTICAL BLOCKING FOR WATER LINES HAS BEEN OMITTED FOR CLARITY. HOWEVER, BLOCKING SHALL BE CONSTRUCTED IN ACCORDANCE WITH CITY STANDARDS AND SPECIFICATIONS.
4. TRENCHES WHICH LAY OUTSIDE EXISTING OR FUTURE PAVEMENTS SHALL BE BACK FILLED ABOVE THE TOP OF THE EMBEDMENT WITH TYPE 'C' BACKFILL MATERIALS. WHEN TYPE 'C' BACKFILL MATERIAL IS NOT SUITABLE AND AT THE DIRECTION OF THE ENGINEER TYPE 'B' MATERIAL SHALL BE USED. ALL BACKFILL MATERIAL SHALL BE COMPACTED TO A MINIMUM OF 90% PROCTOR DENSITY BY MEANS OF TAMPING ONLY. TRENCHES WHICH CROSS UNDER EXISTING OR FUTURE PAVEMENT SHALL BE BACK FILLED PER FIGURE 'A' WITH 95% PROCTOR STANDARD DENSITY OF -2, +4 OF OPTIMUM MOISTURE CONTENT.
5. TOP OF WATER LINES SHALL BE A MINIMUM OF 42" BELOW TOP OF CURB EXCEPT WHERE SHOWN OTHERWISE IN THESE PLANS.
6. FIRE HYDRANTS SHALL BE A MINIMUM 3' BEHIND THE FACE OF THE CURB UNLESS OTHERWISE DIRECTED BY THE CITY. FIRE HYDRANTS AND VALVES AS SHOWN ON THESE PLANS ARE SYMBOLIC ONLY.
7. CORPORATION STOPS SHALL BE TESTED FOR FULL FLOW WHEN THE SYSTEM IS PRESSURE TESTED.
8. ALL NEW WATER MAINS SHALL BE FULLY PURGED.
9. ALL 6", 8", 10" & 12" WATER MAINS SHALL BE PVC AWWA C900, DR-14.
10. FITTINGS SHALL BE DUCTILE IRON AND MECHANICAL JOINT TYPE, WITH "COR-BLUE" BOLTS AND SHALL BE CLASS 250.

SANITARY SEWER NOTES

- 1. EXISTING UTILITY DATA IS PROVIDED FOR INFORMATION ONLY. ALTHOUGH THIS DATA IS SHOWN AS ACCURATELY AS POSSIBLE, THE CONTRACTOR IS CAUTIONED THAT THE DEVELOPER AND THE ENGINEER NEITHER ASSUMES NOR IMPLIES ANY RESPONSIBILITY FOR THE ACCURACY OF THIS DATA.
2. THE CONTRACTOR IS TO VERIFY LOCATION AND ELEVATION OF EXISTING UTILITIES PRIOR TO CONSTRUCTION.
3. TRENCHES WHICH LIE OUTSIDE EXISTING PAVEMENTS SHALL BE BACKFILLED ABOVE THE TOP OF THE EMBEDMENT WITH TYPE "C" BACKFILL MATERIAL. WHEN TYPE "C" BACKFILL MATERIAL IS NOT SUITABLE AND AT THE DIRECTION OF THE ENGINEER, TYPE "B" MATERIAL SHALL BE USED. ALL BACKFILL MATERIAL SHALL BE COMPACTED TO A MINIMUM OF 90% OF THE MAXIMUM DRY DENSITY BY MEANS OF TAMPING ONLY. TRENCHES THAT CROSS UNDER EXISTING OR FUTURE PAVEMENT SHALL BE BACKFILLED AND COMPACTED TO A MINIMUM OF 95% OF THE MAXIMUM DRY DENSITY WITH MOISTURE CONTENT -2 AND +4% OF OPTIMUM MOISTURE CONTENT.
4. TYPICAL LOCATION OF SANITARY SEWER PIPE SHALL BE A MINIMUM OF 4'-0" BELOW TOP OF CURB EXCEPT WHERE SHOWN OTHERWISE IN THESE PLANS.
5. ALL FLEXIBLE SANITARY SEWER MAINS SHALL BE TESTED WITH STANDARD 5% DEFLECTION MANDREL.
6. ALL SANITARY SEWER LINES SHALL BE CAPPED WITH AN APPROPRIATE CAP AT THE END OF EACH WORKDAY.
7. WHEN EXISTING GRADES ARE LOWER THAN PROPOSED MAINS, THE FILL AREA OVER THE PIPE SHALL BE FILLED AND COMPACTED TO A MINIMUM OF 95% OF THE MAXIMUM DRY DENSITY TO THE PROPOSED FINISHED GRADE PRIOR TO INSTALLING ANY MAIN.
8. ALL SEWER SERVICES SHALL BE CONSTRUCTED OF SDR-35 PIPE.

TRAFFIC CONTROL NOTES

 
- 1. CONTRACTOR SHALL PROVIDE TRAFFIC CONTROL PLANS TO THE OWNER AND CITY INSPECTION STAFF, AT LEAST 48 HOURS PRIOR TO CONSTRUCTION ACTIVITY.
2. ALL TRAFFIC CONTROL MEASURES SHALL BE INSTALLED AND MAINTAINED IN ACCORDANCE WITH THE KANSAS MANUAL ON UNIFORM TRAFFIC CONTROL DEVICES, LATEST VERSION.
3. THE CONTRACTOR SHALL COVER EXISTING SIGNS AND OBLITERATE EXISTING PAVEMENT MARKINGS THAT CONFLICT WITH THE INTENT OF THESE TRAFFIC CONTROL PLANS TO AVOID CONFUSION TO THE TRAVELING PUBLIC.
4. THE CONTRACTOR SHALL UNCOVER EXISTING SIGNS AND REPLACE PAVEMENT MARKINGS IN-KIND AS ORIGINALLY CONFIGURED AT THE END OF CONSTRUCTION OPERATIONS AND PRIOR TO FINAL ACCEPTANCE BY THE OWNER.
5. ALL TEMPORARY SIGNS, BARRICADES, WARNING LIGHTS AND OTHER MISCELLANEOUS TRAFFIC CONTROL MEASURES SHALL BE REMOVED AND ORIGINAL TRAFFIC CONTROL MEASURES REPLACED AT THE END OF THE CONTRACTOR'S CONSTRUCTION OPERATIONS.

EROSION CONTROL NOTES

- 1. THE CONTRACTOR SHALL COMPLY WITH ALL FEDERAL, STATE, AND LOCAL EROSION, CONSERVATION, AND SILTATION ORDINANCES. THE CONTRACTOR SHALL USE SEDIMENT FILTERS OR OTHER MEASURES APPROVED BY THE ENGINEER AND CONSTRUCTION MANAGER TO PREVENT SILT AND CONSTRUCTION DEBRIS FROM CLOGGING STORM SEWER PIPES OR PROPOSED OR EXISTING INLETS, OR FROM BEING TRANSPORTED TO ADJACENT PROPERTIES AND STREET RIGHT-OF-WAYS. ALL EROSION CONTROL DEVICES SHALL BE INSTALLED PRIOR TO SITE DISTURBANCE AND SHALL REMAIN IN PLACE UNTIL FINAL GRADING AND PAVING IS COMPLETE AND PERMANENT SOIL STABILIZATION IS ACHIEVED.
2. CONSTRUCTION OPERATIONS SHALL BE MANAGED SO THAT AS MUCH OF THE SITE AS POSSIBLE IS LEFT COVERED WITH EXISTING TOPSOIL AND VEGETATION.
3. ALL SLOPES AND AREAS DISTURBED BY CONSTRUCTION SHALL BE GRADED SMOOTH. THE AREAS SHALL THEN BE SEEDED (OR SODDED), IRRIGATED, AND MAINTAINED UNTIL PERMANENT STAND OF GRASS IS ACHIEVED WITH A MINIMUM OF 70% COVERAGE. UNLESS OTHERWISE NOTED, PRIVATE LAWN AREAS AND PARKWAYS IN FRONT OF PRIVATE LAWN AREAS DISTURBED BY CONSTRUCTION SHALL BE REPLACED WITH BLOCK SOD SIMILAR TO THAT EXISTING.
4. CONTRACTOR SHALL CONSTRUCT A STABILIZED CONSTRUCTION ENTRANCE AT ALL PRIMARY POINTS OF ACCESS. CONTRACTOR IS RESPONSIBLE FOR ENSURING THAT ALL CONSTRUCTION TRAFFIC UTILIZES THE STABILIZED ENTRANCE AT ALL TIMES FOR INGRESS/EGRESS TO THE SITE.
5. CONSTRUCTION ENTRANCE:
- MINIMUM SIZE STONE: 5-INCHES DIAMETER
- THICKNESS: NOT LESS THAN 8-INCHES
- LENGTH: AS SHOWN ON PLAN
- WIDTH: NOT LESS THAN FULL WIDTH OF ALL POINTS OF INGRESS AND EGRESS.
- MAINTENANCE REQUIREMENTS: AS NECESSARY TO PREVENT TRACKING OR FLOWING MUD INTO PUBLIC RIGHT-OF-WAY OR PARKING AREAS.
6. SITE ENTRY AND EXIT LOCATIONS SHALL BE MAINTAINED IN A CONDITION WHICH SHALL PREVENT TRACKING OR FLOWING OF SEDIMENT ONTO PUBLIC ROADWAYS. ALL SEDIMENT SPILLED, DROPPED, WASHED OR TRACKED ON A PUBLIC ROADWAY SHALL BE REMOVED IMMEDIATELY. WHEN WASHING IS REQUIRED TO REMOVE SEDIMENT PRIOR TO ENTRANCE TO A PUBLIC ROADWAY, IT SHALL BE DONE ON AN AREA STABILIZED WITH CRUSHED STONE WHICH DRAINS INTO AN APPROVED SEDIMENT BASIN. ALL FINES IMPOSED FOR TRACKING ONTO PUBLIC ROADS SHALL BE PAID BY THE CONTRACTOR.
7. CONTRACTOR IS RESPONSIBLE FOR PROPER MAINTENANCE OF THE REQUIRED EROSION CONTROL DEVICES THROUGHOUT THE ENTIRE CONSTRUCTION PROCESS. EROSION CONTROLS SHALL BE REPAIRED OR REPLACED AS INSPECTION DEEMS NECESSARY, OR AS DIRECTED BY THE OWNER'S REPRESENTATIVE. ACCUMULATED SILT IN ANY EROSION CONTROL DEVICE SHALL BE REMOVED AND SHALL BE DISTRIBUTED ON SITE IN A MANNER NOT CONTRIBUTING TO ADDITIONAL SILTATION. THE CONTRACTOR IS RESPONSIBLE FOR RE-ESTABLISHING ANY EROSION CONTROL DEVICE WHICH IS DISTURBED.
8. THE CONTRACTOR SHALL MAINTAIN ADEQUATE SITE DRAINAGE DURING ALL PHASES OF CONSTRUCTION. THE CONTRACTOR SHALL USE FILTER BARRIER (OR OTHER METHOD APPROVED BY THE ENGINEER AND CITY) AS REQUIRED TO PREVENT ADVERSE OFF SITE IMPACTS OR STORM WATER QUALITY FROM SILT AND CONSTRUCTION DEBRIS FLOWING ONTO ADJACENT PROPERTIES AS REQUIRED BY THE CITY.
9. BEFORE ANY EARTHWORK IS DONE, THE CONTRACTOR SHALL STAKE OUT AND MARK THE LIMITS OF CONSTRUCTION AND OTHER ITEMS ESTABLISHED BY THE PLANS. THE CONTRACTOR SHALL PROTECT AND PRESERVE CONTROL POINTS AT ALL TIMES DURING THE COURSE OF THE PROJECT. THE GRADING CONTRACTOR SHALL PROVIDE ALL NECESSARY ENGINEERING AND SURVEYING FOR LINE AND GRADE CONTROL POINTS RELATED TO EARTHWORK.
10. CONTRACTOR STAGING AREA TO BE AGREED UPON BY OWNER PRIOR TO BEGINNING CONSTRUCTION.
11. THE CONTRACTOR MUST REVIEW AND MAINTAIN A COPY OF THE STORM WATER POLLUTION PREVENTION PLAN WITH ALL CONDITIONS, ATTACHMENTS, EXHIBITS, AND PERMIT MODIFICATIONS IN GOOD CONDITION AT THE CONSTRUCTION SITE. THE COMPLETE PERMIT MUST BE AVAILABLE FOR REVIEW UPON REQUEST BY THE T.C.E.Q. OR THE GOVERNING CITY.


GRADING NOTES

- 1. IF A GRADING PERMIT IS REQUIRED FROM THE CITY PRIOR TO STARTING CONSTRUCTION, CONTRACTOR IS RESPONSIBLE FOR OBTAINING PERMIT AND PAYING ALL ASSOCIATED FEES.
2. CONTRACTOR SHALL FIELD VERIFY HORIZONTAL AND VERTICAL LOCATION OF ALL EXISTING UTILITIES PRIOR TO CONSTRUCTION. CONTRACTOR IS RESPONSIBLE FOR PROTECTING EXISTING UTILITIES (SHOWN OR NOT SHOWN) WITHIN SCOPE OF CONSTRUCTION. IF ANY EXISTING UTILITIES ARE DAMAGED, THE CONTRACTOR SHALL REPLACE THEM AT HIS OWN EXPENSE.
3. ALL SPOT ELEVATIONS SHOWN ARE TO TOP OF PAVING SURFACE OR FINISHED EARTH GRADE UNLESS NOTED OTHERWISE.
4. CONTRACTOR TO ENSURE POSITIVE DRAINAGE FROM THE EXISTING AND PROPOSED BUILDINGS AND NO PONDING IN PAVED AREAS. CONTRACTOR ADJUSTMENTS TO SPOT GRADES TO MAINTAIN POSITIVE DRAINAGE IS ALLOWED WITH THE PRIOR APPROVAL OF THE ENGINEER. CONTRACTOR SHALL CONTACT THE ENGINEER PRIOR TO PAVING IF ANY AREAS OF POOR DRAINAGE ARE ENCOUNTERED.
5. THE CONTRACTOR SHALL PROTECT ALL MANHOLE COVERS, VALVE COVERS, VAULT LIDS, FIRE HYDRANTS, POWER POLES, GUY WIRES, AND TELEPHONE BOXES WHICH ARE TO REMAIN IN PLACE AND UNDISTURBED DURING CONSTRUCTION.
6. ALL EXISTING CONCRETE PAVING, CHANNEL IMPROVEMENTS, SIDEWALK, STRUCTURES AND CURB DEMOLITION SHALL BE REMOVED IN THEIR ENTIRETY AND DISPOSED OF BY THE CONTRACTOR, OFFSITE UNLESS OTHERWISE DIRECTED BY THE OWNER OR ENGINEER.
7. ALL CLEARING, GRADING, COMPACTION AND SUBGRADE PREPARATION SHALL BE IN ACCORDANCE TO THE GEOTECHNICAL REPORT.
8. GRADING CONTRACTOR TO COORDINATE WITH THE FRANCHISE UTILITY COMPANIES FOR ANY REQUIRED UTILITY ADJUSTMENTS AND/OR RELOCATIONS.
9. THE CONTRACTOR SHALL CALCULATE HIS OWN EARTHWORK QUANTITIES AND USE TO DETERMINE HIS BID ACCORDINGLY.
10. BEFORE PLACING PAVEMENT, CONTRACTOR SHALL VERIFY THAT SUITABLE HANDICAPPED ROUTES (PER A.D.A. & T.A.S) EXIST TO AND FROM EVERY DOOR. IN NO CASE SHALL HANDICAP RAMP SLOPES EXCEED 1 VERTICAL TO 12 HORIZONTAL. IN NO CASE SHALL SIDEWALK CROSS SLOPES EXCEED 2.0 PERCENT. IN NO CASE SHALL LONGITUDINAL SIDEWALK SLOPES EXCEED 5.0 PERCENT. CONTRACTOR SHALL CONTACT ENGINEER PRIOR TO PAVING IF ANY EXCESSIVE SLOPES ARE ENCOUNTERED. NO CONTRACTOR CHANGE ORDERS WILL BE ACCEPTED FOR A.D.A. AND T.A.S. COMPLIANCE ISSUES.



IF CONTRACTOR IS TO ENCOUNTER ANY CONFLICTS, THE CITY OF WICHITA DESIGN STANDARDS AND PROCEDURES SHALL TAKE PRECEDENCE

1903 CENTRAL DR. SUITE #406 PHONE: 817.281.0572 BEDFORD, TX 76021 WWW.CLAYMOOREENGINEERING.COM KS REGISTRATION #60159645

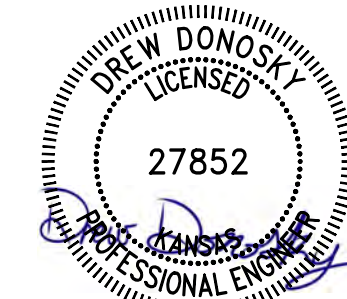

5/24/2021




McDONALD'S logo and address: 511 E JOHN CARPENTER FRWY SUITE 375, IRVING, TX 75062. 6420 E. CENTRAL AVENUE WICHITA, KS. McDONALD'S L.C. 015-0101, 2020-150. THESE PLANS AND SPECIFICATIONS ARE THE PROPERTY OF McDONALD'S CORPORATION AND SHALL NOT BE REPRODUCED WITHOUT THEIR WRITTEN CONSENT.

Table with columns: PLAN APPROVALS, SIGNATURE (2 REQUIRED), DATE, REGIONAL MGR, CONST. MGR, OPERATIONS DEPT., REAL ESTATE DEPT., CO-SIGN SIGNATURE, CONTRACTOR, OWNER.

Table with columns: LEGAL DESCRIPTION, ADDRESS, CITY, STATE, L/C NUMBER, SHEET NAME, SHEET NO.

STOP! CALL BEFORE YOU DIG DIG TESS 1-800-DIG-TESS (@ LEAST 72 HOURS PRIOR TO DIGGING)

PLOTTED BY: remth PLOT DATE: May 24, 2021, 8:42pm
 LOCATION: Z:\Projects\2020-150 McDONALD'S Wichita\CADD\SHEETS\C-2 EROSION CONTROL PLAN.dwg
 LAST SAVED: 5/22/2021 11:28 PM

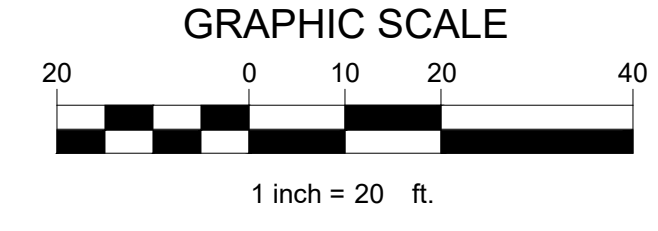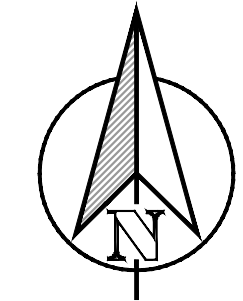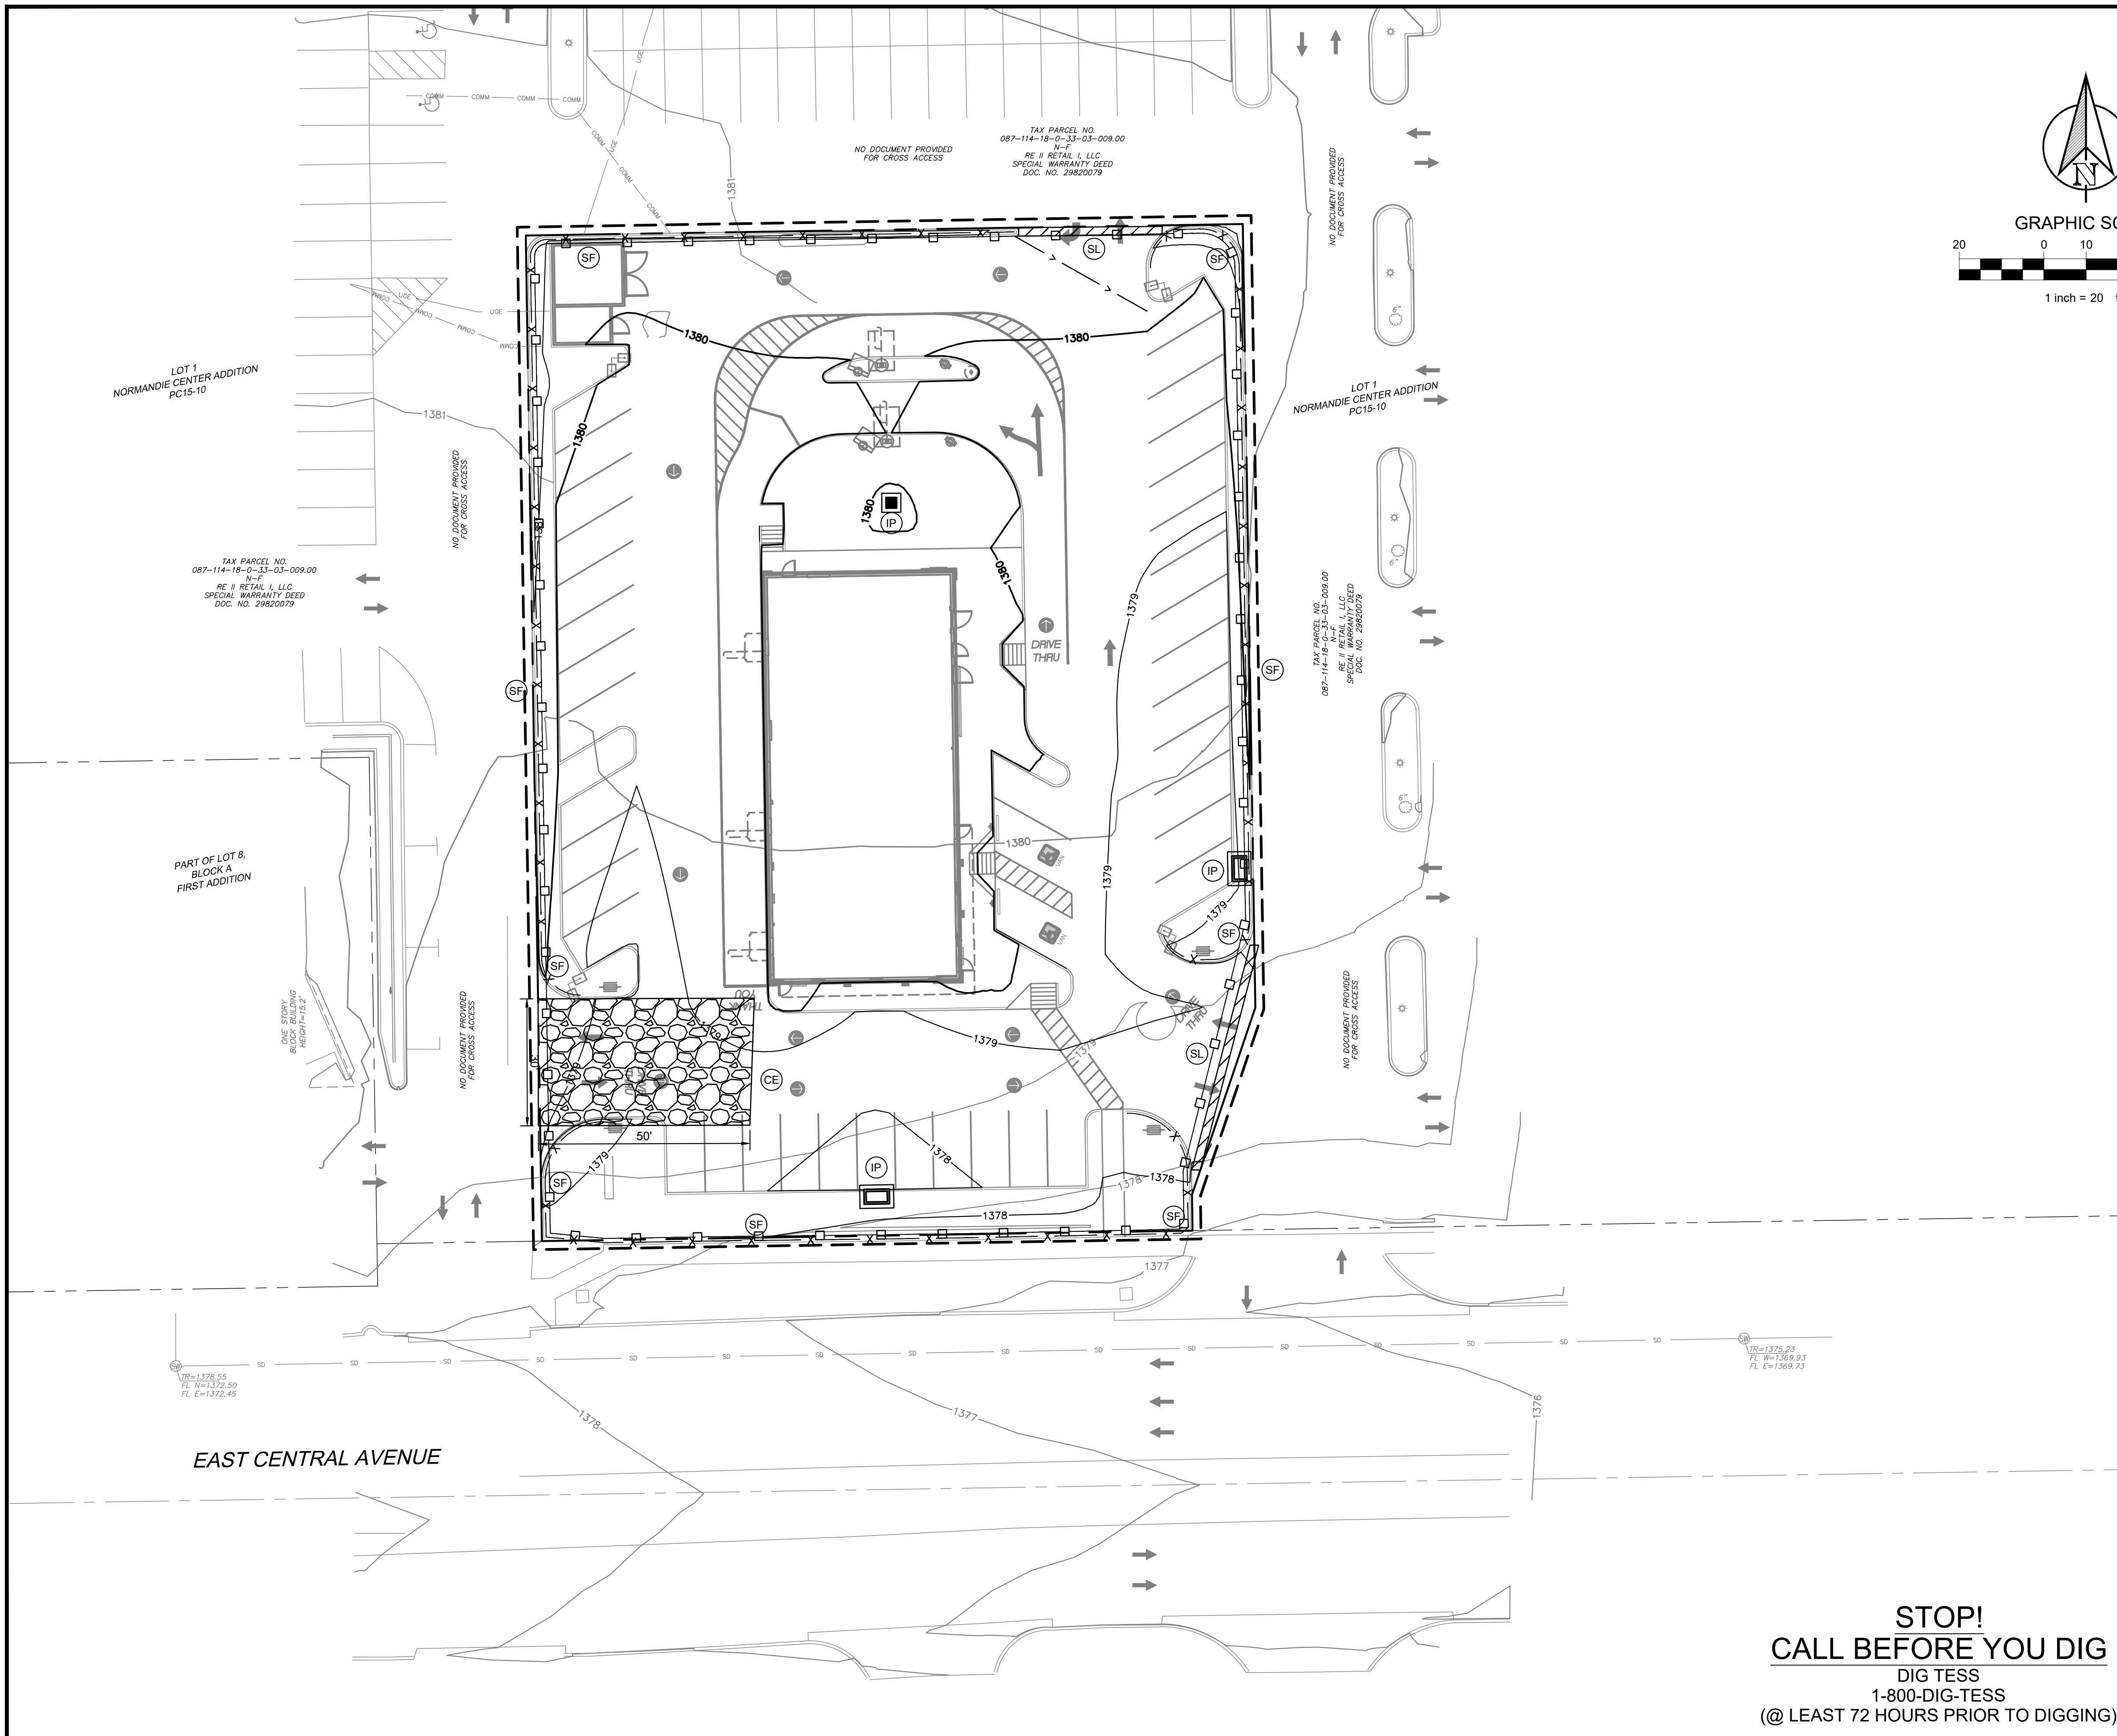

LEGEND	
	DIRECTION OF FLOW
	EXISTING CONTOUR
	PROPOSED CONTOUR
	LIMITS OF CONSTRUCTION
	CONSTRUCTION FENCE
	SILT FENCE
	CONSTRUCTION ENTRANCE
	SEDIMENT LOG
	INLET PROTECTION

ACREAGE SUMMARY	
ONSITE DISTURBED AREA	0.95 AC
TOTAL DISTURBED AREA	0.95 AC

• BM = SET 1/2" IRON PIN WITH LS1540 CAP OR MAG NAIL WITH LS1540 TAG UNLESS OTHERWISE NOTED.

STOP!
CALL BEFORE YOU DIG
 DIG TESS
 1-800-DIG-TESS
 (@ LEAST 72 HOURS PRIOR TO DIGGING)

LEGAL DESCRIPTION: PART OF LOT 1, NORMANDIE CENTER ADDITION PC15-10	
ADDITION: NEW CONSTRUCTION	
ADDRESS: 6420 E. CENTRAL AVENUE	
CITY: WICHITA	STATE: KANSAS
L/C NUMBER: 015-0101	SHEET NAME: EROSION CONTROL PLAN

ISSUE REF	BY	DESCRIPTION	REV	DATE

	<p>1903 CENTRAL DR. SUITE #406 BEDFORD, TX 76021 WWW.CLAYMOOREENGINEERING.COM KS REGISTRATION #60159945</p> <p>CLAYMOORE ENGINEERING</p>
--	---

5/24/2021

OFFICE	GREATER SOUTHWEST REGION
ADDRESS	511 E JOHN CARPENTER FRWY SUITE 375, IRVING, TX 75062

McDONALD'S

THESE PLANS AND SPECIFICATIONS ARE THE PROPERTY OF McDONALD'S CORPORATION AND SHALL NOT BE REPRODUCED WITHOUT THEIR WRITTEN CONSENT.



6420 E. CENTRAL AVENUE WICHITA, KS

McDONALD'S L.C. 015-0101	CLAYMOORE ENG. NO. 2020-150
--------------------------	-----------------------------


PLAN APPROVALS	DATE
SIGNATURE (2 REQUIRED)	
REGIONAL MGR.	
CONST. MGR.	
OPERATIONS DEPT.	
REAL ESTATE DEPT.	
CO-SIGN SIGNATURE	
CONTRACTOR	
OWNER	

STATUS	DATE	BY
DATE DRAWN	5/24/2021	CWP
PLAN CHECKED	5/24/2021	CLC
ASBUILT		

SHEET NO.	C-2
-----------	-----

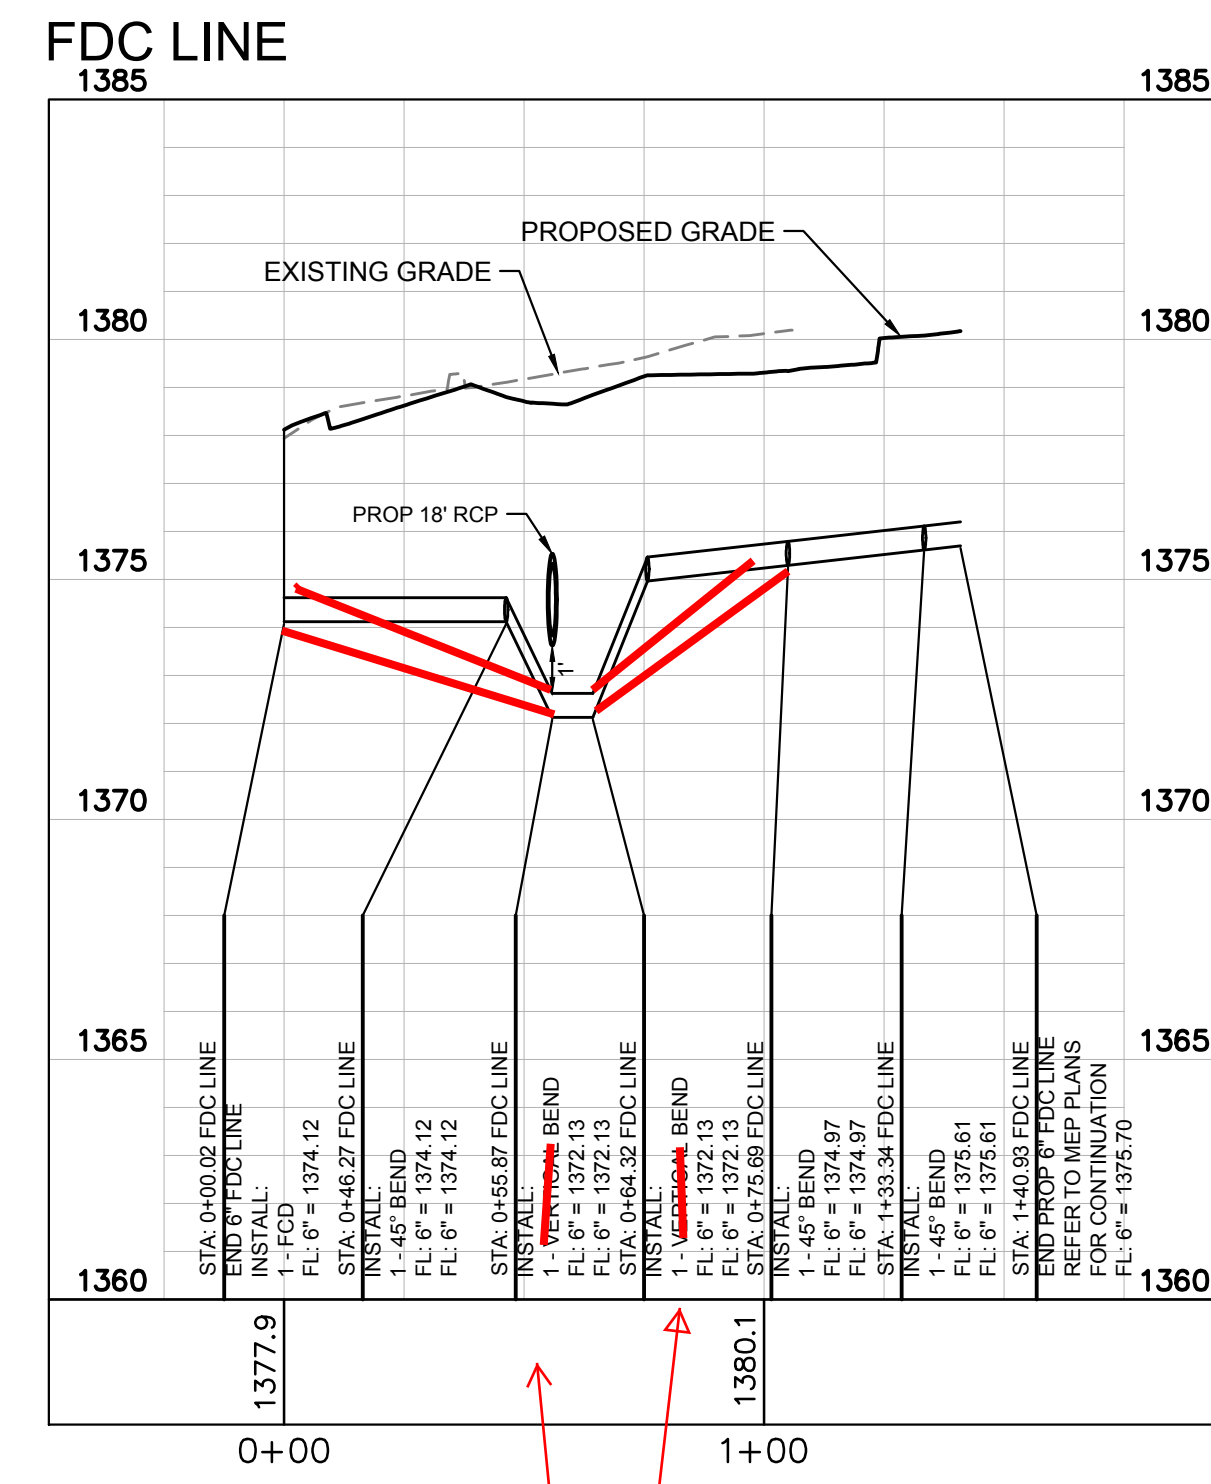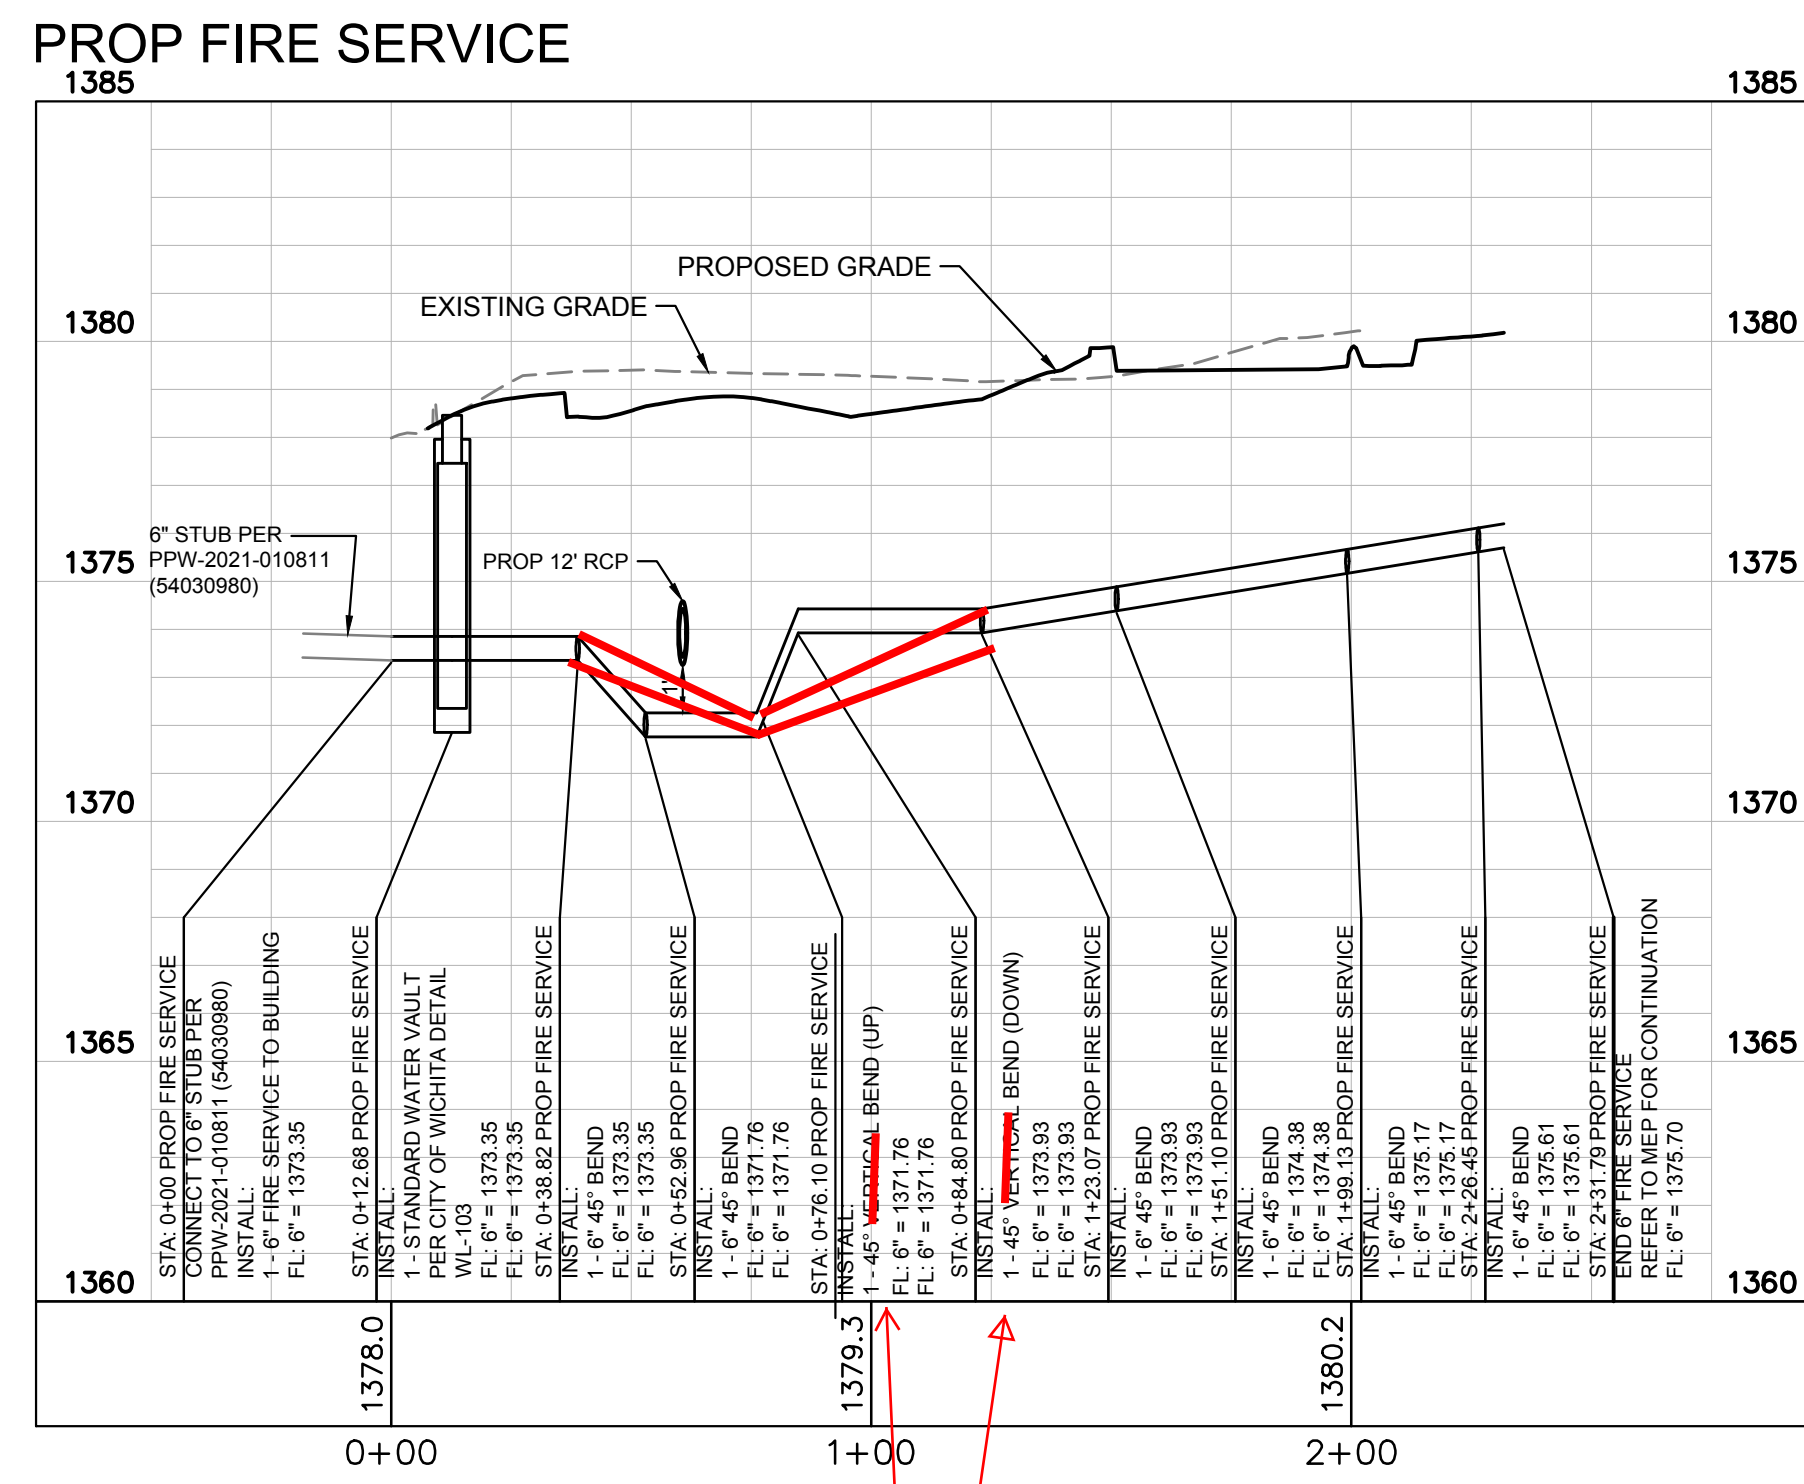


AS BUILTS



1903 CENTRAL DR.
SUITE #406
BEDFORD, TX 76021
WWW.KEMILLERENGINEERING.COM
KS REGISTRATION #60159945

 117 E. Lewis,
Wichita, KS 67202 (316)264-0242



REV	DATE	DESCRIPTION	BY	ISSUE REF



LEGAL DESCRIPTION: PART OF LOT 1, NORMANDIE CENTER ADDITION PC15-10		STATUS		DATE		BY	
ADDITION: NEW CONSTRUCTION		REGIONAL MGR.		DATE DRAWN		5/25/2021 CWP	
ADDRESS: 6420 E. CENTRAL AVENUE		CONST. MGR.		PLAN CHECKED		5/25/2021 CLC	
CITY: WICHITA STATE: KANSAS		OPERATIONS DEPT.		ASBUILT		SHEET NO. C-5	
L/C NUMBER: 015-0101 SHEET NAME: PPW WATER PROFILES		REAL ESTATE DEPT.		CONTRACTOR		OWNER	
CO-SIGN SIGNATURE		CO-SIGN SIGNATURE		CONTRACTOR		OWNER	

OFFICE: GREATER SOUTHWEST REGION
ADDRESS: 511 E. JOHN CARPENTER FRWY SUITE 375, IRVING, TX 75062

McDONALD'S

THESE PLANS AND SPECIFICATIONS ARE THE PROPERTY OF McDONALD'S CORPORATION AND SHALL NOT BE REPRODUCED WITHOUT THEIR WRITTEN CONSENT.

6420 E. CENTRAL AVENUE WICHITA, KS
McDONALD'S L/C: 015-0101
CLAYMOORE ENG. NO. 2020-150