

# GENERAL NOTES:


- The Contractor shall comply with all applicable safety regulations. All construction shall be completed following current City Standard Specifications and Special Provisions.
- Contractor will be required to provide notice to utility companies a minimum of seventy-two (72) hours prior to any excavation, as follows:  
Kansas One-Call 687-2470  
The Contractor must notify the following in case of an emergency:  
AT&T 1-800-246-8464  
Black Hills Energy 1-800-694-8989  
City of Wichita Water & Sewer 1-316-219-8921  
City of Wichita Stormwater 1-316-268-4090  
City of Wichita Traffic 1-316-268-4034  
Cox Communications 1-888-249-3530  
Kansas Gas Service 1-888-482-4950  
Westar Energy 1-800-544-4857
- Utility service lines, poles, etc. are to be adjusted as necessary by others prior to construction unless the plans specifically call for their adjustment by the Contractor or unless the plans specifically identify a utility to be adjusted by its owner during construction. Existing utilities and their location, as shown on the plans, represent the best information obtainable for design. The Contractor will be required to work around existing utilities within the right-of-way which do not conflict with proposed construction.
- Rubble from the removal of miscellaneous structures and excess excavation which is to be wasted shall be disposed of on sites to be provided by the Contractor. These sites shall be approved by the Engineer as to suitability, appearance and site location. Locations, in the opinion of the Engineer, that will leave an unsightly appearance will not be approved. All disposal sites must be approved by the Kansas Department of Health and Environment. Material either stockpiled or disposed of in a flood plain will require a Kansas State Board of Agriculture permit. Any material dumped in waters of the United States or wetlands is subject to U.S. Corps. of Engineers permitting regulations. Any material buried or stockpiled beyond approved construction limits will require additional archaeological investigations unless buried in a previously approved borrow location.
- Trees and shrubs in public right-of-way which are in direct conflict with proposed new construction shall be removed by the Contractor with the City Engineer's approval. Trees and shrubs which are not in direct conflict with proposed new construction shall be saved and protected from damage.
- The Contractor shall give all property owners and/or tenants of developed property abutting the construction of this project a minimum of ten (10) days notice prior to start of construction.
- The Contractor shall be responsible for preserving property irons. The Contractor will be required to re-establish any property irons which are damaged or destroyed by his construction operations. Such irons shall be re-established by a licensed land surveyor in accordance with state laws.
- The Engineering Division shall field locate water valves one time during construction when requested by the Contractor. It shall be the Contractor's responsibility to preserve such field locations during the construction process. Water valves, valve boxes or fire hydrants damaged during construction shall be repaired by Contractor at his own expense. Valve boxes and water meters within the project limits shall be adjusted to match final grades by the contractor.
- The Contractor shall notify the consultant engineer and Dawnita Reinhardt at 316-650-0740 with the City of Wichita with the anticipated construction start date and notify them of project completion. Staking and inspection for this project will be the responsibility of the Contractor.
- If traffic will be impacted by construction, a traffic control plan must be submitted and approved by the City Traffic Engineer, Mike Armour at traffic@wichita.gov before construction can begin. The Contractor shall be responsible for all traffic control measures to facilitate construction. All construction zone markings and signage shall conform to the latest version of the Manual on Uniform Traffic Control Devices (MUTCD) as published by the US Dept. of Transportation, Federal Highway Administration. All costs associated with construction markings and signage shall be the Contractors responsibility.
- All elevations shown are NAVD 88.
- All areas disturbed during construction that will not be under proposed pavement shall be restored to match existing conditions.

- Any sidewalk, drive approach, curb, or street pavement removed to construct project must have a pavement cut permit and be replaced by the City contractor. Permits can be obtained by calling 316-268-4501 or 316-268-4480.
- All applicable fees (tap, equity, in lieu of & main benefit) must be paid before any work on this project can commence.
- City maintenance of water mains ends at right-of-way or easement line or within two feet of vault.
- Opening and closing of water valves shall be done slowly to prevent damage to the water distribution system from water hammer. All valves closed by the contractor must be reopened as new construction permits. The project inspector must ascertain that any valve closed by the Contractor is reopened. The contractor will be permitted to operate water valves only when the project inspector assigned to the project is present.
- The Contractor shall lay a Tracer Wire and Set Test Stations along all water pipe installed in accordance with City Specifications and Tracer Wire Detail on detail sheet WL-101, cost is subsidiary to pipe installation.
- The contractor shall provide materials for temporary blowoff of waterlines. Connections to the existing waterline(s) shall be made with clean, swabbed pipe and flushed upon completion of tie-ins.
- Requests for short term water interruptions shall be made to the City Water Distribution Division and will be subject to their approval. The Contractor shall give written notice to any property owner, business, and/or tenants that will have water service interrupted at least 5 days in advance. Such notifications should indicate the time and date that the water will be turned off and when the service will be restored. No business, property owner, and/or tenants shall be without water service for more than 8 hours. Proposed tie in locations which will affect water service to property owners shall be preformed during non-peak hours.
- The Contractor must schedule the connections to the existing main with the City such that there is a minimum disruption of service. Connections shall be made during periods of low water usage. The Contractor shall submit his proposed schedule for completing work for City approval at least 10 days prior to beginning construction.
- Deflections at pipe joint or couplings shall not exceed the pipe manufactures recommended maximum. Where deflections are greater than the maximum allowed, the contractor shall utilize fittings.
- Any existing joint exposed during excavation shall be replaced if within four feet of proposed joint.
- Valves 12 inch and larger are to be operated by the City Water Distribution Division, 48 hours of advance notice is required with the water Dispatch at 316-291-8921.
- All wet taps shall be installed by the City of Wichita. The Contractor will reimburse the City for tapping fees prior to tap being made. Unless noted on plans.
- The Contractor shall protect from damage and support existing utilities through construction as approved by the utility owner and the Engineer at the contractors expense.
- Contractor shall limit the extent of trench openings overnight and weekends to less than 50 feet.
- Fire Line inspections may be scheduled by calling 316-650-0740
- Maintain a minimum of 10-foot horizontal separation between all water lines (mains, services, and fire hydrants) and all sanitary sewer lines (mains, services, and manholes). All separation distances are to be measured from edge-to-edge at the closest point.
- Maintain a minimum of 2-foot vertical separation between all water lines (mains and services) and all gravity sanitary lines (mains, services, and manholes) at crossings. All separation distances are to be measured from edge-to-edge, at the closest point.
- Maintain a minimum of 2-foot vertical separation between all water lines (mains and services) and all pressurized sanitary sewer lines (force mains and services) at crossings. Waterlines must always be placed above pressurized sanitary sewer lines where they cross. All separation distances are to be measured edge-to-edge, at the closest point.

**Benchmark:**  
City Disc North side of Maple street, approximately 38 feet west of center line of Maple Lane and 42.20 feet due north of 1/4 section.  
Elevation=1310.58 NAVD 88  
Rebar with cap marking the northeast property corner of Lot 1 Ernest Jordan Addition  
Elevation=1305.21 NAVD 88

# FIRE LINE to serve Vintage Court Duplexes 361 - 387 N Julia Near Taft & Julia Street CITY OF WICHITA, KANSAS


Gary Janzen, P.E. City Engineer  
Project Number  
PPW - 2022 - 009803  
Org Code: 54030980

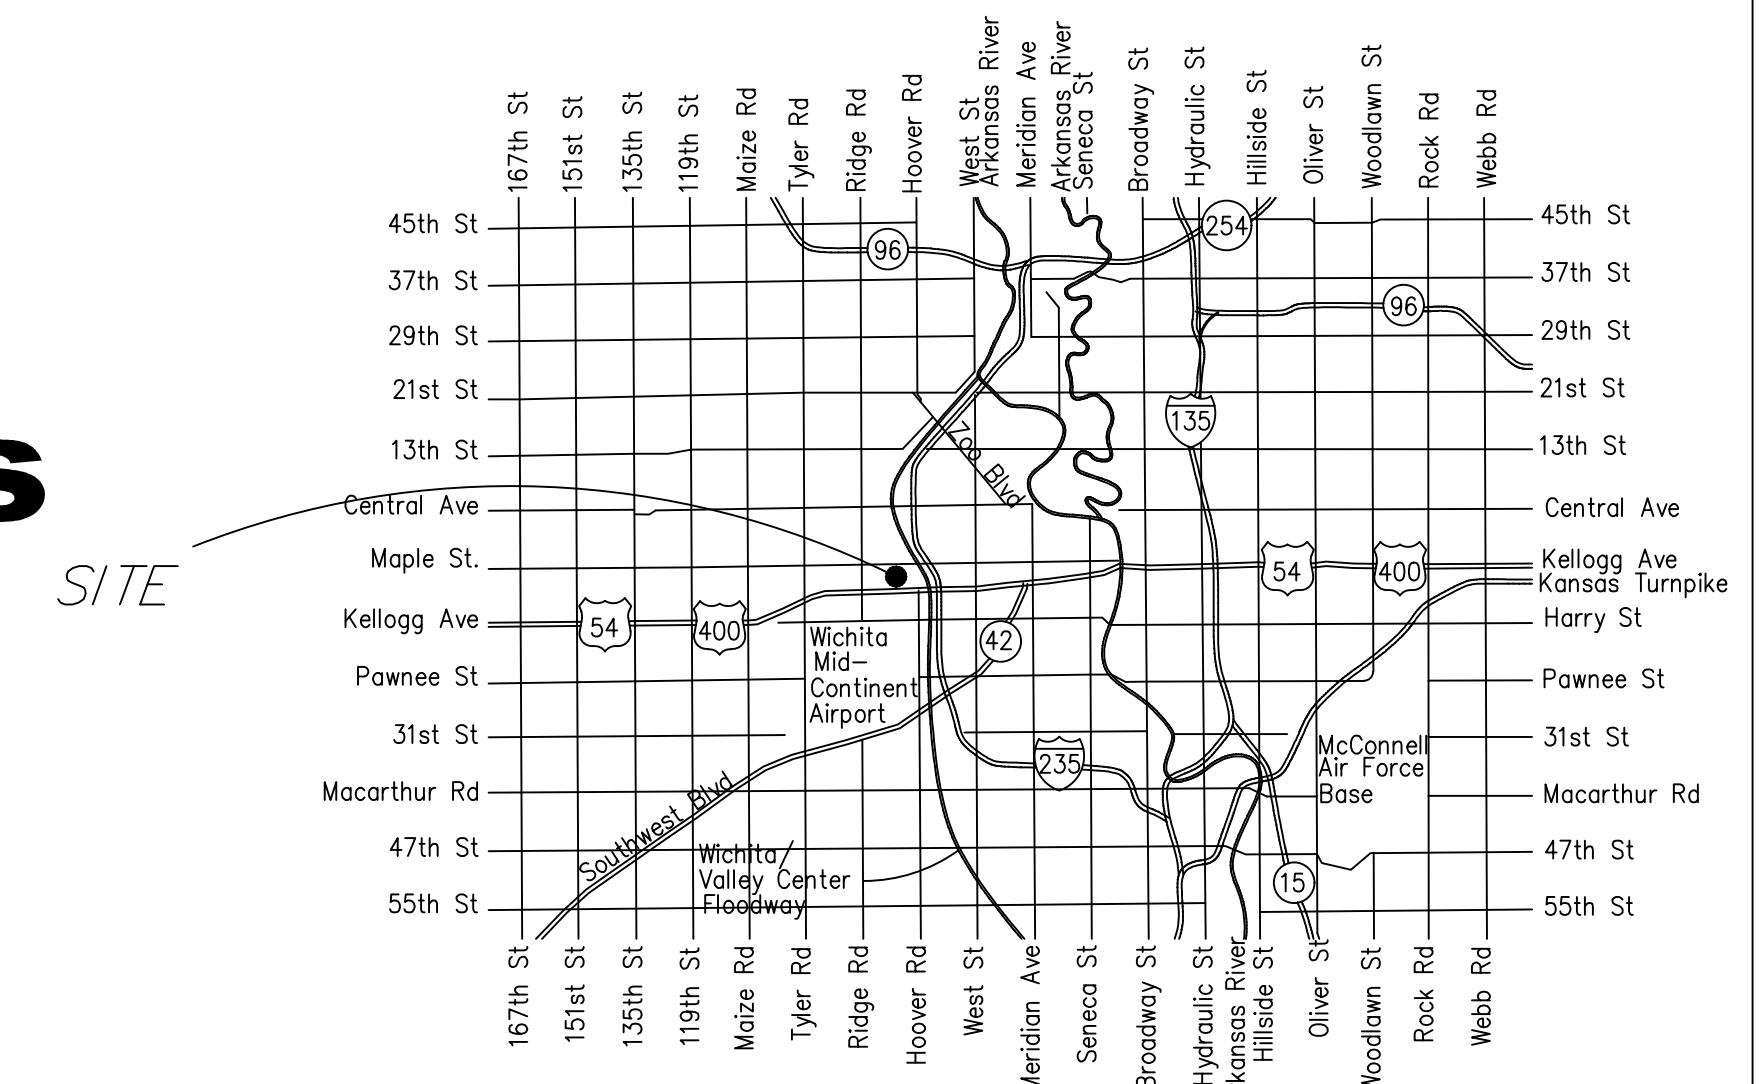

## Vicinity Map

## Sheet Index


- 1.0 Title Sheet
- 2.1 Std Water Ass'y Detail
- 2.2 Misc. Water Detail
- 2.3 Standard Vault Detail
- 3.0 Plan and Profile Line 1
- 3.1 Plan and Profile Line 2
- 4.1-4.5 Erosion Control Details
- 5.0 Plat (For Reference Only)

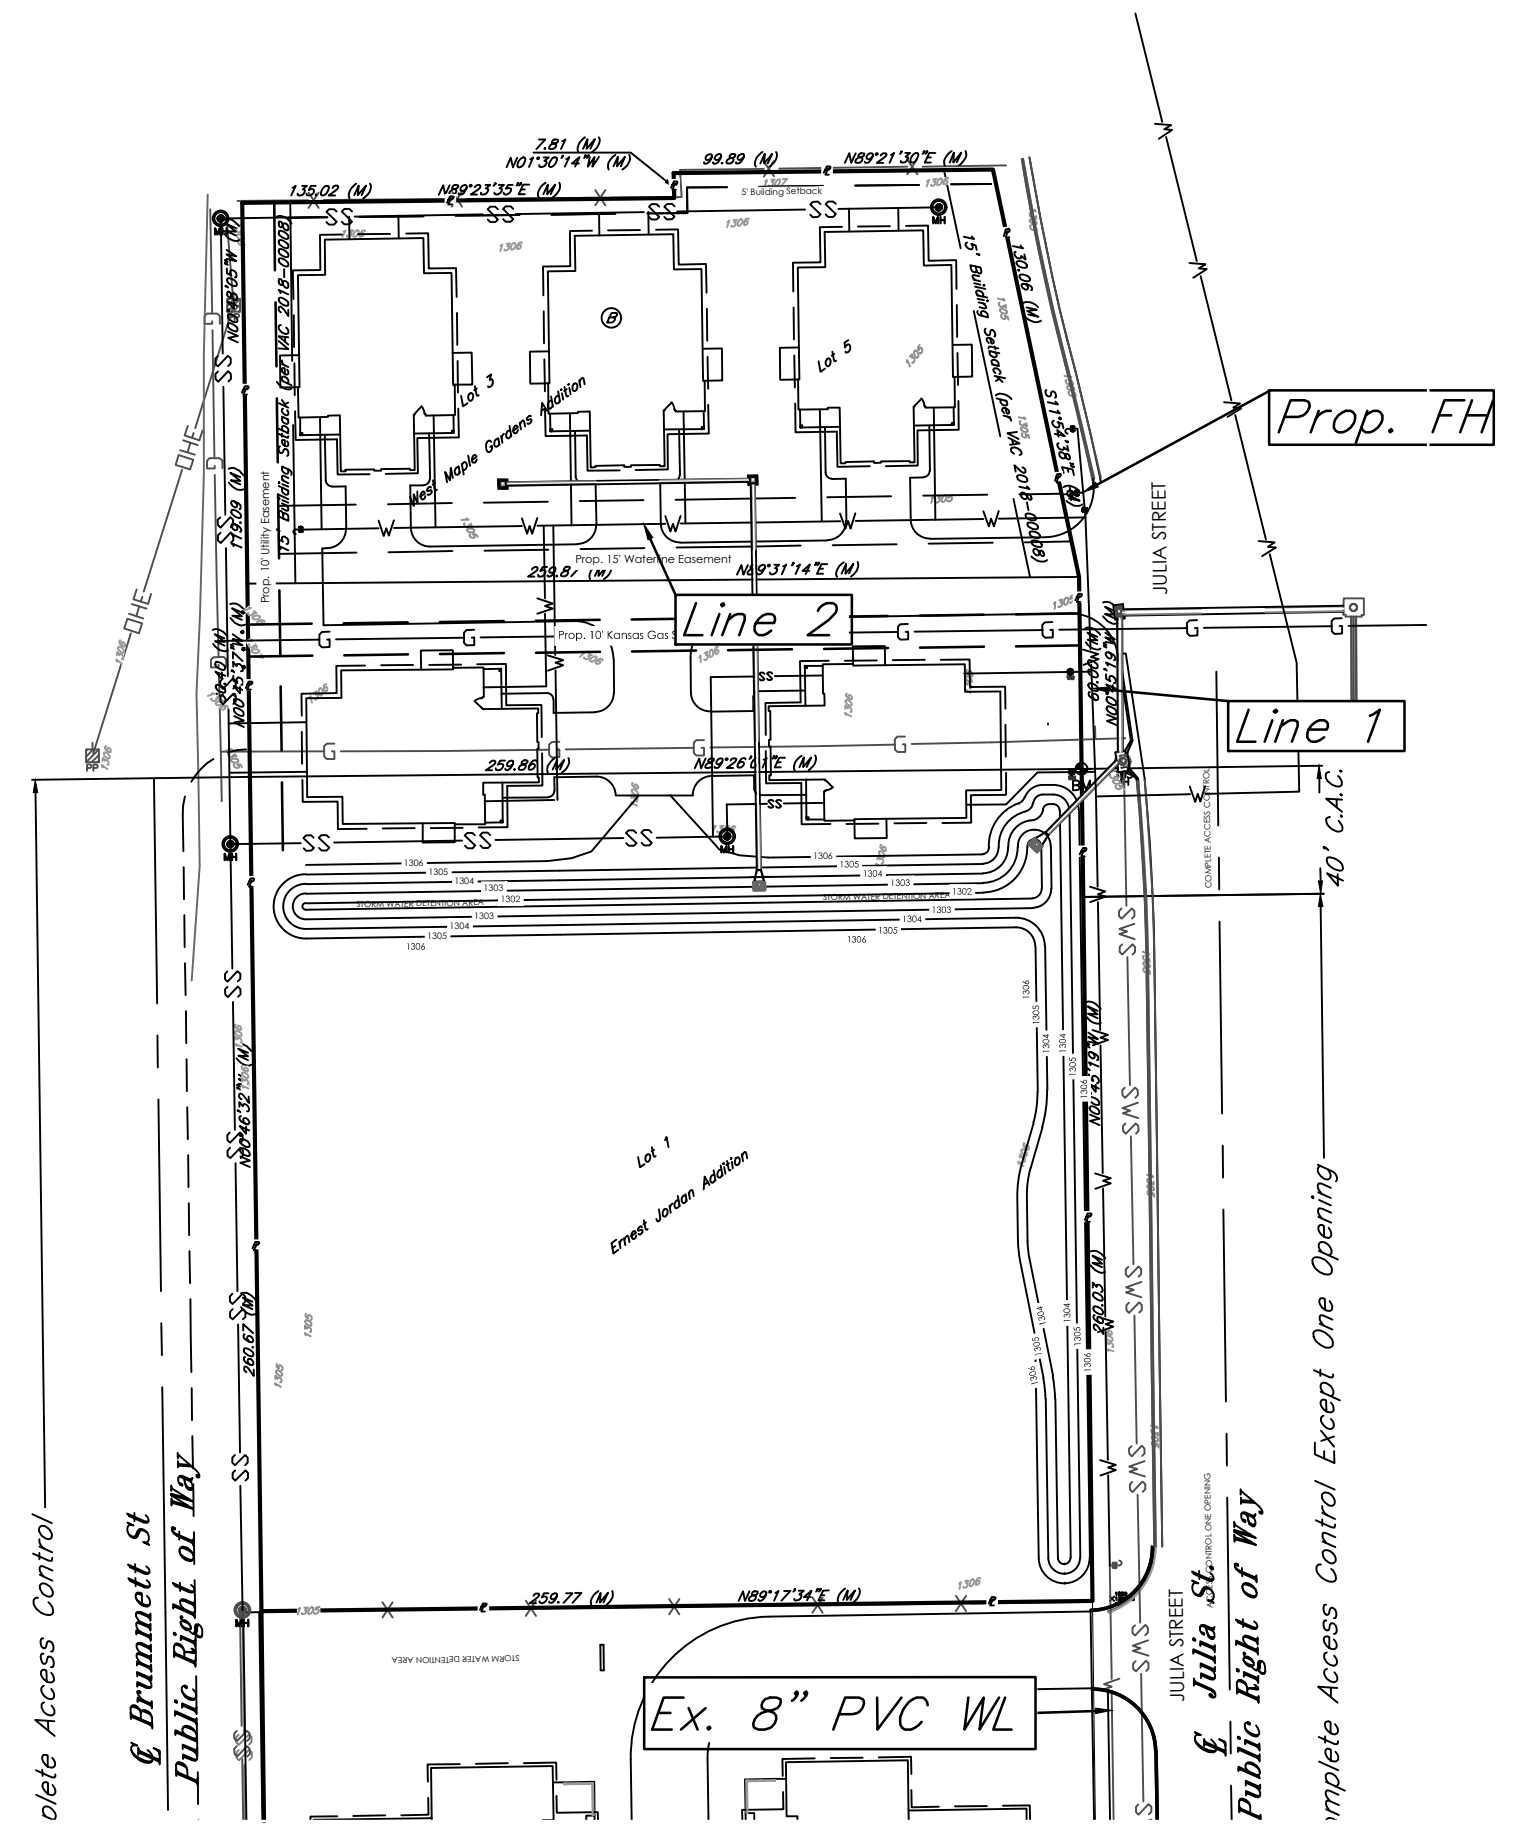

THIS SHEET HAS BEEN SIGNED, SEALED AND DATED DIGITALLY

**AS BUILTS**

<b>Contractor:</b> Ewertz Excavation  18 AUG 2022	<b>Project Inspector:</b> Eric Miner  117 E. Lewis, Wichita, KS 67202 (316)264-0242
--	--

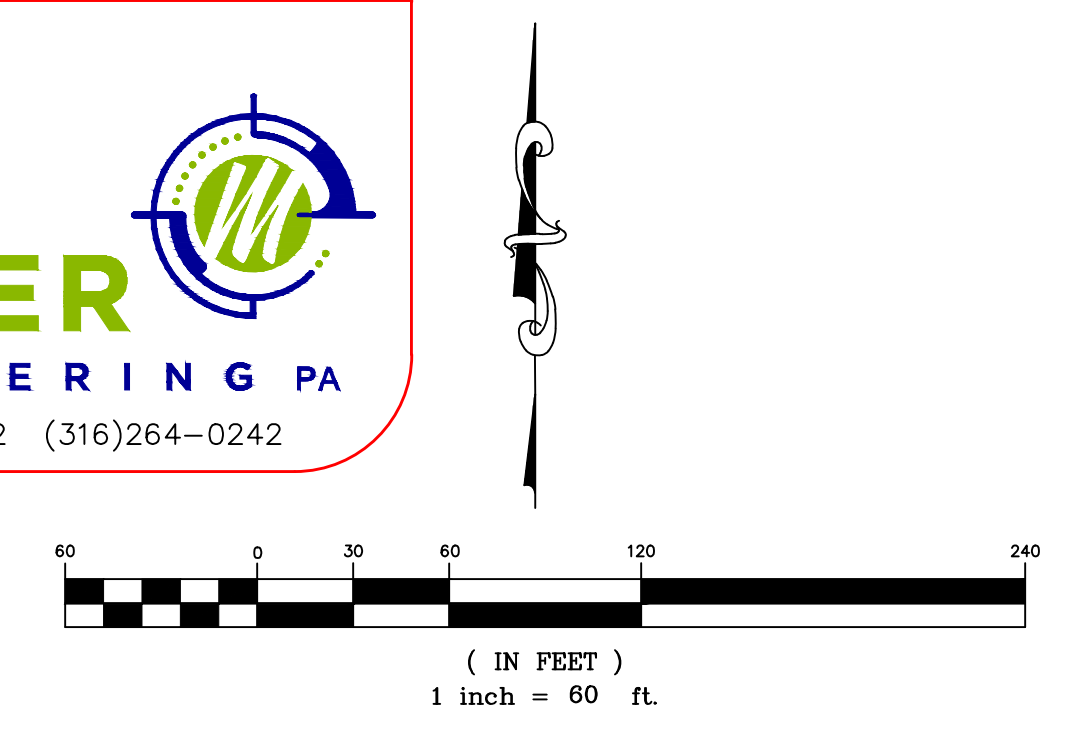

APPROVED AS NOTED  
BY WICHITA PUBLIC WORKS  
ENGINEERING DIVISION  
& BY WICHITA FIRE DEPARTMENT

Engineering \_\_\_\_\_  
Utilities \_\_\_\_\_  
Fire Dept. \_\_\_\_\_

NOTE TO CONTRACTORS

**Public Property:**  
Inspection and testing for the waterline is to be provided by a Licensed Consulting Engineering Firm under contract with the Owner/Developer. Said inspection is to be in accordance with the City of Wichita standard construction engineering practices and certified by a Professional Engineer Licensed in the state of Kansas. No work shall be performed in dedicated easements or public right-of-way by the Contractor without such inspection nor shall any work be commenced without written authorization by City Engineering. All Construction and Materials shall comply with the City or Wichita Specifications and Standards and Special Provision (on file and available in the City Engineer's Office) or on the City's Website.


**Private Property:**  
Installation and testing for the fire protection line is to be performed by a City of Wichita licensed fire protection contractor in accordance with the fire codes as adopted by the City of Wichita. All material and construction practices for the fire protection line shall comply with the fire codes as adopted by the City of Wichita (available from the City of Wichita Fire Department). The Contractor shall not commence work without notification and approval of the Wichita Fire Department. Inspection of the fire protection line is to be provided by a licensed Engineering Firm under contract with the Owner/Developer and the Fire Department. The contractor shall not start work until the project inspector is assigned to the project and present on the site. Any work done without inspection will be required to be uncovered for inspection.

An approved copy of these plans signed by City staff are required on-site.

**KEMILLER**  
ENGINEERING PA

117 E. Lewis, Wichita, KS 67202 (316)264-0242

March, 2022

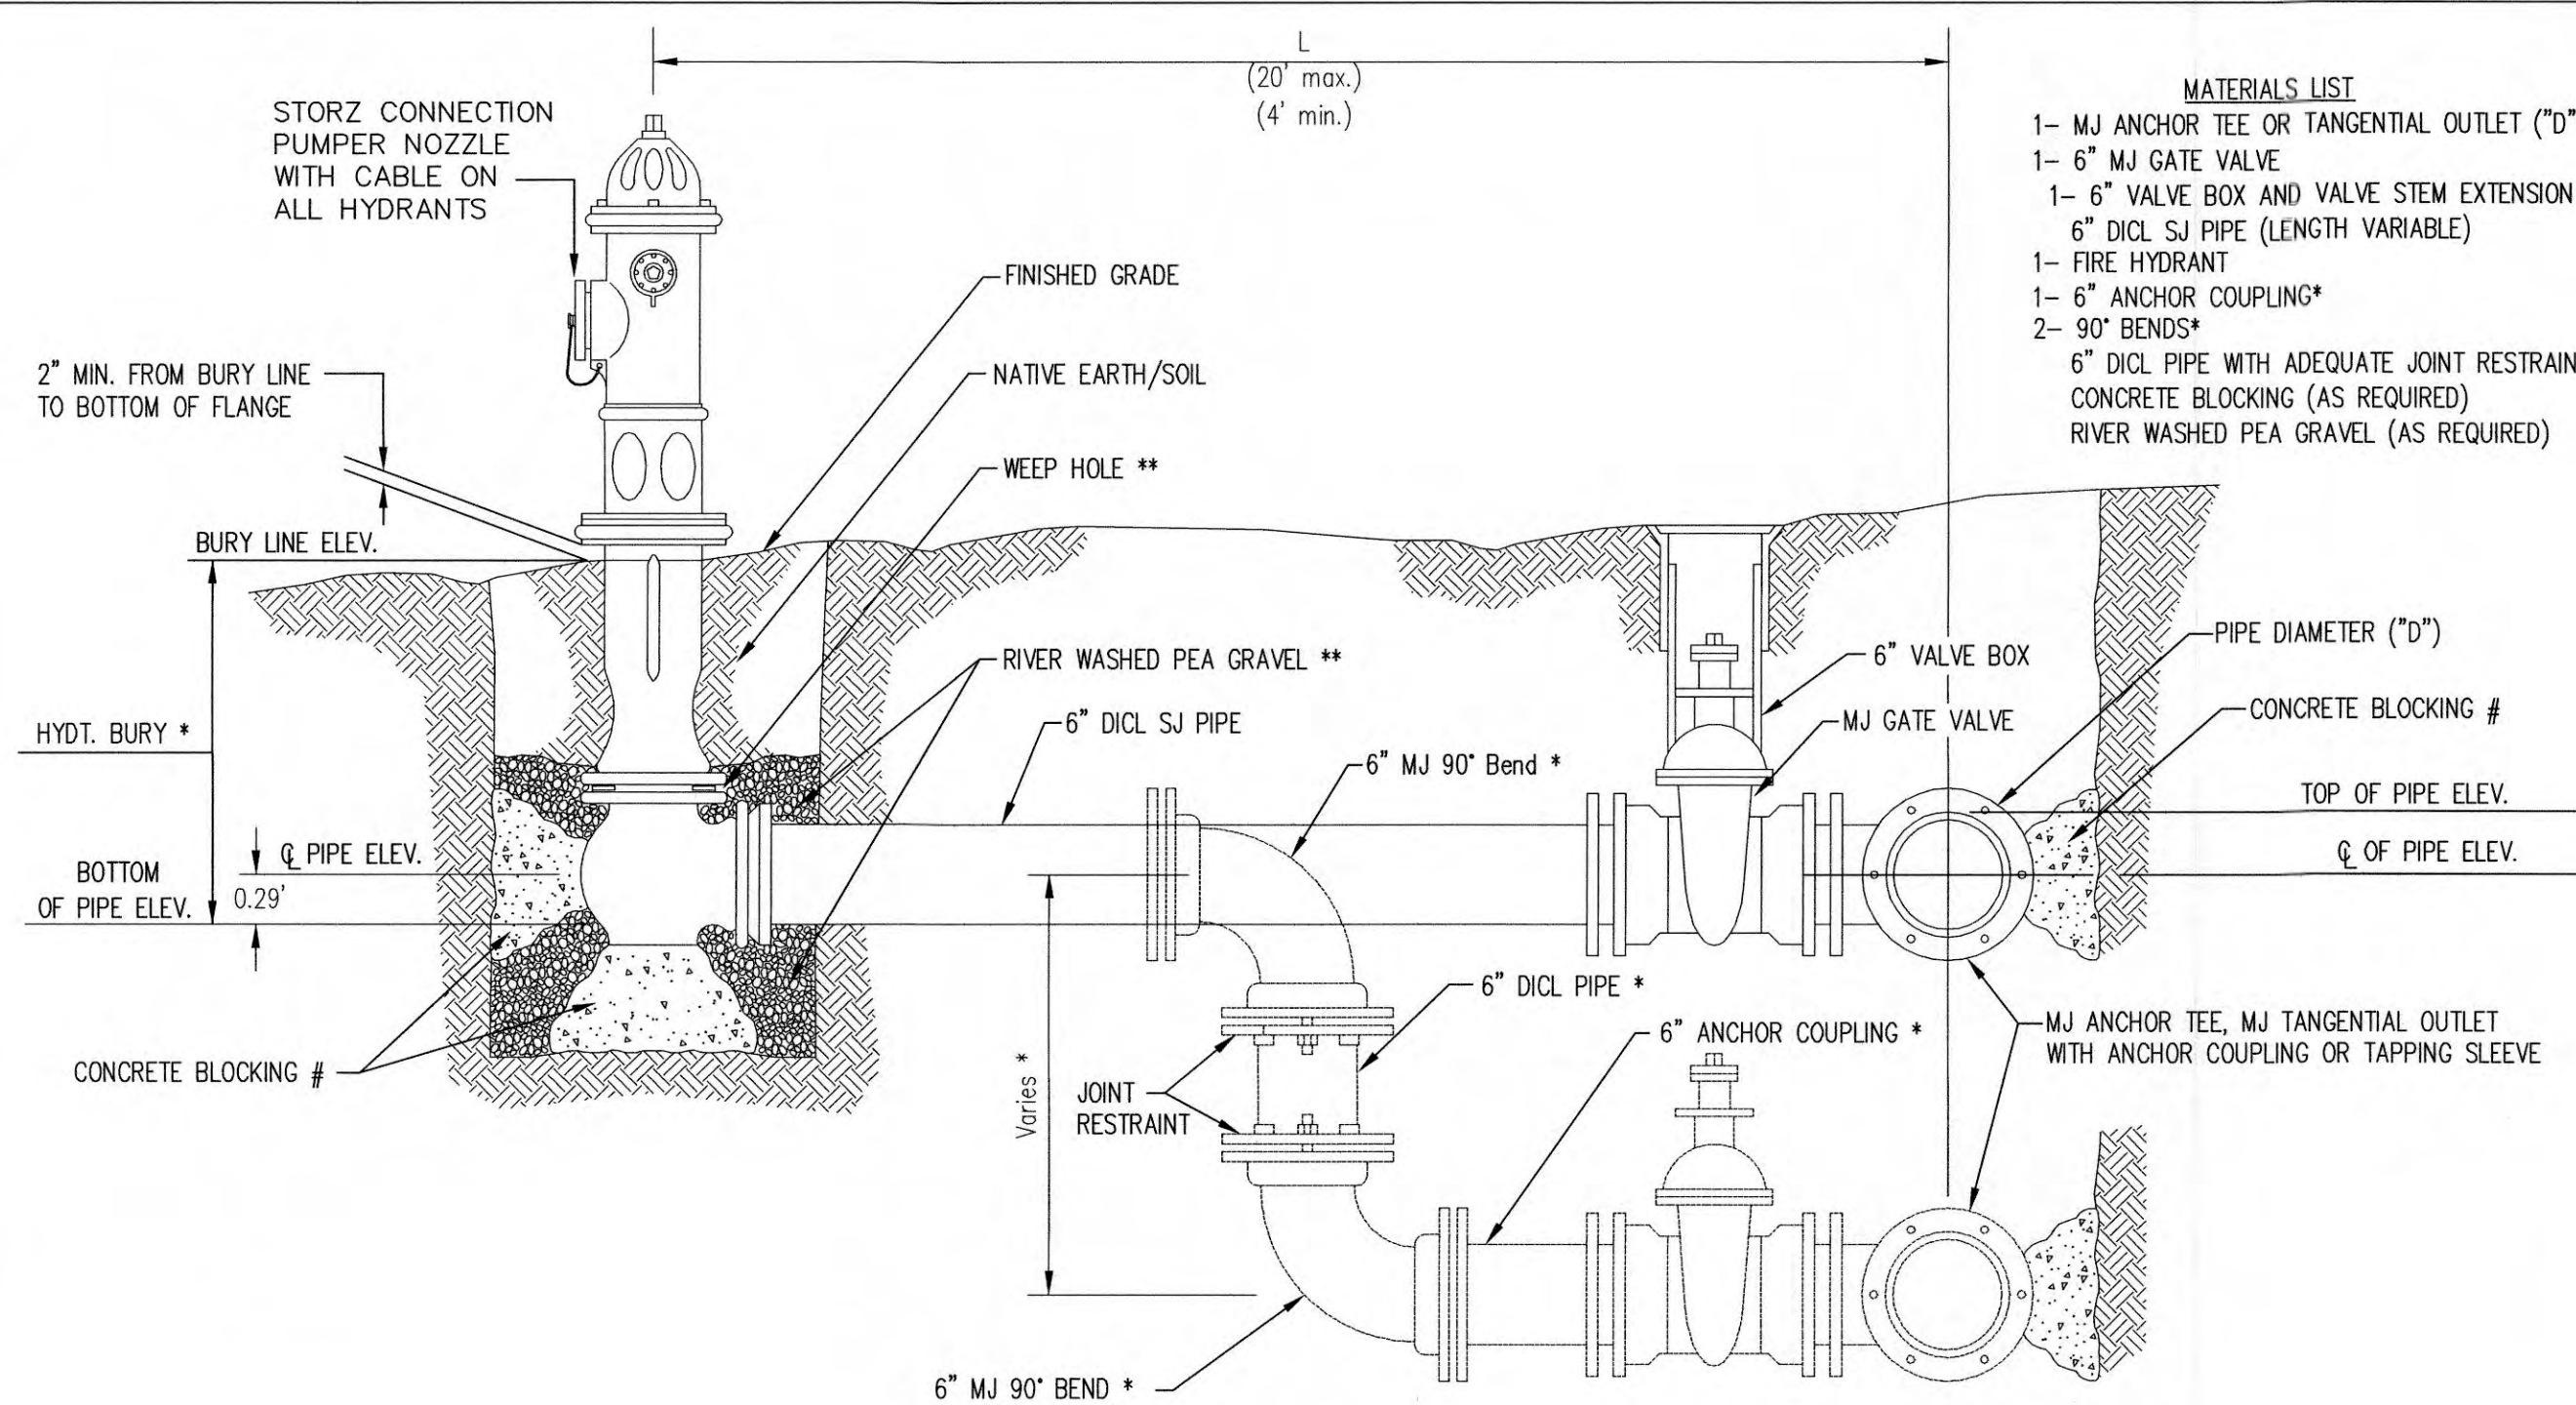


- MATERIALS LIST**
- 1- MJ ANCHOR TEE OR TANGENTIAL OUTLET ("D"x 6")
  - 1- 6" MJ GATE VALVE
  - 1- 6" VALVE BOX AND VALVE STEM EXTENSION IF REQUIRED \*
  - 6" DI CL SJ PIPE (LENGTH VARIABLE)
  - 1- FIRE HYDRANT
  - 1- 6" ANCHOR COUPLING\*
  - 2- 90° BENDS\*
  - 6" DI CL PIPE WITH ADEQUATE JOINT RESTRAINT \*
  - CONCRETE BLOCKING (AS REQUIRED)
  - RIVER WASHED PEA GRAVEL (AS REQUIRED)

\* IF THE REQUIRED HYDRANT BURY IS IN EXCESS OF 5', BUT LESS THAN 7', CONTRACTOR SHALL USE STANDARD 5' HYDRANT BURY AND HYDRANT BARREL EXTENSIONS AS NECESSARY. IF THE REQUIRED HYDRANT BURY IS GREATER THAN 7', CONTRACTOR SHALL USE 5' HYDRANT BURY, 2-MJ 90° BENDS, 6" ANCHOR COUPLING AND 6" DI CL PIPE AS NECESSARY FOR VERTICAL ADJUSTMENT. THE CONTRACTOR SHALL PROVIDE ADEQUATE THRUST BLOCKING AT HYDRANT AND MEGALUGS, OR SIMILAR RESTRAINT BETWEEN 90° BENDS TO SECURE ALL FITTINGS DURING TESTING AND OPERATION. THE CONTRACTOR SHALL PROVIDE A VALVE STEM EXTENSION PER DETAIL THIS SHEET.

\*\* CAUTION: WEEP HOLES TO BE KEPT CLEAR DURING CONSTRUCTION AND BACKFILL. CONCRETE FOR THRUST BLOCKING SHALL NOT OBSTRUCT WEEP HOLES. PLACE 1 CUBIC FOOT OF RIVER WASHED PEA GRAVEL AROUND EACH WEEP HOLE.

# CONCRETE THRUST BLOCKING SHALL BE KEPT CLEAR OF BOLTS, NUTS, AND MJ ACCESSORIES.

**FIRE HYDRANT ASSEMBLY**  
PER CITY OF WICHITA SPECIFICATIONS

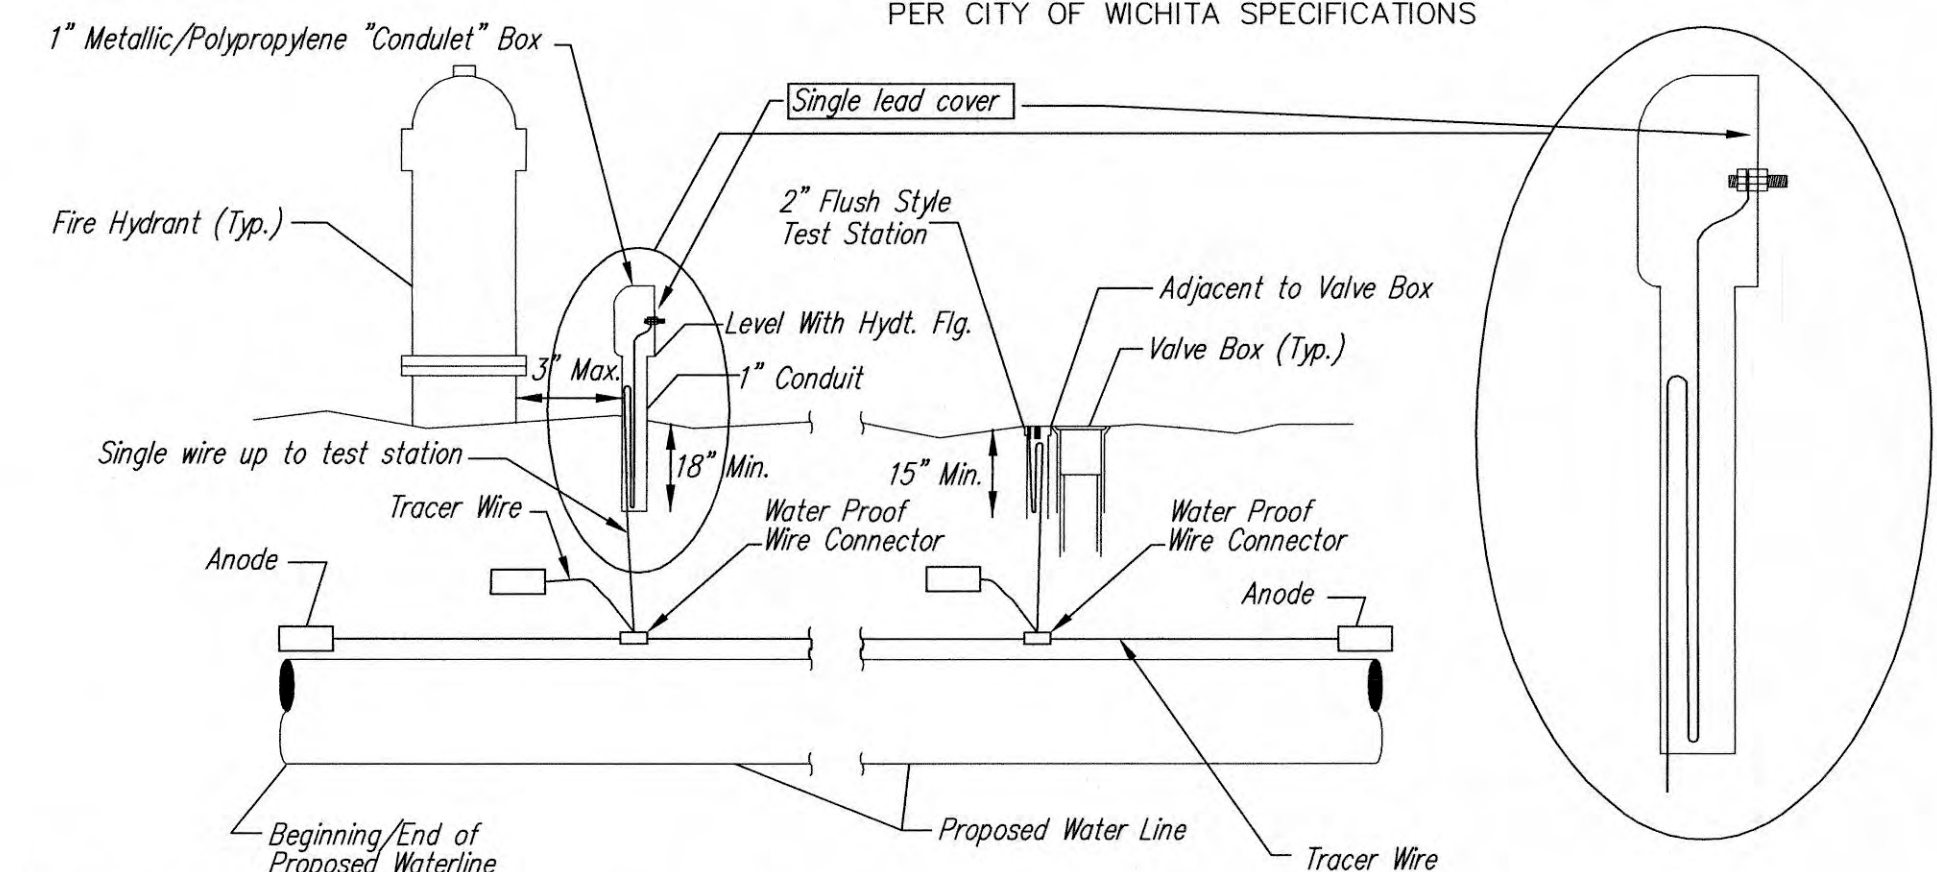

**TRACER WIRE**  
Conductive type pipe locator/tracer wire shall be installed to locate all waterline pipe regardless of pipe material. The wire shall extend the entire length of the proposed pipe. The wire shall be taped to the waterline and pulled with the pipe. A waterproof connector shall be used at splice locations. A complete list of approved tracer wire and waterproof connectors can be found on the City of Wichita's website at [www.wichita.gov](http://www.wichita.gov).


**WIRE**  
The tracer wire shall be Blue No. 12 AWG CCS with 45 mil HDPE insulation. To allow for grade adjustment, a minimum of 12" of excess wire shall be coiled at the bottom of the test station for all wires. Wire connectors shall be installed per manufacturer recommendations. Contractor shall attach wire being installed with proposed water main to any tracer wire installed with adjacent waterline projects.

**TEST STATIONS**  
The test station for fire hydrant application shall be a 1" "condulet" style station as manufactured by AGRA Industries with a removable solid cover having a single lead extending from the face or approved equal. The "conduit" style test station shall be attached to a 1" rigid galvanized conduit with a minimum length of 36" and plastic end bushing. The flush style shall have the word "WATER" stamped or molded into the lid. The test station for valve applications shall be a 2" flush style test station with wire connector on lid. Model # T2PH/B1LP Handley Industries or CD14\*TP SnakePit as manufactured by Copperhead Industries or approved equal. The flush style shall have the word "WATER" stamped or molded into the lid. All test stations shall be manufactured using molded blue tops or sufficiently coated with blue enamel paint. The tracer wire and the anode wire shall be installed to allow 12" of wire within the test station. The location of all test stations shall be recorded, and shown in the as-built drawings. Flush style test stations shall not be installed in pavement or sidewalk unless approved by the Engineer. Contractor shall extend tracer wire & move flush mount test station to nearest location out of pavement or sidewalk.

**ANODES**  
The anodes shall be 3 lb. bare zinc or magnesium. The anodes shall be buried at the same elevation as the waterline at each test station. The anodes shall be connected to 12 AWG CCS which shall be extended to the test station.

**TRACER WIRE DETAIL**  
COST IS SUBSIDIARY TO PIPE INSTALLATION


FIRE HYDRANTS REQUIRED				
STATION	BURY LINE ELEVATION	TOP OF PIPE ELEVATION	FIRE HYDRANT BURY REQUIRED*	VALVE STEM EXT. REQUIRED (ft)*
2+32.65	1306.00	1299.65	6.35'	N/A

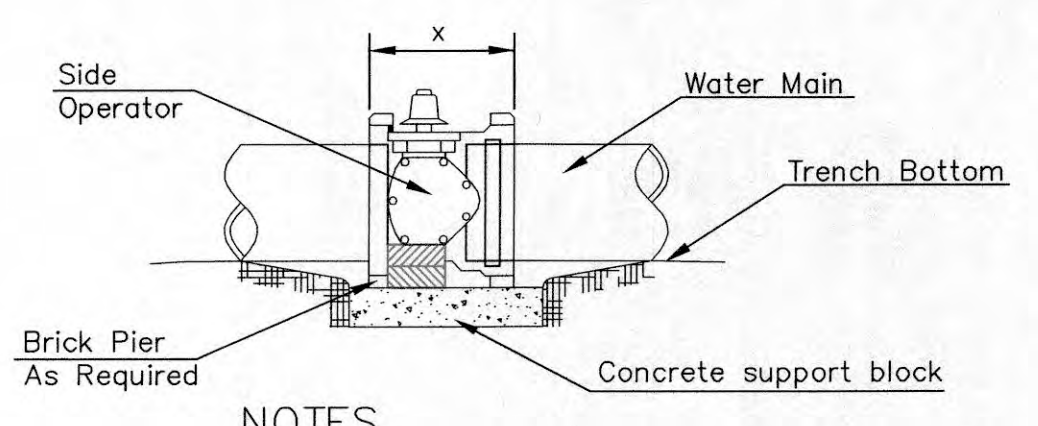


**NOTES**

- This detail covers Butterfly Valve installation, inclusive, regardless of type of pipe or joint used. 24" and larger lines to be detailed on plans.
- 6" Valve Box and Cover required per City of Wichita Std. Specifications.
- Conc. Support Block to be full width of trench.


**CONCRETE SUPPORT BLOCKING FOR BUTTERFLY VALVE INSTALLATION**

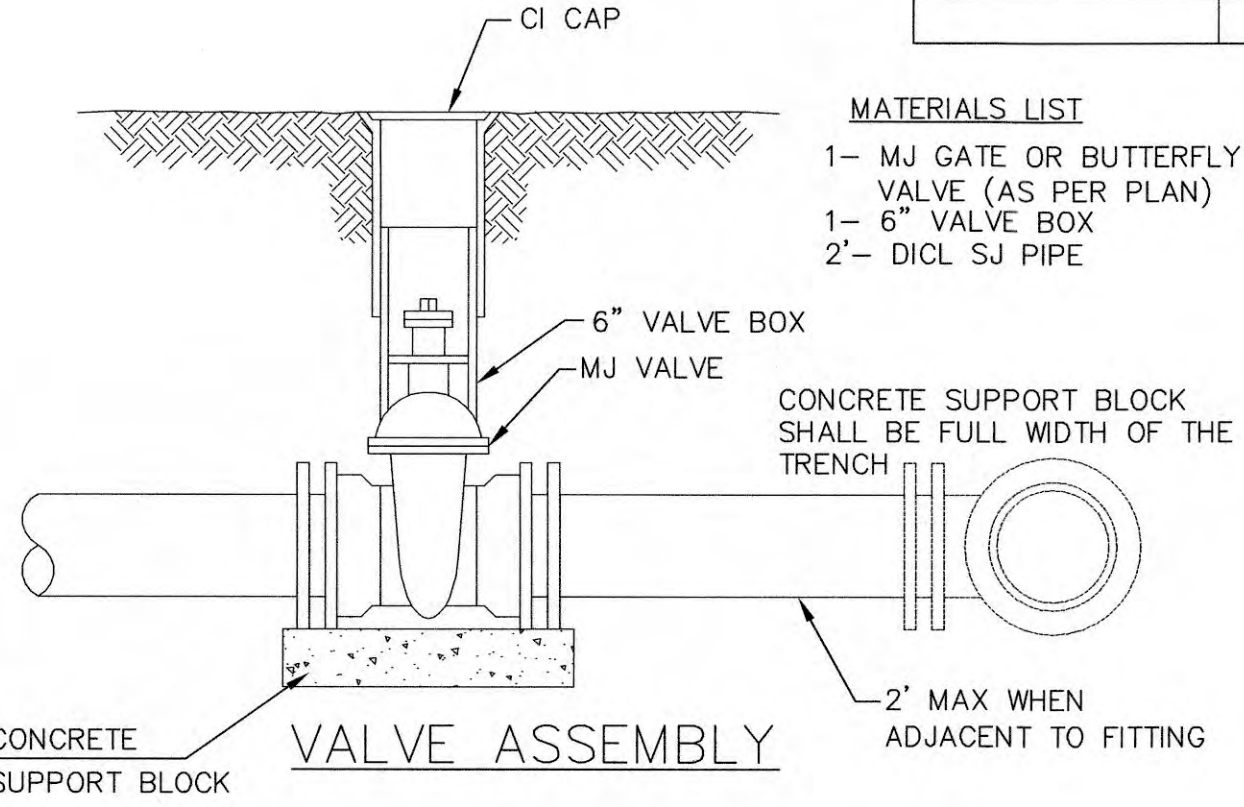

- MATERIALS LIST**
- 1- MJ GATE OR BUTTERFLY VALVE (AS PER PLAN)
  - 1- MJ ANCHOR COUPLING (12" OR SMALLER)
  - 1- 6" VALVE BOX
  - CONCRETE SUPPORT BLOCK SHALL BE FULL WIDTH OF THE TRENCH

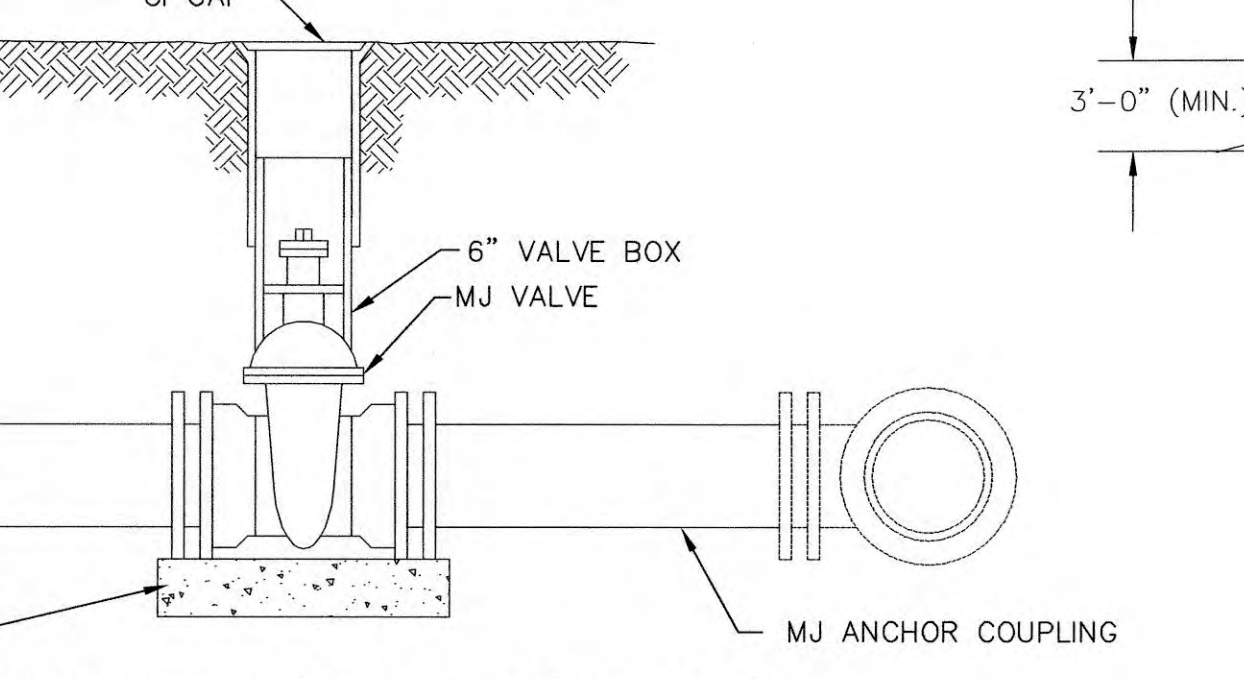


**ANCHORED VALVE ASSEMBLY**

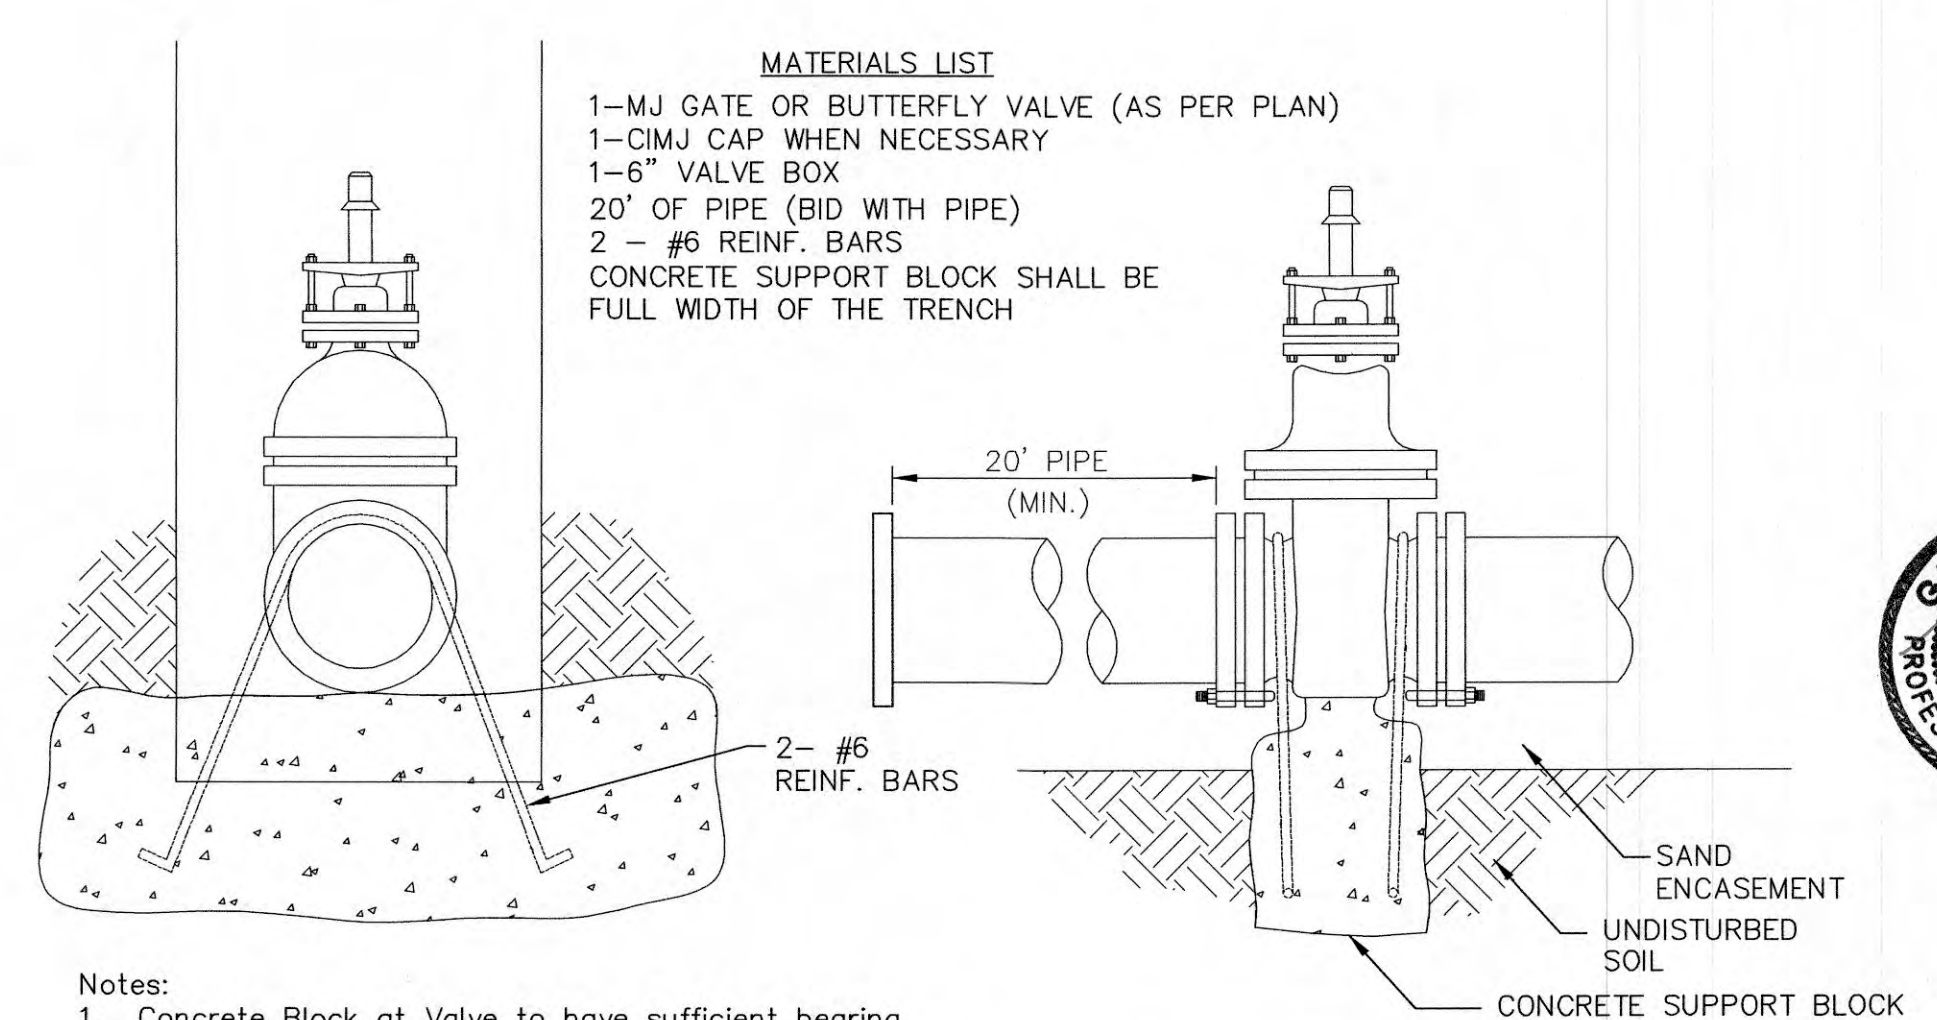


- Notes:**
- Concrete Block at Valve to have sufficient bearing in undisturbed soil to prevent thrust movement as shown in table at right. Field Engineer to determine thrust loading of undisturbed soil and final size of thrust block.
  - The thrust block shall be constructed such that bolts, nuts, and other MJ accessories are kept clear of concrete.
  - All valves at dead ends and at other locations as called out on the plans shall be blocked as shown here.

THRUST AT VALVES	
VALVE	THRUST AT 150 #/sq.2
4"	1809 lbs.
6"	4245 lbs.
8"	7540 lbs.
12"	16965 lbs.

**ANCHORED VALVE ASSEMBLY, SPECIAL**

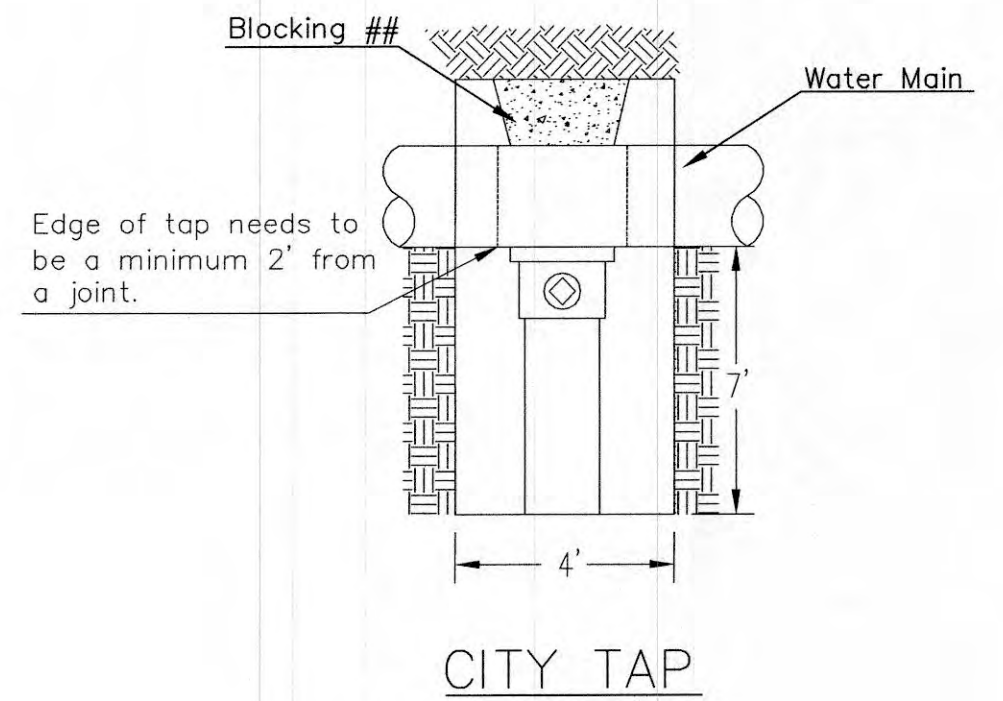


## When the City of Wichita makes tap, blocking is to be done by Contractor

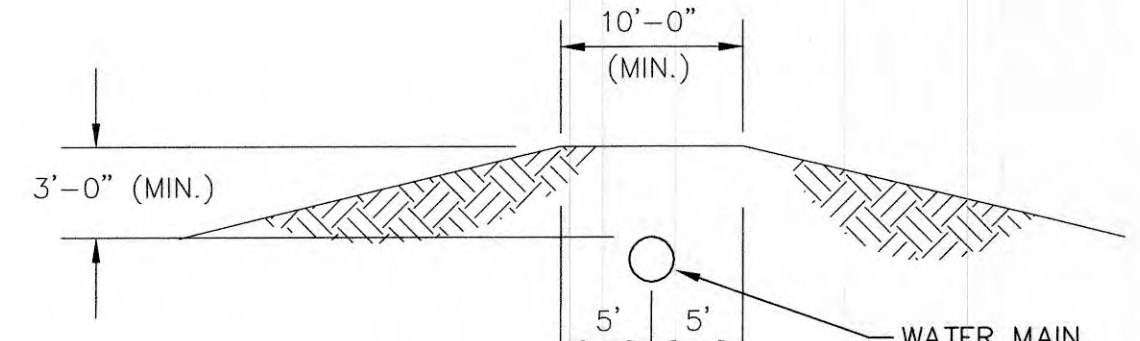


**PROTECTIVE FILL DETAIL**

MINIMUM PROTECTIVE FILL SHALL BE PROVIDED IN ALL INSTANCES WHERE COVER OVER THE PROP. WATER LINE IS LESS THAN 3'. (COST SUBSIDIARY TO PIPE INSTALLATION)

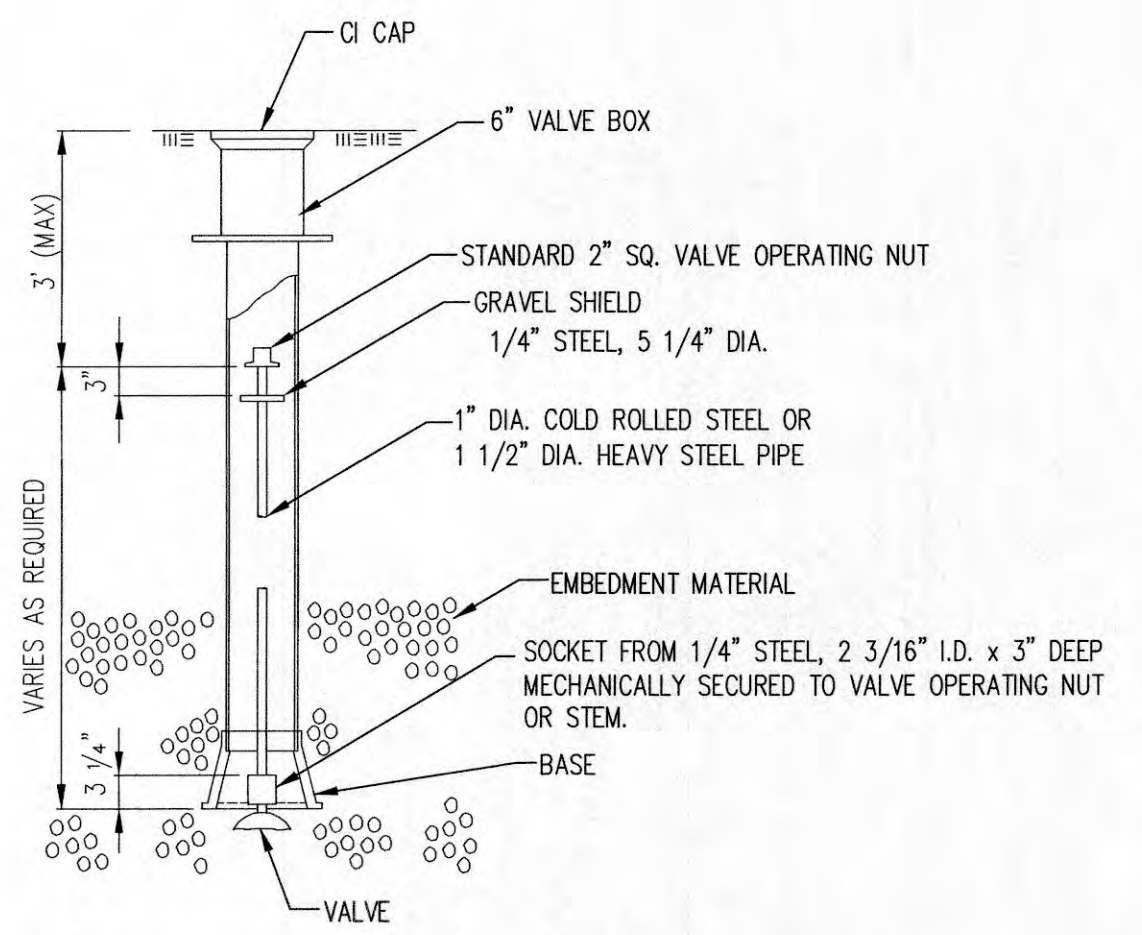

**VALVE STEM EXTENSION DETAIL**

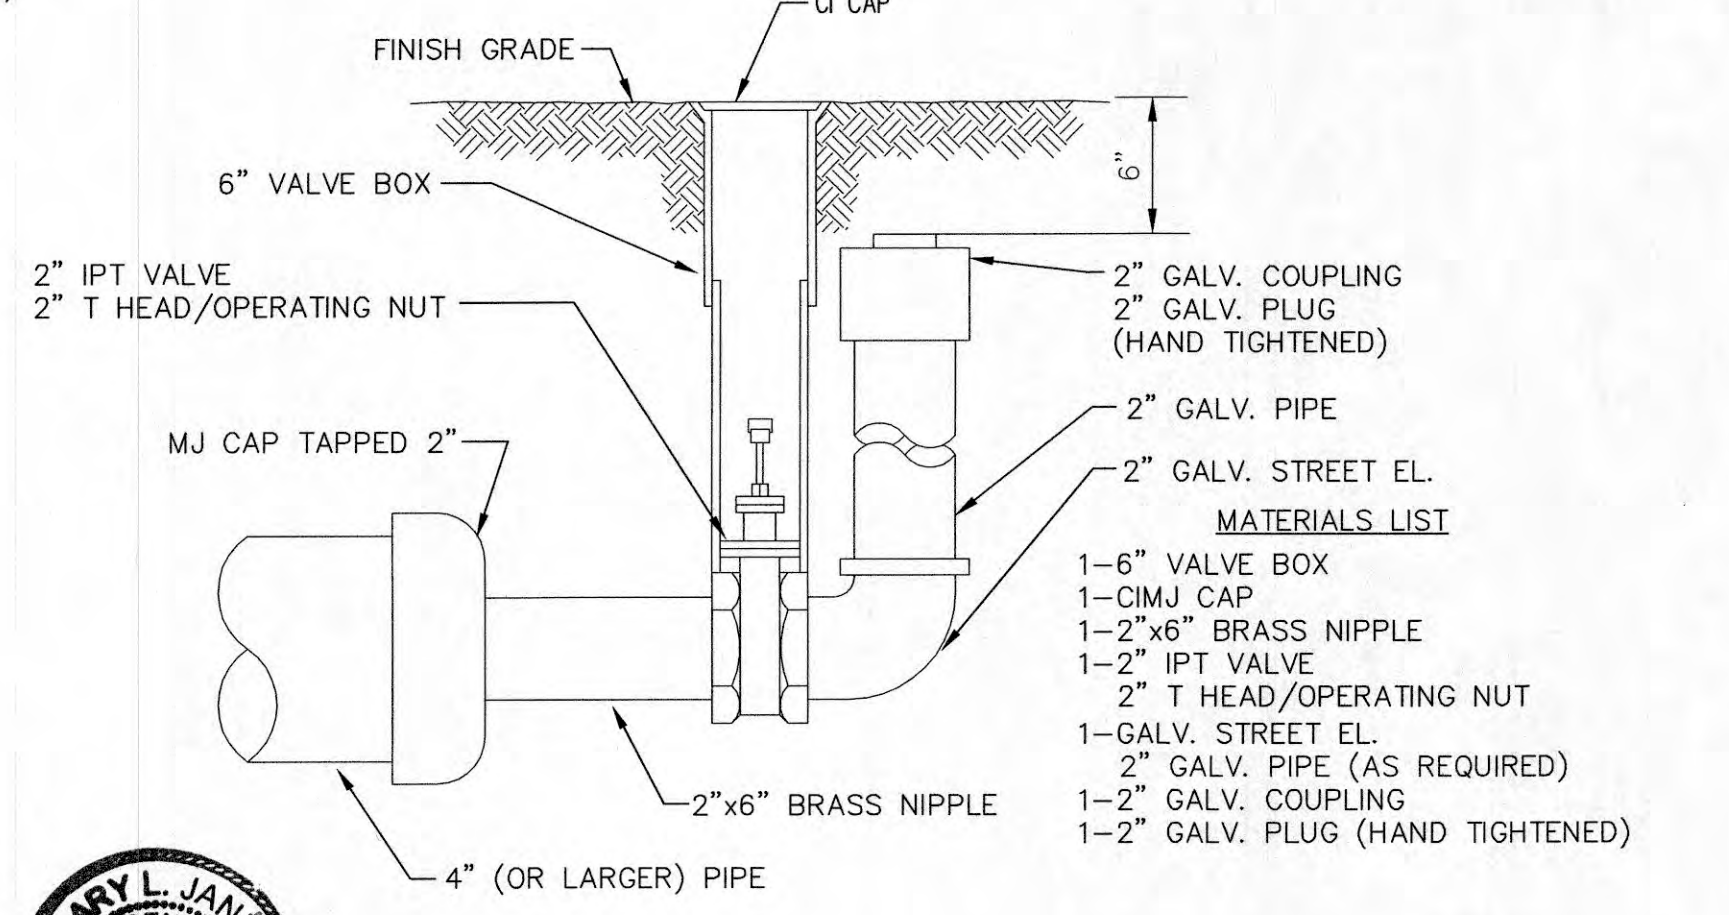

**2" BLOWOFF ASSEMBLY**

**CITY OF WICHITA**  
PUBLIC WORKS & UTILITIES ENGINEERING DIVISION

REVISED: OCTOBER 2016

**STANDARD WATER ASSEMBLY DETAIL**

CITY ENGINEER  
**GARY JANZEN, P.E.**

PROJECT NUMBER	OCA NUMBER	DATE

CITY ENGINEER'S OFFICE  
CITY HALL - SEVENTH FLOOR  
455 NORTH MAIN STREET  
WICHITA, KANSAS 67202-1620  
(316) 268-4501

SHEET  
**2.1**

# AS BUILTS




**KEMILLER**  
ENGINEERING PA  
117 E. Lewis,  
Wichita, KS 67202 (316)264-0242




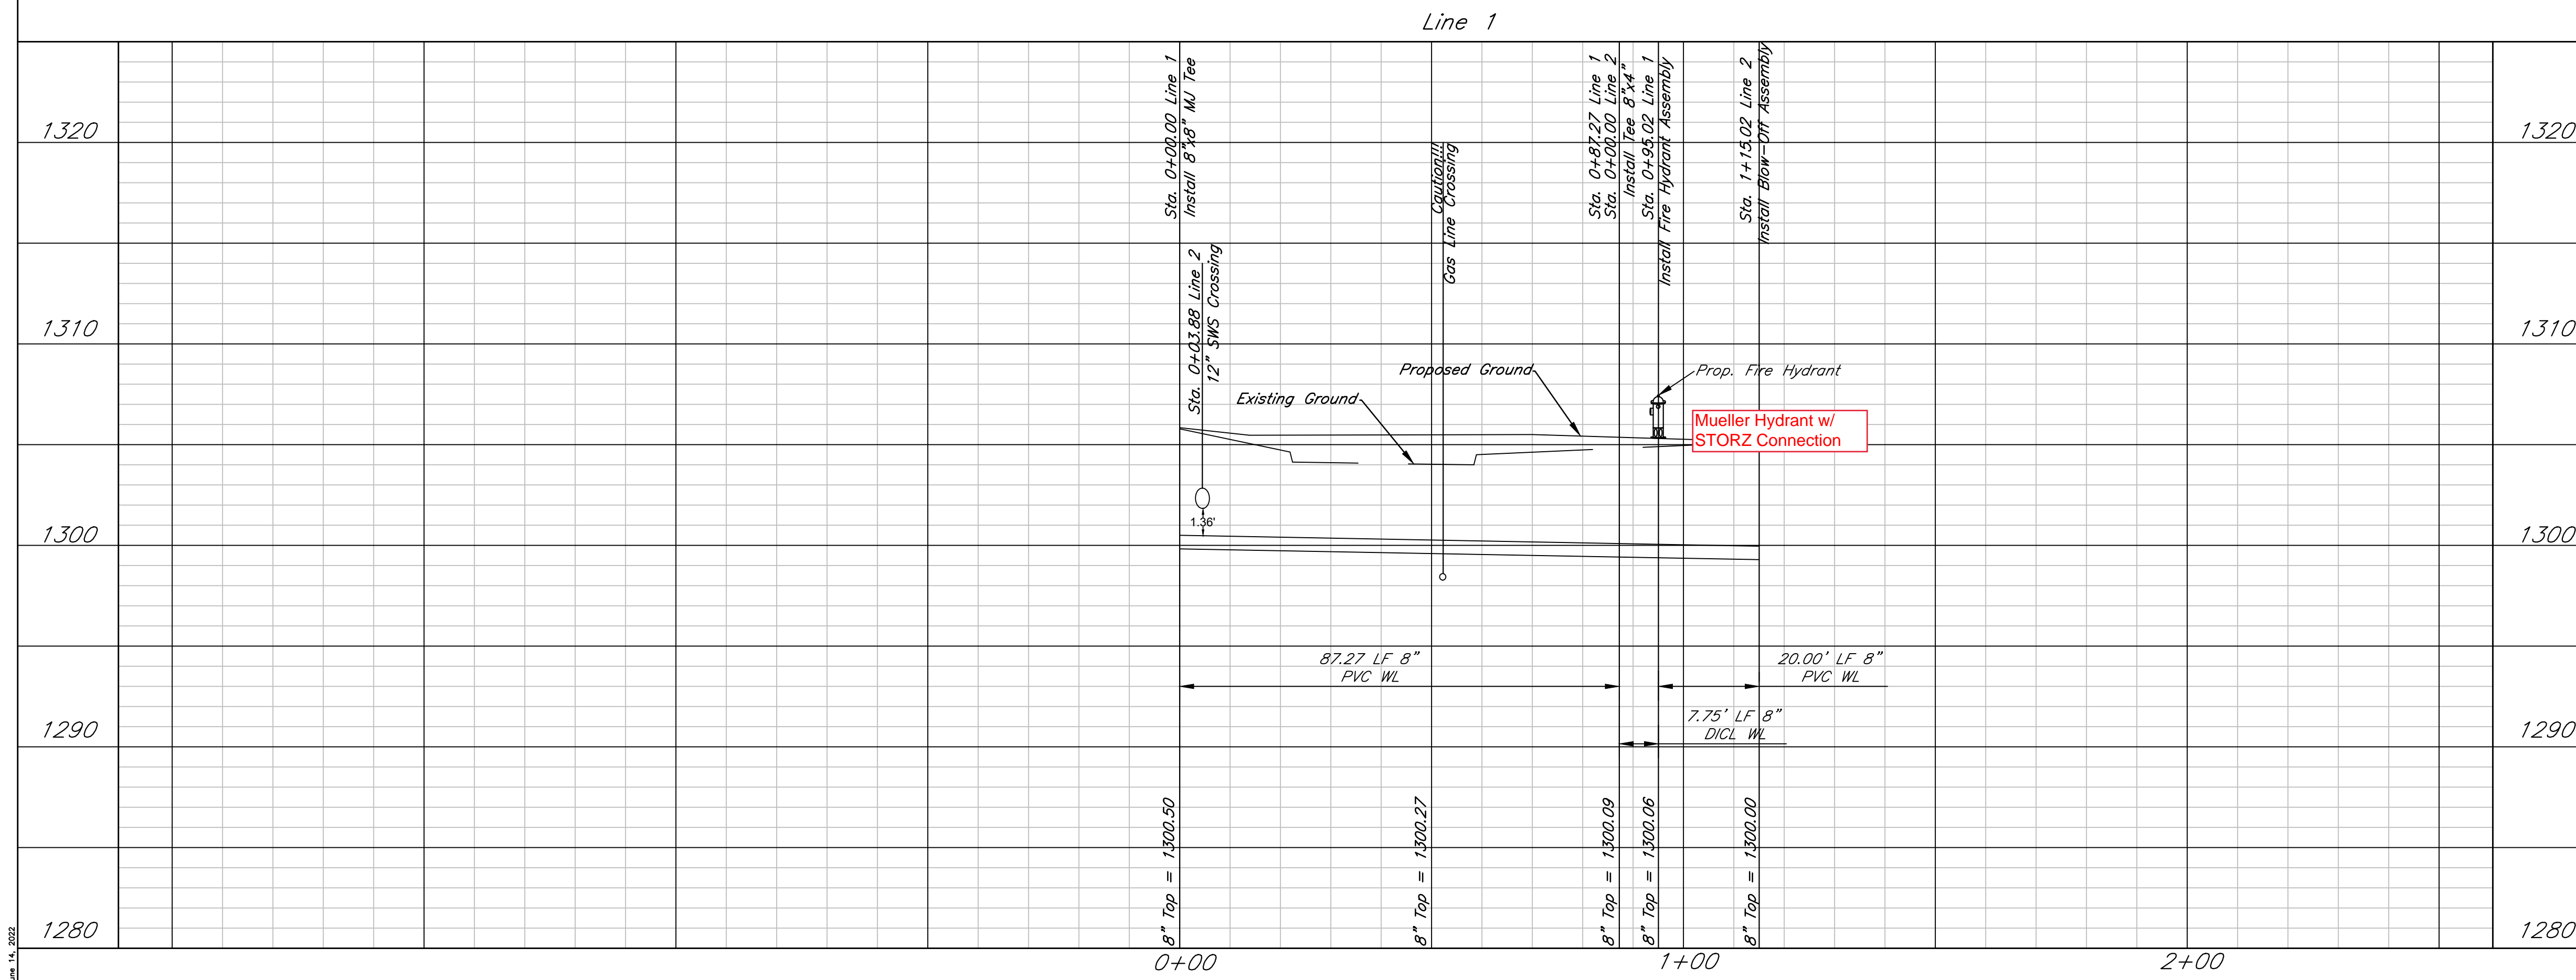
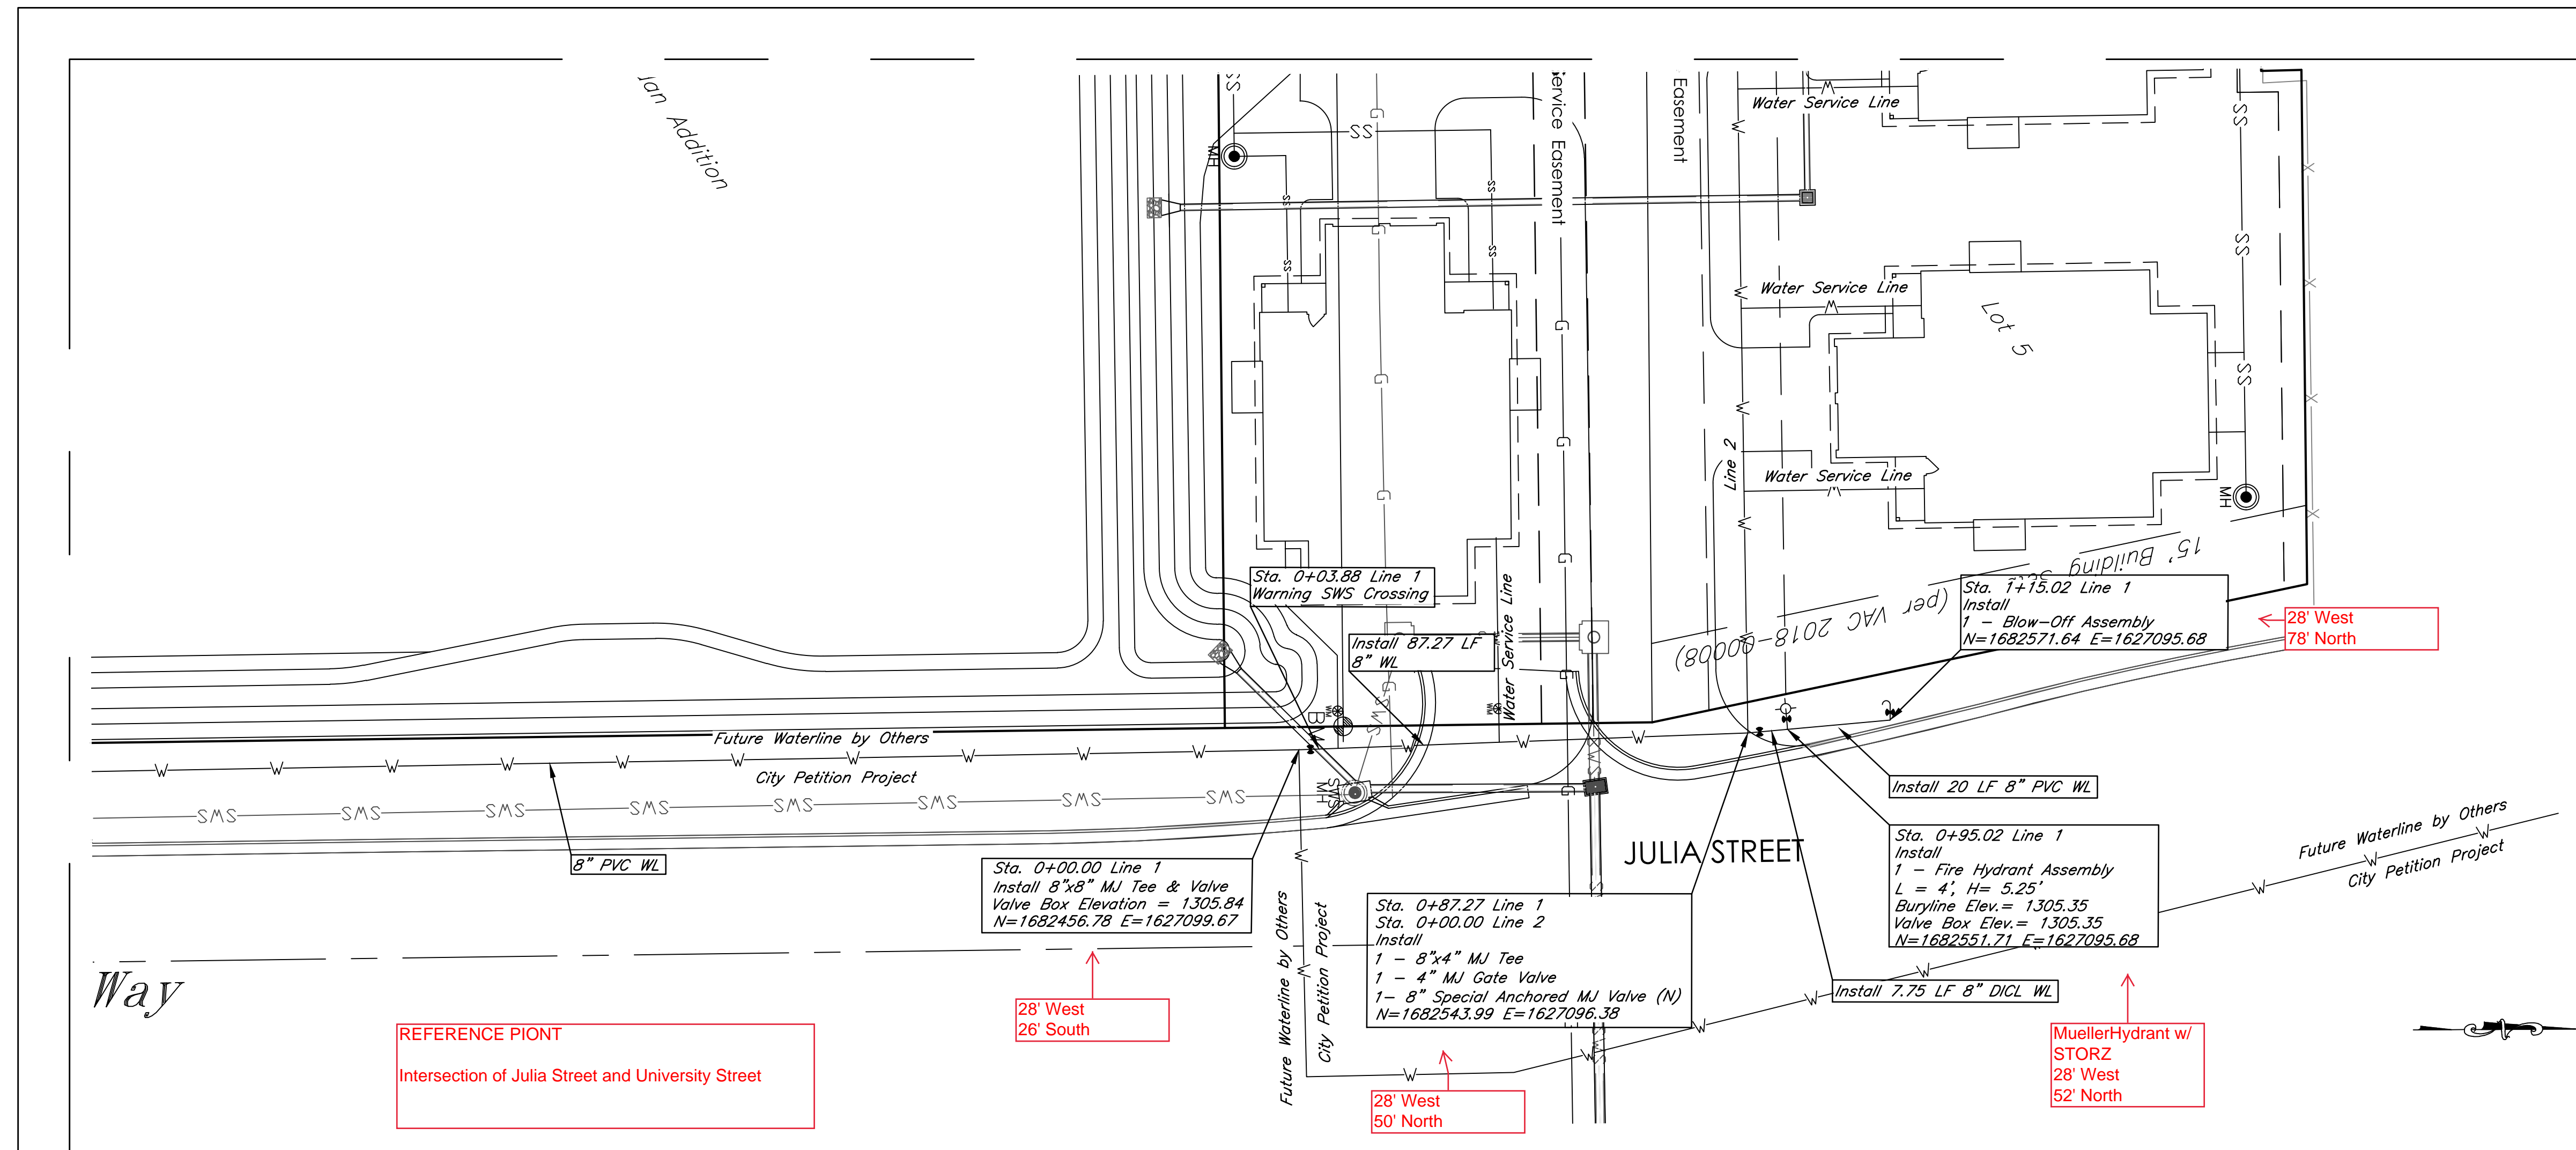
THIS SHEET HAS BEEN  
SIGNED, SEALED AND  
DATED DIGITALLY

Top of Waterline Pipe to be at  
least 42" below ground elevation  
in accordance with City of Wichita  
Requirements

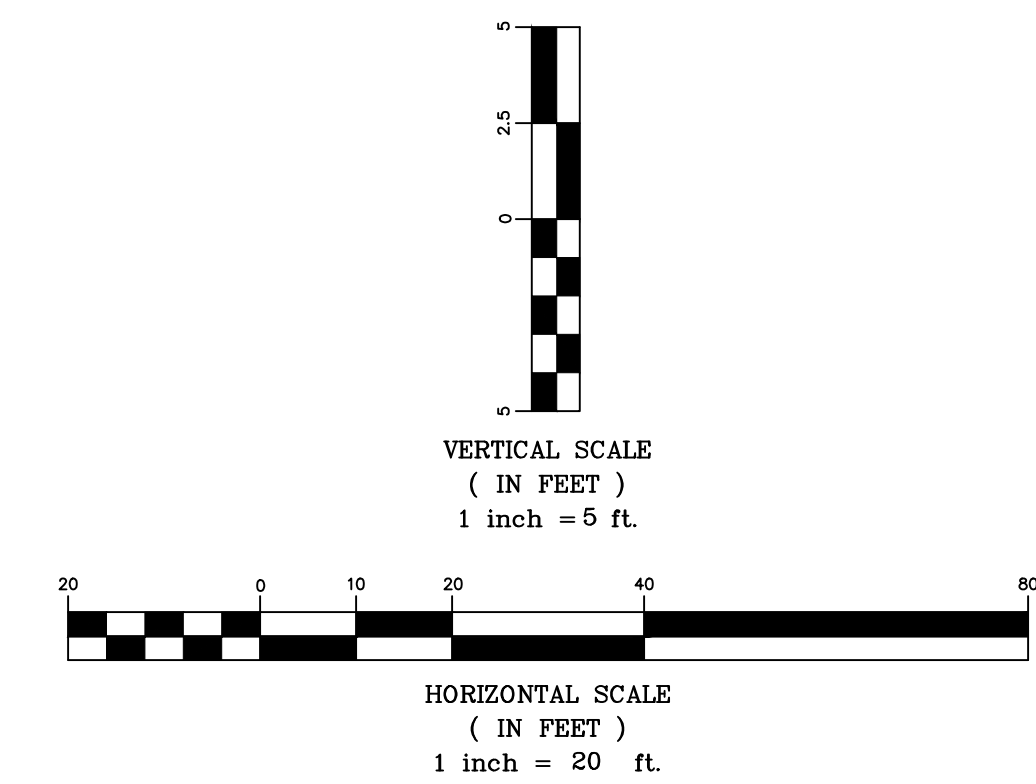

## Vintage Court Duplexes Plan & Profile Line 1 Wichita, Kansas


	PROJECT NUMBER PPW-2022-009803			SHEET <b>3.0</b>
	KEM NO. 21167	FILE	DATE 03/2022	
DESIGN KM	DRAWN KJ	REVISED 06/03/2022		



June 14, 2022

# AS BUILTS

**KEMILLER** ENGINEERING PA  
 117 E. Lewis,  
 Wichita, KS 67202 (316)264-0242

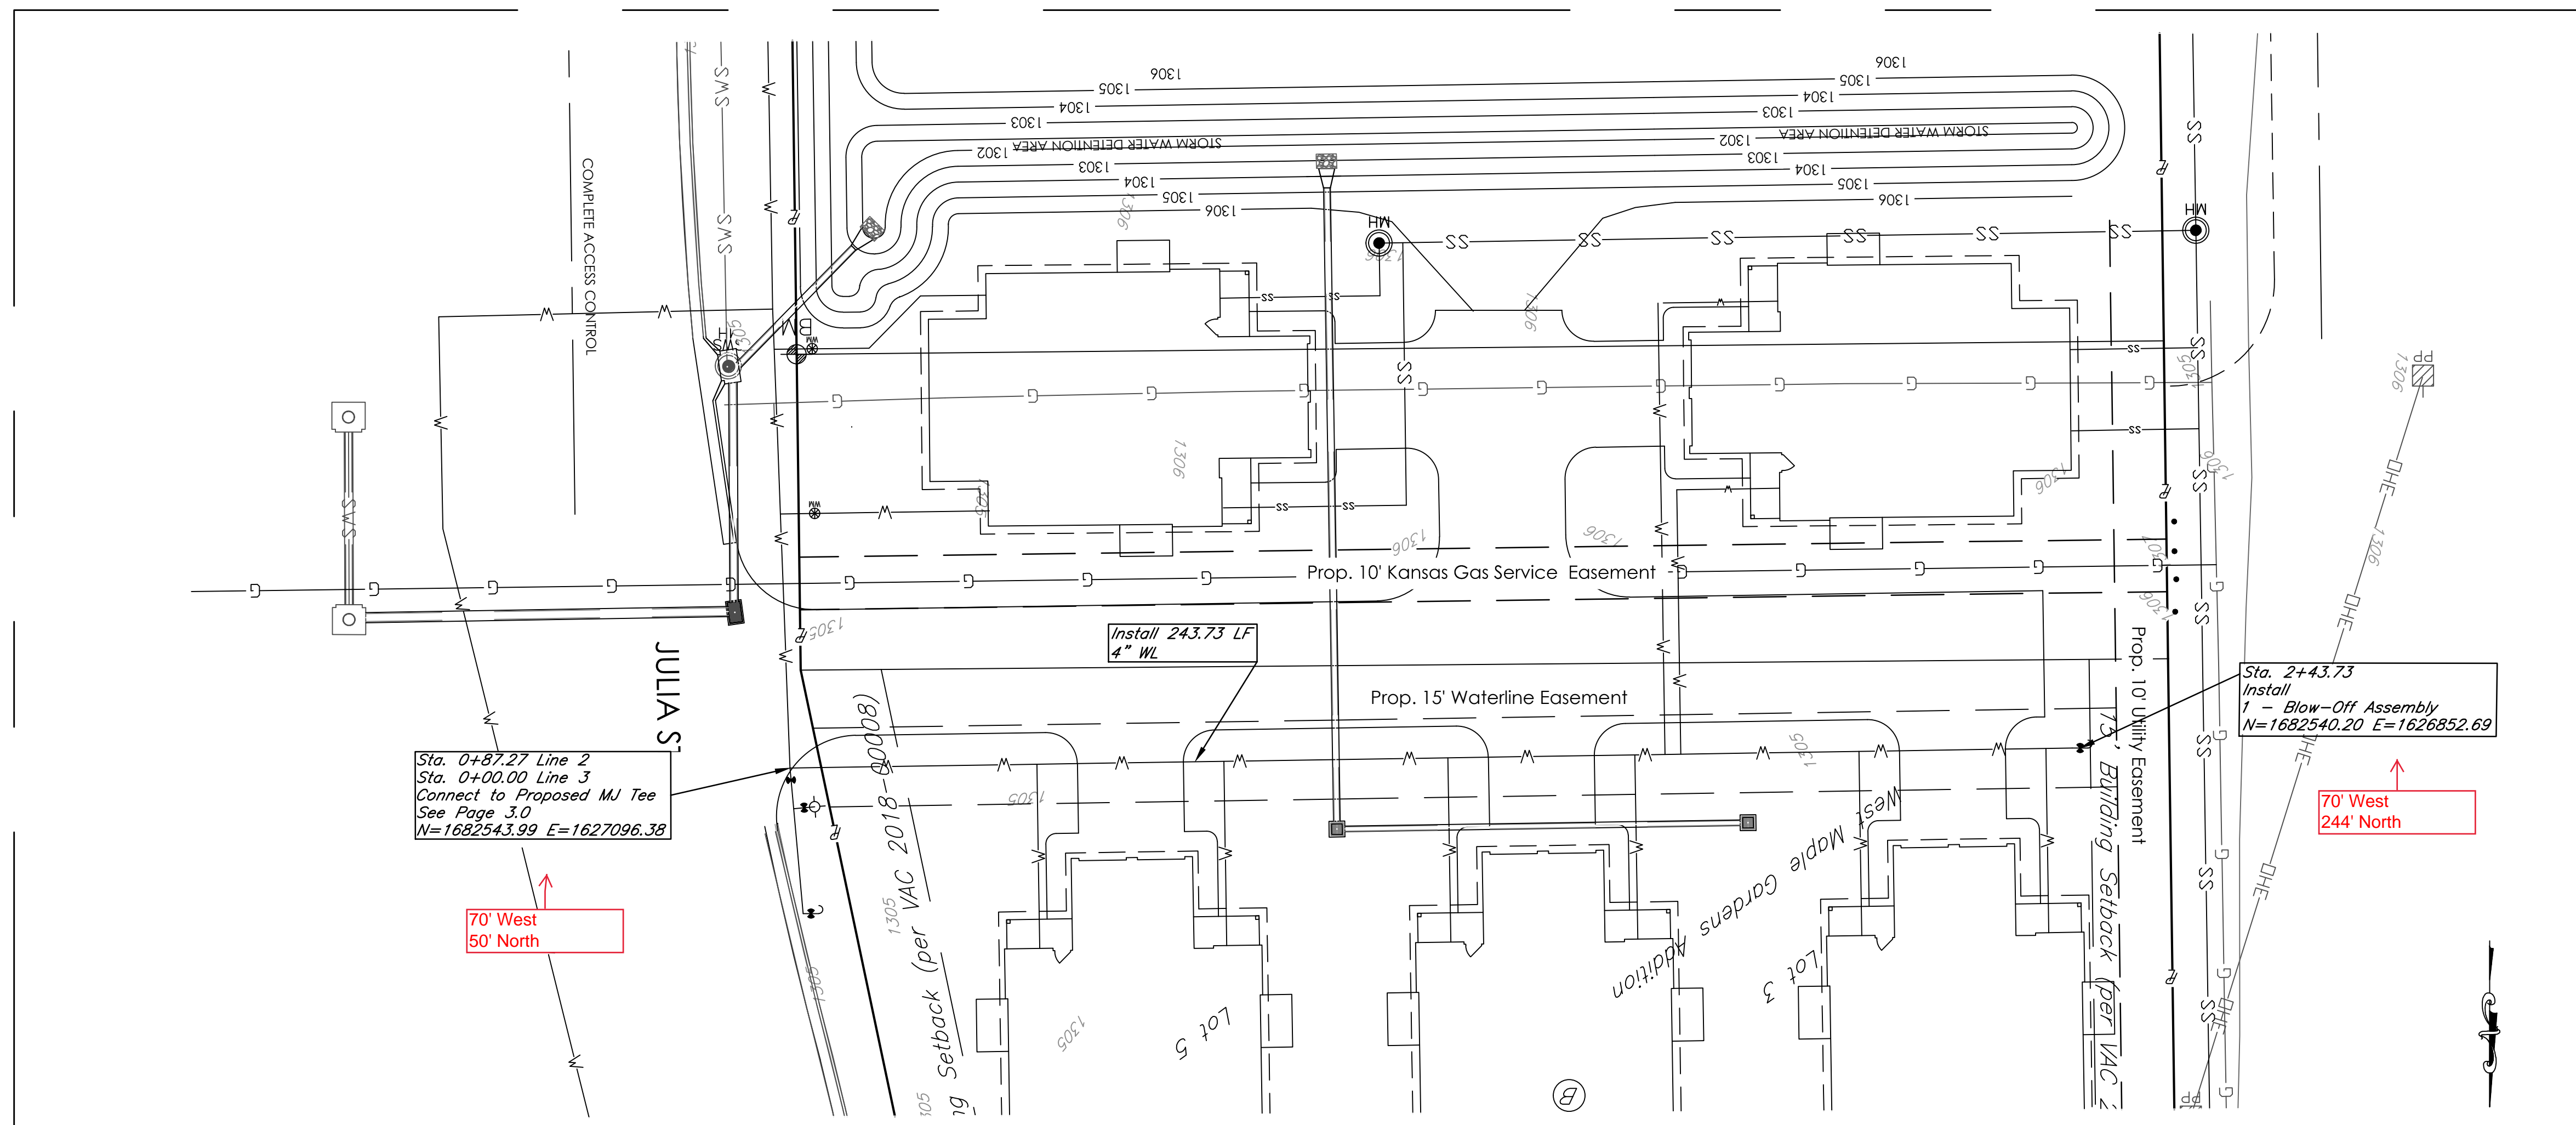


Sta. 0+87.27 Line 2  
 Sta. 0+00.00 Line 3  
 Connect to Proposed MJ Tee  
 See Page 3.0  
 N=1682543.99 E=1627096.38


Sta. 2+43.73  
 Install  
 Blow-Off Assembly  
 N=1682540.20 E=1626852.69

70' West  
 244' North

Line 2

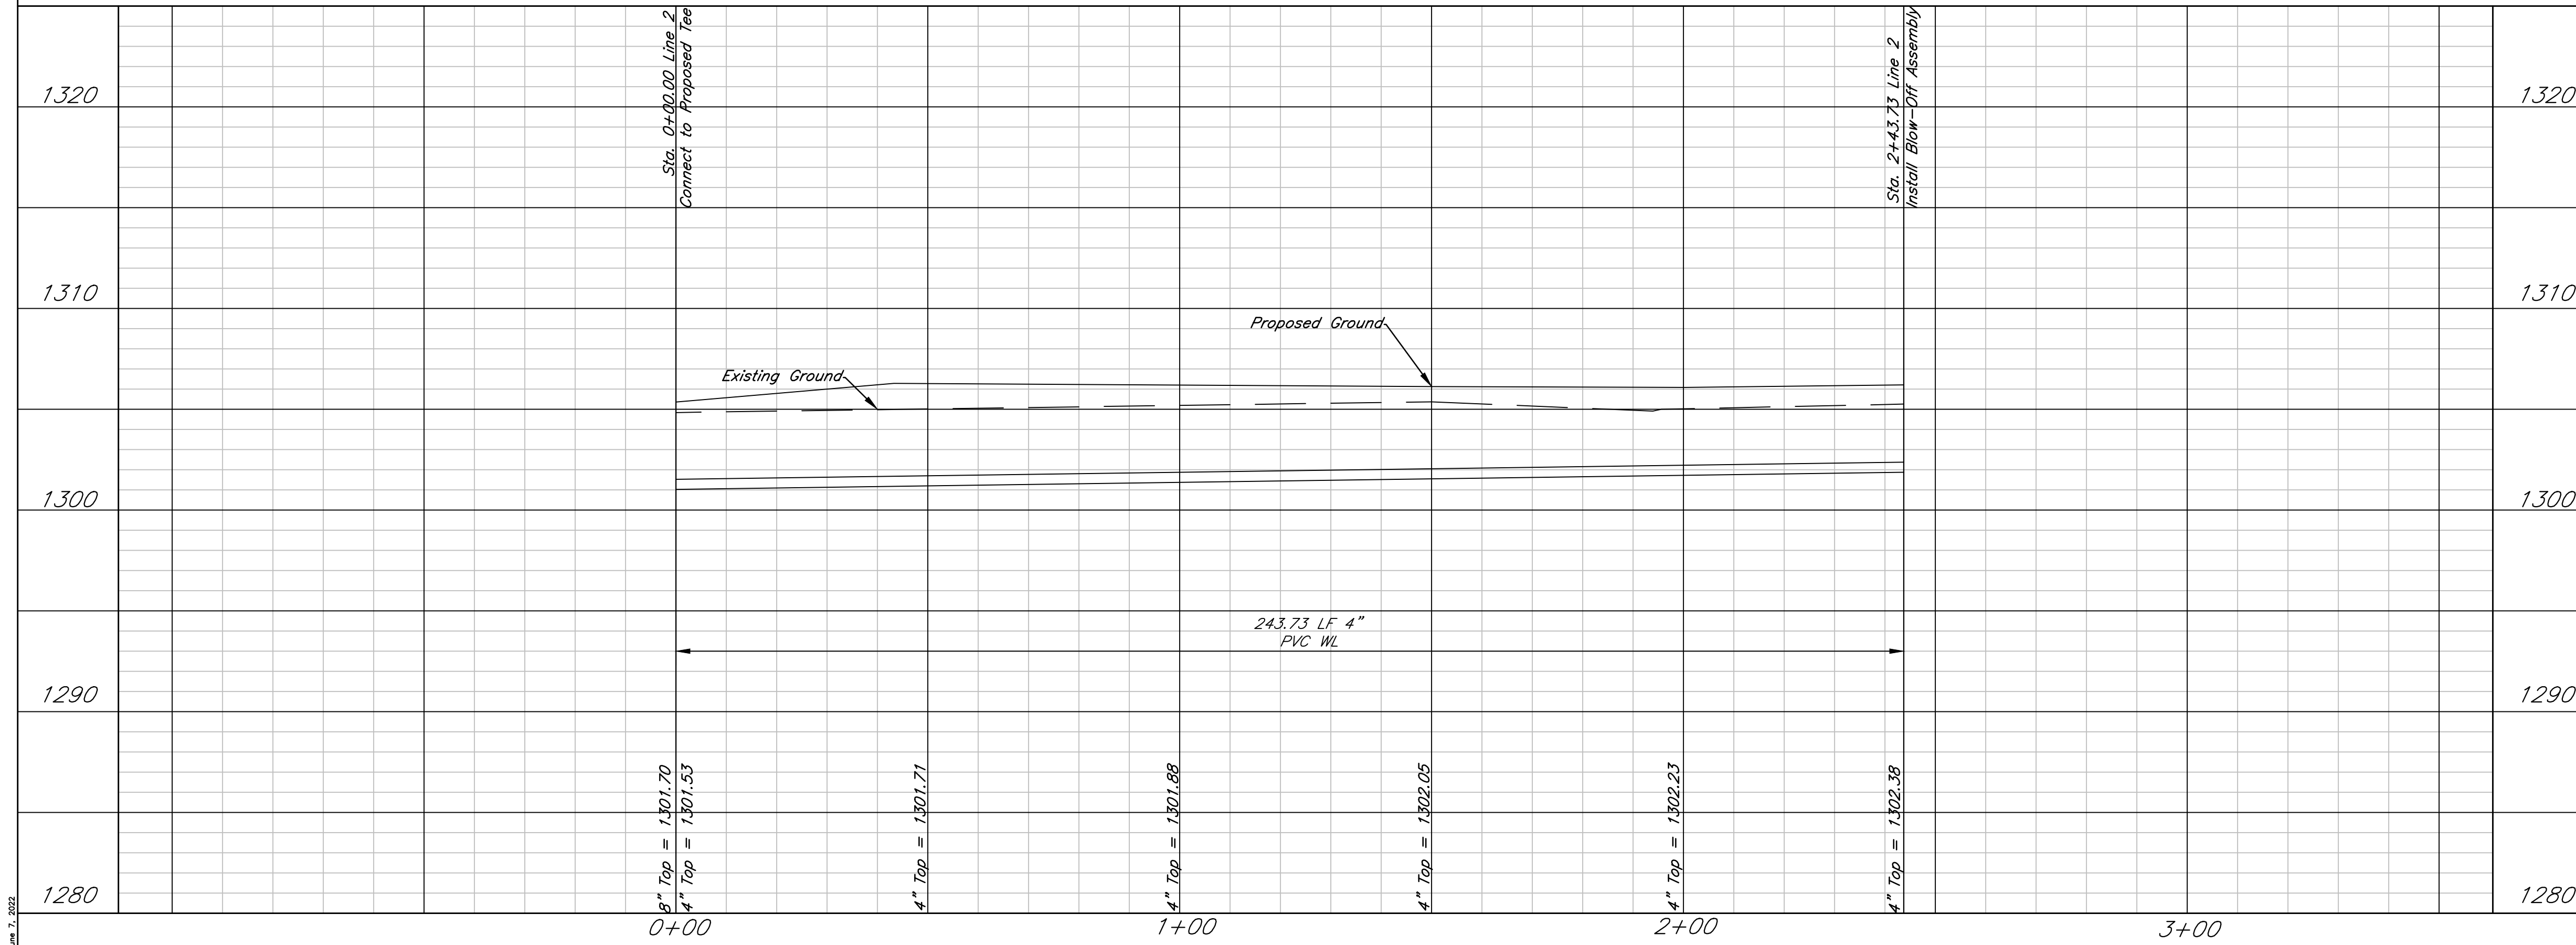

THIS SHEET HAS BEEN  
 SIGNED, SEALED AND  
 DATED DIGITALLY.

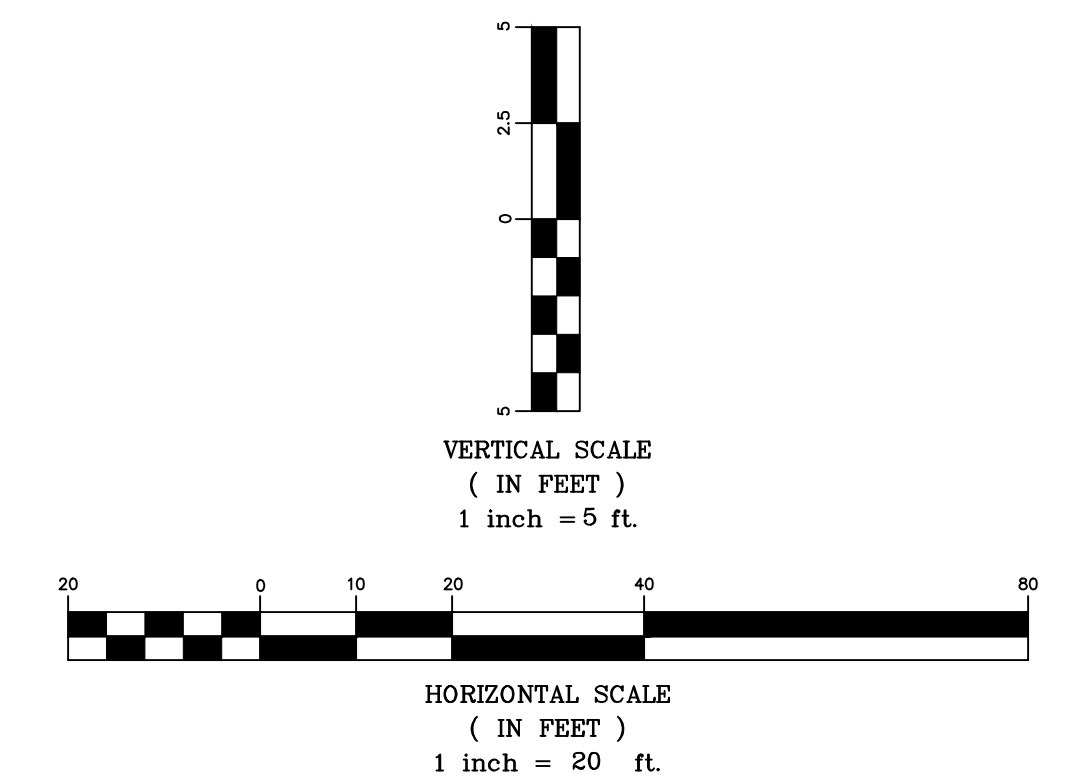


Vintage Court Duplexes  
**Plan & Profile Line 2**  
 Wichita, Kansas

	PROJECT NUMBER PPW-2022-009803			SHEET <b>3.1</b>
	KEM NO. 21167	FILE	DATE 03/2022	
DESIGN KM	DRAWN KJ	REVISED 06/03/2022		

June 3, 2022

# WEST MAPLE GARDENS

## SEDGWICK COUNTY, KANSAS

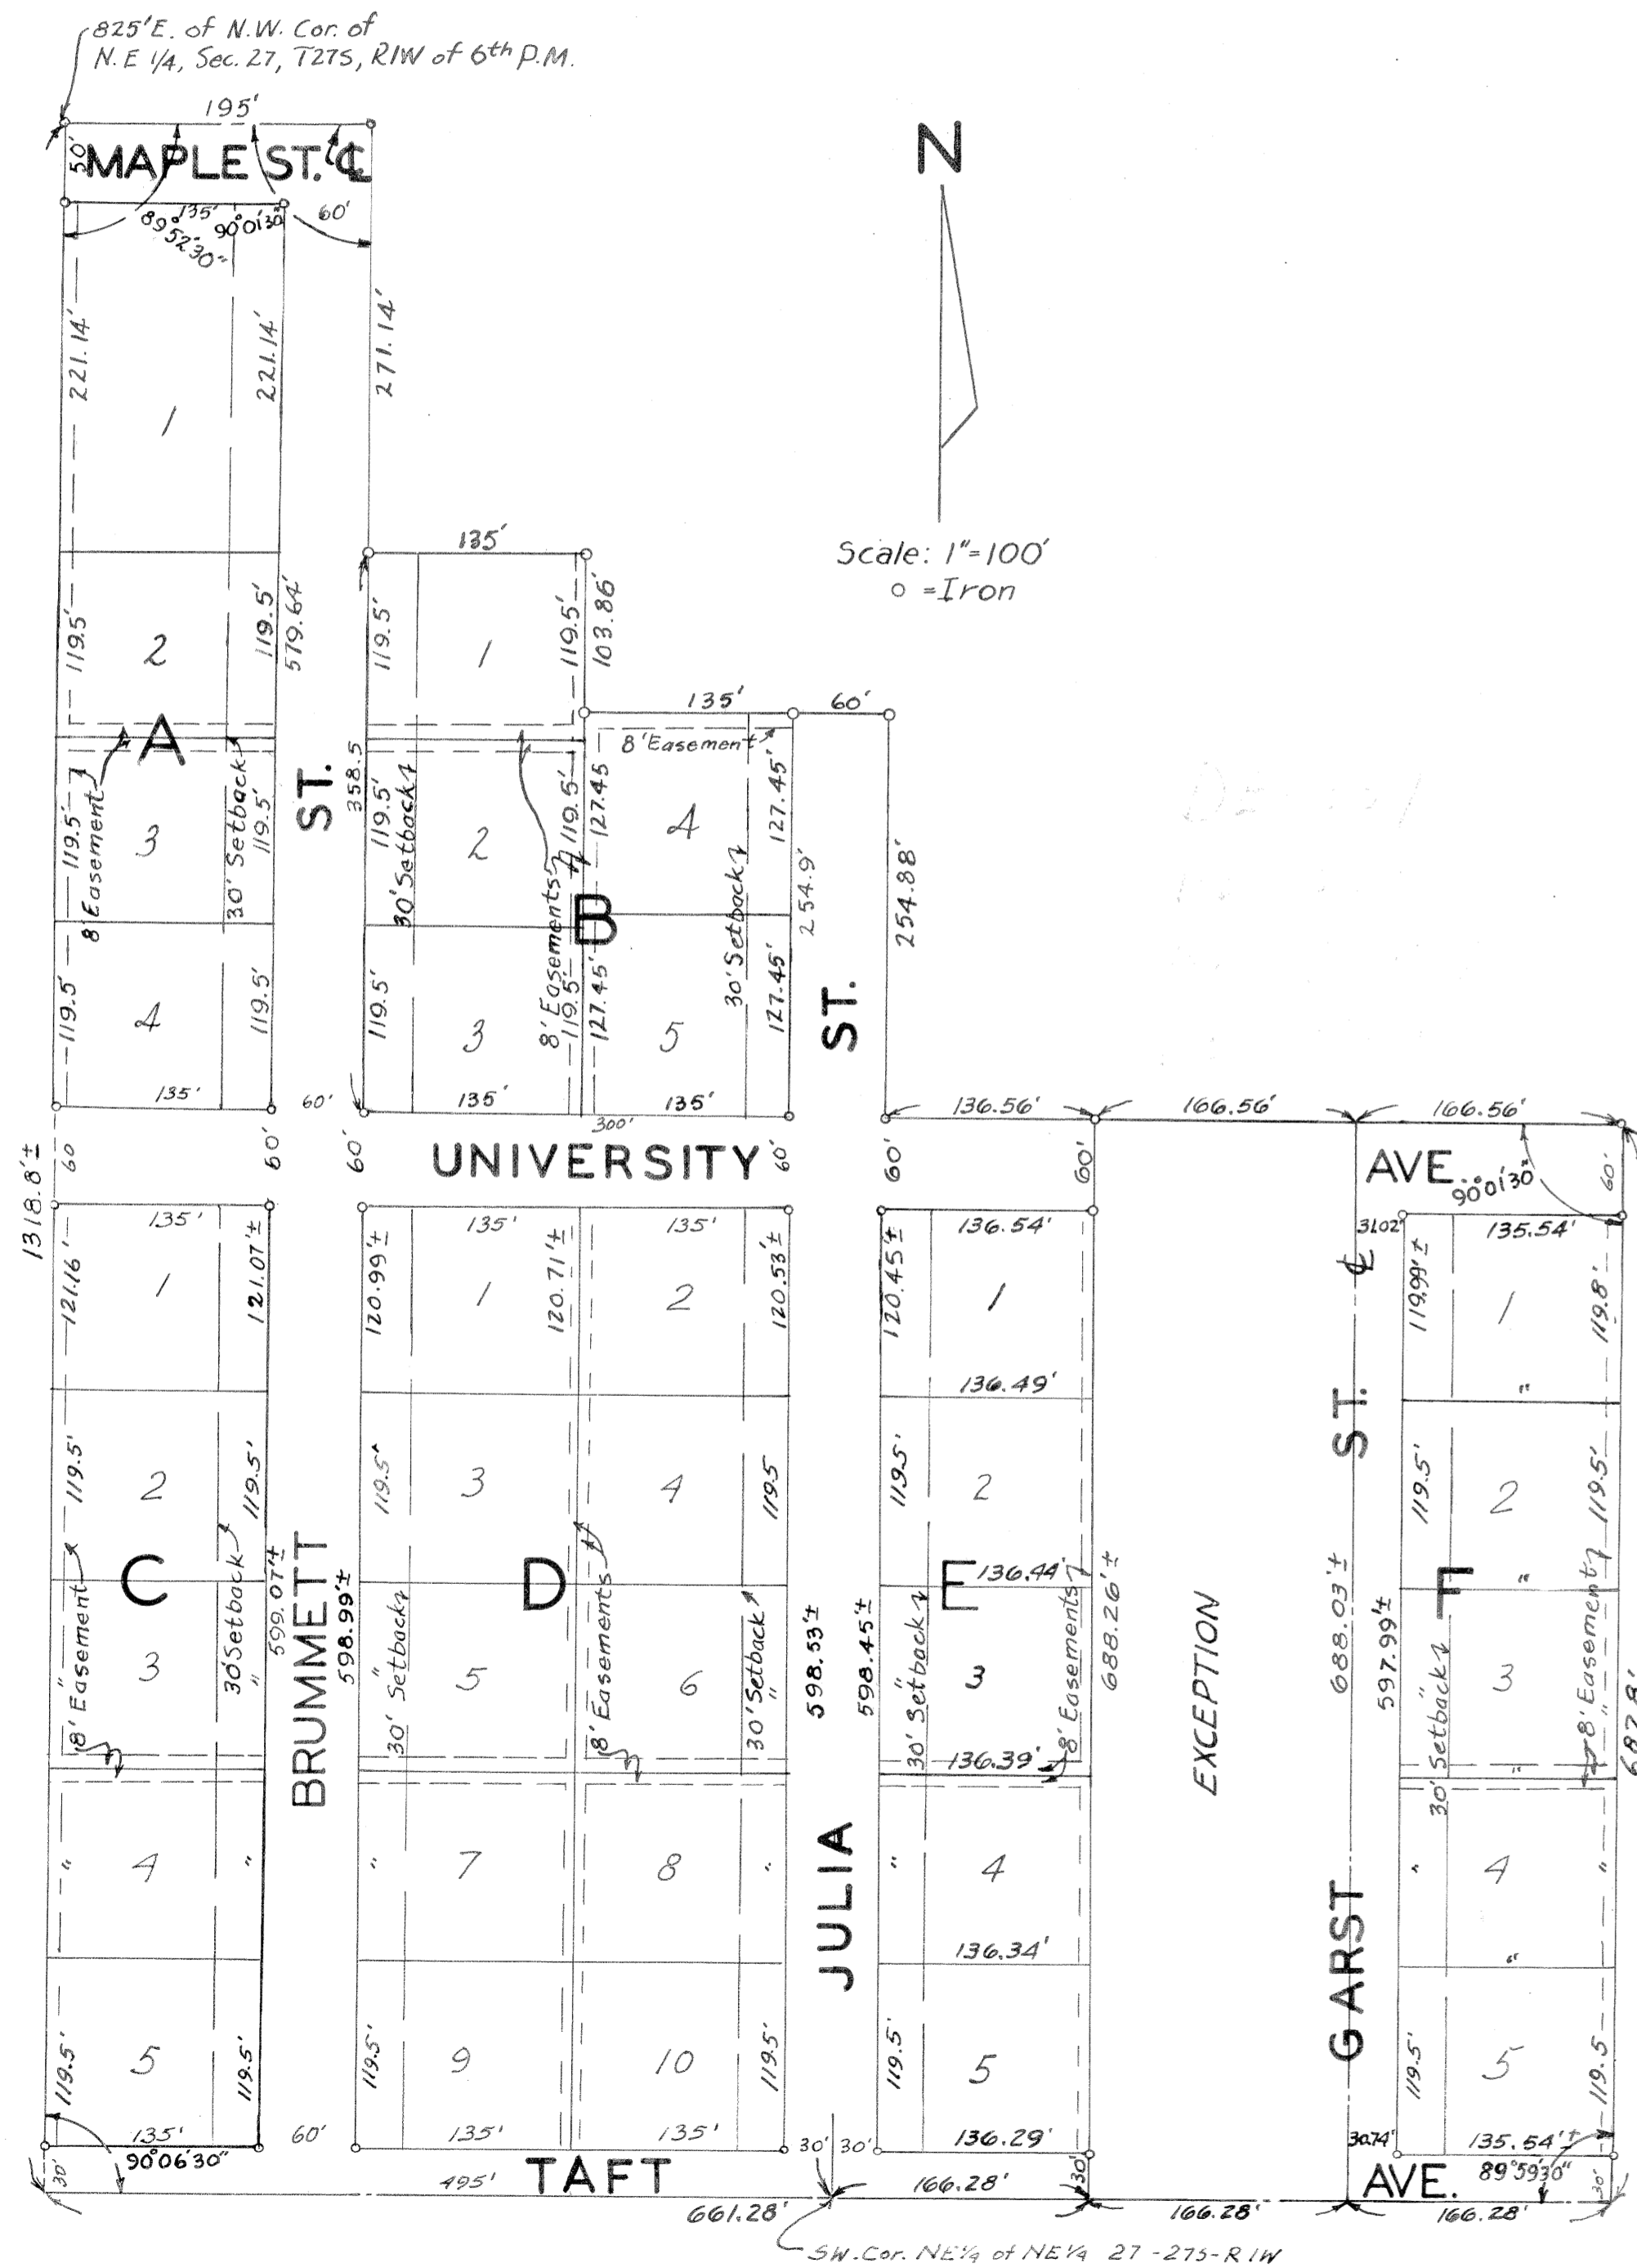

State of Kansas }  
County of Sedgwick } ss

I, Don C. Moehring, a Civil Engineer in and for said State and County, do hereby certify that I have surveyed and platted WEST MAPLE GARDENS, Sedgwick County, Kansas, into Lots, Blocks, Streets, and Avenues, the same being accurately set forth in the accompanying plat, being described as follows: The East 5 Acres of the West 30 Acres of the Northwest 1/4 of Northeast 1/4 of Section 27, Township 27 South, Range 1 West of the 6th P.M., being also described as: Beginning at a point in the North line of the Northeast Quarter of said Section 27, and 825 feet East of the Northwest Corner of the Northeast Quarter of said Section 27; thence South 131.88 feet more or less to a point in the South line of the Northwest Quarter of the Northeast Quarter of said Section 27; thence East 165 feet; thence North to a point in the North line of said Section 27; thence West 165 feet to the point of beginning, Owned by J. B. Brummett and Mabel H. Brummett, his wife; and beginning at a point in the North line of the Northeast Quarter of Section 27, Township 27 South, Range 1 West of the 6th P.M. and 990 feet East of the Northwest Corner of said Northeast Quarter, thence South to a point in the South line of the Northwest Quarter of the Northeast Quarter of said Section 27; thence East 310.1 feet; thence North 943.33 feet; thence West 50.1 feet; thence North 375 feet to a point in the North line of said Section 27; thence West 260 feet to the point of beginning, excepting the North 271.14 feet of the East 135 feet of the West 165 feet thereof, and excepting the East 95 feet of the West 260 feet of the North 375 feet thereof, being owned by Ernest A. Jordan and Doris Jordan, his wife; and beginning at a point in the North line of the Northeast Quarter of Section 27, Township 27 South, Range 1 West of the 6th P.M. and 1300.1 feet East of the Northwest Corner of said Northeast Quarter; thence South to a point in the South line of the Northwest Quarter of the Northeast Quarter of said Section 27; thence East 187.1 feet; thence North to a point in the North line of said Section 27; thence West 189.27 feet to the point of beginning, excepting the West 49.9 feet of the North 375 feet thereof, and excepting the N. 629.58 feet of the East 139.37 feet thereof, owned by J. L. Van Gilder and Mabel I. Van Gilder, his wife; and the East 5 Acres of the West 15 Acres of the Northeast Quarter of the Northeast Quarter of Section 27, Township 27 South, Range 1 West of the 6th P.M., excepting the North 629.58 feet thereof, owned by Joseph Clithero, Jr., and Lois J. Clithero, his wife.

Don C. Moehring, C.E.  
Don C. Moehring, C.E. Consulting Civil Engineer

Know all men by these presents that we, the undersigned property owners of the land as above set forth in the Civil Engineer's Certificate, have caused the same to be surveyed and platted into Lots, Blocks, Streets, and Avenues, the same to be known as WEST MAPLE GARDENS, Sedgwick County, Kansas. The Streets and Avenues are hereby dedicated to and for the use of the public, and Easements for the construction and maintenance of Public utilities are hereby granted as indicated on the accompanying plat.

J. B. Brummett Mabel I. Van Gilder Lois J. Clithero  
Mabel H. Brummett Ernest A. Jordan  
J. L. Van Gilder Doris Jordan Joseph Clithero, Jr.

I, Bessie A. Clithero, being mortgagee on part of the above described property do hereby consent to the plat of "West Maple Gardens," Sedgwick County, Kansas.

Bessie A. Clithero

State of Kansas }  
County of Sedgwick } ss

Be it remembered that on this 17th day of December, 1955, before me, a Notary Public in said State and County, came Bessie A. Clithero, to me personally known to be the same person who executed the foregoing instrument of writing and duly acknowledged the same as her voluntary act and deed

Helene Woods, Notary Public

My Commission expires: October 9, 1958

We, the Citizens Federal Savings and Loan Association of Wichita, being Mortgagees on part of the above described property, do hereby consent to the plat of "WEST MAPLE GARDENS," Sedgwick County, Kansas.

Leo Breese President Lyman Woodruff Secretary

State of Kansas }  
County of Sedgwick } ss

Be it remembered that on this 1st day of Oct. 1955, before me, a Notary Public in and for said State and County, came the "Citizens Federal Savings and Loan Association of Wichita" by its President, Leo Breese, and its Secretary, Lyman Woodruff, to me personally known to be the same persons who executed the foregoing instrument of writing, and duly acknowledged the same as their voluntary act and deed and the voluntary act of said Association.

My commission expires June 10, 1958 Malvina L. Roberts Notary Public

State of Kansas }  
County of Sedgwick } ss

Be it remembered that on this 15th day of Aug. 1955, before me, a Notary Public in and for said State and County, came J. B. Brummett and Mabel H. Brummett, his wife;

J. L. Van Gilder and Mabel I. Van Gilder, his wife; Joseph Clithero, Jr., and Lois J. Clithero, his wife; Ernest A. Jordan and Doris Jordan, his wife; to me personally known to be the same persons who executed the foregoing instrument of writing, and duly acknowledged the same as their voluntary act and deed.

My commission expires February 9, 1958 Lyman Woodruff Notary Public

This plat of "WEST MAPLE GARDENS," Sedgwick County, Kansas, has been submitted to and considered by the City Planning Commission of the City of Wichita, Kansas, and is hereby transmitted to the Board of Commissioners of the City of Wichita, Kansas, with the recommendation that such plat be approved as proposed.

Dated this 2 day of Aug. 1955.

The City Planning Commission of the City of Wichita, Kansas.

Eugene Hoar Chairman Attest J. Thomas Secretary

Approved by the Board of City Commissioners of Wichita, Kansas, this 9 day of Aug. 1955.

Blanche M. DeLors Mayor J. C. Bliss City Clerk

Approved by the Board of County Commissioners this 18th day of FEBRUARY 1956

Ed Schreier County Clerk

State of Kansas }  
County of Sedgwick } ss

This is to certify that this instrument was filed for records in the Register of Deeds Office this 1st day of Feb. 1956 at 4:00 o'clock P.M. and is duly recorded.

Lufer E. Dearing Register of Deeds W. K. Law Deputy

Entered on Transfer Record this 1st day of FEBRUARY 1956



Ed Schreier county Clerk

see Protective Rest. M. 362 P 271  
Setback/WAIVER M402 P 398

W1 1-14

# ERNEST JORDAN ADDITION

WICHITA, SEDGWICK COUNTY, KANSAS

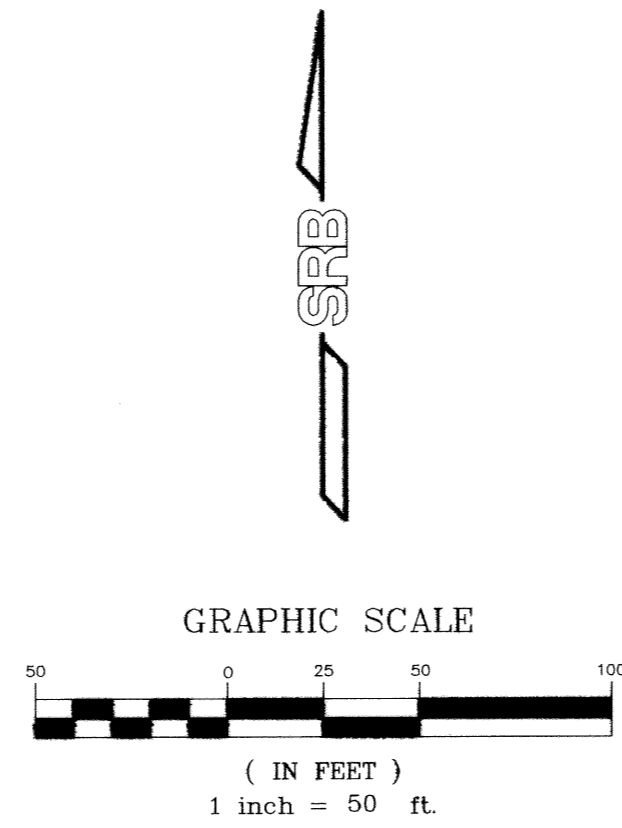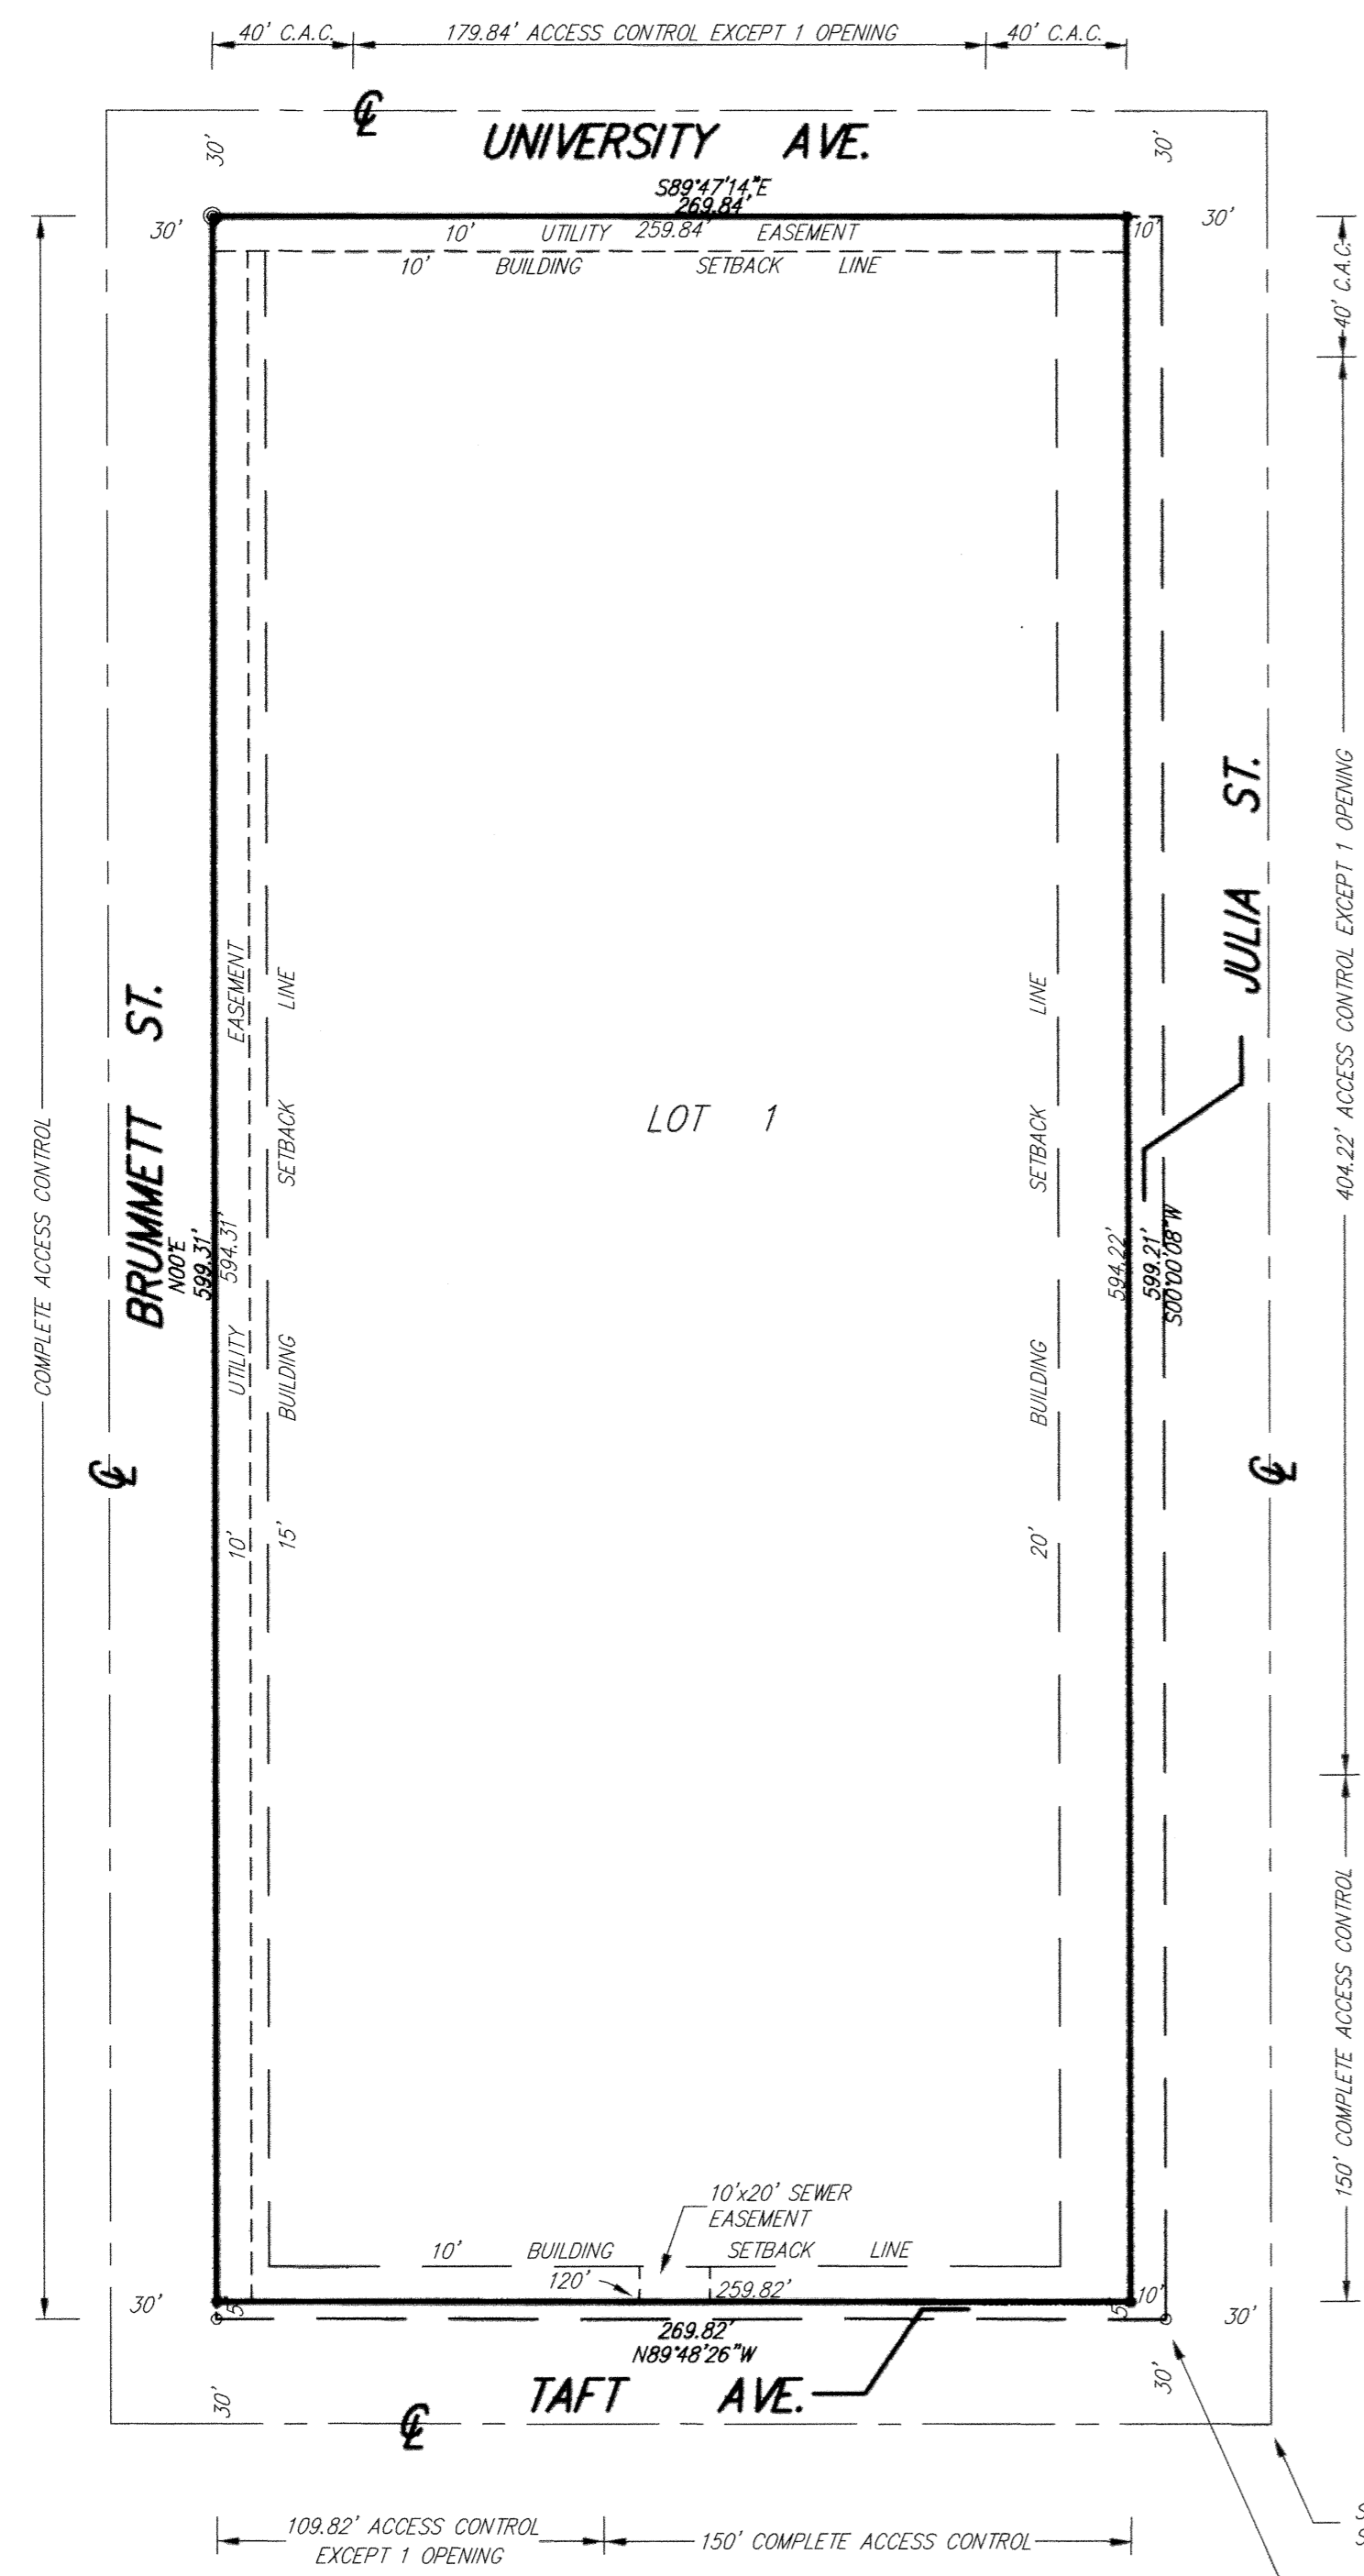

- ⊙ = 3/4" IRON PIPE (FOUND)
- = 1/2" IRON PIPE (FOUND)
- = 1/2" REBAR W/SRB CAP (SET)
- C.A.C. = COMPLETE ACCESS CONTROL

S.E. COR. NW1/4 OF NE1/4 SEC. 27-1275-R1W  
S.E. COR. LOT 10, BLOCK D, WEST MAPLE GARDENS

State of Kansas )  
Sedgwick County) SS


We, Savoy, Ruggles & Bohm, P.A., Surveyors in aforesaid county and state do hereby certify that, under the supervision of the undersigned, we have surveyed and platted "ERNEST JORDAN ADDITION", Wichita, Sedgwick County, Kansas and that the accompanying plat is a true and correct exhibit described as and being a replat of the following:

Lots 1, 2, 3, 4, 5, 6, 7, 8, 9 and 10, Block D, West Maple Gardens, Sedgwick County, Kansas.

All being situated in the NW1/4 of the NE1/4 of Sec. 27, T27S, R1W of the 6th P.M., Sedgwick County, Kansas.

Existing Public easements and dedications are being vacated by virtue of K.S.A. 12-512(b).

Savoy, Ruggles & Bohm, P.A.

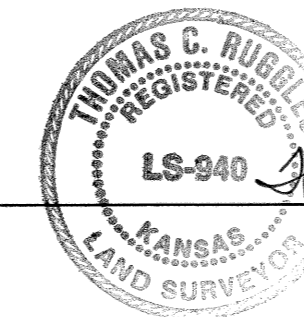


*Thomas C. Ruggles*  
Thomas C. Ruggles  
Surveyor

This plat of "ERNEST JORDAN ADDITION", Wichita, Sedgwick County, Kansas, has been submitted to and approved by the Wichita-Sedgwick County Metropolitan Area Planning Commission, Wichita, Kansas.

Dated this 8th day of November, 2001.

Wichita-Sedgwick County Metropolitan Area Planning Commission

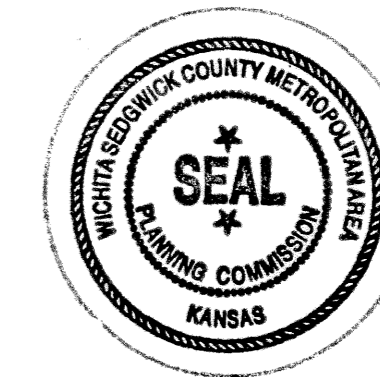


*J.D. Michaelis*  
J.D. Michaelis  
Chair

*Marvin S. Krout*  
Marvin S. Krout  
Secretary

This plat approved and all dedications shown hereon, accepted by the City Council of the City of Wichita, Kansas, this 20th day of AUGUST, 2002.

At the Direction of the City Council

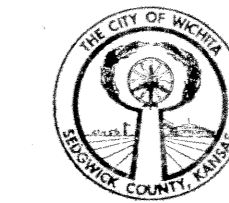

*Chris Cherches*  
Chris Cherches  
City Manager

*Pat Burnett*  
Pat Burnett  
City Clerk

Know all men by these presents that we, the undersigned have caused the land described in the surveyor's certificate to be platted into a Lot and Streets to be known as "ERNEST JORDAN ADDITION", Wichita, Sedgwick County, Kansas. The sewer easement is hereby granted as indicated for the construction and maintenance of a sewer system. The Streets are hereby dedicated to and for the use of the public. Access Control is hereby granted to the appropriate governing body (as indicated on the face of the plat). A drainage plan has been developed for this plat and all drainage easements, and rights-of-way shall remain at established grades or as modified with the approval of the City Engineer, and unobstructed to allow for the conveyance of stormwater.

ERNEST A. JORDAN, SR. TRUST,  
Dated the 3rd day of November, 1997

*Ernest A. Jordan, Sr.*  
Ernest A. Jordan, Sr.  
Trustee


DORIS I. JORDAN, TRUST,  
Dated the 3rd day of November, 1997

*Ernest A. Jordan, Sr.*  
Ernest A. Jordan, Sr.  
Trustee

State of Texas )  
Galveston County) SS

The foregoing instrument acknowledged before me, this 15th day of February, 2002, by Ernest A. Jordan, Sr., Trustee of the Ernest A. Jordan, Sr. Trust, dated the 3rd day of November, 1997 and Ernest A. Jordan, Sr., Trustee of the Doris I. Jordan Trust, dated the 3rd day of November, 1997.

*Karen Dennis Renfrow*  
Karen Dennis Renfrow  
Notary Public

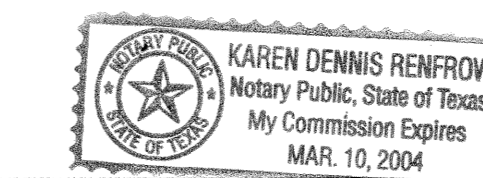


My Appointment Expires

Reviewed in accordance with K.S.A. 58-2005 on this 8th day of March, 2002.

*Tricia L. Robello*  
Tricia L. Robello, LS #1246  
Deputy County Surveyor  
Sedgwick County, Kansas

Entered on transfer record this 5th day of SEPTEMBER, 2002.

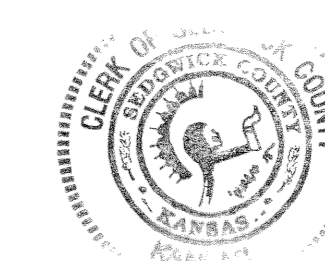

*Don Brace*  
Don Brace  
County Clerk

State of Kansas )  
Sedgwick County) SS

This is to certify that this plat has been filed for record in the office of the Register of Deeds, this 5th day of SEPTEMBER, 2002, at 11:17 o'clock A.M. and is duly recorded.



*Bill Meek*  
Bill Meek  
Register of Deeds

*Linda Kizzire*  
Linda Kizzire  
Deputy

**SRB** 924 NORTH MAIN 316-264-8088  
WICHITA, KANSAS 67203 FAX: 264-4621  
http://www.srb1.com E-mail: srb@srb1.com  
**SAVOY, RUGGLES & BOHM, P.A.**  
ENGINEERING & SURVEYING

DWG FILE: 02023PF-R.C.  
PROJECT NO. 01H02023P

2119192

20-cc

ERNEST JORDAN ADDITION