


# LATERAL 5, MAIN 10 OF THE FOUR MILE CREEK SEWER IN THE CITY OF WICHITA, KANSAS

OCA NO. 744161  
CITY OF WICHITA PROJECT NO. 468-84124  
JAMES L. ARMOUR, P.E. - CITY ENGINEER

*Nowak Construction Co., Inc. - Contractor  
Strothman, City - Inspector  
Released 7/3/06  
As-Built  
Risers & Stubs  
.pdf by JDL 11/13/06*

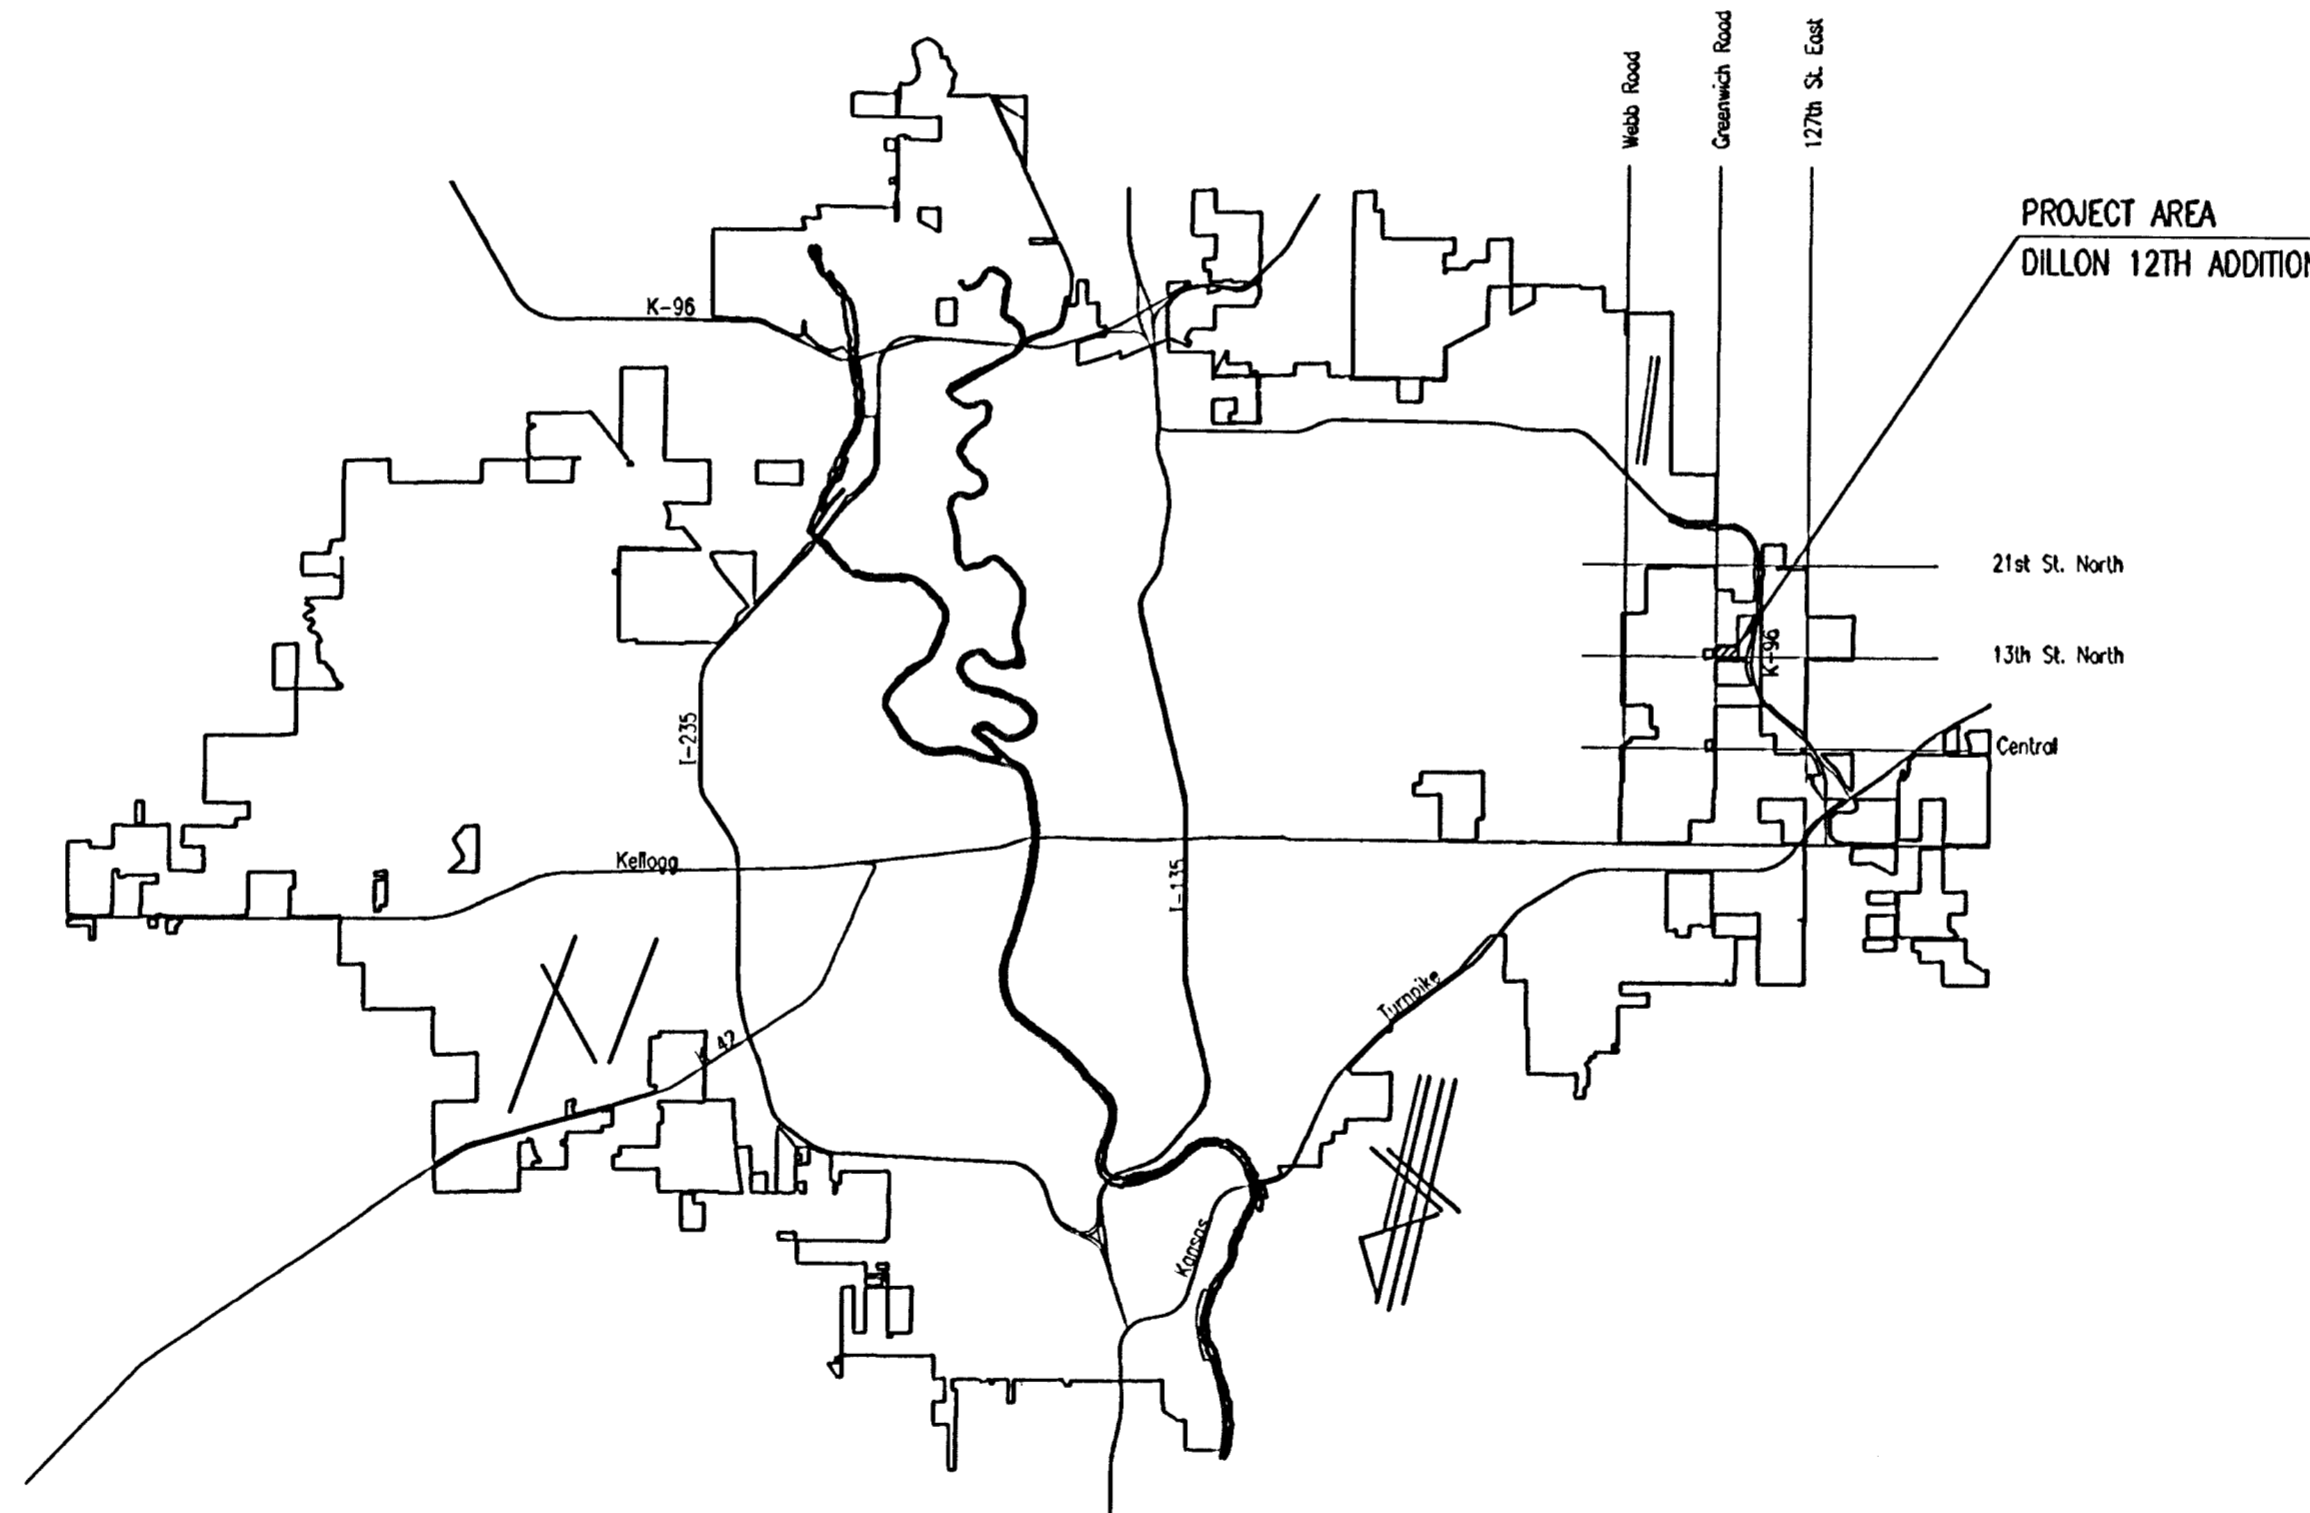

**INDEX OF SHEETS**

SHEET NO. 1	TITLE SHEET
SHEET NO. 2	KEY MAP AND GENERAL NOTES
SHEET NO. 3	PLAT
SHEET NO. 4	PROJECT COORDINATES
SHEET NO. 5-7	PLAN/PROFILE
SHEET NO. 8	TYPE "P" MANHOLE DETAILS
SHEET NO. 9	FRAME & COVER DETAILS
SHEET NO. 10	RISER DETAILS
SHEET NO. 11-14	SOIL EROSION BMP DETAILS

**CONSTRUCTION/SEQUENCE SCHEDULE**

CONTRACTOR SHALL COORDINATE THE INSTALLATION OF SANITARY SEWER ACROSS GREENWICH ROAD WITH THE CONTRACTOR FOR THE GREENWICH ROAD IMPROVEMENTS (C.O.W. PROJECT NUMBER NO. 472-84274). SANITARY SEWER INSTALLATION SHALL BE PERFORMED WHEN GREENWICH ROAD IS CLOSED FOR ROAD CONSTRUCTION.  
THE SANITARY SEWER PROJECT SHALL BE COMPLETED BY FEBRUARY 24, 2006.

## DECEMBER 2005

PLANS PREPARED BY  
**PROFESSIONAL ENGINEERING CONSULTANTS, P.A.**  
ENGINEERS  
WICHITA, KANSAS

