

LATERAL 2, MAIN 6, COWSKIN INTERCEPTOR SEWER Sanitary Sewer Improvements to serve **TURKEY CREEK 2ND ADDITION - PHASE II** CITY OF WICHITA, KANSAS

James L. Armour, P.E. City Engineer

Project Number

468-83819

O.C.A. Number

744173

Nowak Construction Co., Inc. - Contractor

Hartman, City - Inspector

Released 8/1/06

As-Built

Risers & Stubs

.pdf by JDL 10/27/06

GENERAL NOTES:

- Contractor will be required to provide notice to utility companies a minimum of Forty-Eight (48) hours prior to any excavation, as follows:

Kansas One-Call 687-2470

The Contractor must notify the following in case of an emergency:

Cox Communications	262-4270
Kansas Gas Service	1-888-482-4950
Westar Energy	383-8650
Aquila Energy	1-800-303-0357
Southwestern Bell	268-2245
City of Wichita Water Dept.	268-4563
City of Wichita Sewer Maint.	268-4024
City of Wichita Storm Sewer Maint.	268-4030
City of Wichita Traffic Maint.	268-4034
Conoco Pipeline Co.	1-800-231-2551
Williams Pipeline Co.	329-6600
Phillips Pipeline Co.	1-800-766-8230


- Utility service lines, poles, valve boxes, meters, and etcetera are to be adjusted as necessary by others prior to construction unless the plans specifically call for their adjustment by the Contractor or unless the plans specifically identify a utility to be adjusted by its owner during construction. Existing utilities and their location, as shown on the plans, represent the best information obtainable for design. The Contractor will be required to work around existing utilities within the right-of-way which do not conflict with proposed construction.
- Rubble from the removal of miscellaneous structures and excess excavation which is to be wasted shall be disposed of on sites to be provided by the Contractor. These sites shall be approved by the Engineer as to suitability, appearance on site location. Locations, in the opinion of the Engineer, will leave an unsightly appearance will not be approved. All disposal sites must be approved by the Kansas Department of Health and Environment. Material either stockpiled or disposed of in a flood plain would require a Kansas State Board of Agriculture permit. Any material dumped in waters of the United States or wetlands is subject to U.S. Corps. of Engineers permitting regulations. Any material buried or stockpiled beyond approved construction limits would require additional archaeological investigations unless buried in a previously approved borrow location.
- Trees and shrubs in public right-of-way which are in direct conflict with proposed new construction shall be removed by the Contractor with the Engineer's approval. Trees and shrubs which are not in direct conflict with proposed new construction shall be saved and protected from damage.

Sheet Index


Title Sheet	1
Line 1	2-3
Line 2	4
Line 3	5
Line 4	6
Line 4A	7
Line 4B	8
Standard Manhole Detail	9
Ring & Cover Detail	10
Vertical Riser Detail	11
Erosion Control BMP's	12-15
Erosion Control Plan	16-17
Coordinate Sheet	18
Copy of Plat	19

Benchmarks

119th St. W. & Pawnee
City of Wichita Benchmark Disc.
NE corner of intersection. 40' E
and 30' N of centerline. 59.5' N
of power pole @ SE corner of
intersection. 156.8' NNE of
centerline of E concrete headwall
on culvert under 119th St. W.
Elev. = 148.68 (City Datum)
Elev. = 1336.08 (N.G.V.D.29)

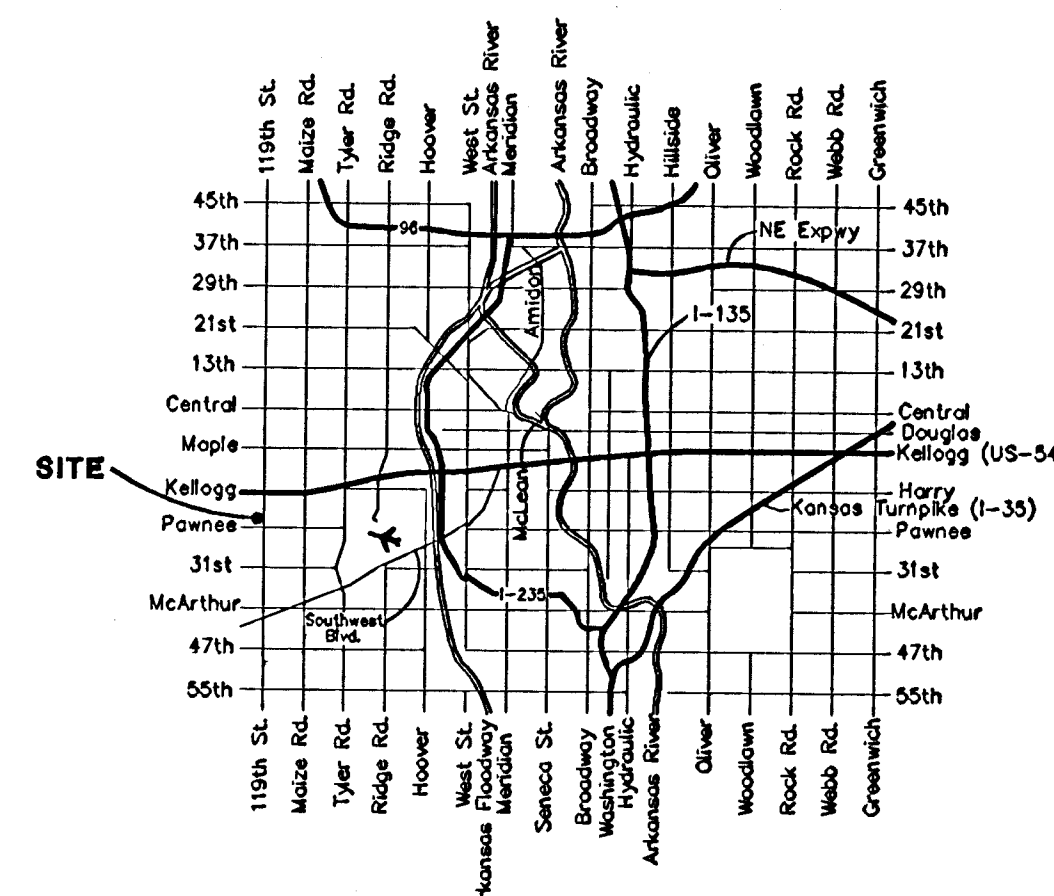

Vicinity Map

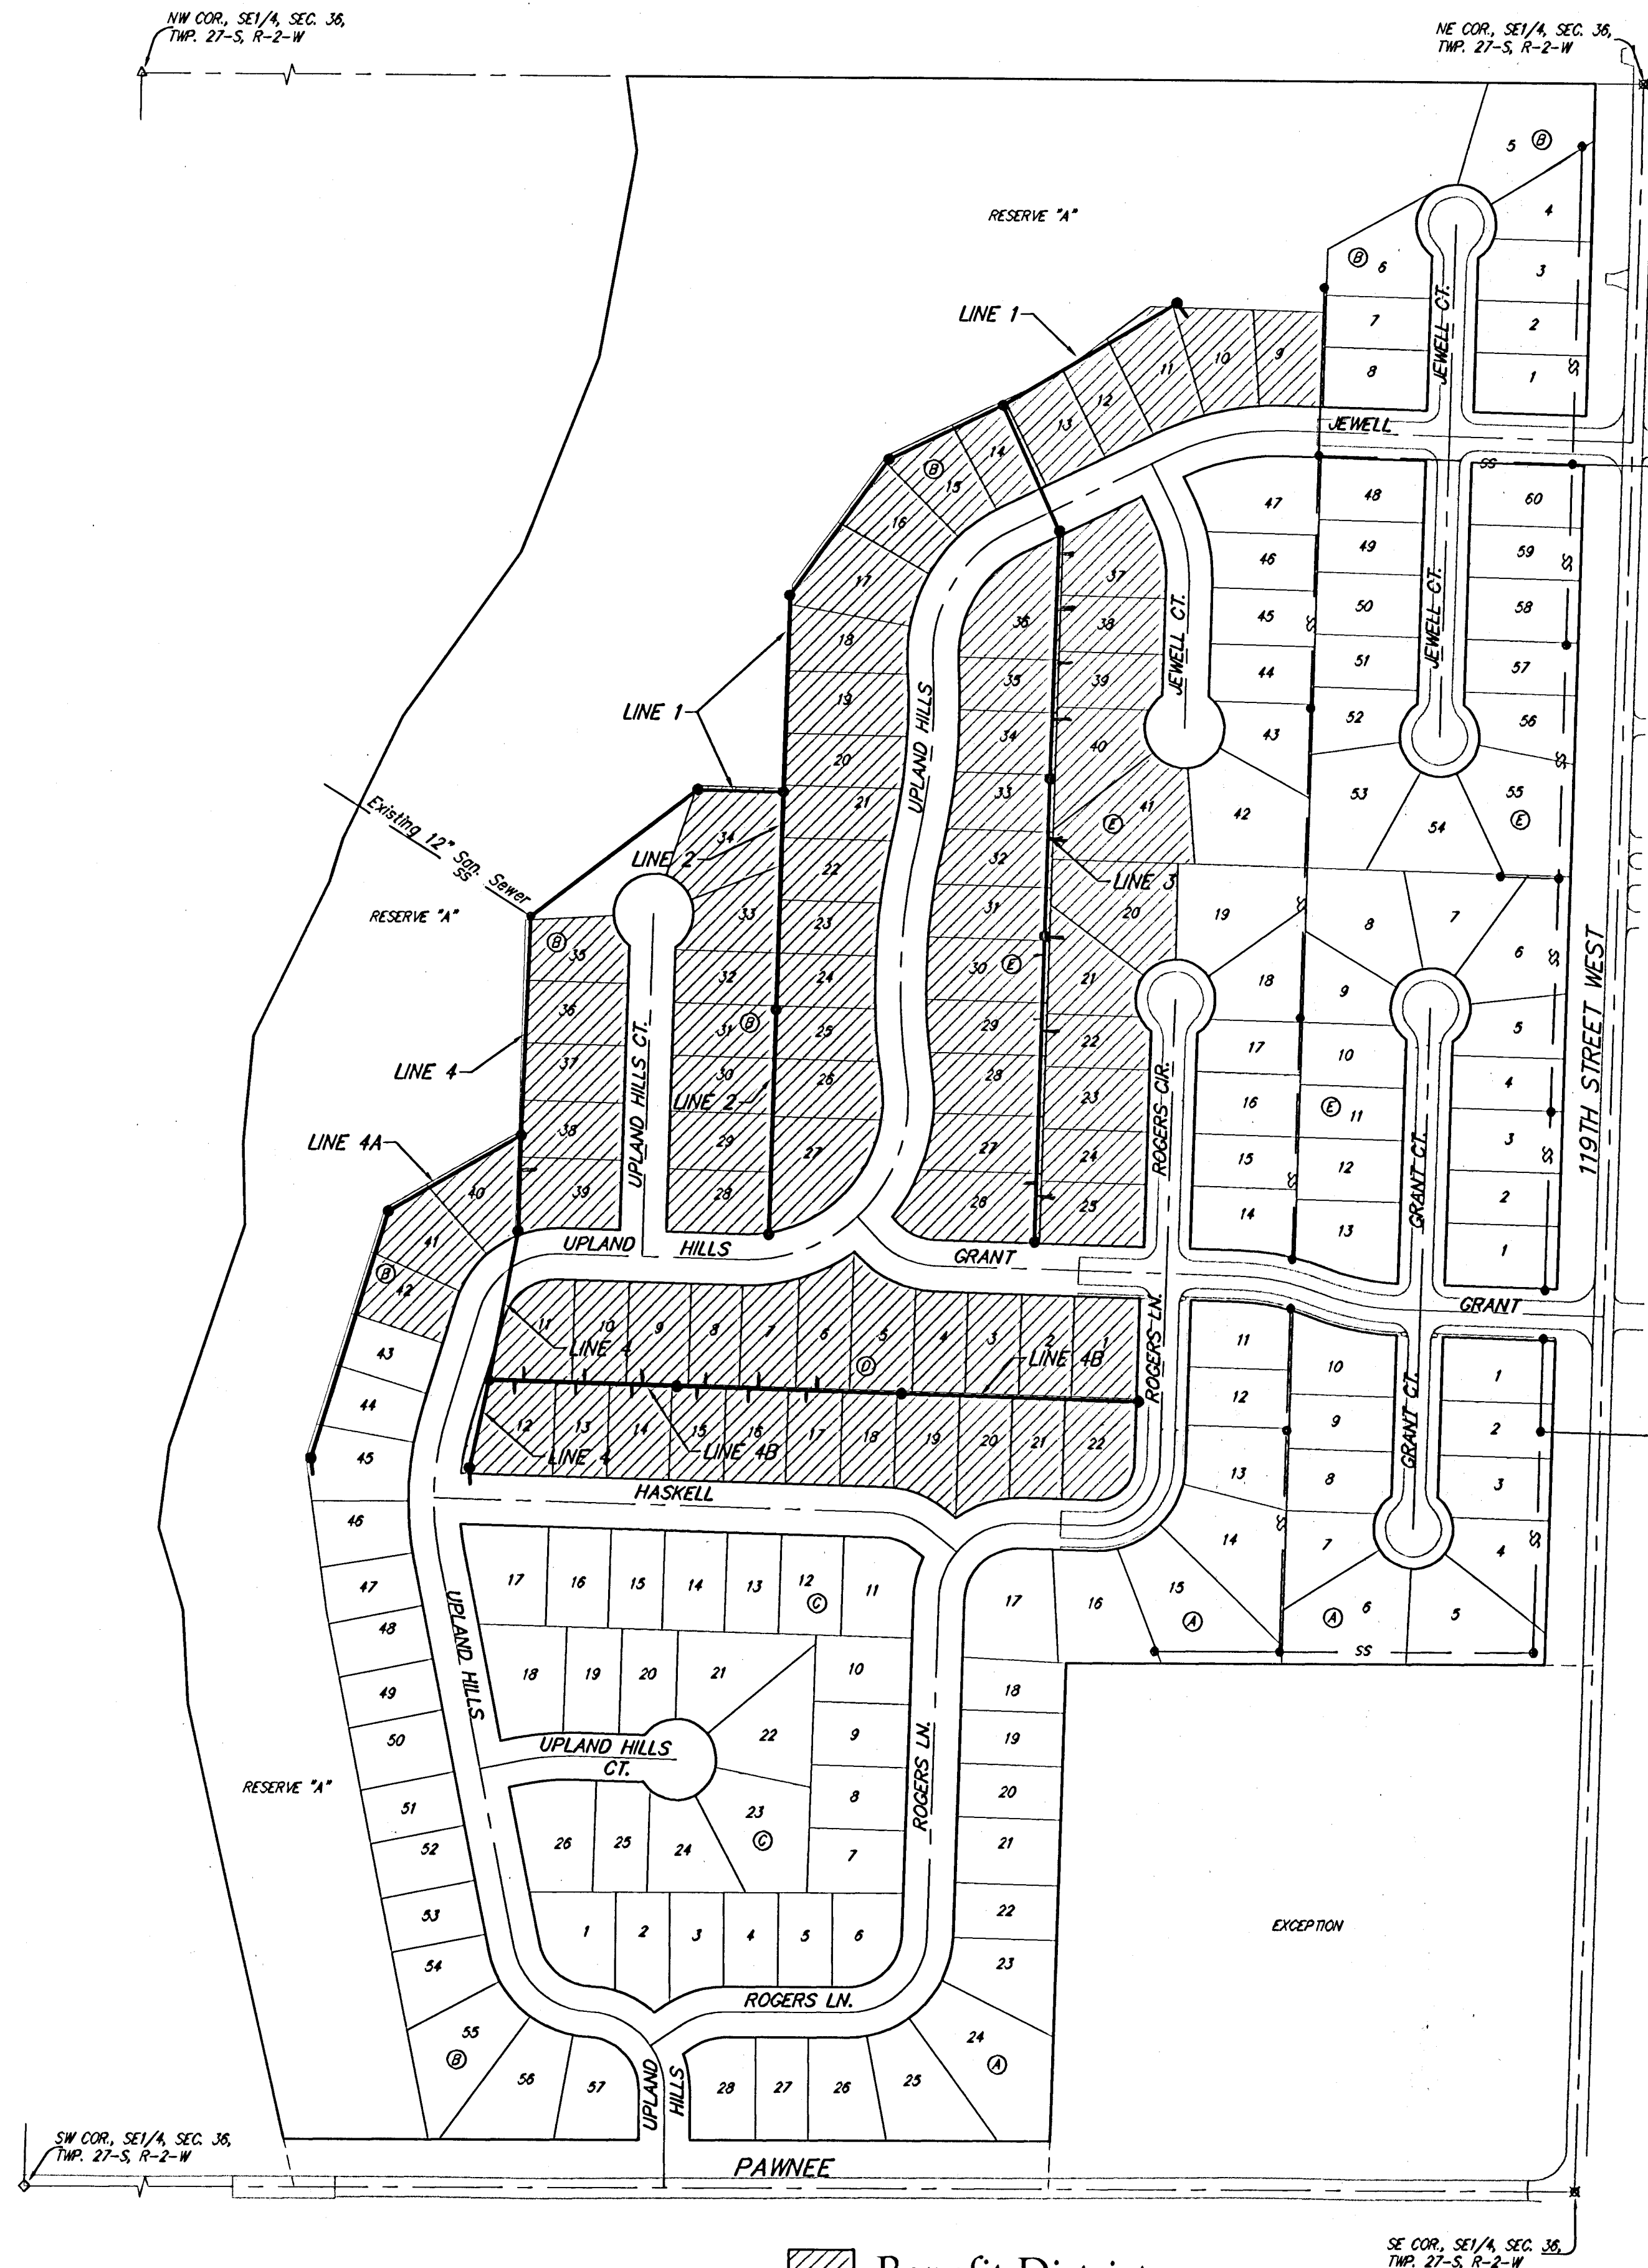

Benefit District



Baughman Company, P.A. 315 Ella St. Wichita, KS 67211 P 316-262-7271 F 316-262-0141
ENGINEERING | SURVEYING | PLANNING | LANDSCAPE ARCHITECTURE

