

# GENERAL NOTES:

- The Contractor shall comply with all applicable safety regulations. All construction shall be completed following current City Standard Specifications and Special Provisions.
  - Maintain a minimum of 10-foot horizontal separation between all water lines (mains and services) and all sanitary sewer lines (mains, services, and manholes). All separation distances are to be measured from edge-to-edge, at the closest point.
  - Maintain a minimum of 2-foot vertical separation between all water lines (mains and services) and all gravity sanitary sewer lines (mains, services, and manholes) at crossings. All separation distances are to be measured from edge-to-edge, at the closest point.
  - Maintain a minimum of 2-foot vertical separation between all water lines (mains and services) and all pressurized sanitary sewer lines (force mains and services) at crossings. Waterlines must always be placed above pressurized sanitary sewer lines where they cross. All separation distances are to be measured from edge-to-edge, at the closest point.
- Contractor will be required to provide notice to utility companies a minimum of seventy-two (72) hours prior to any excavation, as follows:
 

Kansas One-Call 687-2470

The Contractor must notify the following in case of an emergency:

AT&T	1-800-246-8464
Black Hills Energy	1-800-694-8989
City of Wichita Water & Sewer	1-316-219-8921
City of Wichita Stormwater	1-316-268-4090
City of Wichita Traffic	1-316-268-4034
Cox Communications	1-888-249-3530
Kansas Gas Service	1-888-482-4950
Every	1-800-544-4857
- Utility service lines, poles, etc. are to be adjusted as necessary by others prior to construction unless the plans specifically call for their adjustment by the Contractor or unless the plans specifically identify a utility to be adjusted by its owner during construction. Existing utilities and their location, as shown on the plans, represent the best information obtainable for design. The Contractor will be required to work around existing utilities within the right-of-way which do not conflict with proposed construction.
- Rubble from the removal of miscellaneous structures and excess excavation which is to be wasted shall be disposed of on sites to be provided by the Contractor. These sites shall be approved by the Engineer as to suitability, appearance and site location. Locations, in the opinion of the Engineer, that will leave an unsightly appearance will not be approved. All disposal sites must be approved by the Kansas Department of Health and Environment. Material either stockpiled or disposed of in a flood plain will require a Kansas State Board of Agriculture permit. Any material dumped in waters of the United States or wetlands is subject to U.S. Corps. of Engineers permitting regulations. Any material buried or stockpiled beyond approved construction limits will require additional archaeological investigations unless buried in a previously approved borrow location.
- Trees and shrubs in public right-of-way which are in direct conflict with proposed new construction shall be removed by the Contractor with the City Engineer's approval. Trees and shrubs which are not in direct conflict with proposed new construction shall be saved and protected from damage.
- The Contractor shall give all property owners and/or tenants of developed property abutting the construction of this project a minimum of ten (10) days notice prior to start of construction.
- The Contractor shall be responsible for preserving property irons. The Contractor will be required to re-establish any property irons which are damaged or destroyed by his construction operations. Such irons shall be re-established by a licensed land surveyor in accordance with state laws.
- The Engineering Division shall field locate water valve one time during construction when requested by the Contractor. It shall be the Contractor's responsibility to preserve such field locations during the construction process. Water valves, valve boxes or fire hydrants damaged during construction shall be repaired by Contractor at his own expense. Valve boxes and water meters within the project limits shall be adjusted to match field grades by the contractor.
- The Contractor shall notify the consultant engineer and Dawnita Reinhardt at 316-650-0740 with the City of Wichita with the anticipated construction start date and notify them of project completion. Staking and inspection for this project will be the responsibility of the Contractor.
- If traffic will be impacted by construction, a traffic control plan must be submitted and approved by the City Traffic Engineer at [traffic@wichita.gov](mailto:traffic@wichita.gov) before construction can begin. The Contractor shall be responsible for all traffic control measures to facilitate construction. All construction zone markings and signage shall conform to the latest version of Manual on Uniform Traffic Control Devices (MUTCD) as published by the US Dept. of Transportation, Federal Highway Administration. All costs associated with construction markings and signage shall be the Contractors responsibility.
  - All elevations shown are NAVD88.
  - All areas disturbed during construction that will not be under proposed pavement shall be restored to match existing conditions per City specifications.
  - Any sidewalk, drive approach, curb, or street pavement removed to construct project must have a pavement cut permit and be replaced by the City contractor. Permits can be obtained by calling 316-268-4501 or 316-268-4480.
  - All applicable fees (tap, equity, in lieu of & main benefit) must be paid before any work on this project can commence. Quotes can be obtained on fees by calling 316-268-4555.
  - City maintenance of water mains ends at right-of-way.
  - Opening and closing of water valves shall be done slowly to prevent damage to the water distribution system from water hammer. All valves closed by the contractor must be reopened as new construction permits. The project inspector must ascertain that any valve closed by the Contractor is reopened. The contractor will be permitted to operate water valves only when the project inspector assigned to the project is present.
  - The Contractor shall lay a Tracer Wire and Set Test Stations along all water pipe installed in accordance with City Specifications and Tracer Wire Detail on detail sheet WL-101, cost is subsidiary to pipe installation.
  - The contractor shall provide materials for temporary blowoff of waterlines. Connections to the existing waterline(s) shall be made with clean, swabbed pipe and flushed upon completion of tie-ins.
  - Requests for short term water interruptions shall be made to the City Water Distribution Division and will be subject to their approval. The Contractor shall give written notice to any property owner, business, and/or tenants that will have water service interrupted at least 5 days in advance. Such notifications should indicate the time and date that the water will be turned off and when the service will be restored. No business, property owner, and/or tenants shall be without water service for more than 8 hours. Proposed tie in locations which will affect water service to property owners shall be performed during non-peak hours.
  - The Contractor must schedule the connections to the existing main with the City such that there is a minimum disruption of service. Connections shall be made during periods of low water usage. The Contractor shall submit his proposed schedule for completing work for City approval at least 10 days prior to beginning construction.
  - Deflections at pipe joint or couplings shall not exceed the pipe manufacturers recommended maximum. Where deflections are greater than the maximum allowed, the contractor shall utilize fittings.
  - Any existing joint exposed during excavation shall be replaced if within four feet of proposed joint.
  - Valves 12 inches and larger are to be operated by the City Water Distribution Division, 48 hours of advance notice is required.
  - All wet taps shall be installed by the City of Wichita. The Contractor will reimburse the City for tapping fees prior to tap being made. Unless noted on plans.
  - The Contractor shall protect from damage and support existing utilities through construction as approved by the utility owner and the Engineer at the contractor's expense.
  - Contractor shall limit the extent of trench openings overnight and weekends to less than 50 feet.
  - Wichita Fire Department inspections may be scheduled by calling Dawnita Reinhardt at 316-650-0740.

## Benchmarks

BM #1: "□" Chiseled on Conc. Planter Box on the north side of Douglas, ~145' west of Emporia. Elevation=1298.91 (NAVD88)

6" PVC PIPE = NORTHERN PIPE PRODUCTS.  
 6" DICL PIPE = AMERICAN.  
 6" TAP VALVE = CLOW.

# AS-BUILT PLANS

## WATER DISTRIBUTION SYSTEM

to serve

# LEGACY BUILDING

105 S. Emporia

CITY OF WICHITA, K


Gary Janzen, P.E. City Engineer

2022-022632 PPW

54030980

**UTILITY CONTRACTOR: McCULLOUGH EXCAVATION.**  
**INSPECTOR: LARRY POWELL / JIM RALSTON BAUGHMAN COMPANY, P.A.**  
**AS-BUILTS BY: L. POWELL**  
**MAY 5, 2023**

**BEGIN: MAY 1, 2023.**  
**END: MAY 5, 2023.**

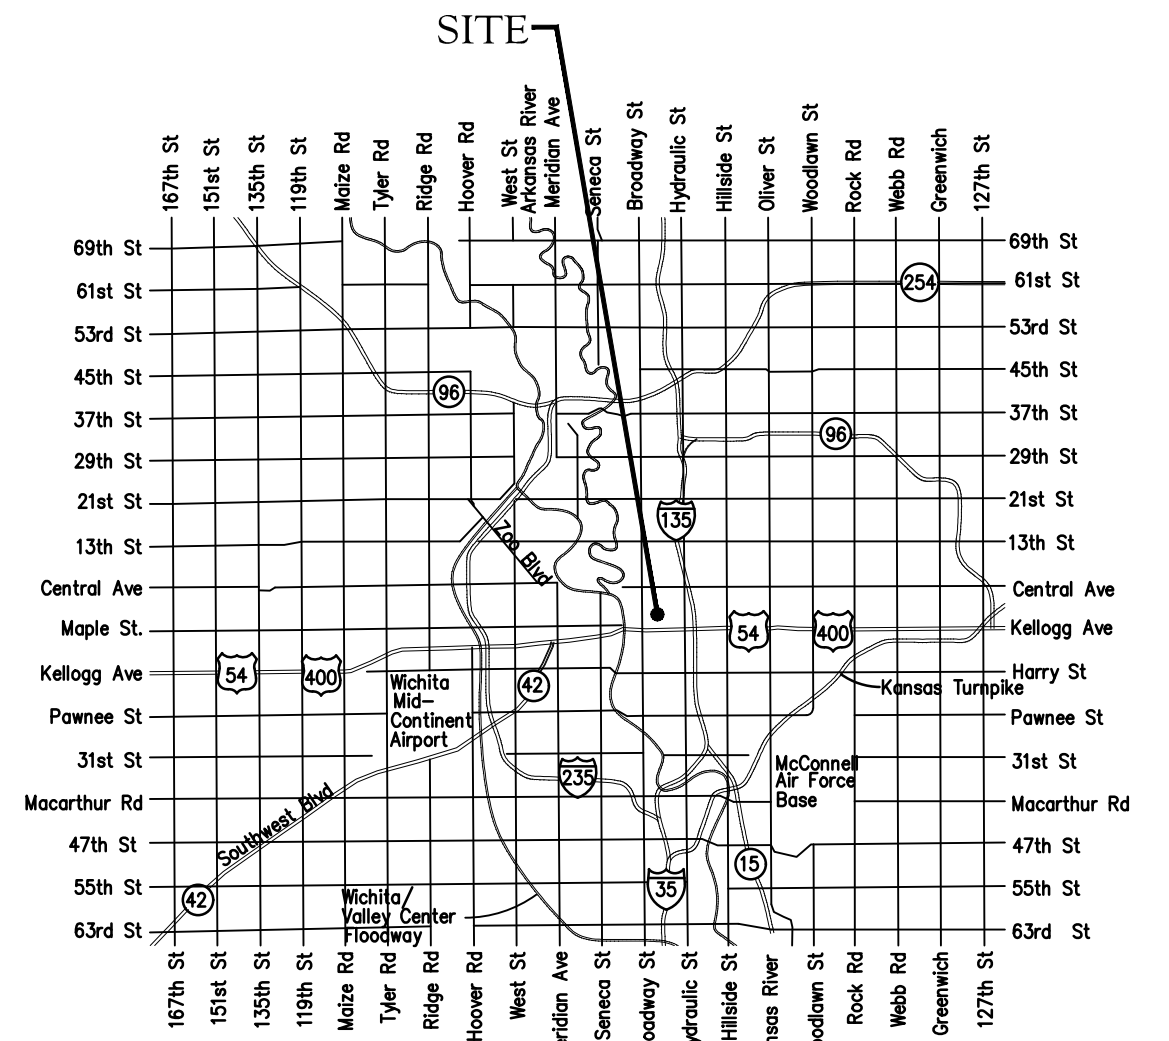

Vicinity Map

## Sheet Index

Title Sheet	1
Line 1	2
Erosion Control/Grading Plan	3
Std. Water Assembly Detail	4
Miscellaneous Water Details	5
Erosion Control BMP Details	6-10
Copy of Plat	11

APPROVED AS NOTED	
BY WICHITA PUBLIC WORKS	
ENGINEERING DIVISION	
& BY WICHITA FIRE DEPARTMENT	
Engineering	<u>approved by Shawn Mellies on 10.19.22</u>
Utilities	<u>approved by Greg Lolley on 10.19.22</u>
Fire Dept.	<u>approved by Jose Ocadiz on 10.19.22</u>

### NOTE TO CONTRACTORS

**Public Property:**  
 Inspection and testing for the waterline is to be provided by a Licensed Consulting Engineering Firm under contract with the Owner/Developer. Said inspection is to be in accordance with the City of Wichita standard construction engineering practices and certified by a Professional Engineer Licensed in the state of Kansas. No work shall be performed in dedicated easements or public right-of-way by the Contractor without such inspection nor shall any work be commenced without written authorization by City Engineering. All Construction and Materials shall comply with the City of Wichita Specifications and Standards and Special Provisions (on file and available in the City Engineer's Office) or on the City's Website.




**Private Property:**  
 Installation and testing for the fire protection line is to be performed by a City of Wichita licensed fire protection contractor in accordance with the fire codes as adopted by the City of Wichita. All material and construction practices for the fire protection line shall comply with the fire codes as adopted by the City of Wichita (available from the City of Wichita Fire Department). The Contractor shall not commence work without notification and approval of the Wichita Fire Department. Inspection of the fire protection line is to be provided by a licensed Engineering Firm under contract with the Owner/Developer and the Fire Department. The contractor shall not start work until the project inspector is assigned to the project and present on the site. Any work done without inspection will be required to be uncovered for inspection.

An approved copy of these plans signed by City staff are required on-site.

**BAUGHMAN JOB NUMBER:**  
**23-04-E496**

October 20, 2022

**BAUGHMAN COMPANY**  
 315 Ellis St. Wichita, KS 67211 316-262-7271  
 BaughmanCo.com

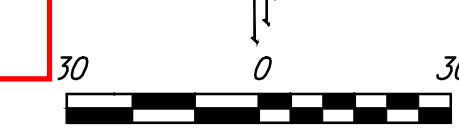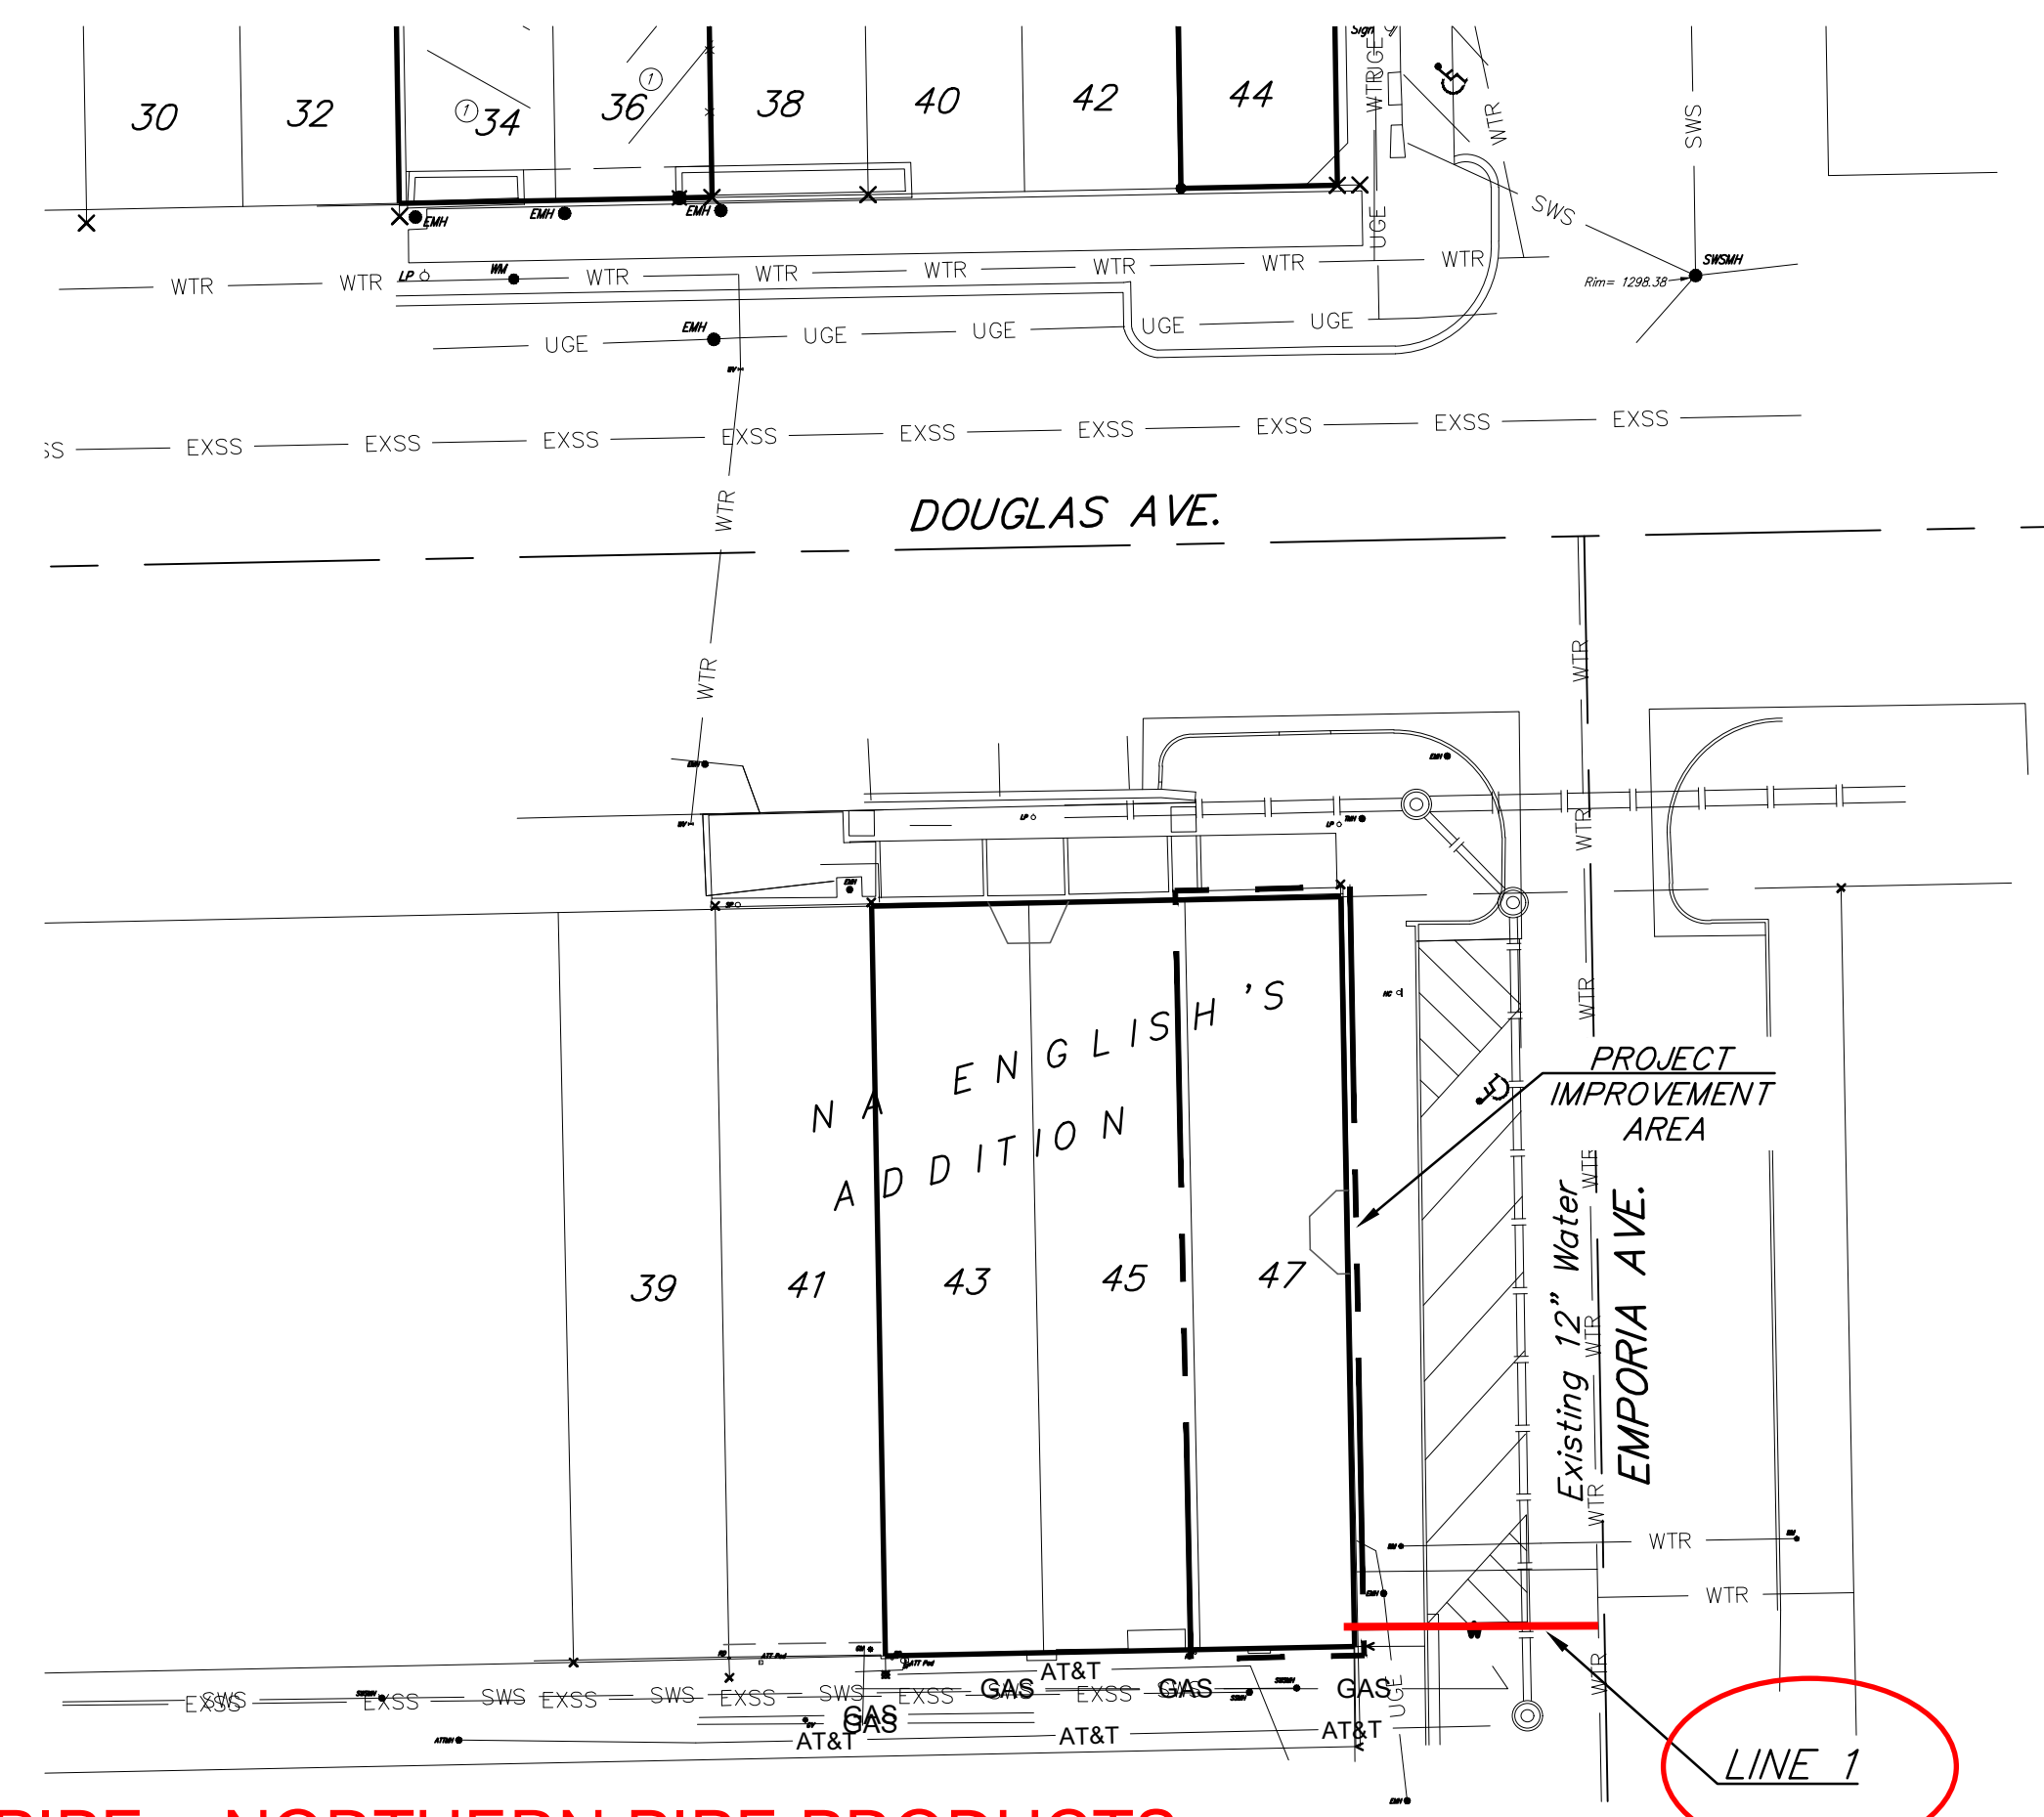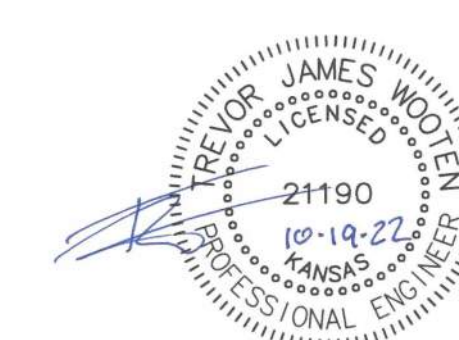

E:\Projects\Legacy Building MA English's Add 22-06-E227\Engineering\Phase 1\PPW\PPW.dwg

**BENCHMARK:**  
 BM #1: "□" Chiseled on  
 Conc. Planter Box on the  
 north side of Douglas,  
 ~145' west of Emporia.  
 Elevation=1298.91 (NAVD88)

**FIRE SERVICE LINE WAS INSTALLED AT 6"... NOT 8" PIPE.**  
**SEE AS-BUILT SKETCH ON SHEET # 12.**

**Sta. 0+20.3 - 45 Deg. Bend (V):**  
 173' South of CL Douglas Ave.  
 20.8' West of CL Emporia Ave.

**Sta. 0+22.8 - 45 Deg. Bend (V):**  
 173' South of CL Douglas Ave.  
 23.5' West of CL Emporia Ave.

**Sta. 0+35.1 - CI Sleeve:**  
 173' South of CL Douglas Ave.  
 35.6' West of CL Emporia Ave.


**LEGEND**

**(TS) = TEST STATION**

When fire service and domestic water line installed in same trench, trench shall be compacted per detail, this sheet.

**Sta. 0+00 - 6" TAP Saddle:**  
 173' South of CL Douglas Ave.  
 0.5' West of CL Emporia Ave.



**Sta. 0+01.5 - 6" TAP Valve:**  
 173' South of CL Douglas Ave.  
 2' West of CL Emporia Ave.

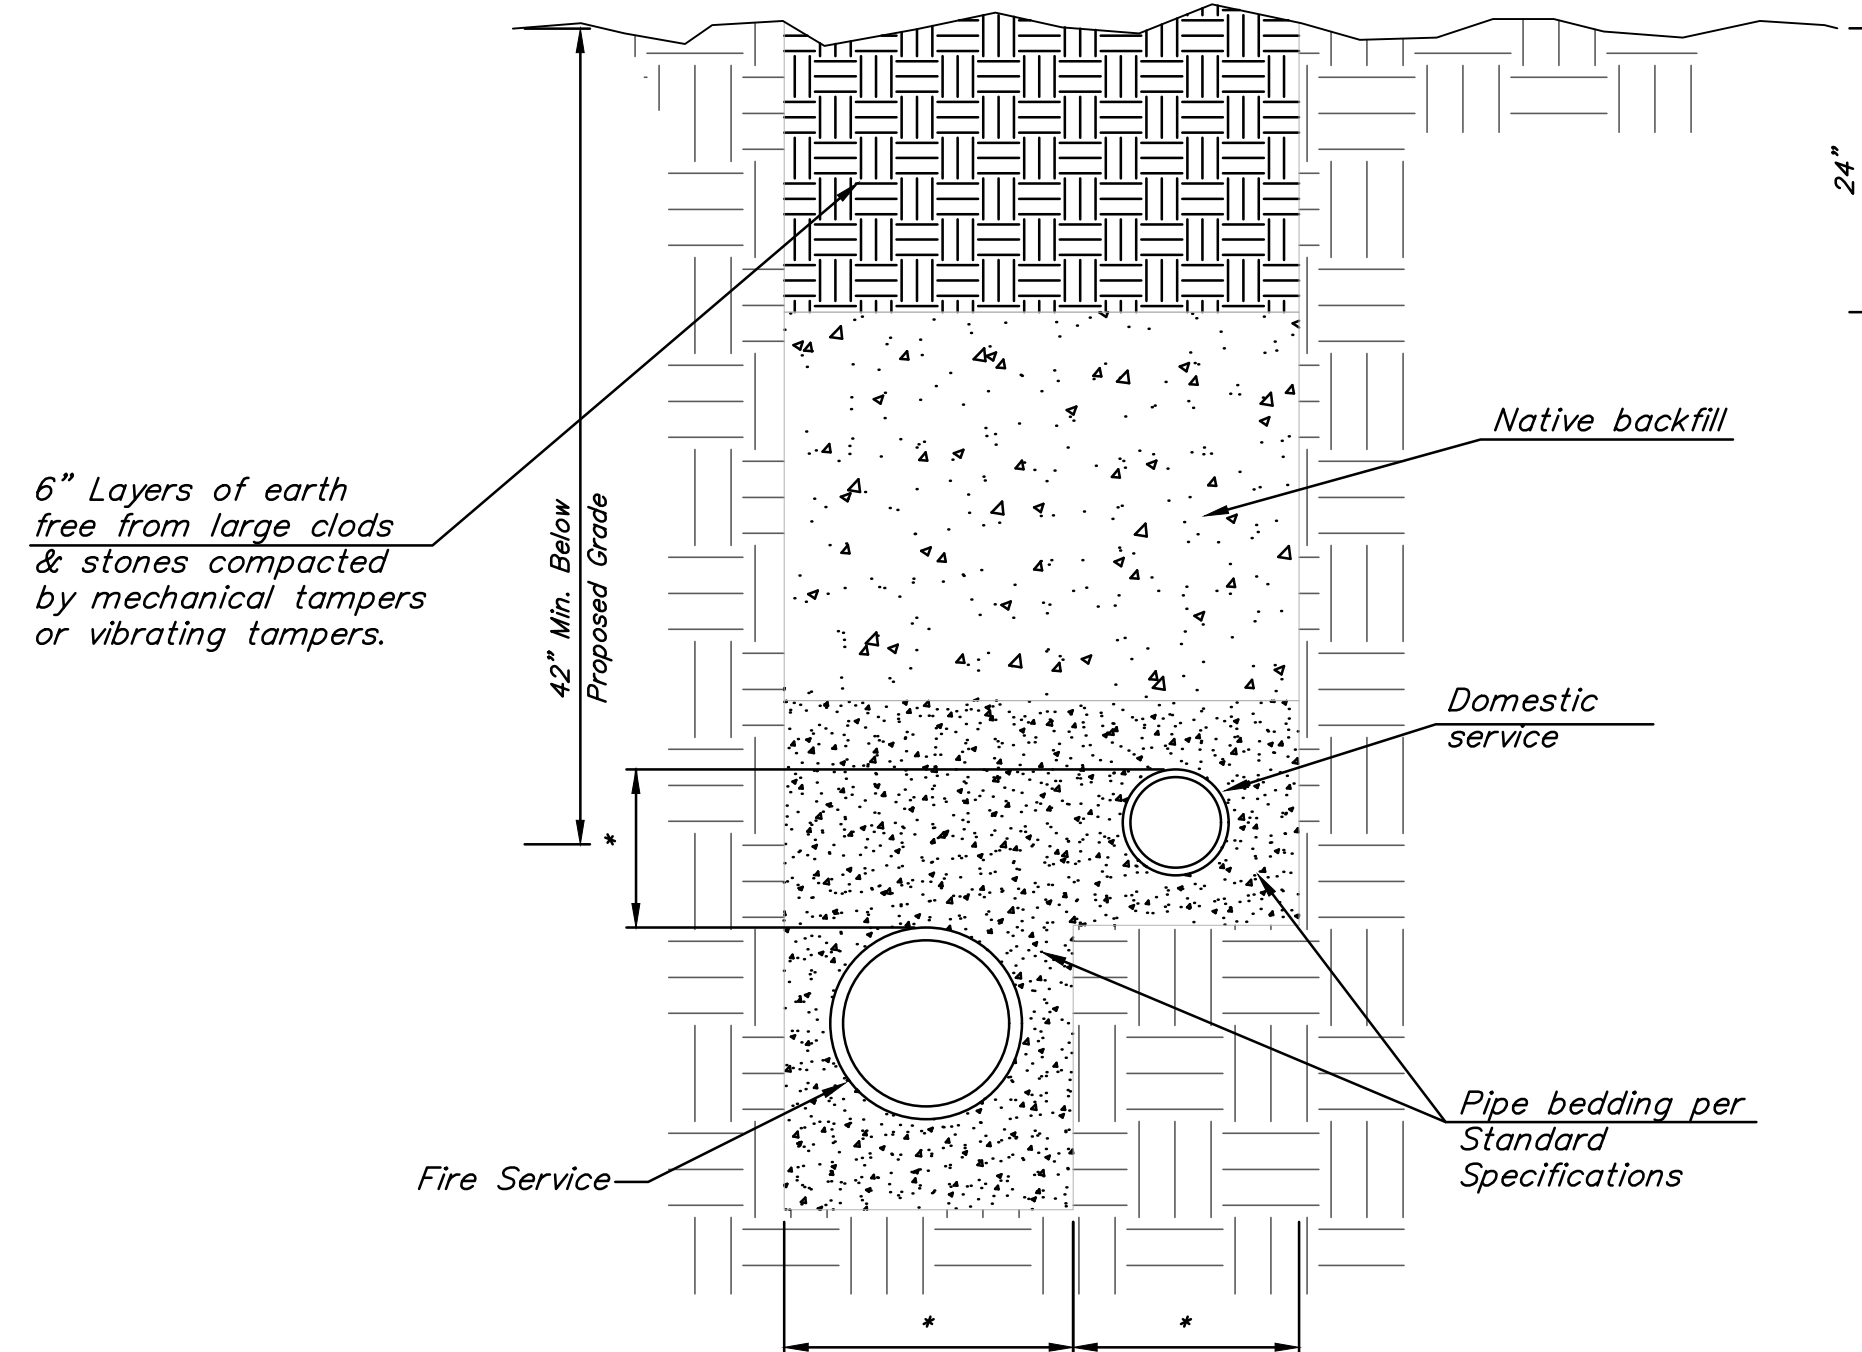

**COMBINED TRENCH SECTION & COMPACTION**

\*TRENCH SIZE AND STAIR STEP SHALL BE BASED ON THRUST BLOCK REQUIREMENTS AGAINST VIRGIN SOIL OR CONTRACTOR MAY OPT TO USE RESTRAINED JOINT PIPE MATERIAL.

**DEPTH UNKNOWN**  
 Contractor to Verify Depth & Location of Existing Water Line Prior to Construction.

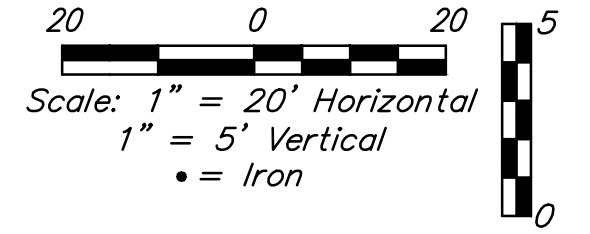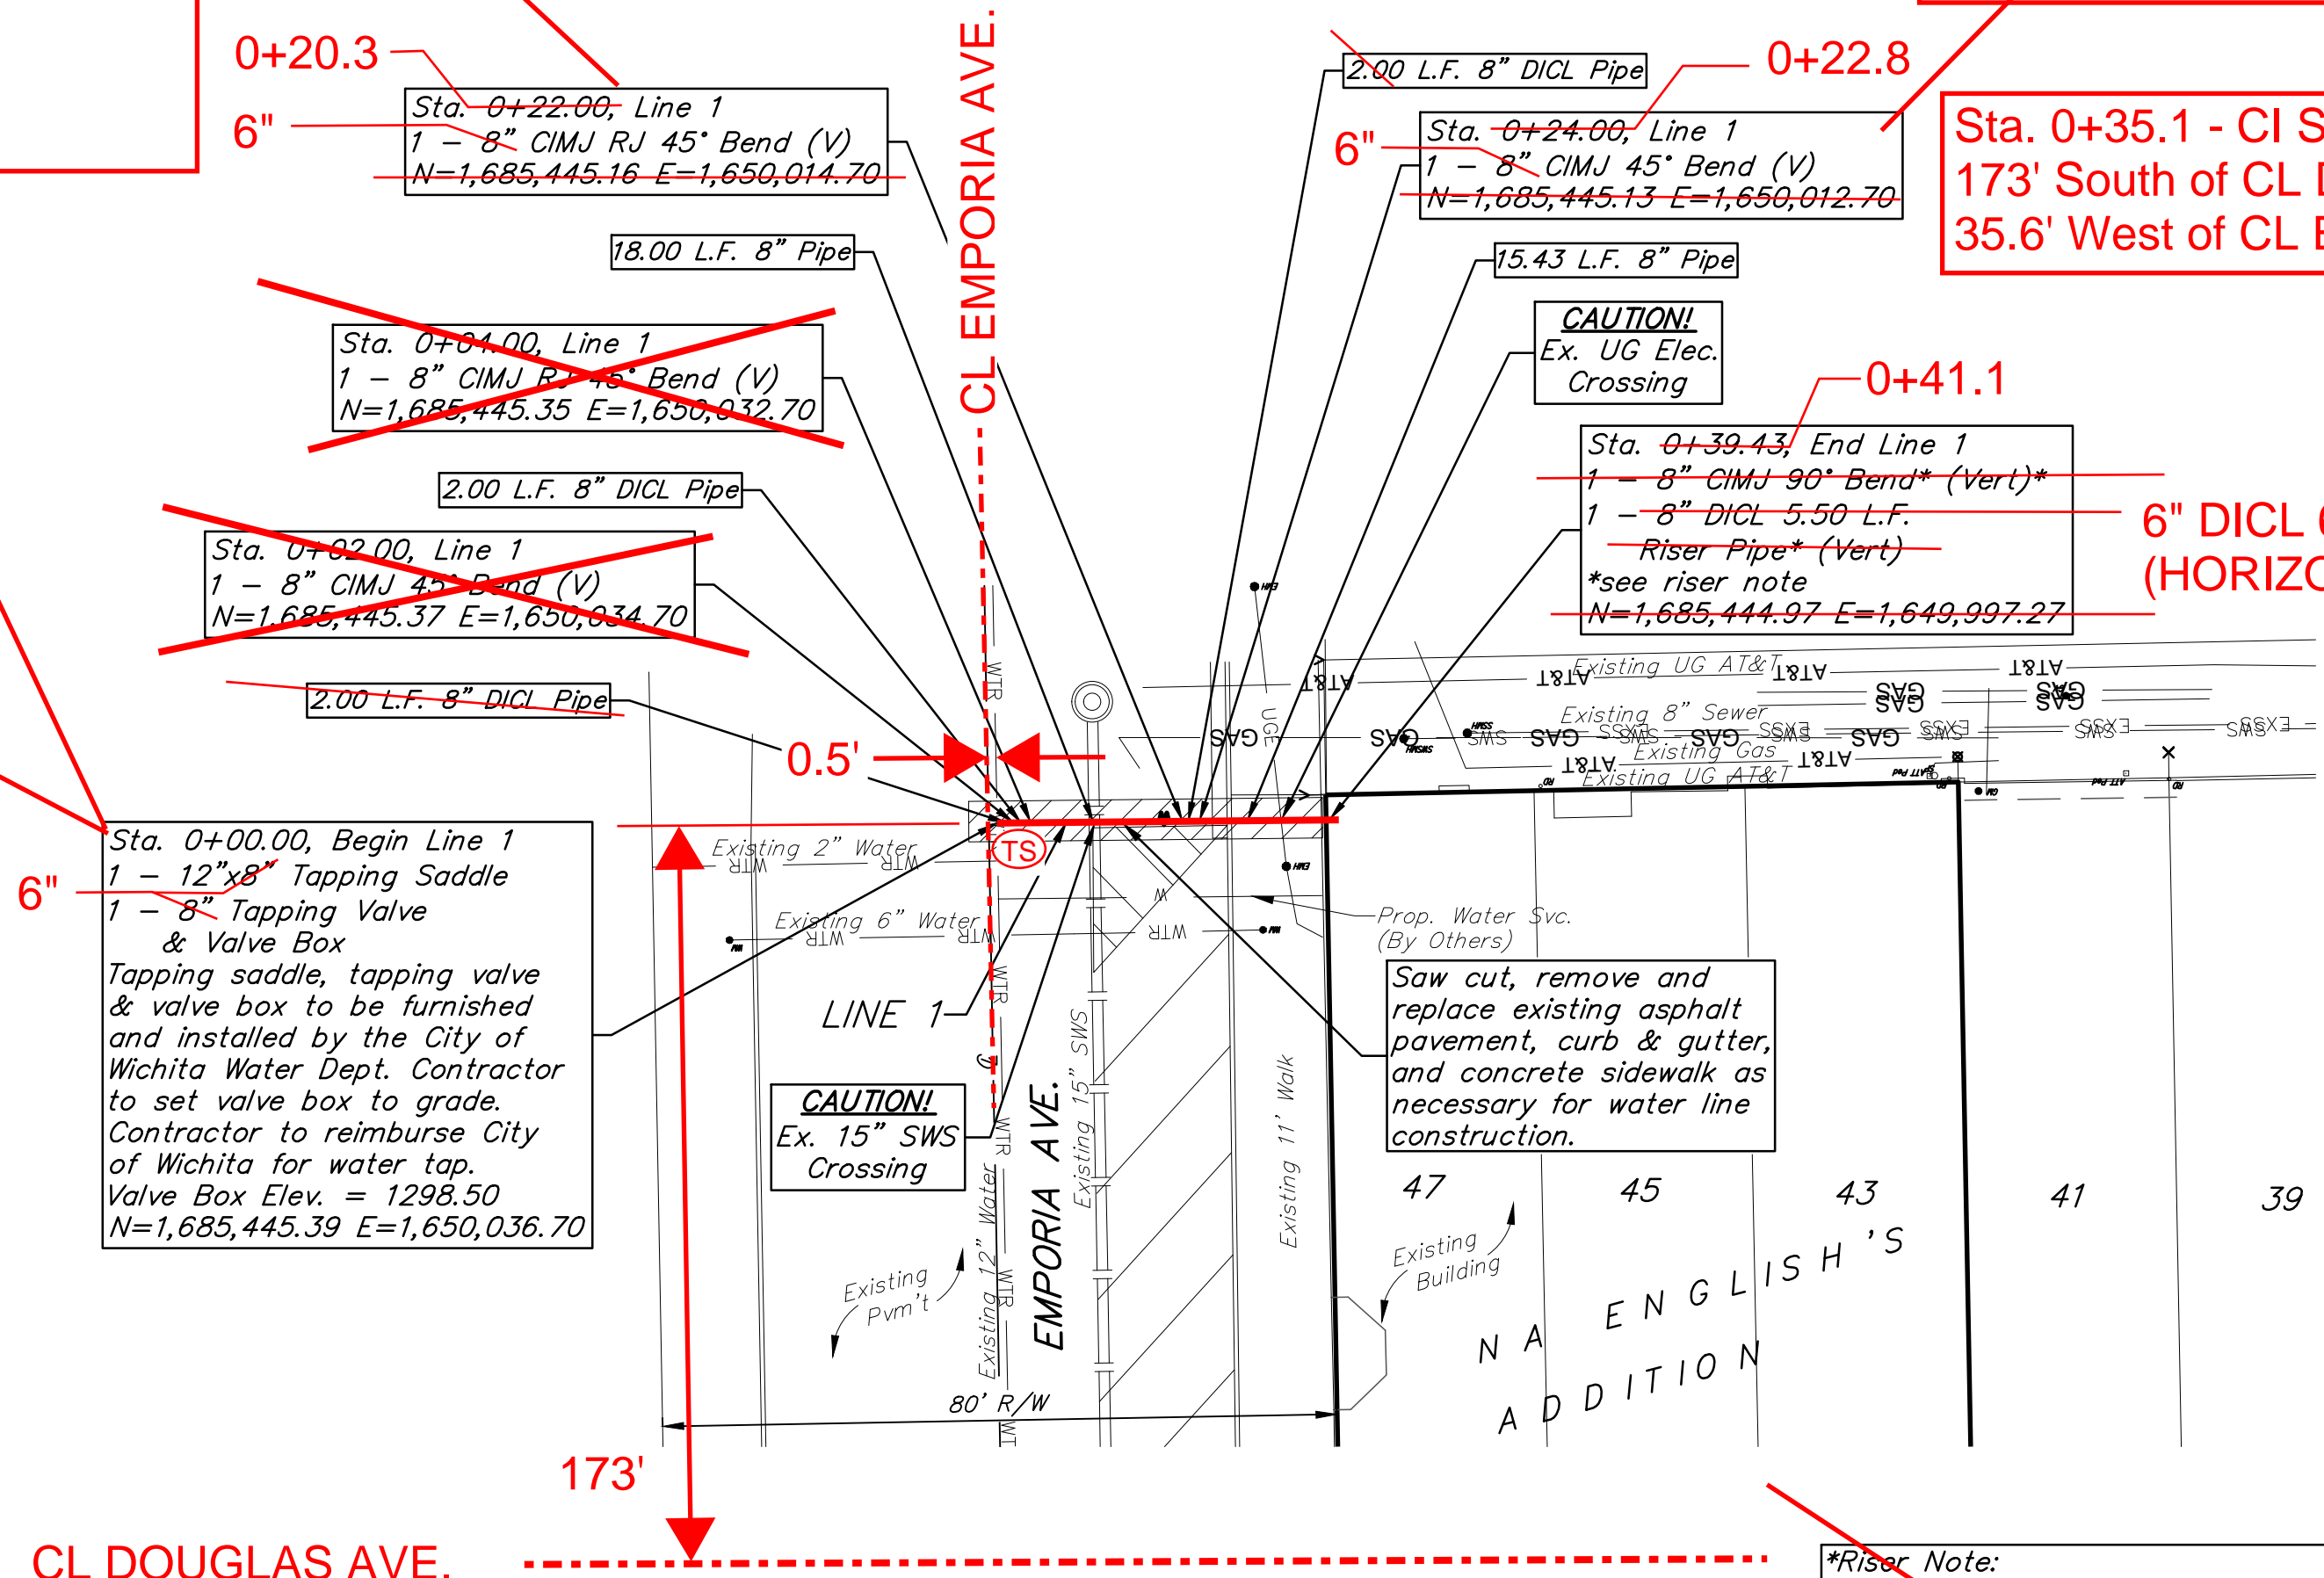

City maintenance of water mains ends before building.


Contractor to verify depth and location of existing utilities. Contractor to relocate any existing utilities as necessary for construction.

Contact utility companies 3 weeks prior to construction to coordinate temporary removal/replacement. Heide Bryan, Evergy, (316) 261-6354

**\*Riser Note:**  
 DICL riser pipe, CIMJ Bend, & DICL horizontal section exiting building foundation wall are to be mega-lugged together and riser is to be extended 12" above Building FFP. Riser location is approximate, building GC is required to locate Riser location per the foundation requirements. Contractor to install blind flange with 2" tap for testing. Remove flange & tap upon acceptance.

1320	Sta. 0+00.00, Begin Line 1	1320
1315	1 - 12" x 8" Tapping Saddle & Valve Box	1315
1310	1 - 8" CIMJ RJ 45° Bend (V)	1310
1305	1 - 8" CIMJ RJ 45° Bend (V)	1305
1300	1 - 8" CIMJ RJ 45° Bend (V)	1300
1295	1 - 8" CIMJ RJ 45° Bend (V)	1295
1290	1 - 8" CIMJ RJ 45° Bend (V)	1290
1285	1 - 8" CIMJ RJ 45° Bend (V)	1285
	1 - 8" DICL 5.50 L.F. Riser Pipe* (Vert)*	
	*see riser note	
	6 LF	

**Top of 12" Water Main is 6.6' below top of pavement.**

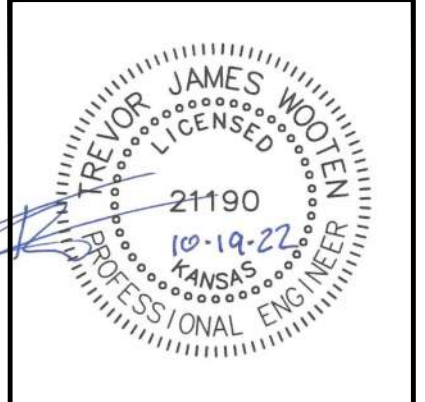


**BAUGHMAN COMPANY**  
 315 Ellis St.  
 Wichita, KS 67211  
 316-262-7271  
 BaughmanCo.com

LEGACY BUILDING  
**LINE 1**  
 WATER DISTRIBUTION SYSTEM  
 PROJECT NUMBER: 22-06-E227  
 DESIGN: TJW DRAWN: TMS  
 DATE: October 20, 2022  
 SHEET 2 OF 11

EROSION CONTROL MEASURE	INSTALL	MAINTAIN	REMOVE
BACK OF CURB PROTECTION (LF)	0	0	0
CONSTRUCTION ENTRANCE (EA)	0	0	0
CURB INLET BARRIER (EA)	0	0	0
DITCH CHECK (EA)	0	0	0
DROP INLET PROTECTION (EA)	0	0	0
EROSION CONTROL (LS)	0	0	0
EROSION CONTROL BERM (LF)	0	0	0
SILT FENCE (LF)	0	0	0
EROSION CONTROL MAT (SY)	0	0	0


QUANTITIES ARE FOR INFORMATION ONLY! CONTRACTOR SHALL VERIFY QUANTITIES PER FINAL BID QUANTITY SHEET.

\* ALL EXISTING BMPs INCLUDING CONSTRUCTION ENTRANCE, SEDIMENT BARRIERS, SILT FENCE, EROSION CONTROL BERM, AND EROSION CONTROL MAT SHALL BE MAINTAINED AND REPAIRED IF NECESSARY. REPLACEMENT OR REMOVAL OF EROSION CONTROL MEASURES TO BE PAID FOR BY L.S. BID ITEM "MAINTAIN EXISTING BMPs"

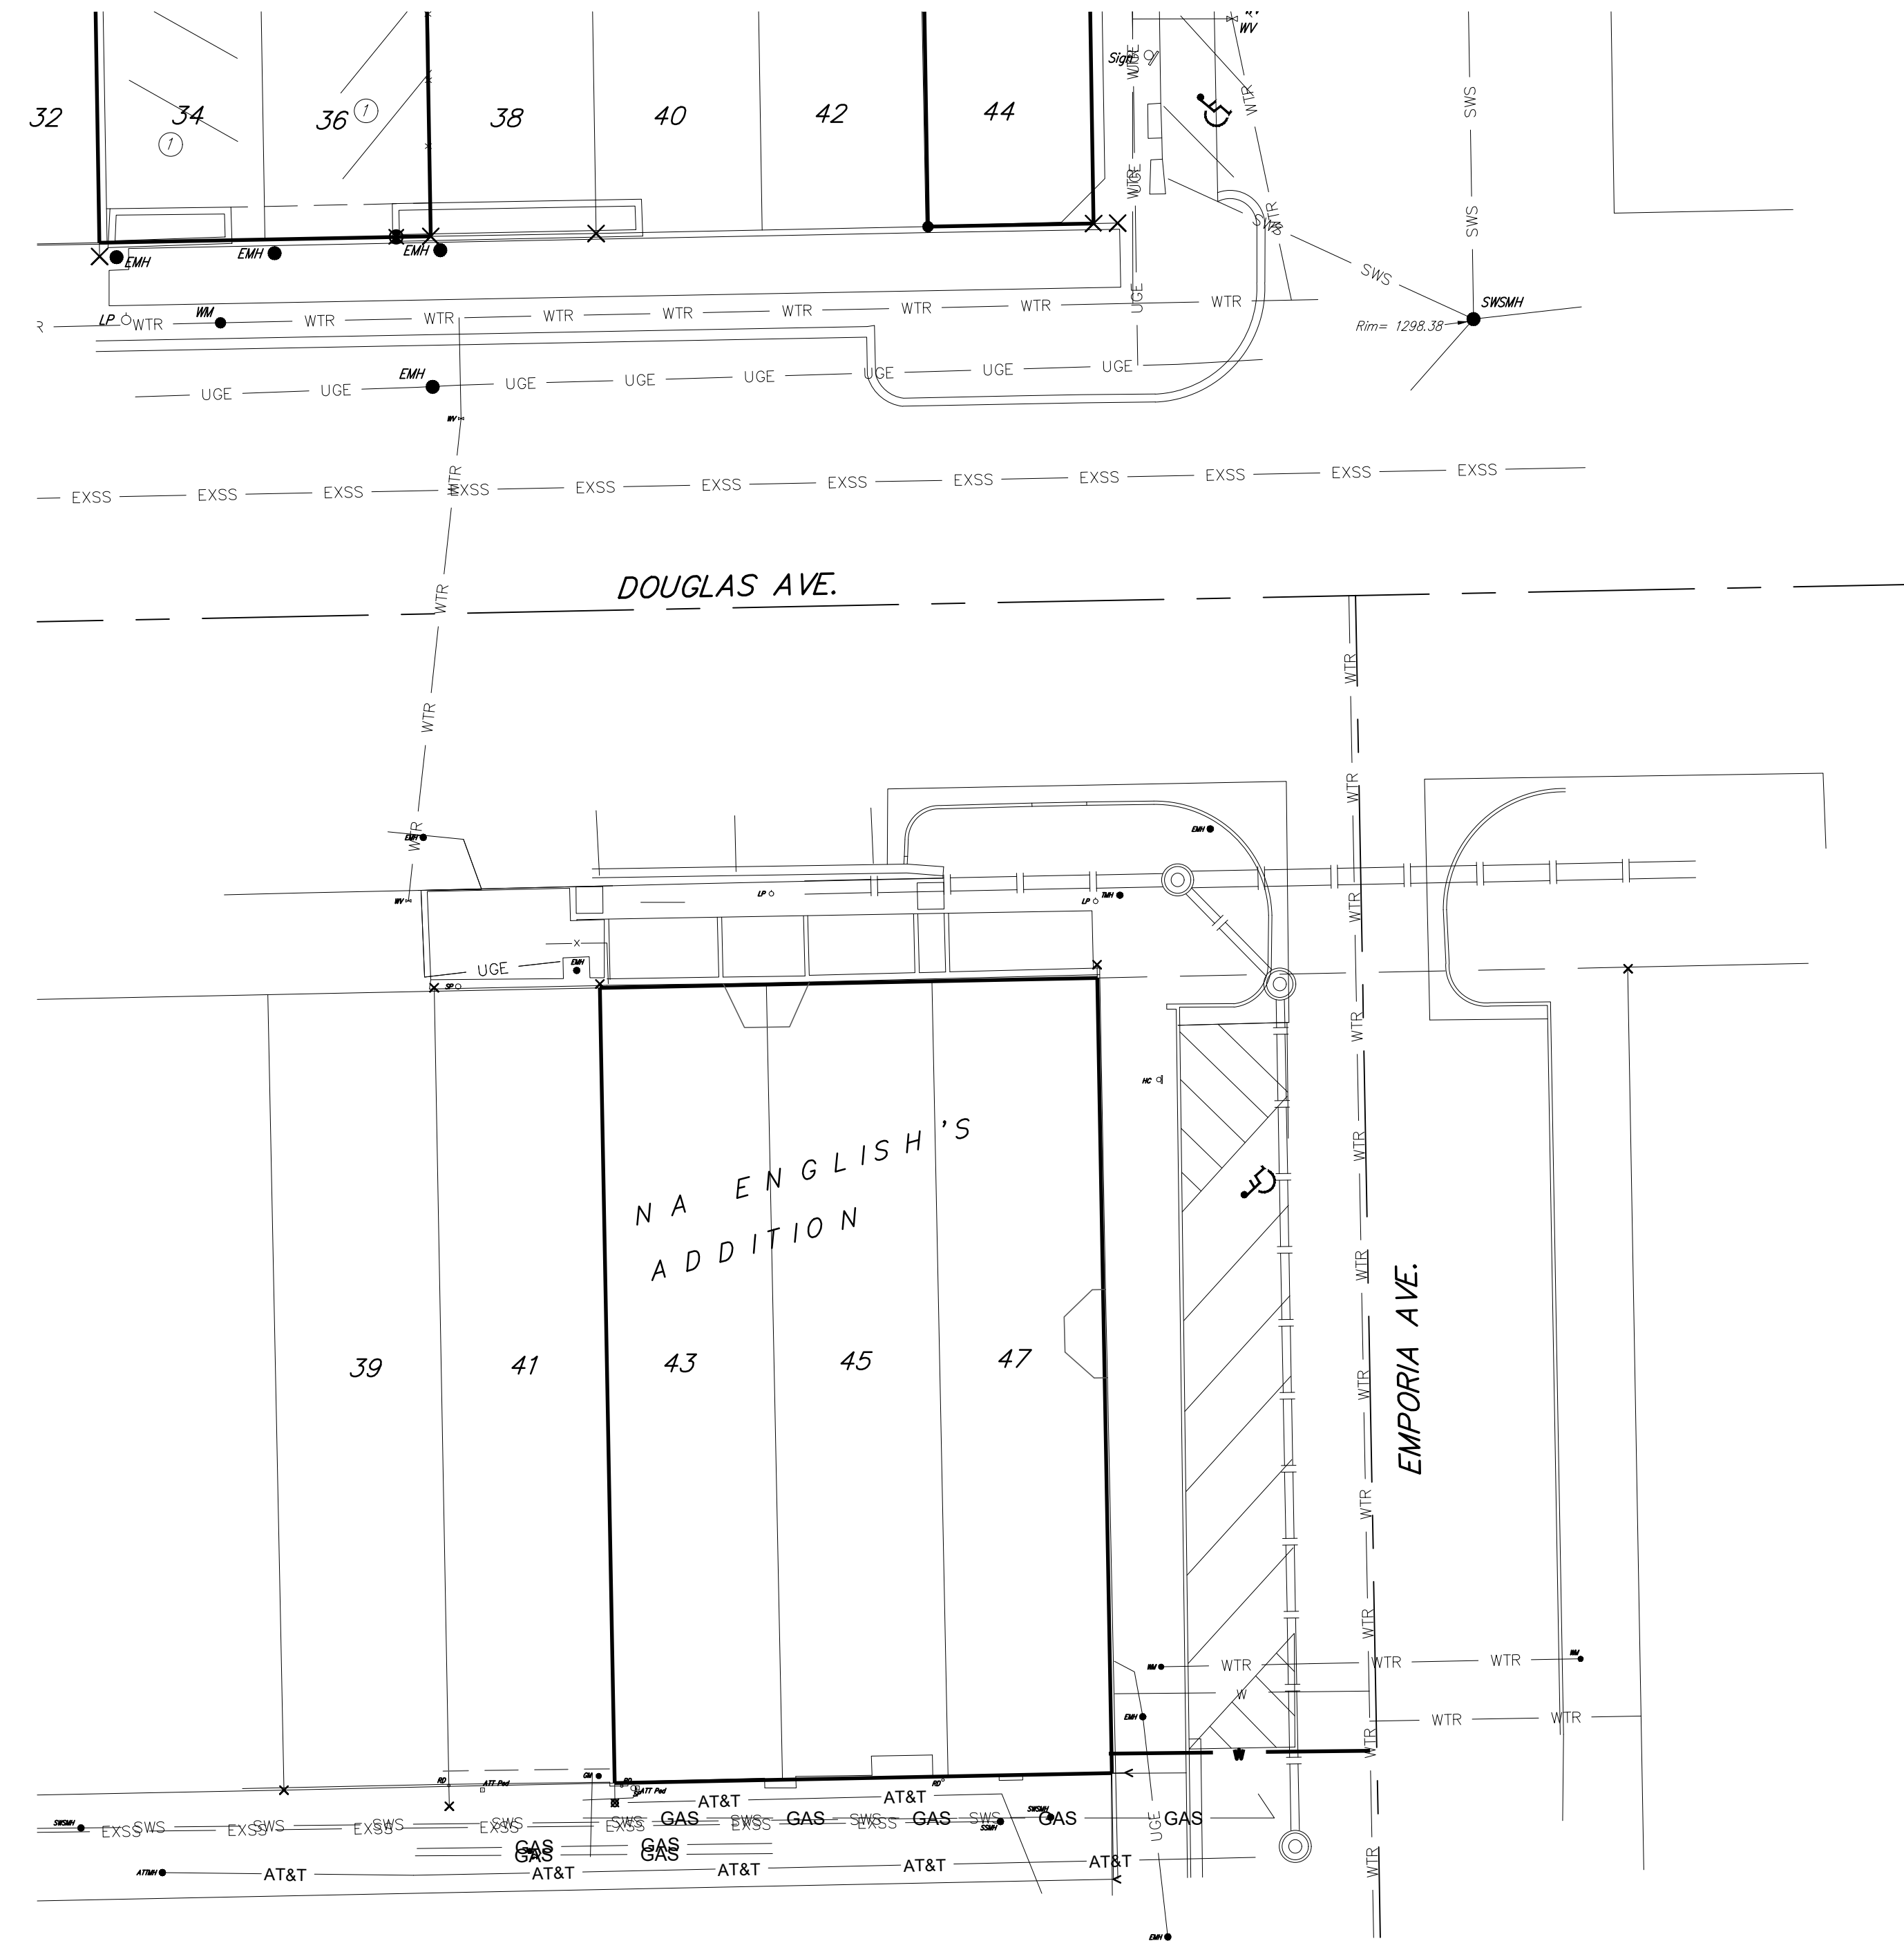

**EROSION CONTROL PLAN LEGEND**

- DROP INLET PROTECTION
- CURB INLET PROTECTION
- DITCH CHECKS
- SILT FENCING
- STRAW WATTLE DITCH CHECKS
- EROSION CONTROL BERM
- BACK OF CURB PROTECTION
- EROSION CONTROL MAT
- TEMPORARY DITCH

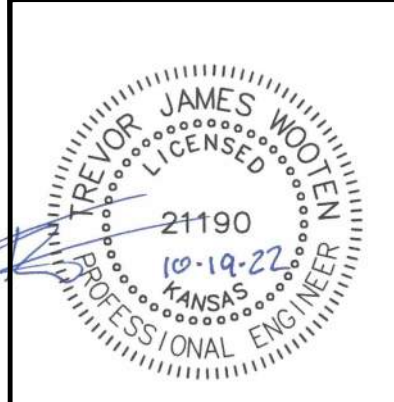

**BAUGHMAN COMPANY**

315 Ellis St.  
Wichita, KS 67211  
316-262-7271  
BaughmanCo.com

LEGACY BUILDING

**EROSION CONTROL PLAN**

WATER DISTRIBUTION SYSTEM

PROJECT NUMBER: 22-06-E227

DESIGN: TJW DRAWN: TMS

DATE: October 20, 2022

SHEET **3** OF **11**

File: E:\Projects\Legacy Building NA English's Add 22-06-E227\Engineering\Phase 1\PPW\PPW.dwg

# AS-BUILT SKETCH of Water Distribution System for LEGACY BUILDING

105 S. Emporia, Wichita, Kansas


COW Project Number: 2022-022632 PPW

Utility Contractor: McCullough Excavation

→ WATER LINE 1 = FIRE SERVICE LINE (6")



No Scale  
Baughman Co.  
L. Powell  
#23-04-EA96  
5-5-2023

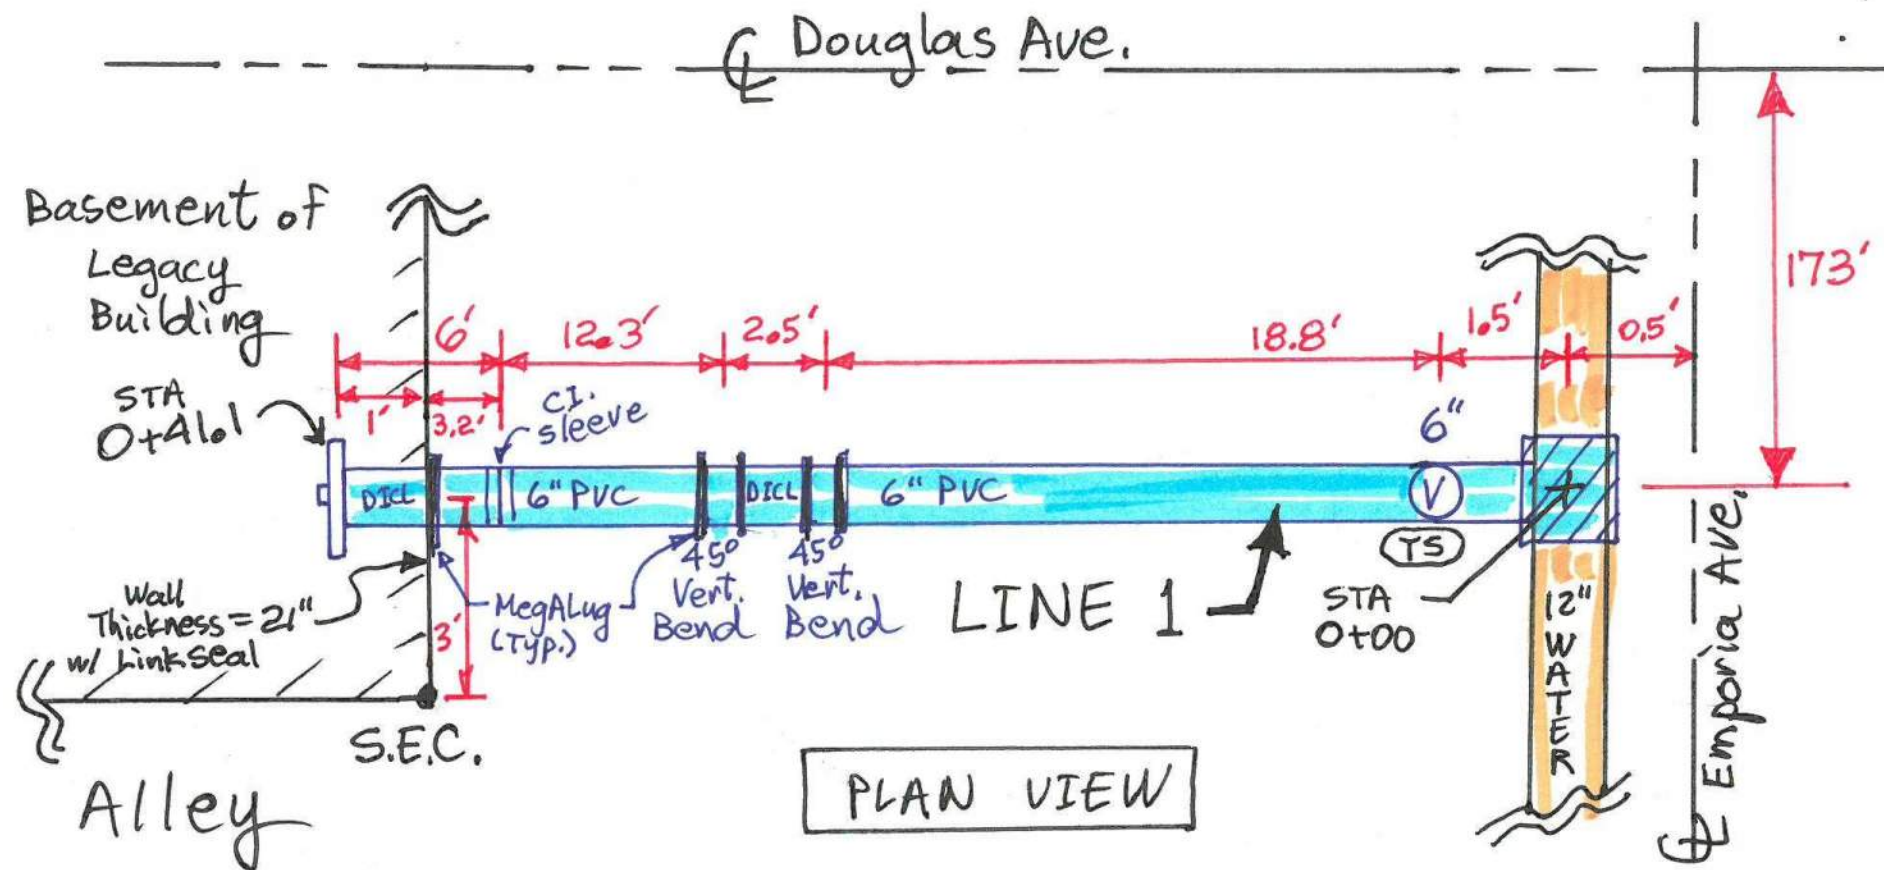

- LEGEND
- (TS) = Test Station
  - (V) = Valve
  - Vert. = Vertical
  - ⌚ = MegAlug
  - C.I. = Cast Iron

NOTES

- Concrete Thrust Blocks installed at TAP saddle and both Vertical 45° Bends.

