


BM #1: "□" Cut on Top of Curb
at West Line of Lot 7, Block A,
Auburn Hills 5th Addition.
Elev. = 207.73 (City Datum)

BM #2: Disc in Back of Curb,
North of Front Corner Common
to Lots 23 and 24, Block D,
Auburn Hills 12th Addition.
Elev. = 191.84 (City Datum)


BM #3: "□" Cut in Middle of Curb
Inlet Top Adjacent to the South
Corner of Lot 15, Block B.
Elev. = 193.65 (City Datum)

Remove trees only as necessary for sanitary sewer construction and only with permission of Developer or Baughman Co. Cost of removal to be incidental to lump sum bid item "Site Clearing & Restoration".

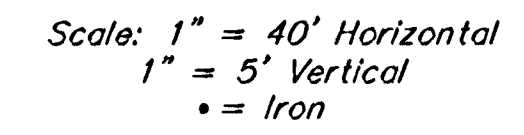

NUMBER	TYPE	LOCATION			FOR INFORMATION ONLY		
		LOT NO.	BLOCK NO.	LINE NO.	DIRECTION\ STATION	APPROXIMATE LENGTH 4" PIPE	
						VERTICAL	HORIZONTAL
22 ✓	8" X 4" Tee	41	A	2	12+48/Rt.	4.0'	13'
23 ✓	8" X 4" Tee	42	A	2	13+33/Rt.	6.0'	13'
24 ✓	4" Stub	43	A	2	14+81.0/Rt.	9.5'	13'

NOTE: Vertical Riser Pipe shall be extended to 2' minimum above ground water elevation and 4' maximum below proposed ground elevation.

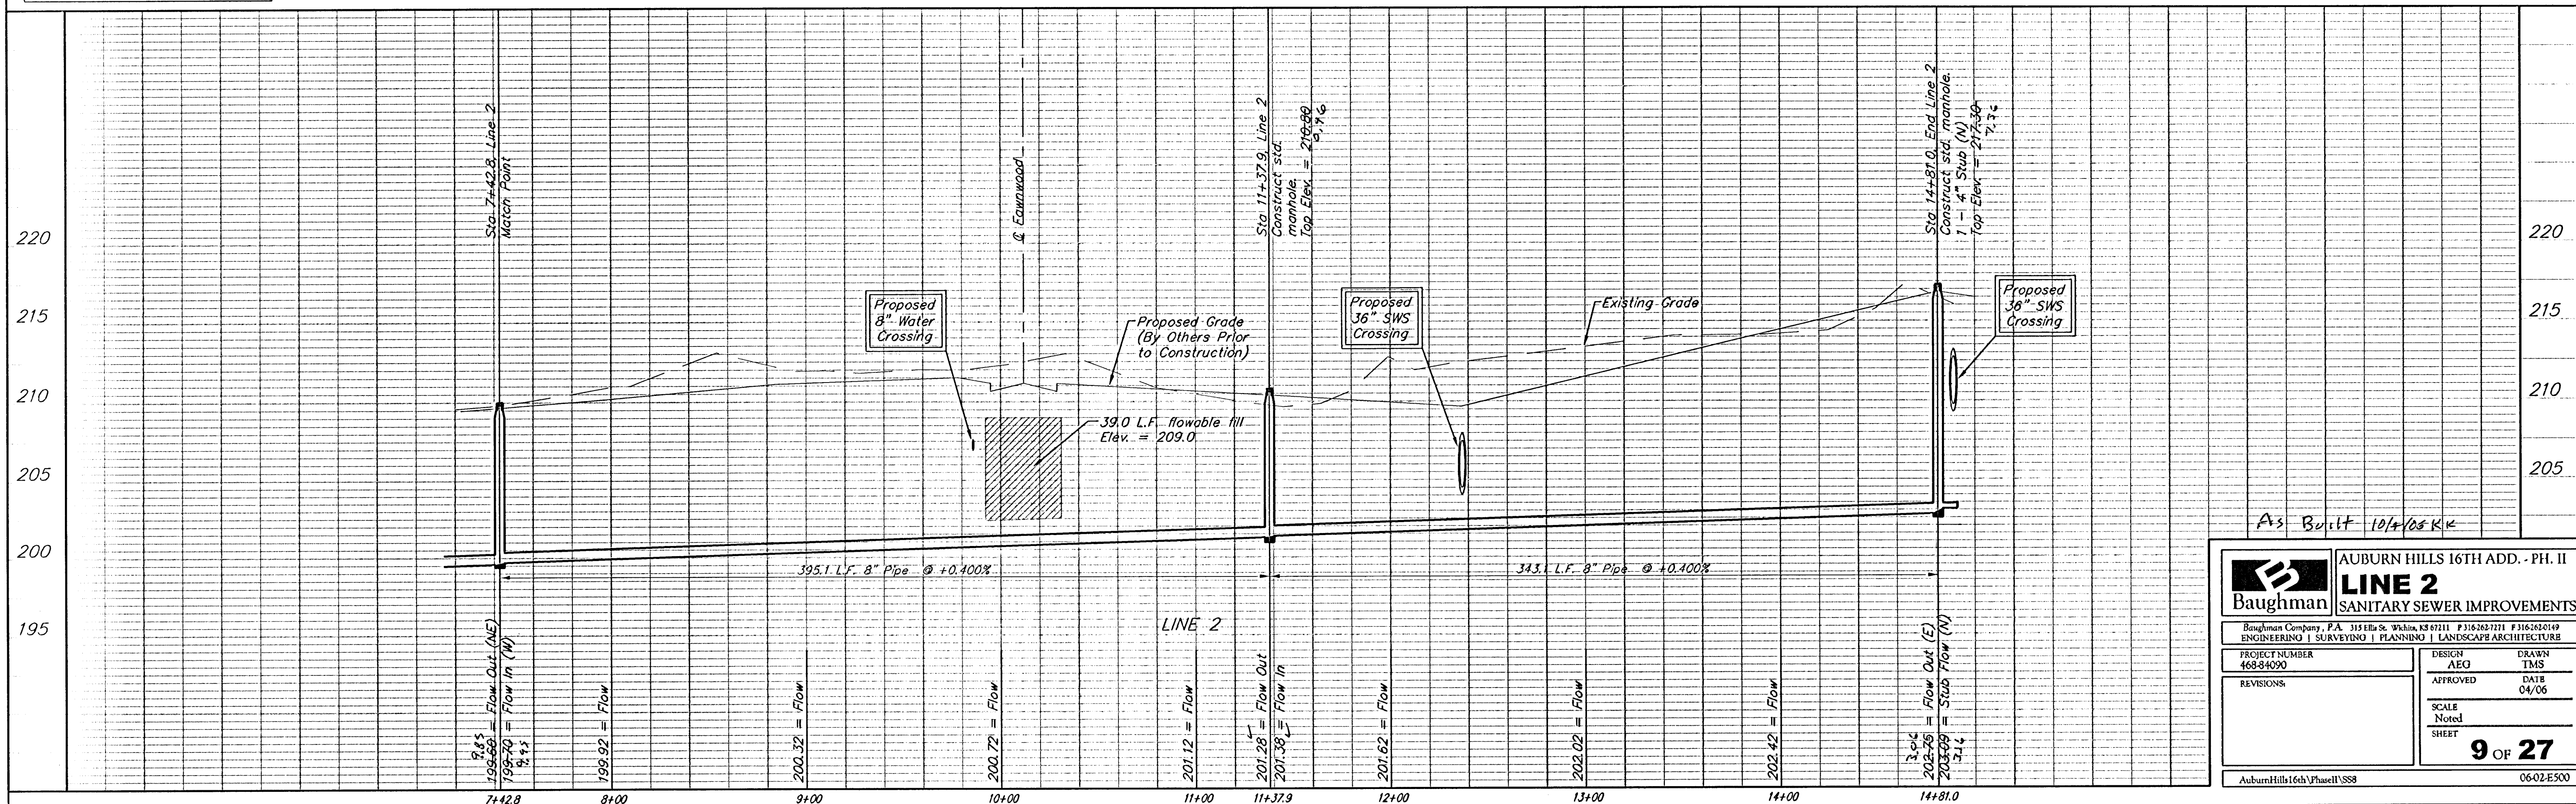

As Built 10/4/05 KK



AUBURN HILLS 16TH ADD. - PH. II
LINE 2
SANITARY SEWER IMPROVEMENTS

Baughman Company, P.A. 315 Ellis St. Wichita, KS 67211 P 316-262-7271 F 316-262-0149
ENGINEERING | SURVEYING | PLANNING | LANDSCAPE ARCHITECTURE

PROJECT NUMBER
468-84090

DESIGN AEG	DRAWN TMS
---------------	--------------

APPROVED	DATE
	04/06

SCALE
Noted

SHEET

9 OF 27

AuburnHills16th\PhaseII\SS8

06-02-E500