




SANITARY SEWER PLANS  
**FOX RIDGE**  
PHASE 9

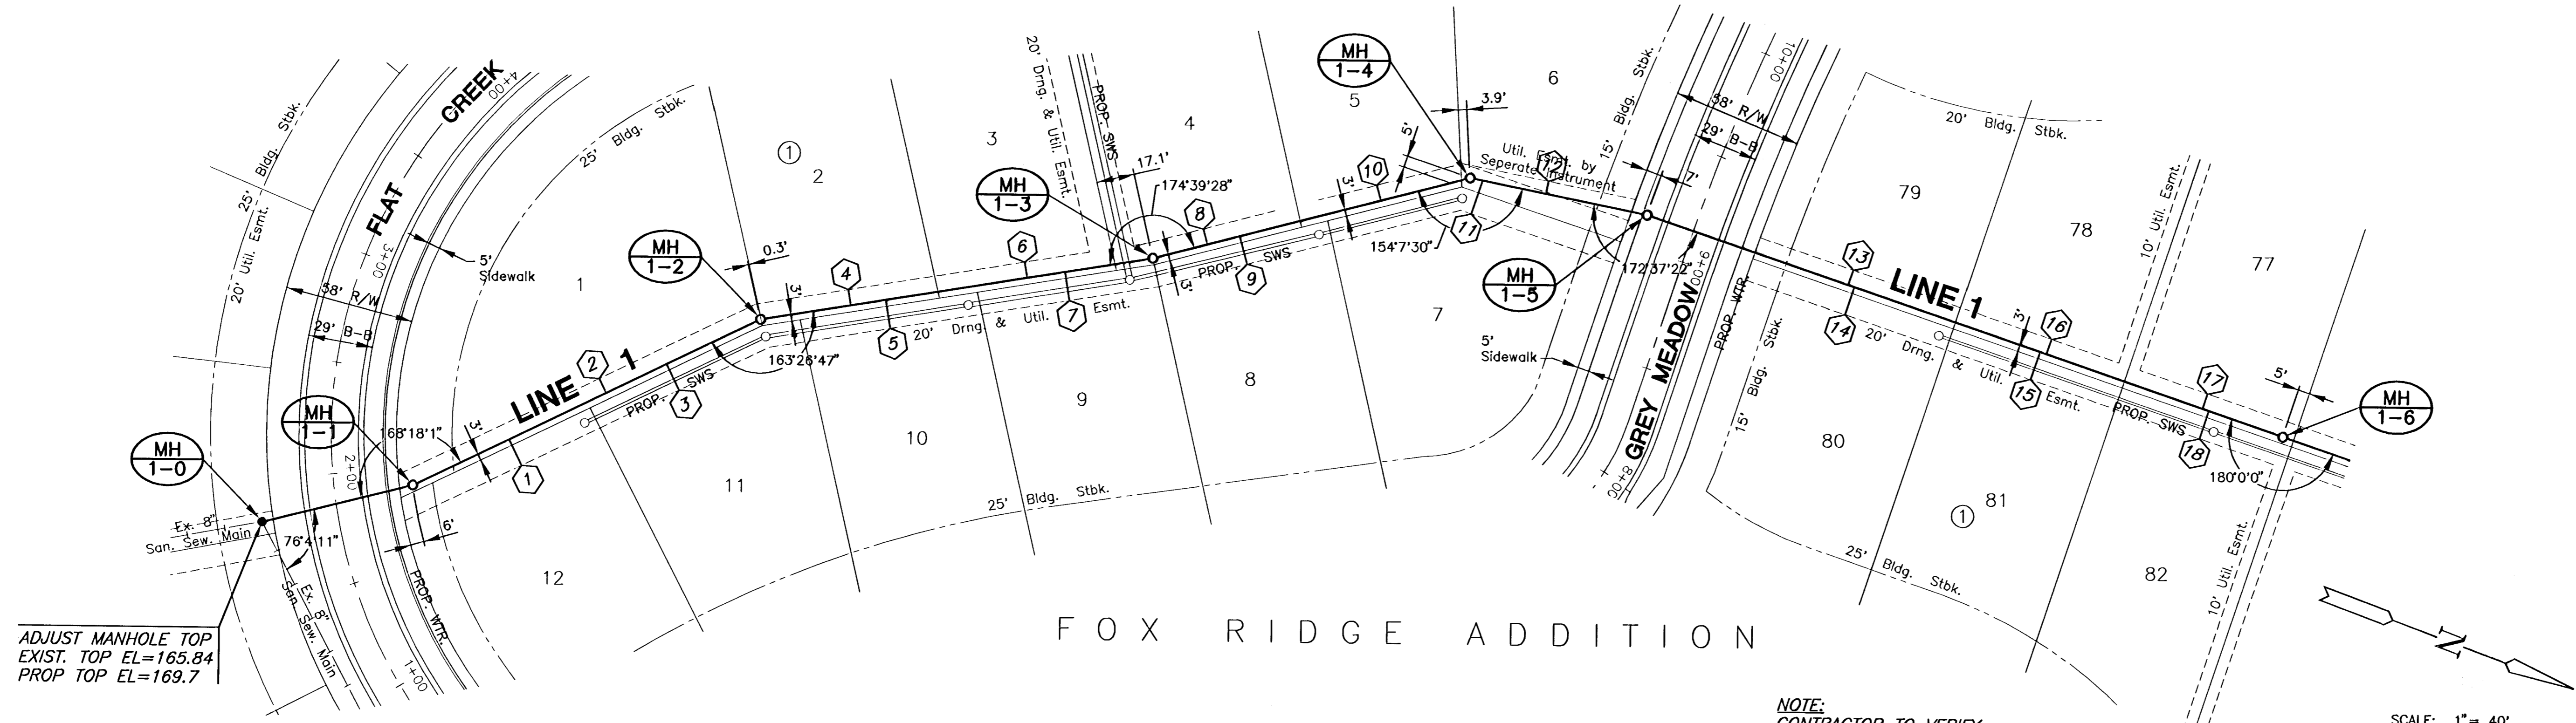

ADJUST MANHOLE TOP  
EXIST. TOP EL=165.84  
PROP. TOP EL=169.7

**PLAN LINE 1**

NOTE:  
CONTRACTOR TO VERIFY  
LOCATION AND ELEVATION OF  
EXISTING UTILITIES PRIOR TO  
CONSTRUCTION.

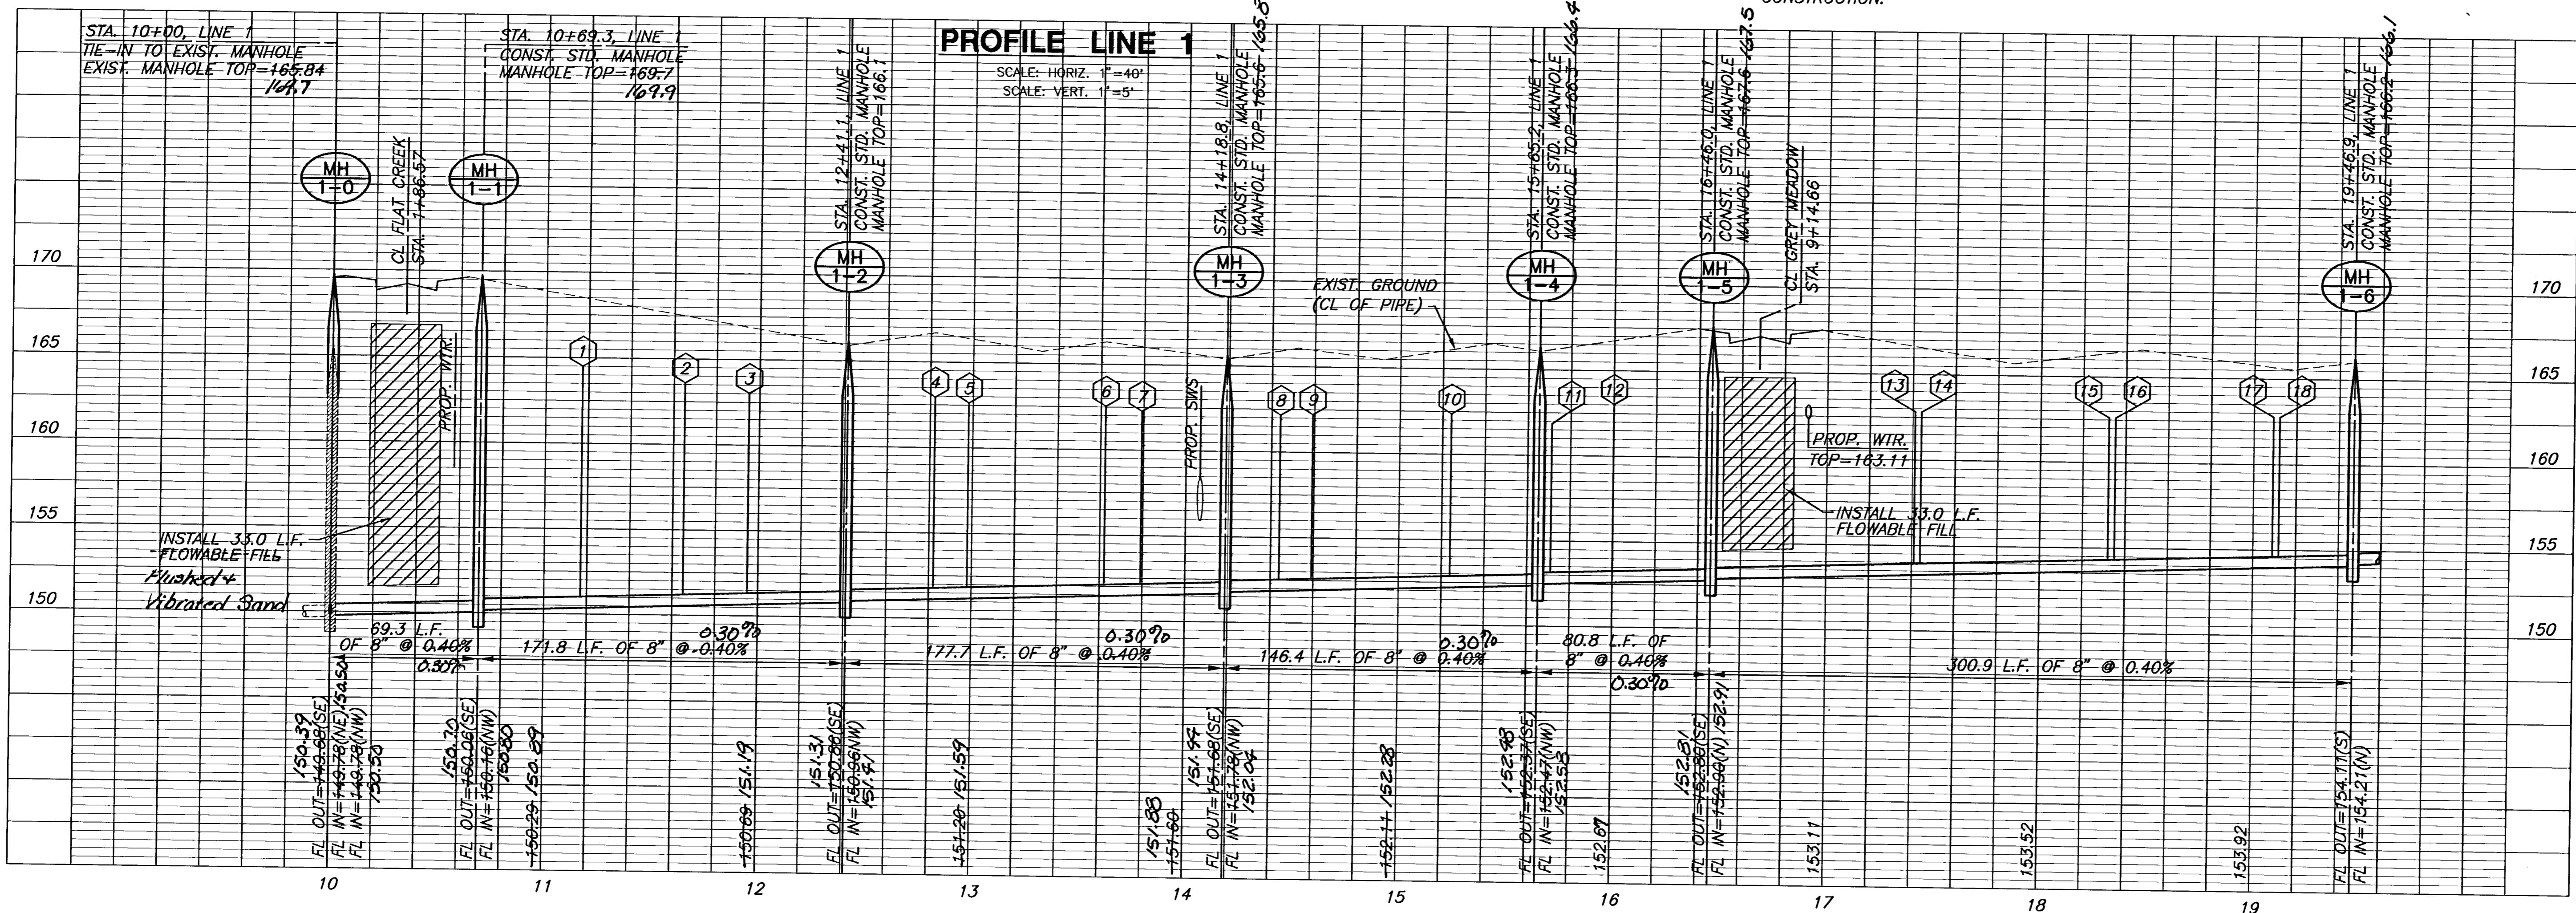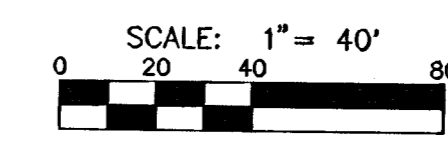

**PROFILE LINE 1**

**LINE 1**  
SHEET TITLE  
468-84202  
PROJECT NUMBER

DFL  
DESIGN BY  
MKEC  
DRAWN BY  
GJA  
CHECKED BY

ISSUED  
JULY 2006  
REVISED

SHEET NO.  
**4 of 14**