

SANITARY SEWER PLANS  
**FOX RIDGE**  
PHASE 9

**LINE 5**

SHEET TITLE  
PROJECT NUMBER  
**468-84202**


DESIGN BY  
**DFL**  
DRAWN BY  
**MKEC**  
CHECKED BY  
**GJA**

ISSUED  
**JULY 2006**

REVISED



SHEET NO.

**8 of 14**

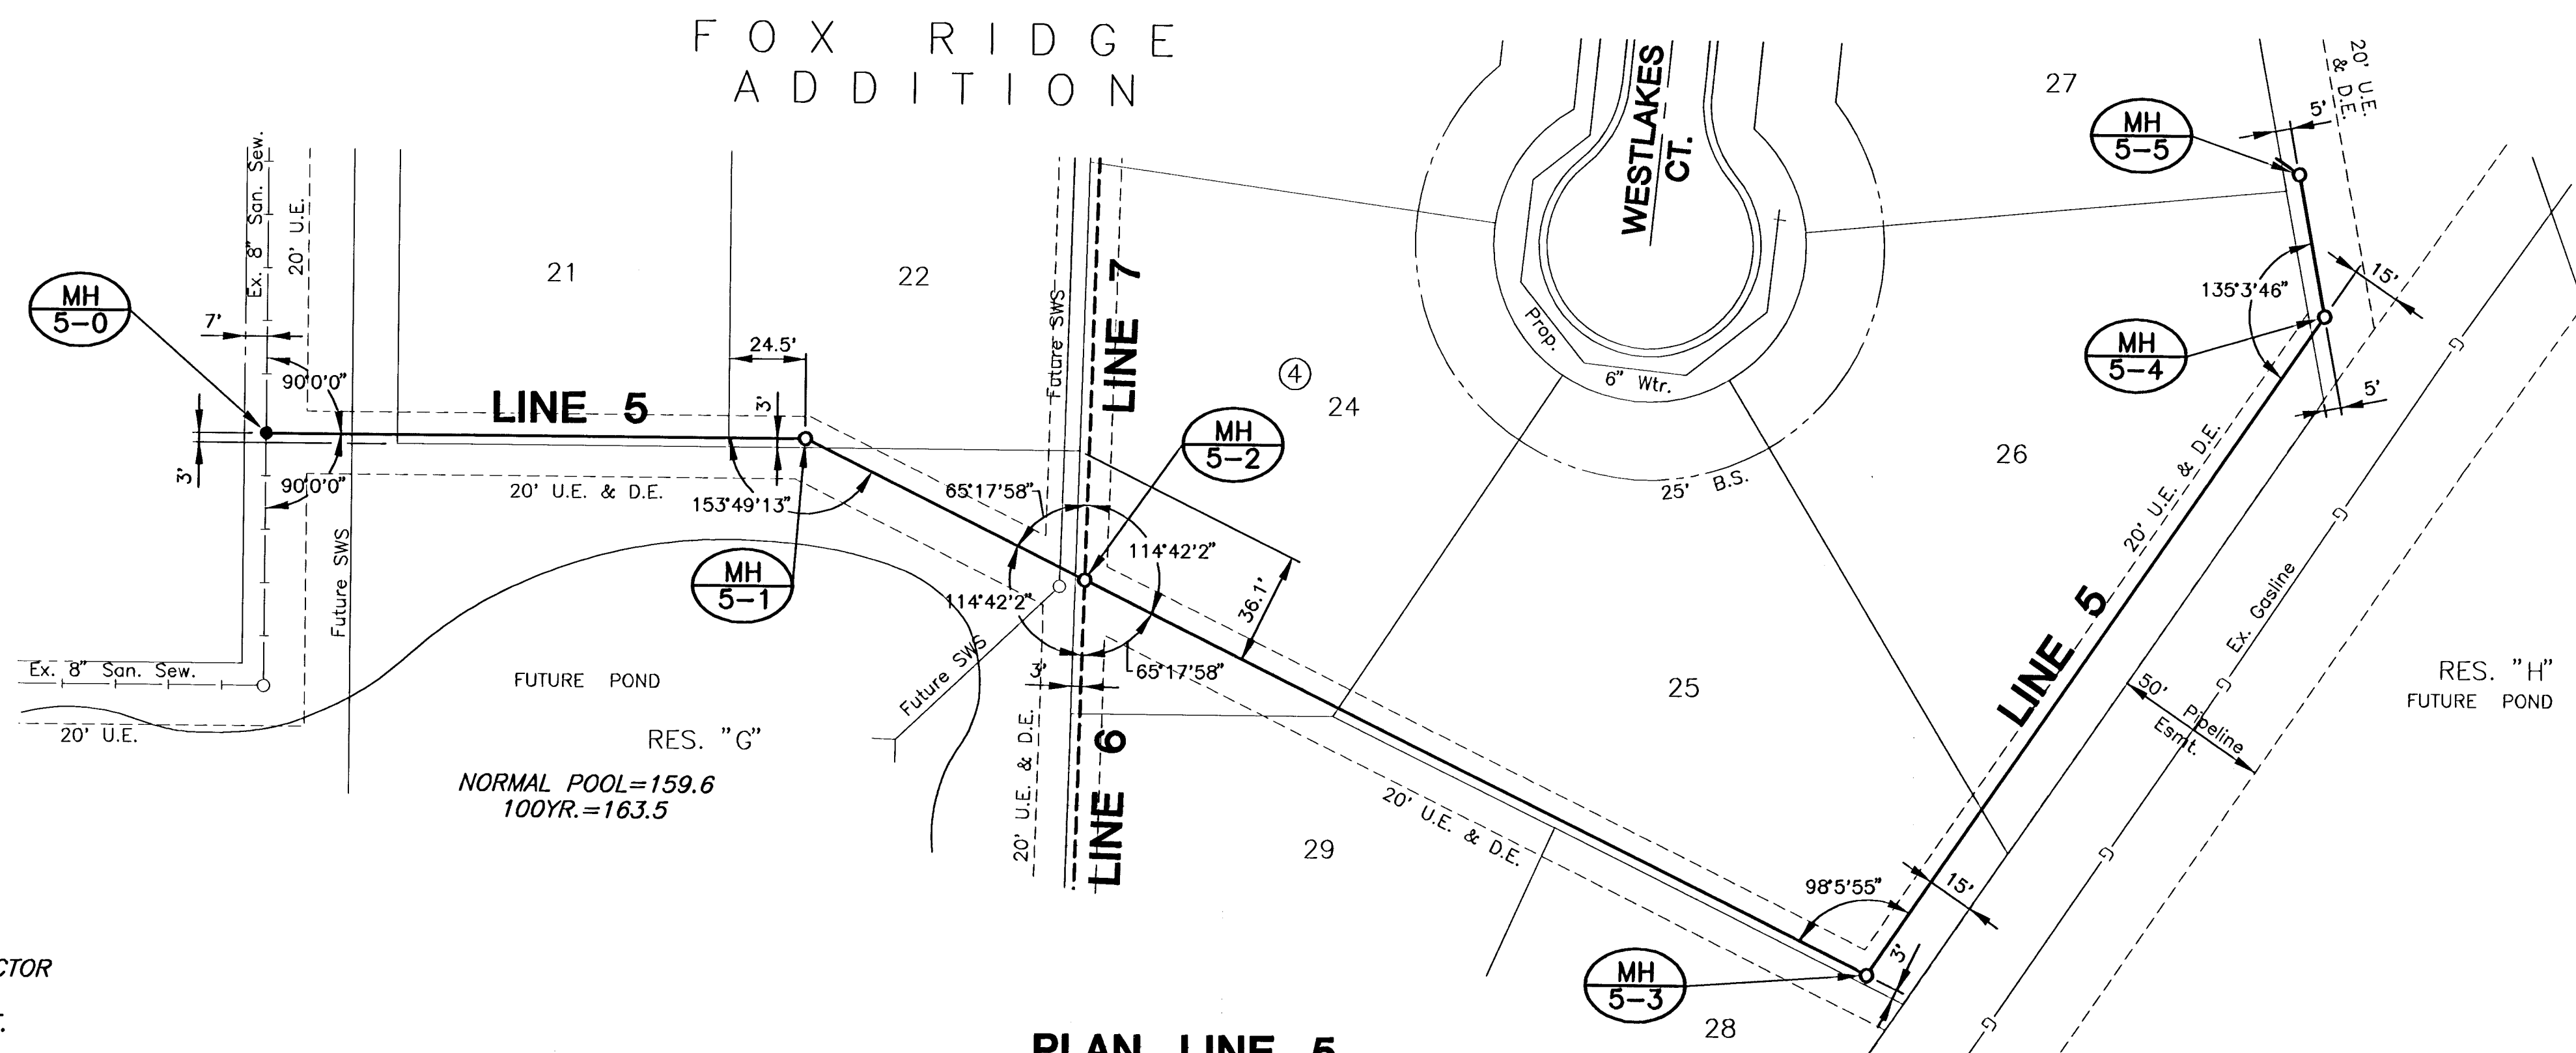

**PLAN LINE 5**

NOTE:  
LINES 5 THRU 10 CONTRACTOR  
TO PROVIDE 18" COLLAR  
ADJUSTMENT FOR MANHOLE.

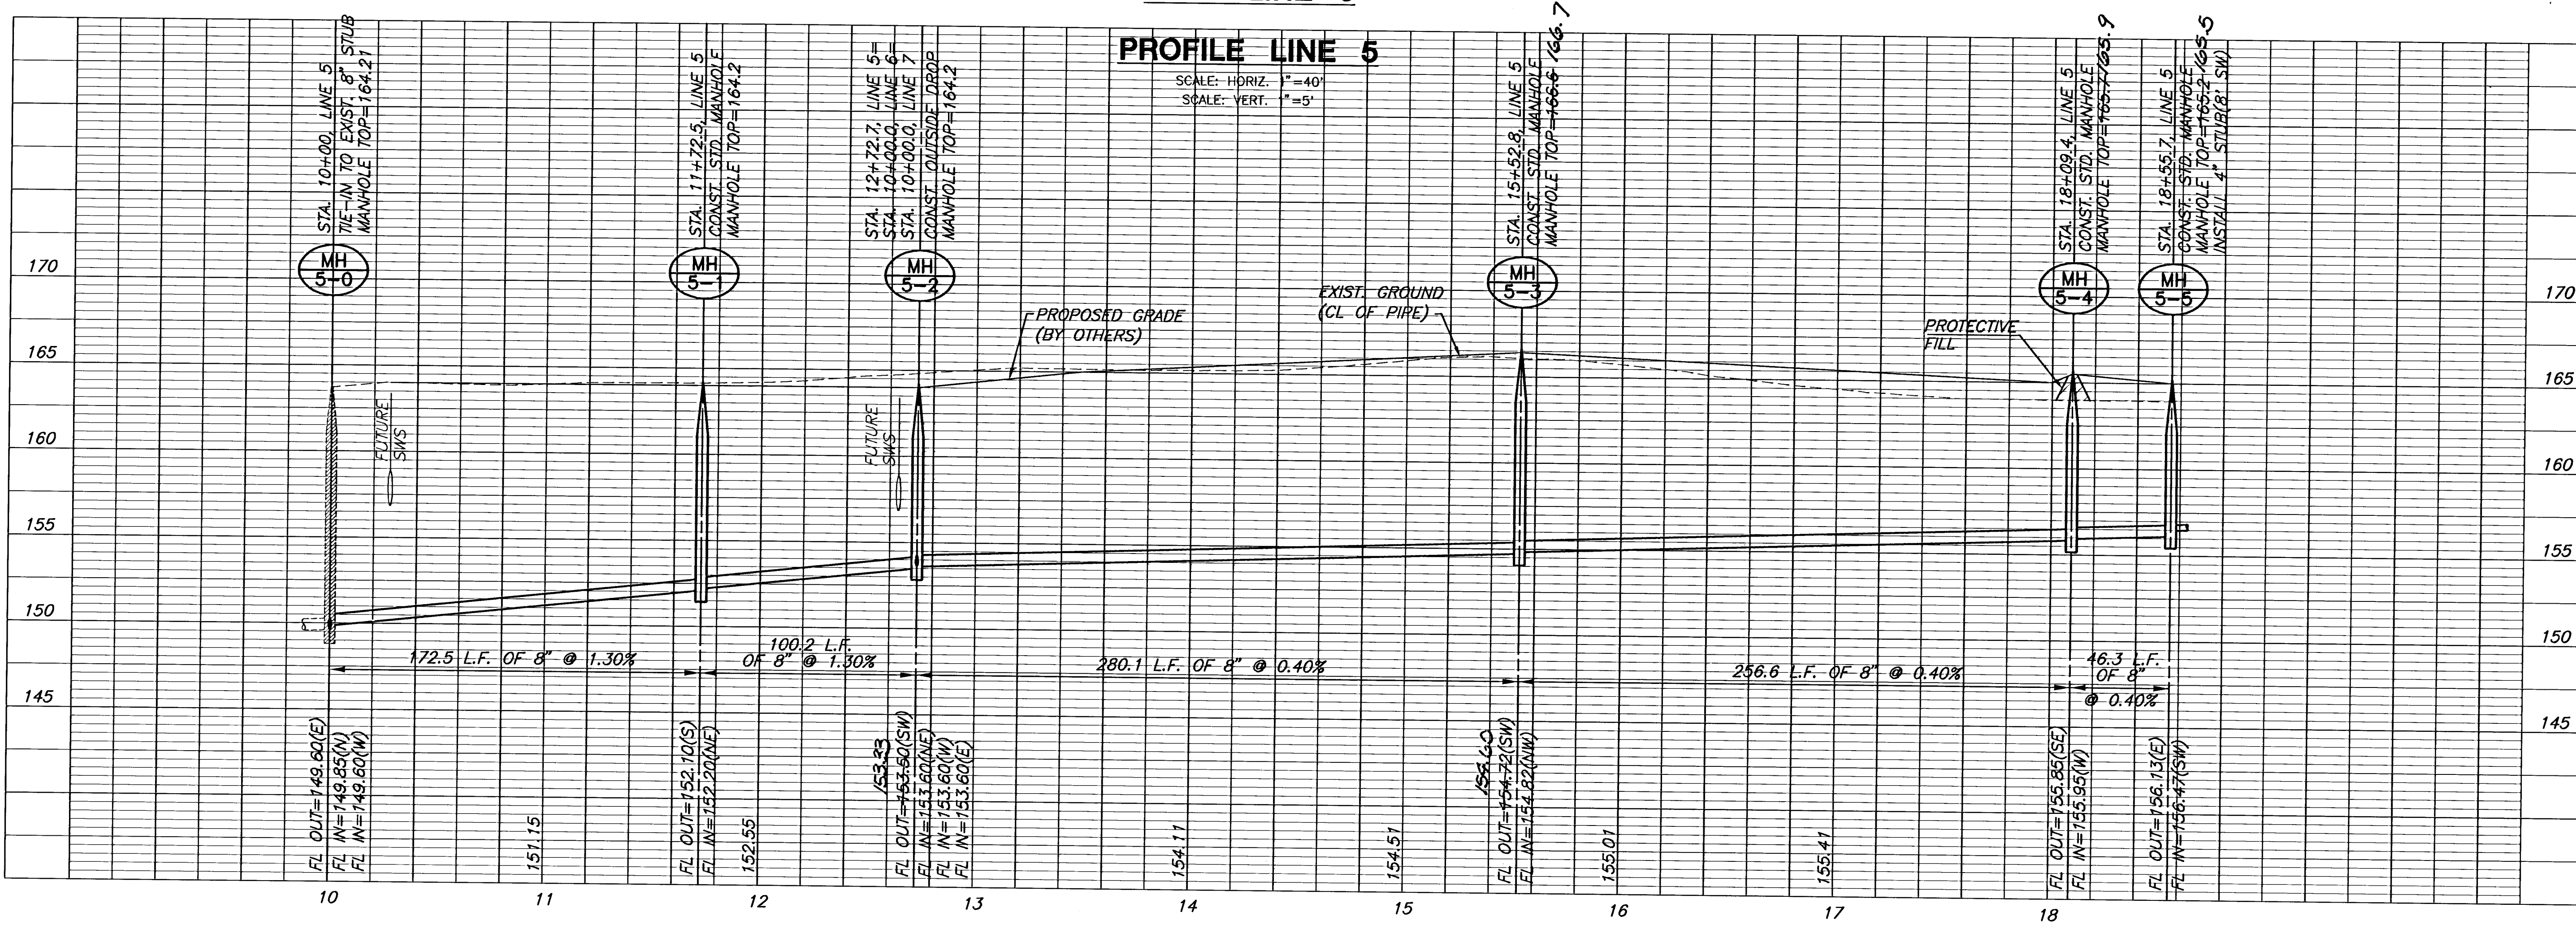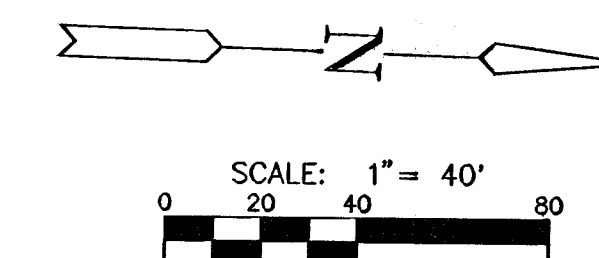

PLOT DATE: MONROVIA, JULY 20, 2006 @ 09:03AM

G:\CIVIL\99118\wg\SAN\PH9\99118B5.dwg