



SANITARY SEWER PLANS
FOX RIDGE
PHASE 9

LINE 6
SHEET TITLE
468-84202
PROJECT NUMBER

DFL
DESIGN BY
MKEC
DRAWN BY
GJA
CHECKED BY

ISSUED
JULY 2006
REVISED

SHEET NO.
9 of 14

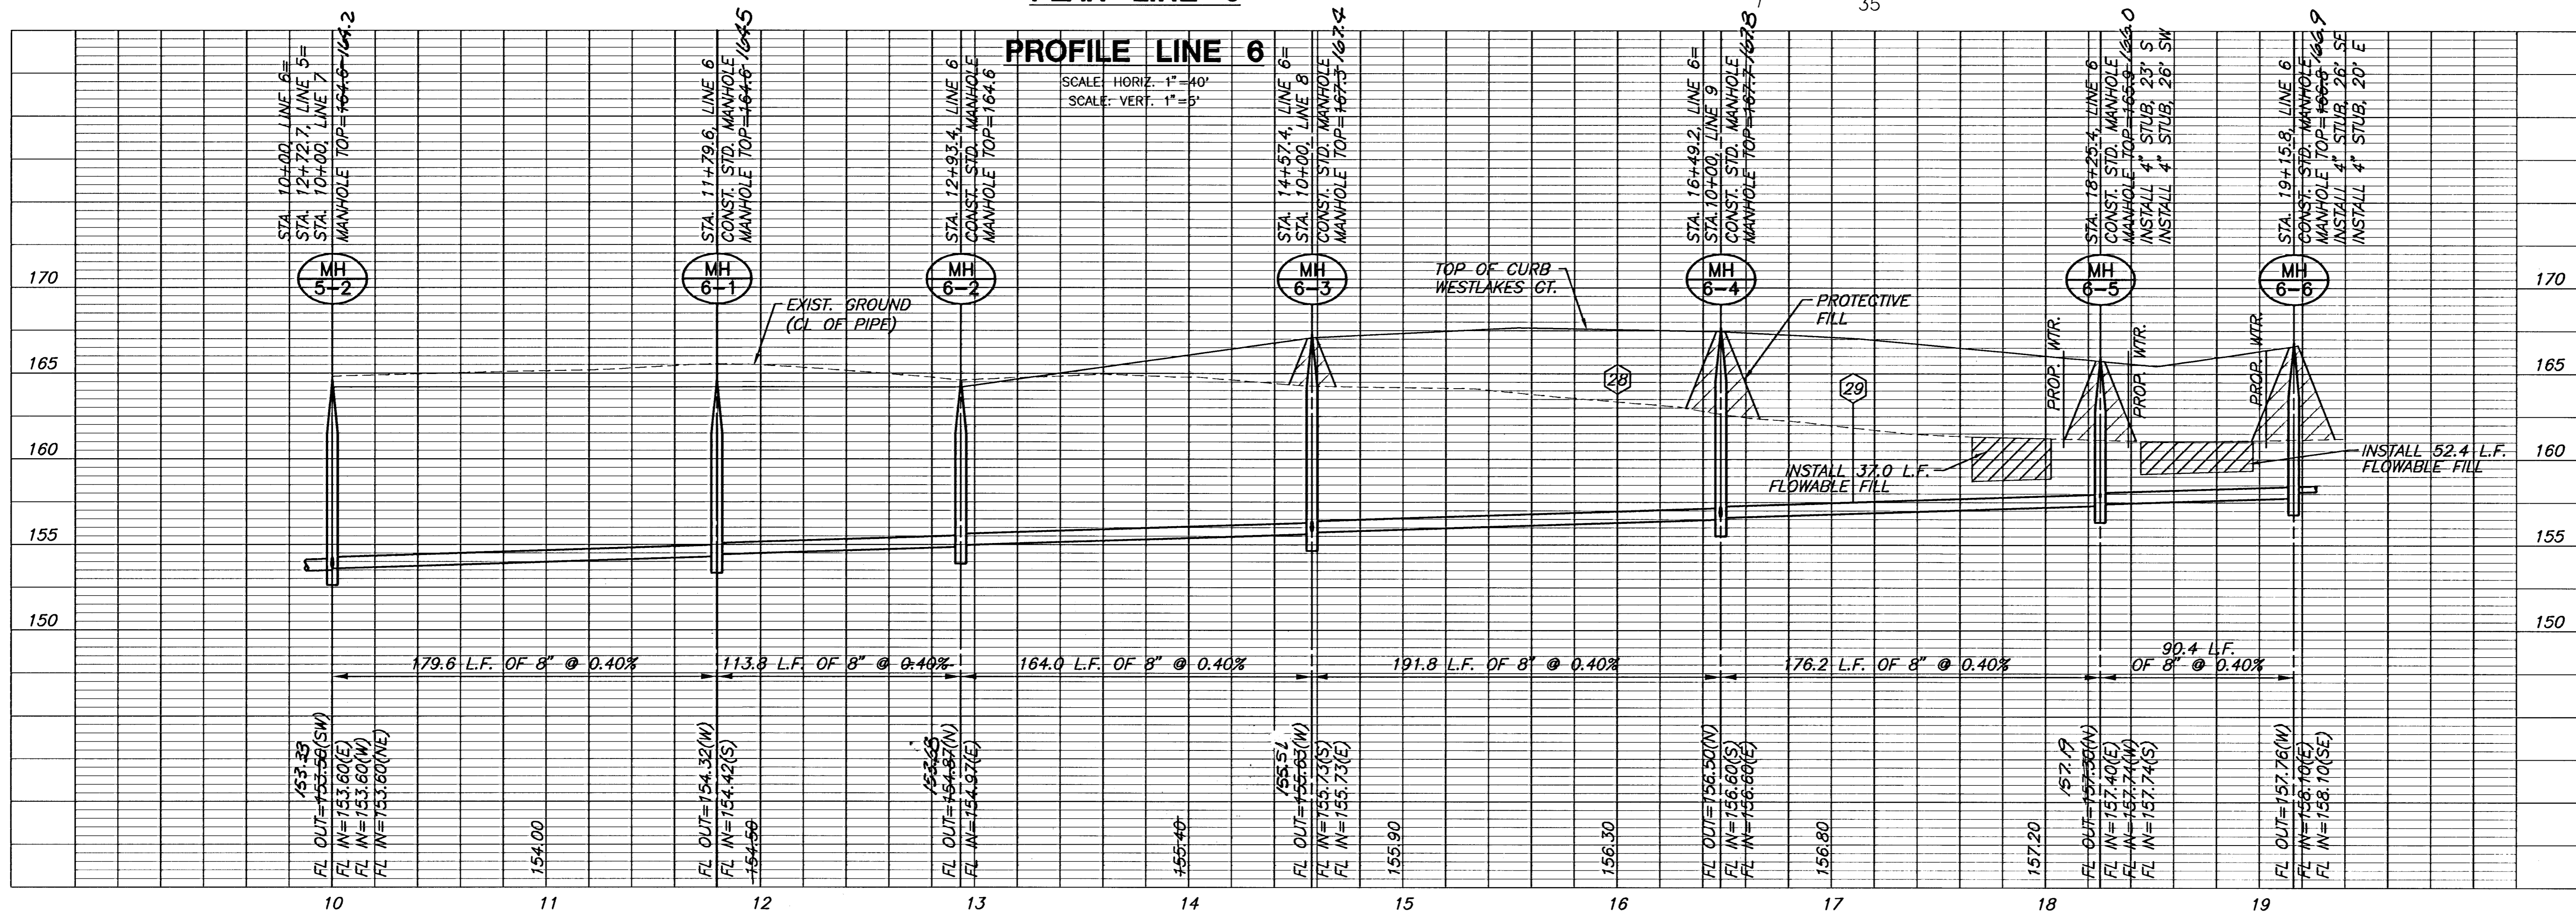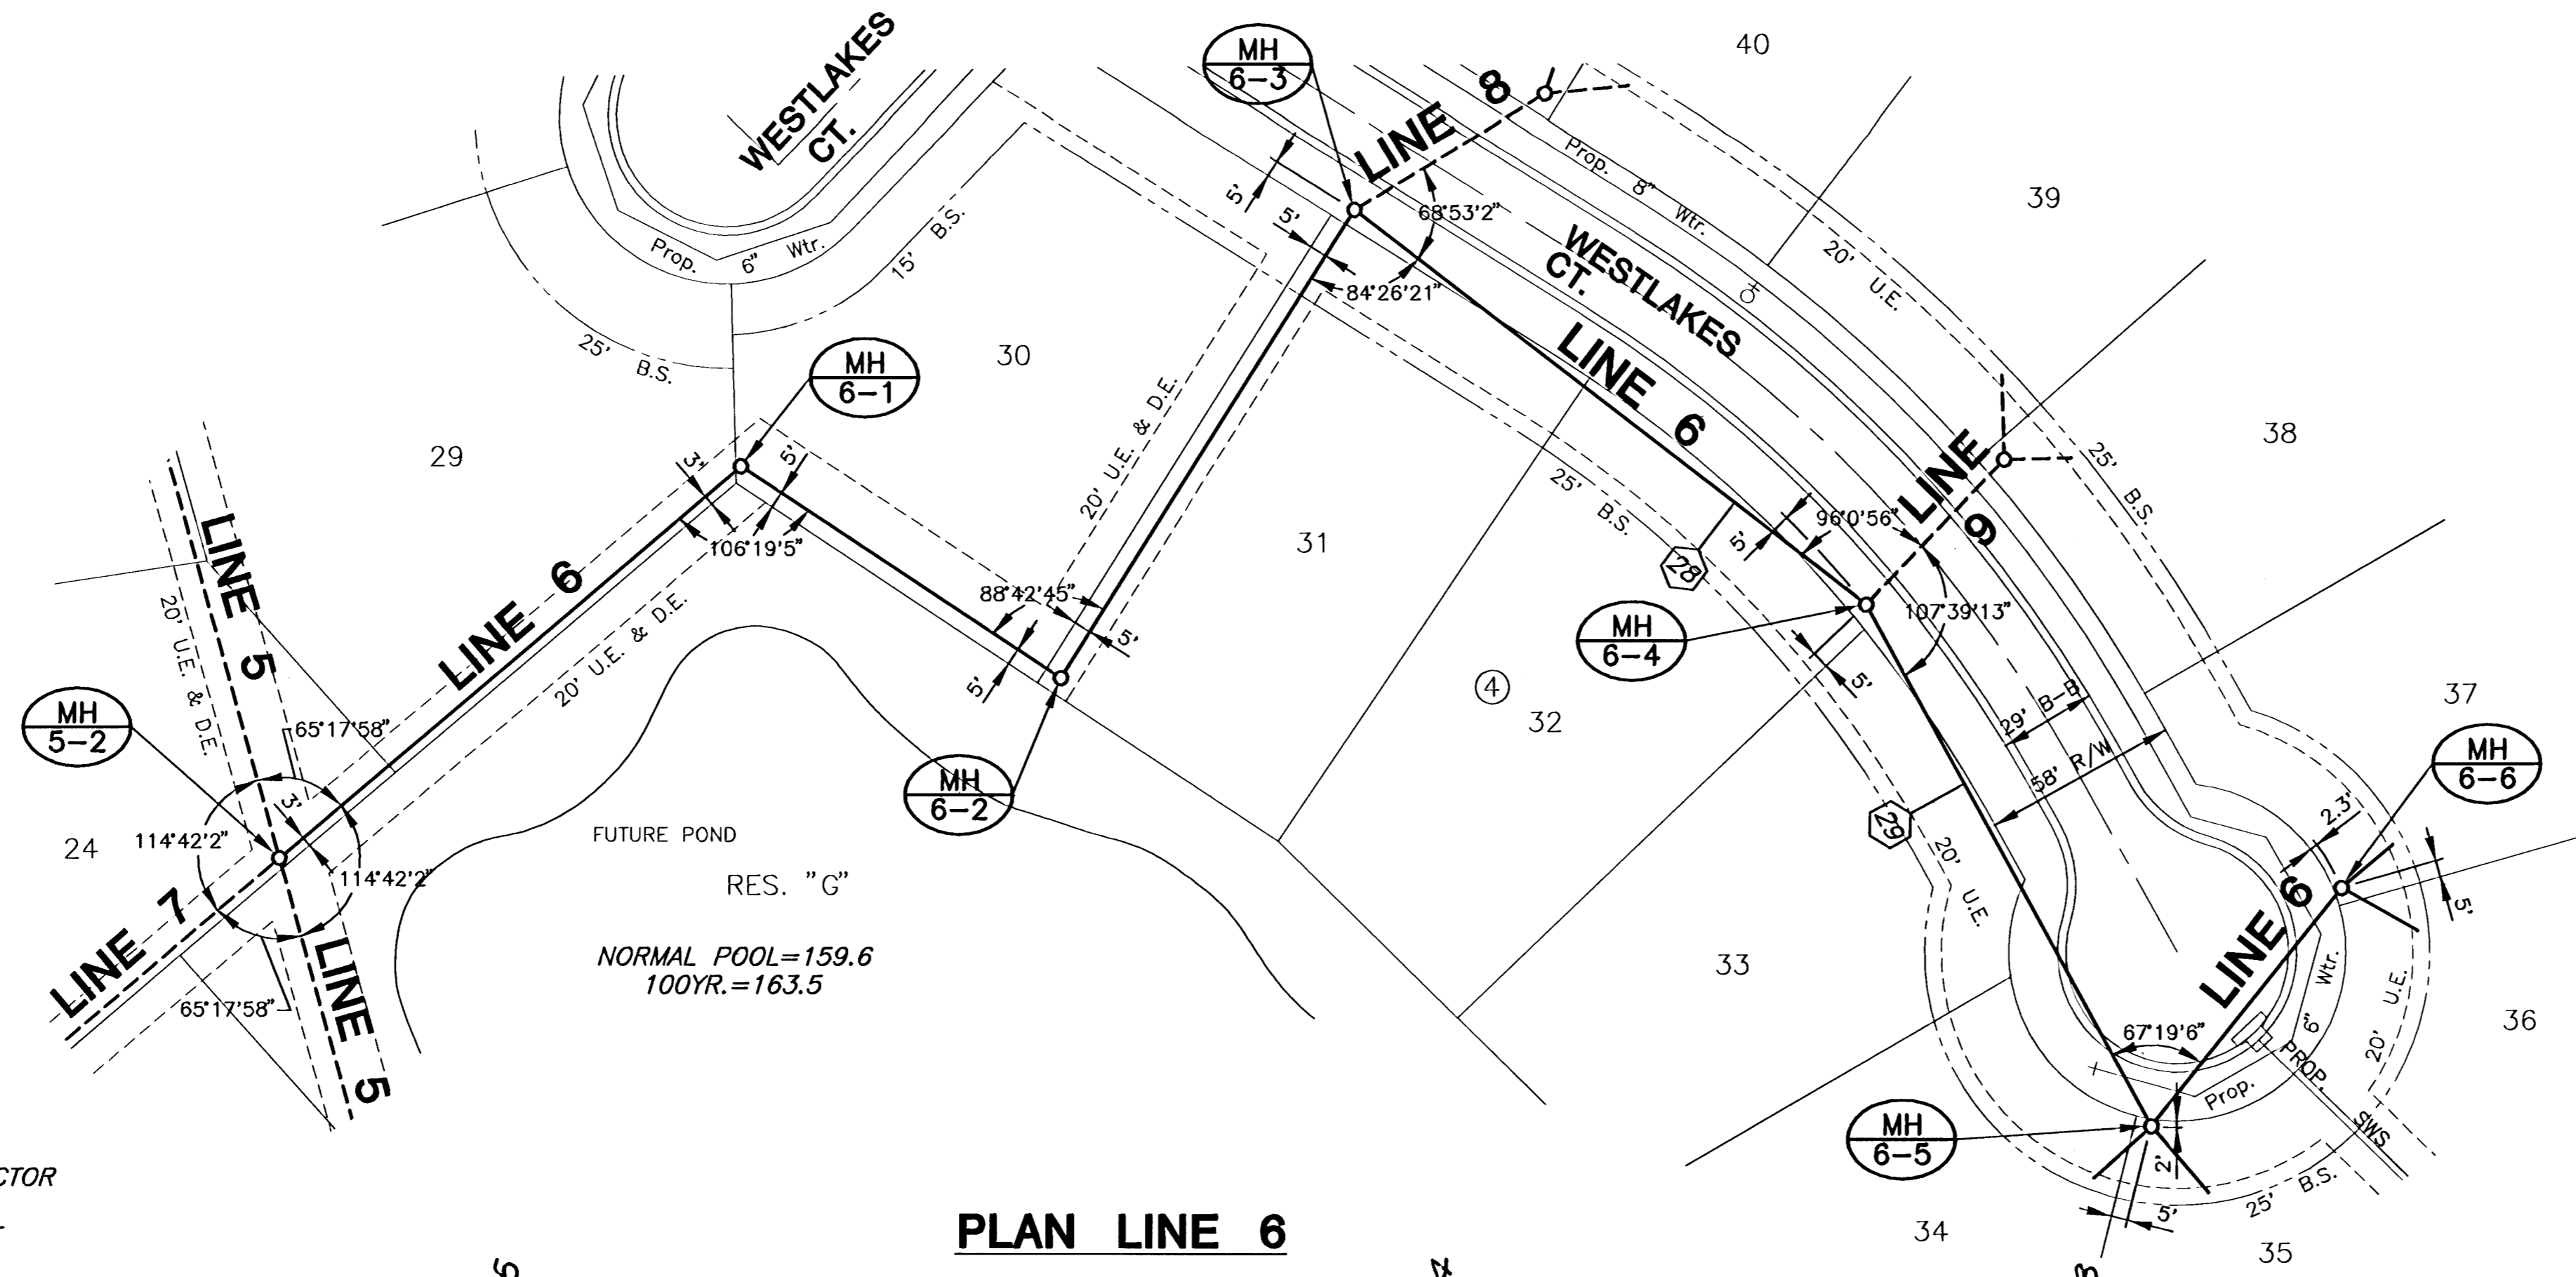

PLT012: Wednesday, July 05, 2006 @ 08:03AM

G:\CIVIL\99118.dwg (SAN) Pkg 99118B6.dwg