


SANITARY SEWER PLANS
**REED'S COVE
FOURTH ADDITION**

LINES 2 & 5
SHEET TITLE
448-00000
PROJECT NUMBER


DESIGN BY: SRS
DRAWN BY: DM
CHECKED BY: GJA

ISSUED: FEBRUARY 2006
REVISED:

SHEET NO.
4 of 11

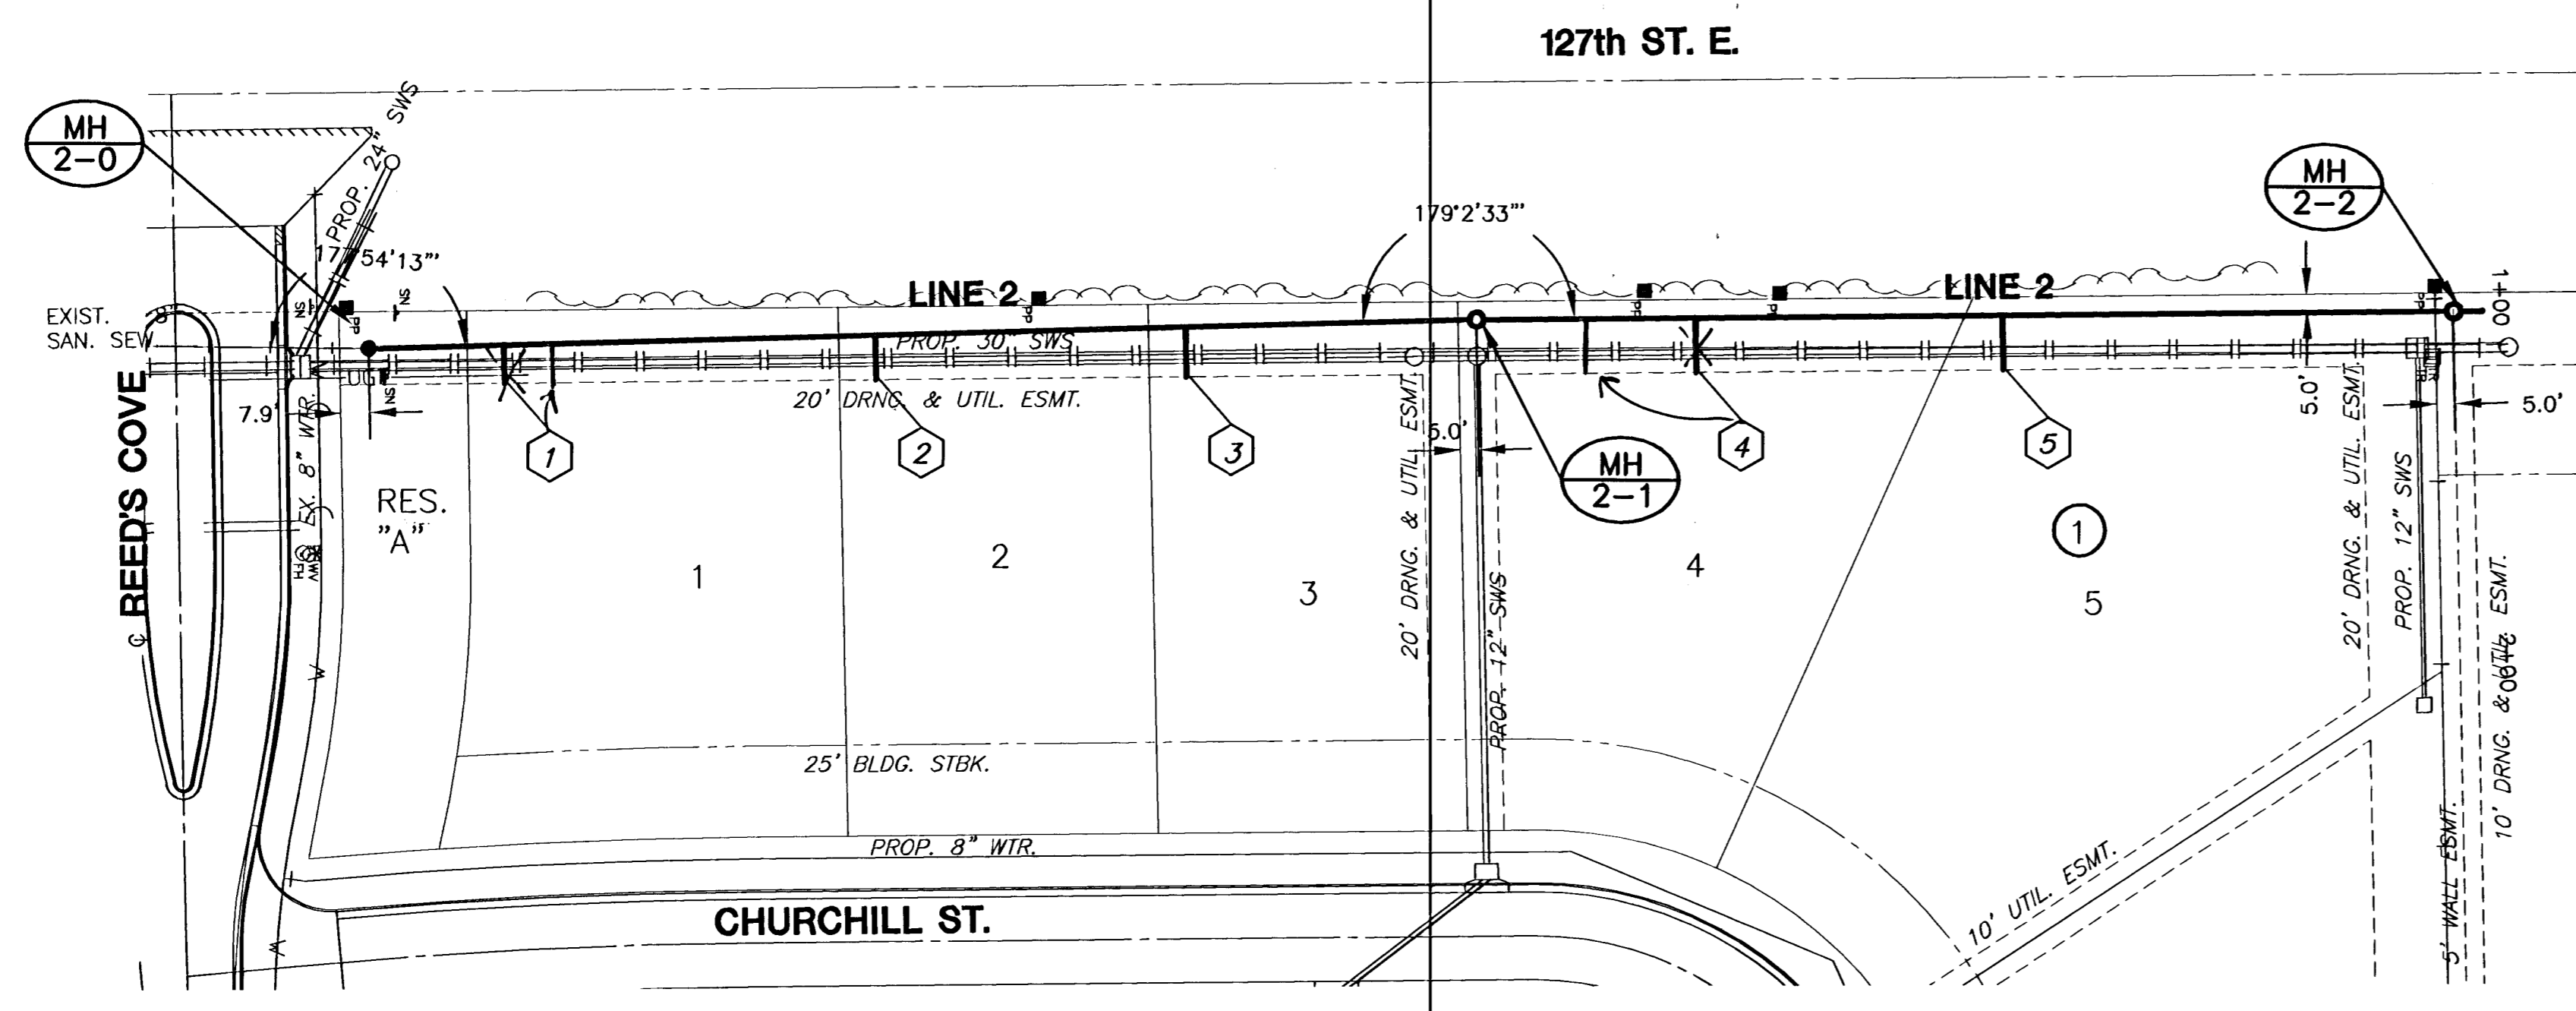


PLAN LINE 2

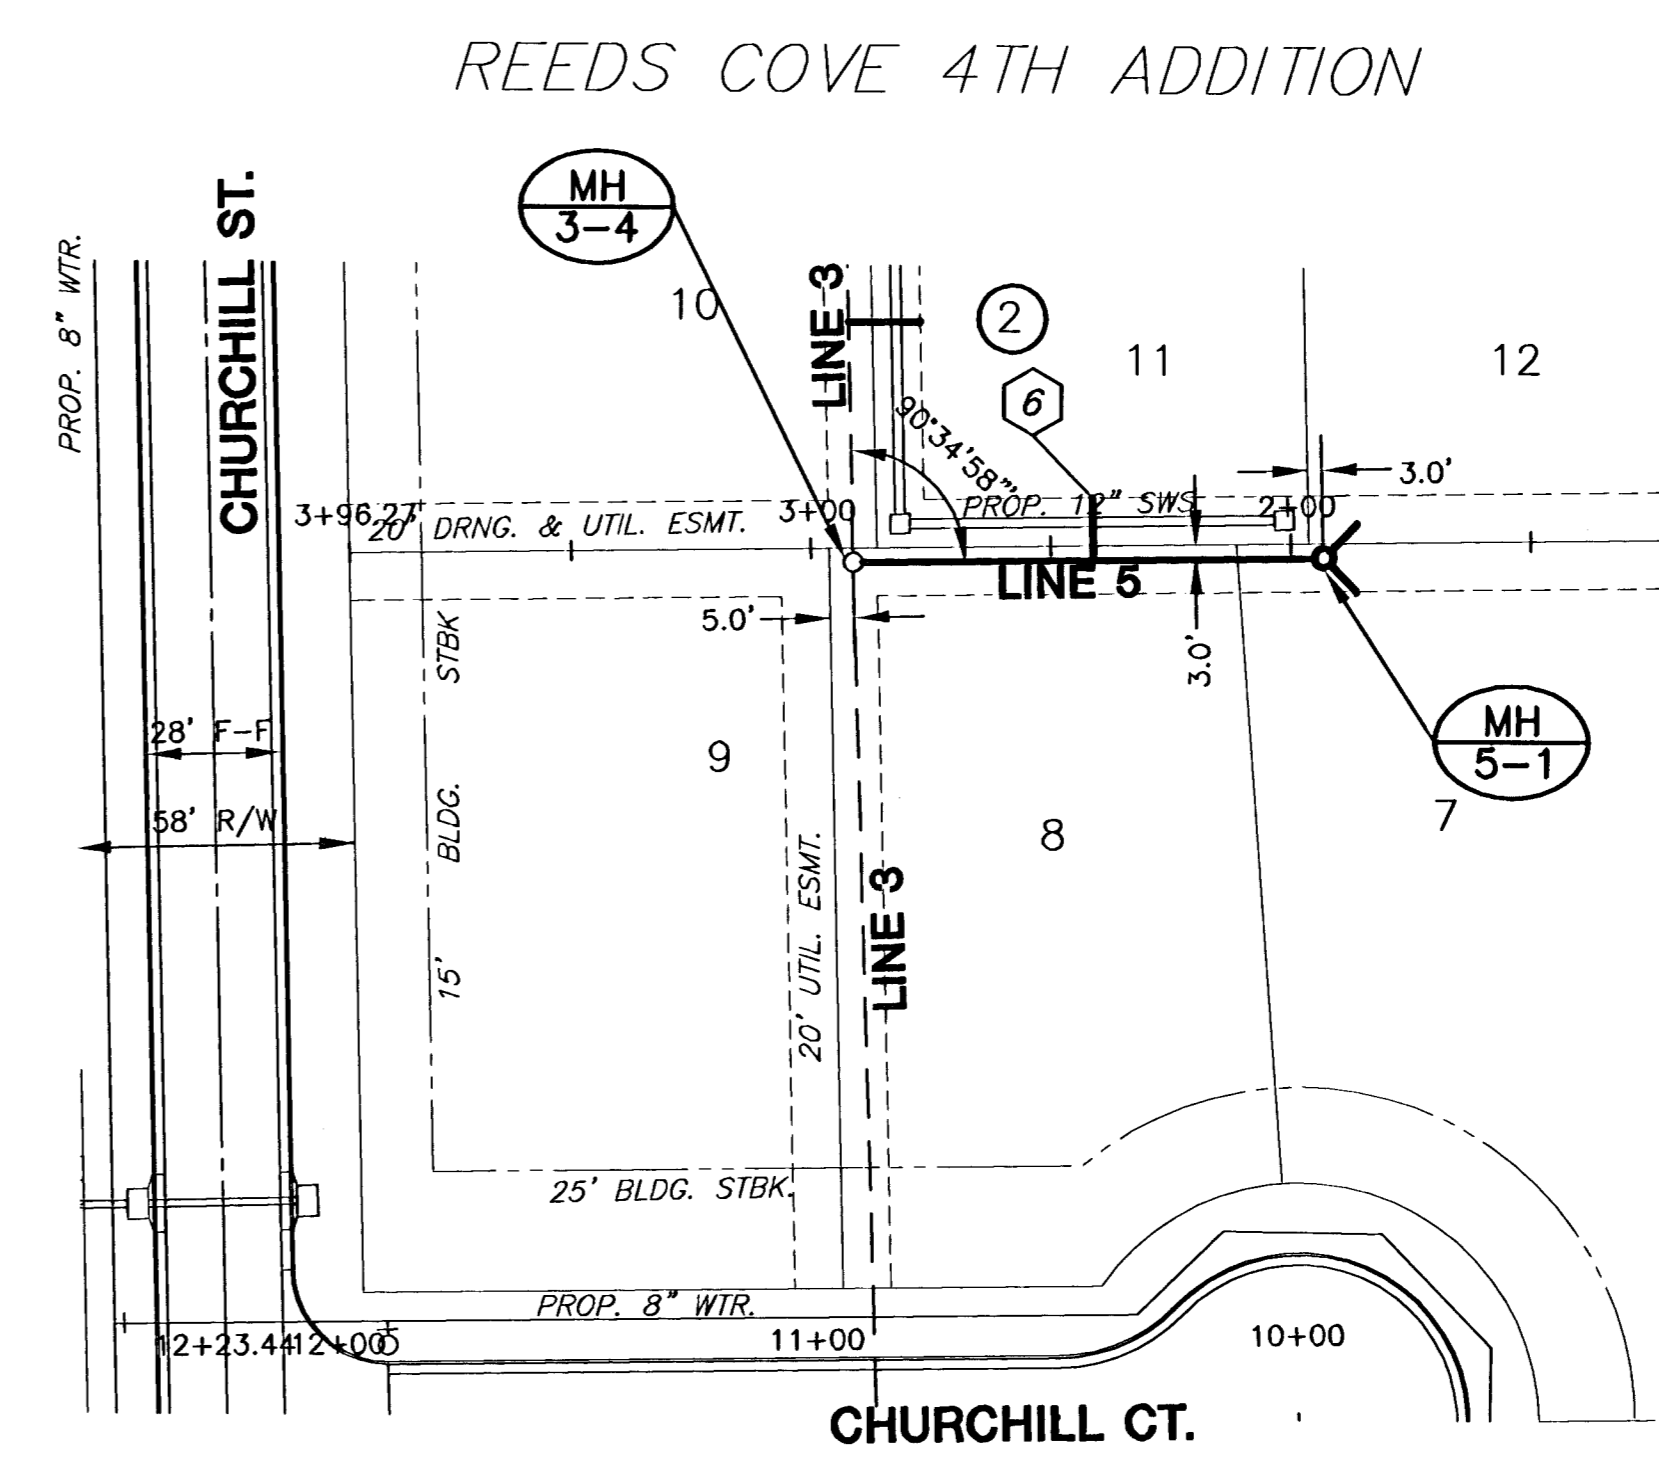

PLAN LINE 5

NOTE:
SEE SHEET 7 FOR
RISER TABLE.

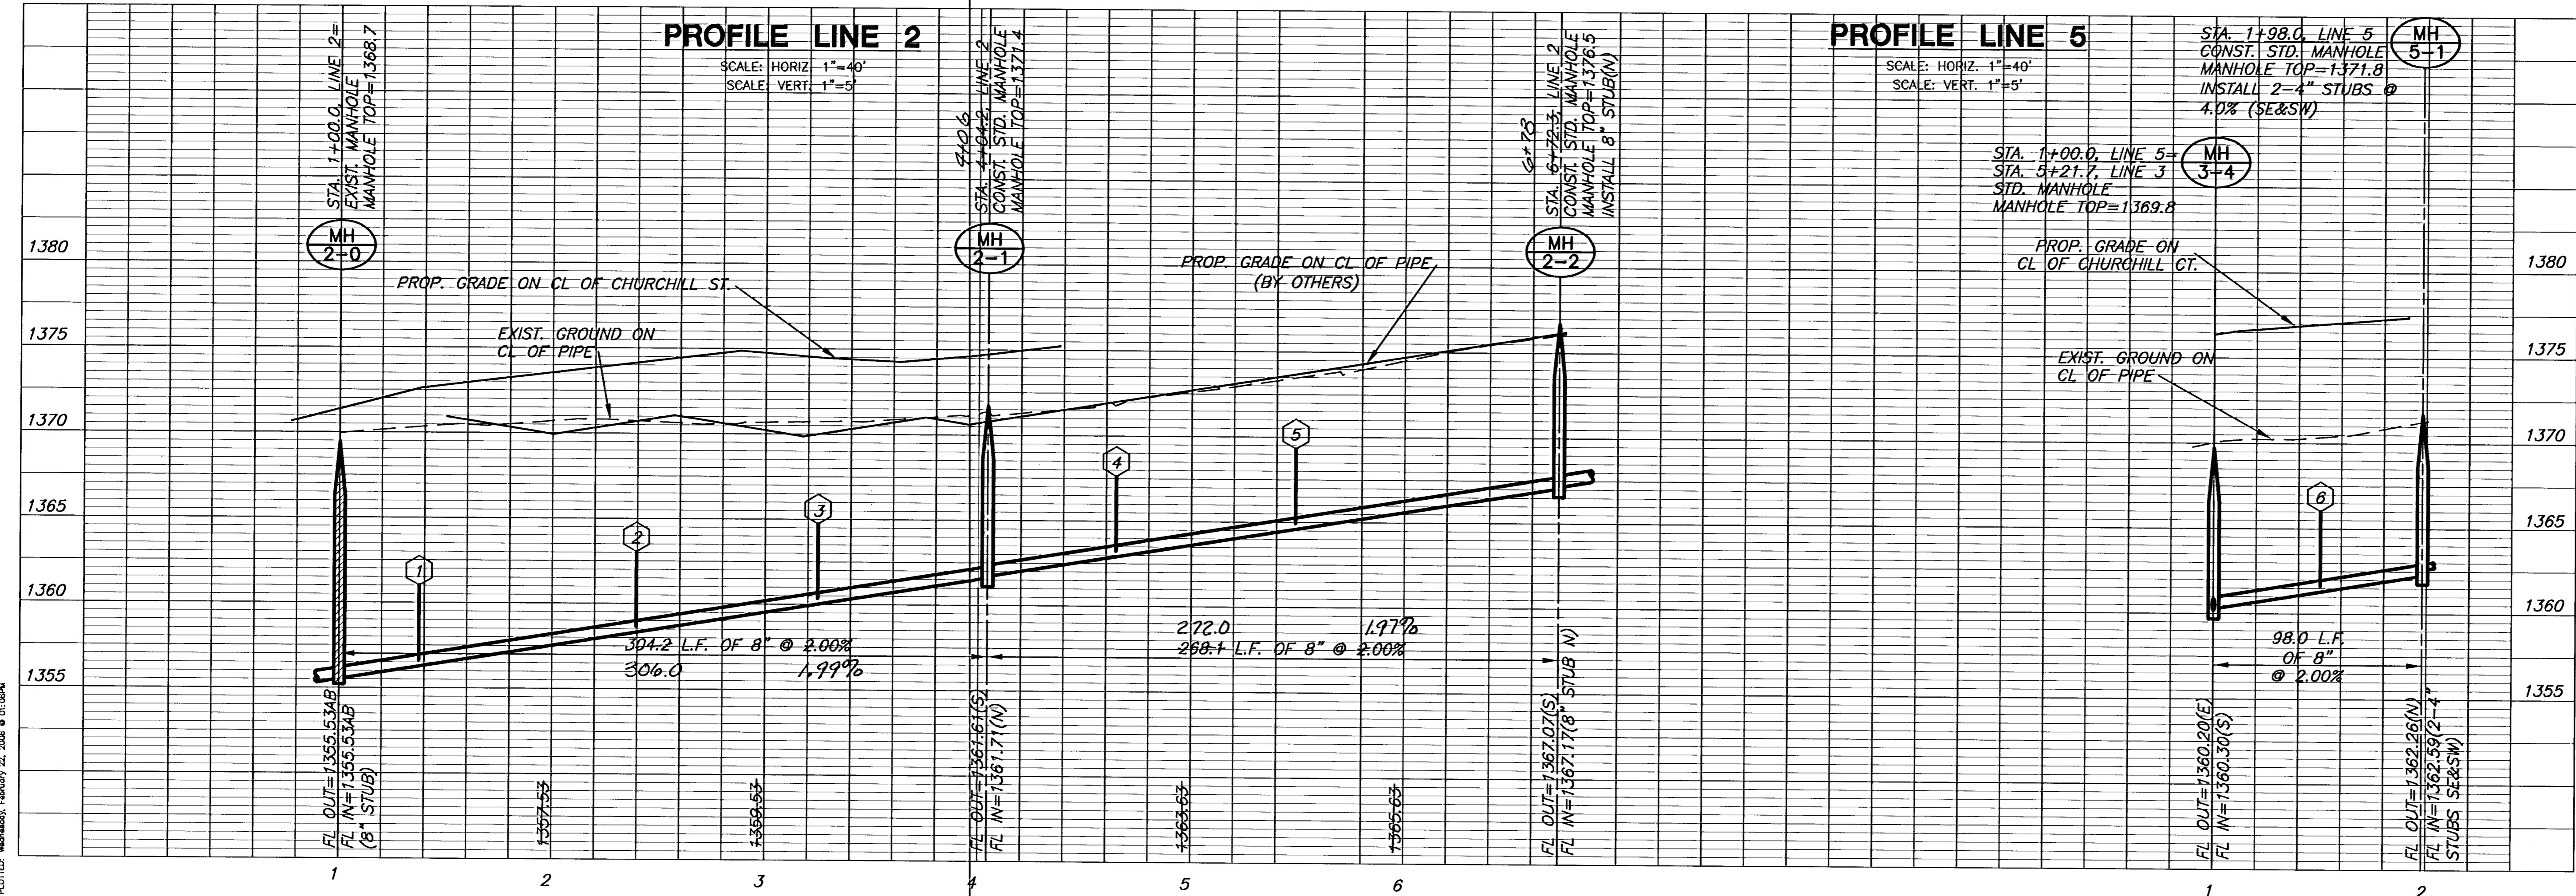

PROFILE LINE 2

PROFILE LINE 5

PLOTTED: Wednesday, February 22, 2006 01:06PM

H:\CIVIL\021214th Addition\SAN\021212B.dwg