

GENERAL NOTES

- THE CONTRACTOR SHALL COMPLY WITH ALL APPLICABLE SAFETY REGULATIONS. ALL CONSTRUCTION SHALL BE COMPLETED FOLLOWING CURRENT CITY STANDARD SPECIFICATIONS AND SPECIAL PROVISIONS.
- CONTRACTOR WILL BE REQUIRED TO PROVIDE NOTICE TO UTILITY COMPANIES A MINIMUM OF SEVENTY-TWO (72) HOURS PRIOR TO ANY EXCAVATION, AS FOLLOWS:

KANSAS ONE-CALL 687-2470

THE CONTRACTOR MUST NOTIFY THE FOLLOWING IN CASE OF AN EMERGENCY:

AT&T	1-800-246-8464
BLACK HILLS ENERGY (GAS)	1-800-694-8989
CITY OF WICHITA WATER & SEWER	1-316-219-8921
CITY OF WICHITA STORMWATER	1-316-268-4090
CITY OF WICHITA TRAFFIC	1-316-268-4034
CITY OF MAIZE WATER & SEWER	1-316-722-4854
COX COMMUNICATIONS	1-888-249-3530
KANSAS GAS SERVICE	1-888-482-4950
EVERGY	1-800-544-4857

- UTILITY SERVICE LINES, POLES, ETC. ARE TO BE ADJUSTED AS NECESSARY BY OTHERS PRIOR TO CONSTRUCTION UNLESS THE PLANS SPECIFICALLY CALL FOR THEIR ADJUSTMENT BY THE CONTRACTOR OR UNLESS THE PLANS SPECIFICALLY IDENTIFY A UTILITY TO BE ADJUSTED BY ITS OWNER DURING CONSTRUCTION. EXISTING UTILITIES AND THEIR LOCATION, AS SHOWN ON THE PLANS, REPRESENT THE BEST INFORMATION OBTAINABLE FOR DESIGN. THE CONTRACTOR WILL BE REQUIRED TO WORK AROUND EXISTING UTILITIES WITHIN THE RIGHT-OF-WAY WHICH DO NOT CONFLICT WITH PROPOSED CONSTRUCTION.
- RUBBLE FROM THE REMOVAL OF MISCELLANEOUS STRUCTURES AND EXCESS EXCAVATION WHICH IS TO BE WASTED SHALL BE DISPOSED OF ON SITES TO BE PROVIDED BY THE CONTRACTOR. THESE SITES SHALL BE APPROVED BY THE ENGINEER AS TO SUITABILITY, APPEARANCE AND SITE LOCATION. LOCATIONS, IN THE OPINION OF THE ENGINEER, THAT WILL LEAVE AN UNSIGHTLY APPEARANCE WILL NOT BE APPROVED. ALL DISPOSAL SITES MUST BE APPROVED BY THE KANSAS DEPARTMENT OF HEALTH AND ENVIRONMENT. MATERIAL EITHER STOCKPILED OR DISPOSED OF IN A FLOOD PLAIN WILL REQUIRE A KANSAS STATE BOARD OF AGRICULTURE PERMIT. ANY MATERIAL DUMPED IN WATERS OF THE UNITED STATES OR WETLANDS IS SUBJECT TO U.S. CORPS OF ENGINEERS PERMITTING REGULATIONS. ANY MATERIAL BURIED OR STOCKPILED BEYOND APPROVED CONSTRUCTION LIMITS WILL REQUIRE ADDITIONAL ARCHAEOLOGICAL INVESTIGATIONS UNLESS BURIED IN A PREVIOUSLY APPROVED BORROW LOCATION.
- TREES AND SHRUBS IN PUBLIC RIGHT-OF-WAY WHICH ARE IN DIRECT CONFLICT WITH PROPOSED NEW CONSTRUCTION SHALL BE REMOVED BY THE CONTRACTOR WITH THE CITY ENGINEER'S APPROVAL. TREES AND SHRUBS WHICH ARE NOT IN DIRECT CONFLICT WITH PROPOSED NEW CONSTRUCTION SHALL BE SAVED AND PROTECTED FROM DAMAGE.
- THE CONTRACTOR SHALL GIVE ALL PROPERTY OWNERS AND/OR TENANTS OF DEVELOPED PROPERTY ABUTTING THE CONSTRUCTION OF THIS PROJECT A MINIMUM OF TEN (10) DAYS NOTICE PRIOR TO START OF CONSTRUCTION.
- THE CONTRACTOR SHALL BE RESPONSIBLE FOR PRESERVING PROPERTY IRONS. THE CONTRACTOR WILL BE REQUIRED TO RE-ESTABLISH ANY PROPERTY IRONS WHICH ARE DAMAGED OR DESTROYED BY HIS CONSTRUCTION OPERATIONS. SUCH IRONS SHALL BE RE-ESTABLISHED BY A LICENSED LAND SURVEYOR IN ACCORDANCE WITH STATE LAWS.
- THE ENGINEERING DIVISION SHALL FIELD LOCATE WATER VALVES ONE TIME DURING CONSTRUCTION WHEN REQUESTED BY THE CONTRACTOR. IT SHALL BE THE CONTRACTOR'S RESPONSIBILITY TO PRESERVE SUCH FIELD LOCATIONS DURING THE CONSTRUCTION PROCESS. WATER VALVES, VALVE BOXES OR FIRE HYDRANTS DAMAGED DURING CONSTRUCTION SHALL BE REPAIRED BY CONTRACTOR AT HIS OWN EXPENSE. VALVE BOXES AND WATER METERS WITHIN THE PROJECT LIMITS SHALL BE ADJUSTED TO MATCH FIELD GRADES BY THE CONTRACTOR.
- IF TRAFFIC WILL BE IMPACTED BY CONSTRUCTION, A TRAFFIC CONTROL PLAN MUST BE SUBMITTED AND APPROVED BY THE CITY TRAFFIC ENGINEER AT traffic@wichita.gov BEFORE CONSTRUCTION CAN BEGIN. THE CONTRACTOR SHALL BE RESPONSIBLE FOR ALL TRAFFIC CONTROL MEASURES TO FACILITATE CONSTRUCTION. ALL CONSTRUCTION ZONE MARKINGS AND SIGNAGE SHALL CONFORM TO THE LATEST VERSION OF THE MANUAL ON UNIFORM TRAFFIC CONTROL DEVICES (MUTCD) AS PUBLISHED BY THE US DEPT. OF TRANSPORTATION, FEDERAL HIGHWAY ADMINISTRATION. ALL COSTS ASSOCIATED WITH CONSTRUCTION MARKINGS AND SIGNAGE SHALL BE THE CONTRACTOR'S RESPONSIBILITY.
- ALL AREAS DISTURBED DURING CONSTRUCTION THAT WILL NOT BE UNDER PROPOSED PAVEMENT SHALL BE SEEDED AND MULCHED. COST SHALL BE CONSIDERED SUBSIDIARY TO PROJECT SEEDING. SEEDING TO BE: ANNUAL RYE @ 150 LBS./ACRE & SLOW RELEASE @ 150 LBS./ACRE
- CONTRACTOR SHALL LIMIT THE EXTENT OF TRENCH OPEN OVERNIGHT AND WEEKENDS TO LESS THAN 50 FEET.
- EXISTING UTILITIES AND THEIR LOCATION, AS SHOWN ON THE PLANS REPRESENT THE BEST INFORMATION OBTAINABLE FOR DESIGN. LOCATION INFORMATION HAS BEEN OBTAINED FROM THE VARIOUS COMPANIES AND IS EITHER FROM COMPANY DRAWINGS OR COMPANY PROVIDED FIELD LOCATIONS. THE PLAN LOCATIONS SHOWN ARE NOT GUARANTEED. ADDITIONAL EXISTING UTILITIES MAY ALSO BE ENCOUNTERED.
- A PORTION OF EXCESS EXCAVATED MATERIAL SHALL BE MOUNDED AROUND MANHOLES WHICH EXTEND MORE THAN ONE (1) FOOT ABOVE THE EXISTING GROUND. SUCH MOUND SHALL BE CONSTRUCTED WITH NEW DEVELOPMENT A SIX (6) FOOT DIAMETER FLAT TOP WITH 4 TO 1 SIDE SLOPES DOWN TO THE ORIGINAL GROUND. THE ELEVATION OF THE FLAT TOP OF THE MOUND SHALL BE 0.4 FOOT BELOW THE TOP OF THE MANHOLE.
- CONTRACTOR SHALL PROVIDE POSITIVE DRAINAGE AWAY FROM ALL MANHOLE COVERS.
- ALL STUBS AND PLUGGED PIPES SHALL BE LOCATED WITH GREEN PLASTIC TAPE IN THE SAME MANNER AS RISERS.
- CONNECTING TO EXISTING MANHOLES: PRIOR TO LAYING SEWER LINES USING EXISTING STUBS IN EXISTING MANHOLES, THE CONTRACTOR SHALL EXPOSE AND VERIFY THE ELEVATION, GRADE AND ALIGNMENT OF EXISTING STUBS AND NOTIFY THE ENGINEER OF ANY DEVIATION FROM THE PLANS. WHERE CONNECTION TO AN EXISTING MANHOLE THAT DOES NOT HAVE AN EXISTING STUB OR THE STUB IS UNUSABLE DUE TO ELEVATION GRADE OR ALIGNMENT, THE CONTRACTOR SHALL BORE CUT INTO EXISTING MANHOLE WALL TO MAKE CONNECTION USING APPROVED WATER STOP GASKET, AND RESHAPE THE EXISTING MANHOLE INVERT TO PROVIDE SMOOTH FLOW. THE COST TO CONNECTING TO EXISTING MANHOLES IS INCIDENTAL TO THE PROJECT.
- THE CONTRACTOR SHALL PREVENT ANY CONSTRUCTION DEBRIS FROM ENTERING THE EXISTING SANITARY SEWER DURING CONSTRUCTION.
- THE CONTRACTOR SHALL BE RESPONSIBLE FOR MAINTAINING CONTINUOUS FLOW OF SEWAGE THROUGH CONSTRUCTION. CONTRACTOR'S PROPOSED METHOD FOR MAINTAINING SEWAGE FLOW SHALL BE SUBMITTED AND APPROVED BY THE SEWER MAINTENANCE DIVISION (316-268-4073) PRIOR TO STARTING AND BY-PASSING OF SEWAGE FLOWS.
- ALL TRAFFIC CONTROL DEVICES IN THE WORK ZONE (INCLUDING MARKINGS AND SIGNS) AND THEIR INSTALLATION AND MAINTENANCE SHALL COMPLY WITH THE LATEST EDITION OF THE MANUAL ON UNIFORM TRAFFIC CONTROL DEVICES (MUTCD). ALL TRAFFIC CONTROL DEVICES IN THE TRAVELED WAY OR CLEAR ZONE SHALL BE CRASHWORTHY (NCHRP REPORT 350 OR MASH COMPLIANT). http://safety.ftwva.dot.gov/roadwaydept/policy_guide/road_hardware/wz/
- ALL CONSTRUCTION EQUIPMENT, INCLUDING VEHICLES, MATERIALS, AND DEBRIS, SHALL BE STORED OUTSIDE OF THE CLEAR ZONE. WHERE THIS CANNOT BE ACHIEVED THE CONTRACTOR SHALL PLACE APPROPRIATE SIGNS, OBJECT IDENTIFIERS, AND/OR BARRICADES IN COMPLIANCE WITH MUTCD.
- EXCEPT WHEN REQUIRED FOR SAFETY, TRAFFIC CONTROL SHALL NOT BLOCK ANY LANES OR SIDEWALKS WHEN WORK IS NOT BEING PERFORMED.
- FOLLOW THE LINK BELOW FOR DETAILS ON SPECIFIC CITY OF WICHITA STANDARD DETAILS: <http://www.wichita.gov/PWU/Pages/Regulations.aspx>
- DEVELOPER FOR THIS PROJECT IS:
MILLER FAMILY HOMES
907 S HYDRAULIC AVENUE
WICHITA, KS, 67211
CLINT MILLER
316-269-3322

SANITARY SEWER IMPROVEMENTS PHASE 1

TO SERVE

ARVADA ADDITION


PROJECT NO. 468-2022-024784

AN ADDITION TO THE CITY OF MAIZE, SEDGWICK COUNTY, KANSAS

ORG CODE 47267322


MUNIS NO. E2087

Nowak Construction - Contractor
S. Lowe - City of Wichita, Field Project Engineer
E. Flores - City of Wichita, Inspector
As-built
Stubs & Risers
Release Date (for connection purposes only): 10/5/2023
Completion Date:
pdf: apr 12/1/2023

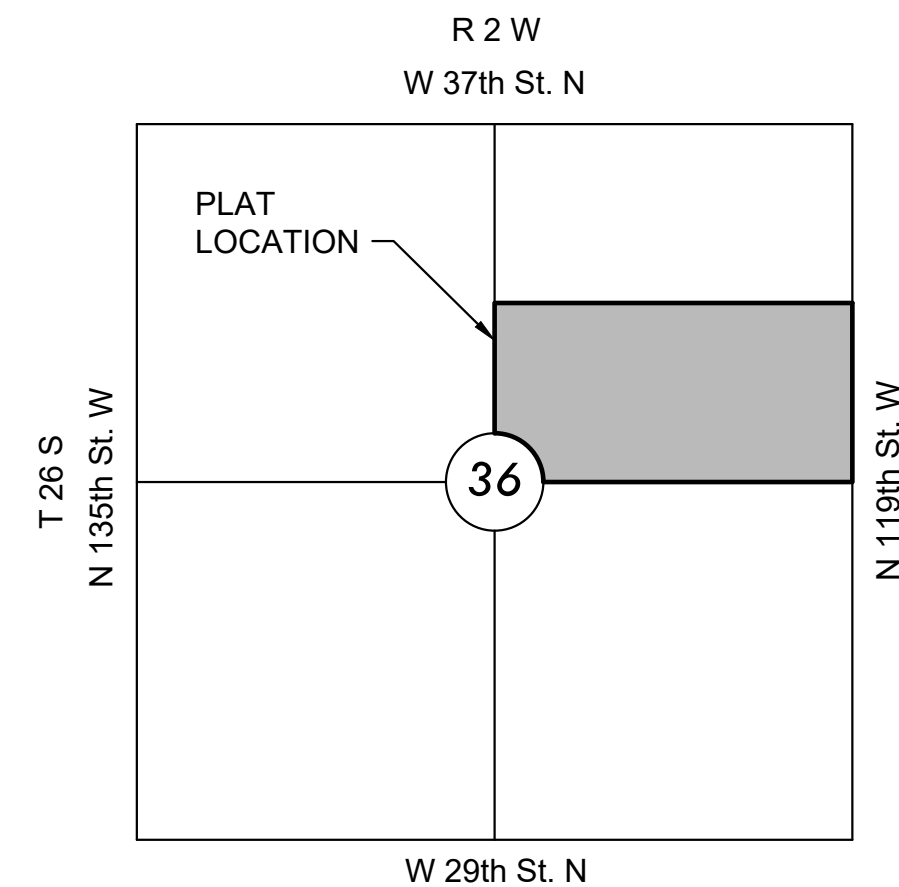



VICINITY MAP

No Scale

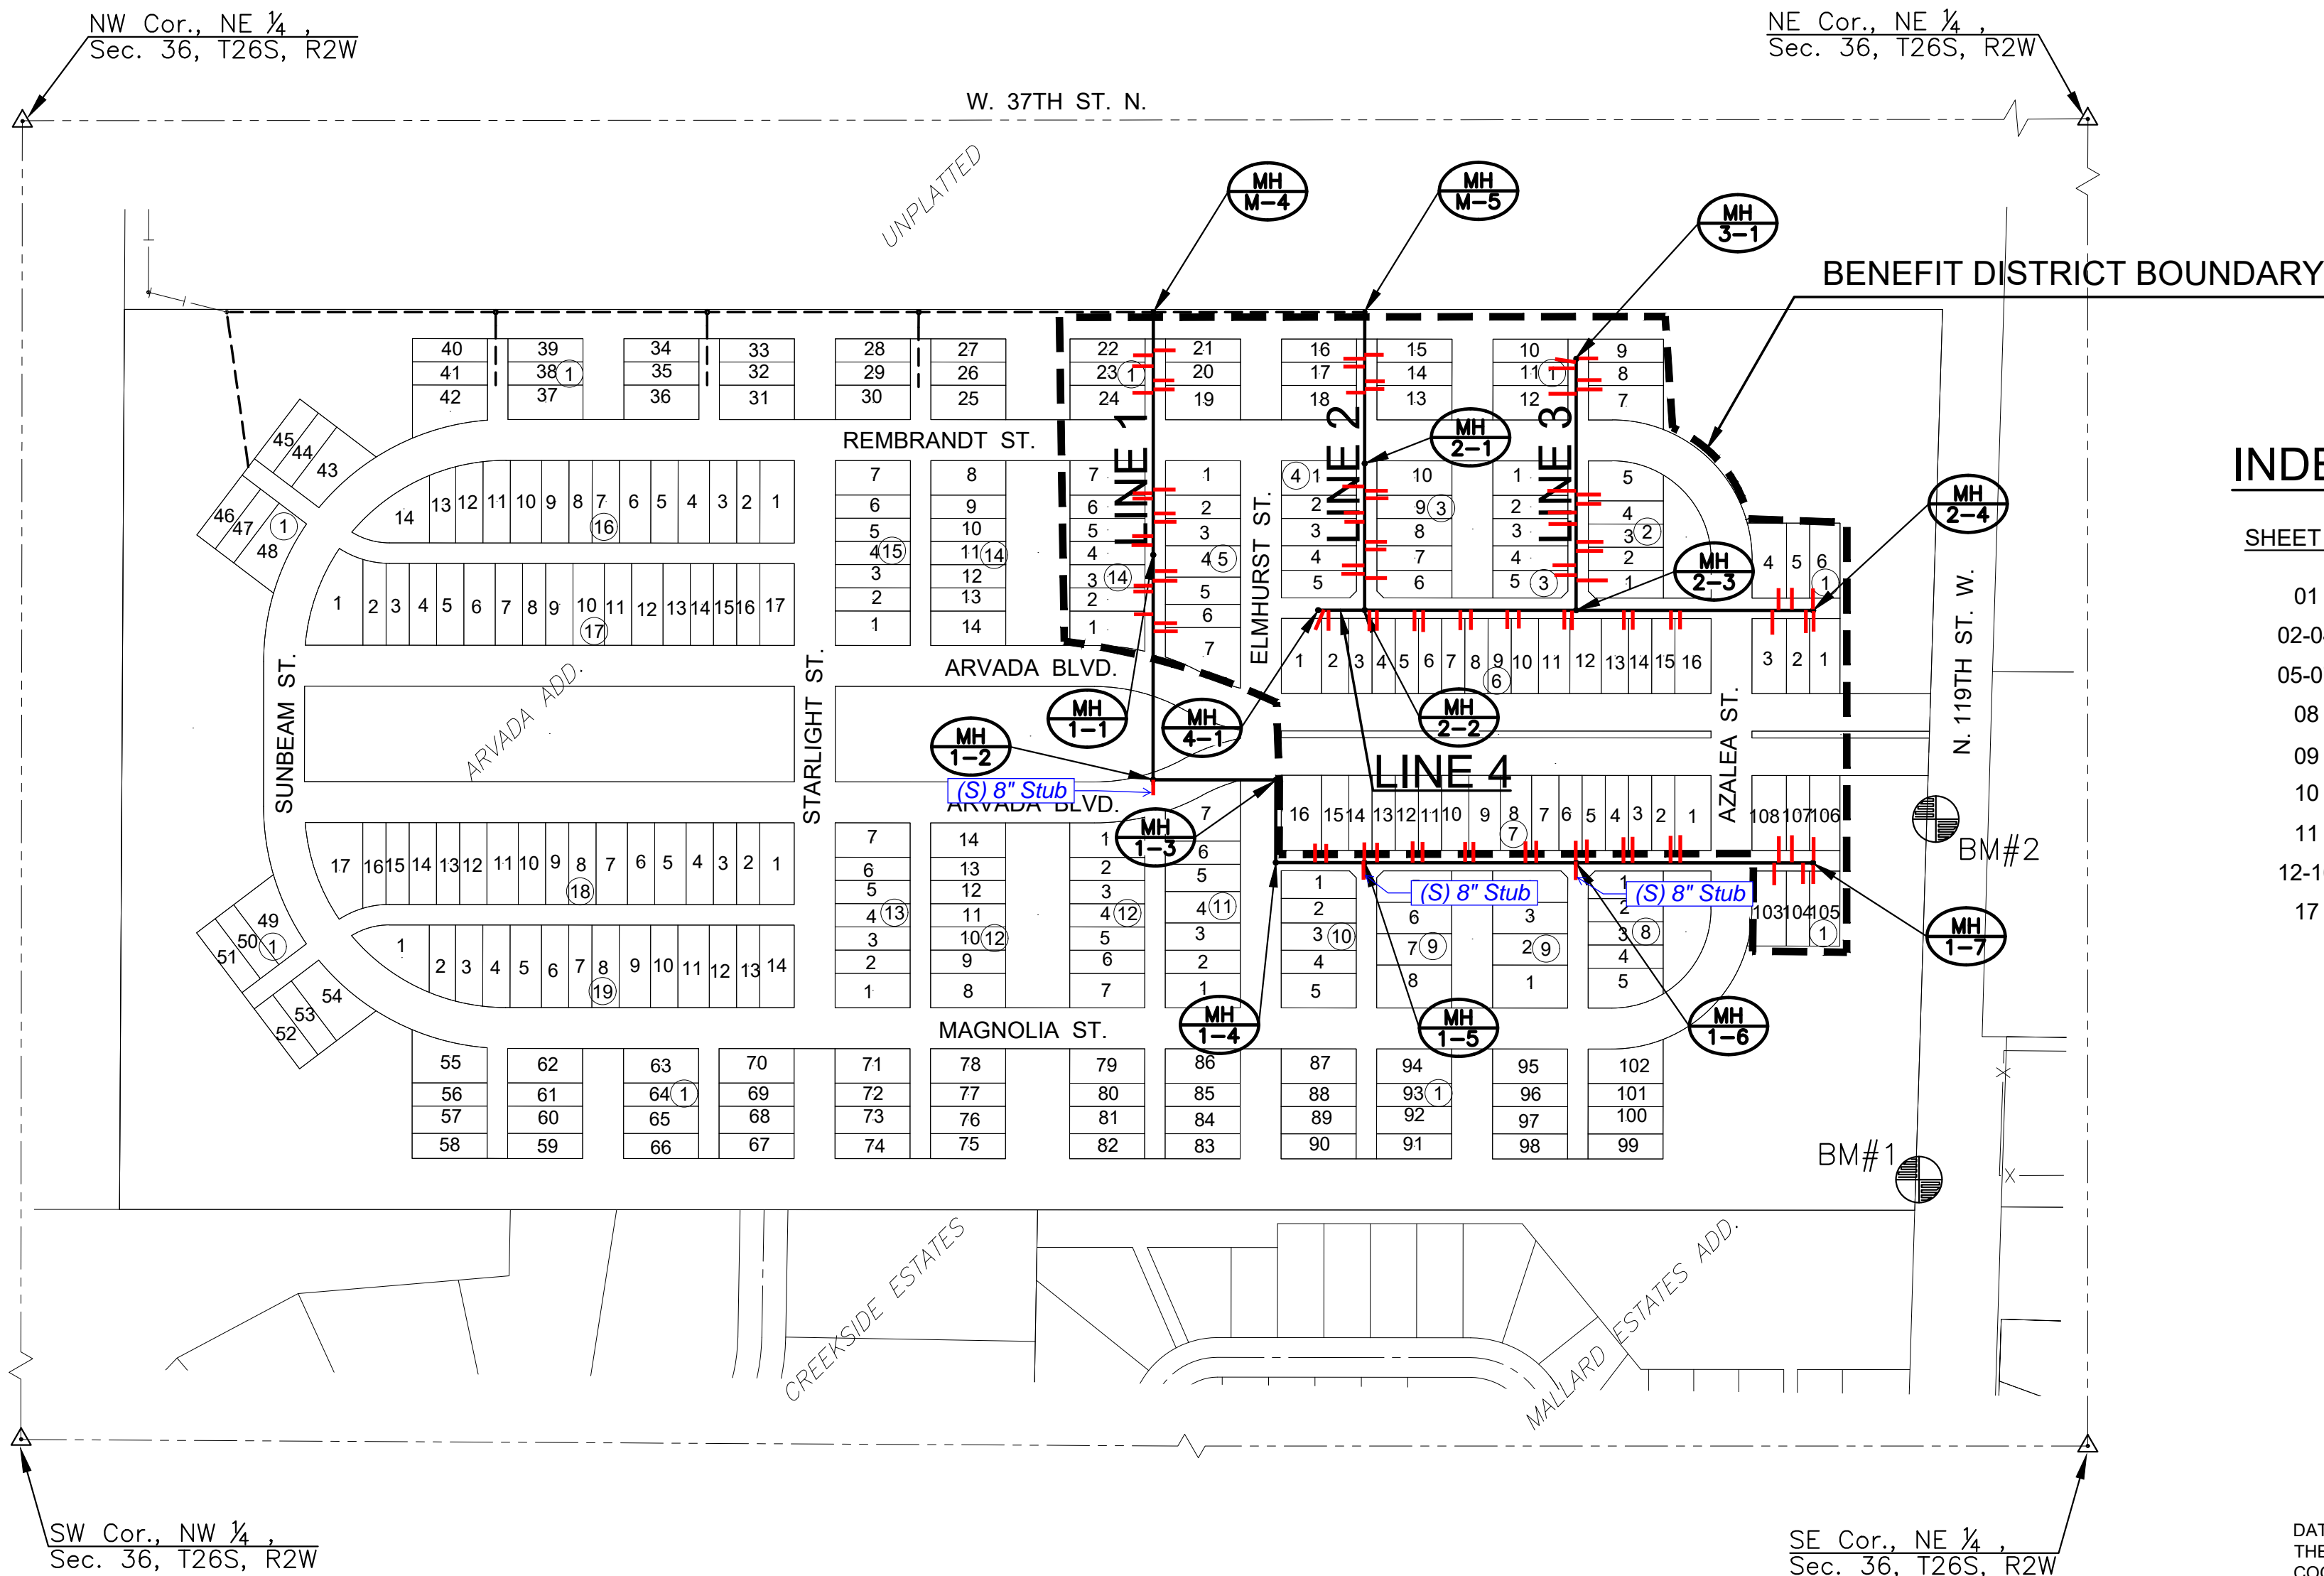

INDEX TO DRAWINGS

SHEET NO.	DESCRIPTION
01	TITLE SHEET
02-04	SAN DETAILS
05-07	LINE 1
08	LINE 2
09	LINES 3 & 4
10	RISER MAP
11	BUBBLE MAP
12-16	BMP DETAILS
17	FINAL PLAT

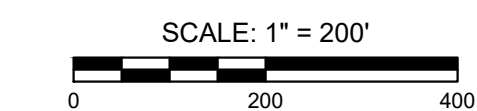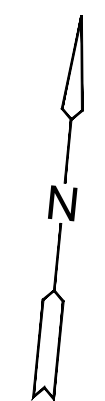

BENCHMARKS

DATUM:
THE HORIZONTAL DATUM IS BASED ON THE KANSAS COORDINATE SYSTEM OF 1983(2011), SOUTH ZONE. COORDINATES SHOWN HAVE BEEN MODIFIED TO THE GROUND USING A COMBINED ADJUSTMENT FACTOR OF 1.0001200144.

ALL ELEVATIONS SHOWN ARE BASED ON THE NAVD 88 VERTICAL DATUM.

BM#1
 N: 1706536.856 E: 1607137.975 EL: 1357.74
 MAG NAIL SET 40' S OF POWER POLE IN SE COR. OF PROPERTY, IN FOUND SQ. CUT ON S END OF A WEIR WALL. 572' 45" N & 5' E OF SE COR. OF PROPERTY.

BM#2
 N: 1707065.924 E: 1607144.837 EL: 1356.78
 MAG NAIL SET 15' W AMD 5' S OF SW WING WALL OF STORM HEADWALL ON W SIDE OF 119TH S W.

NOTE:
ALL CONTROL POINTS SHOWN HAVE ELEVATIONS ESTABLISHED BY DIFFERENTIAL LEVELING AND CAN BE USED AS TEMPORARY BENCHMARKS. WHEN USING A CONTROL POINT AS A TEMPORARY BENCHMARK, IT IS RECOMMENDED THAT CROSS-CHECKS BE MADE TO OTHER CONTROL POINTS OR BENCHMARKS TO CONFIRM ELEVATIONS PRIOR TO USE.



SANITARY SEWER PLANS FOR
ARVADA ADDITION
 PHASE 1

©2022
 MKEC Engineering
 All Rights Reserved
 www.mkec.com
 These drawings and their contents, including, but not limited to, all concepts, designs, & ideas are the exclusive property of MKEC Engineering (MKEC), and may not be used or reproduced in any way without the express consent of MKEC.

TITLE SHEET


PROJECT NO.	468-2022-024784	
DATE	NOV 2022	
SCALE	1"=200'	
DESIGNED	DRAWN	CHECKED
DFL	LAL	SPE

NO.	REVISION	DATE


SHEET NO.

J:\PROJECTS\2020\20201010708_MPH_119TH\HAND37TH\DEVELOPMENT SERVICES\00 02788 CAD\SH1\505 CIVIL\SANISAN PH 1\202008-05-2020 PH1.DWG
 PLOTTED: Friday, November 04, 2022 @ 08:39AM



Riser Number	Distance from Main to Riser (Lt./Rt.)	Distance from	
		Upstream MH	Downstream MH
1	20' Lt.	286'	70'
2	14' Rt.	284'	72'
3	14' Rt.	282'	74'
4	20' Lt.	250'	106'
5	20' Lt.	248'	108'
6	14' Rt.	246'	110'
7	20' Lt.	91'	265'
8	14' Rt.	89'	267'
9	14' Rt.	87'	269'
10	20' Lt.	55'	301'
11	20' Lt.	53'	303'
12	14' Rt.	21'	335'
13	14' Rt.	19'	337'
14	20' Lt.	307'	31'
15	20' Lt.	305'	33'
16	14' Rt.	291'	47'
17	14' Rt.	289'	49'
18	14' Rt.	255'	83'
19	20' Lt.	233'	105'
20	20' Lt.	231'	107'

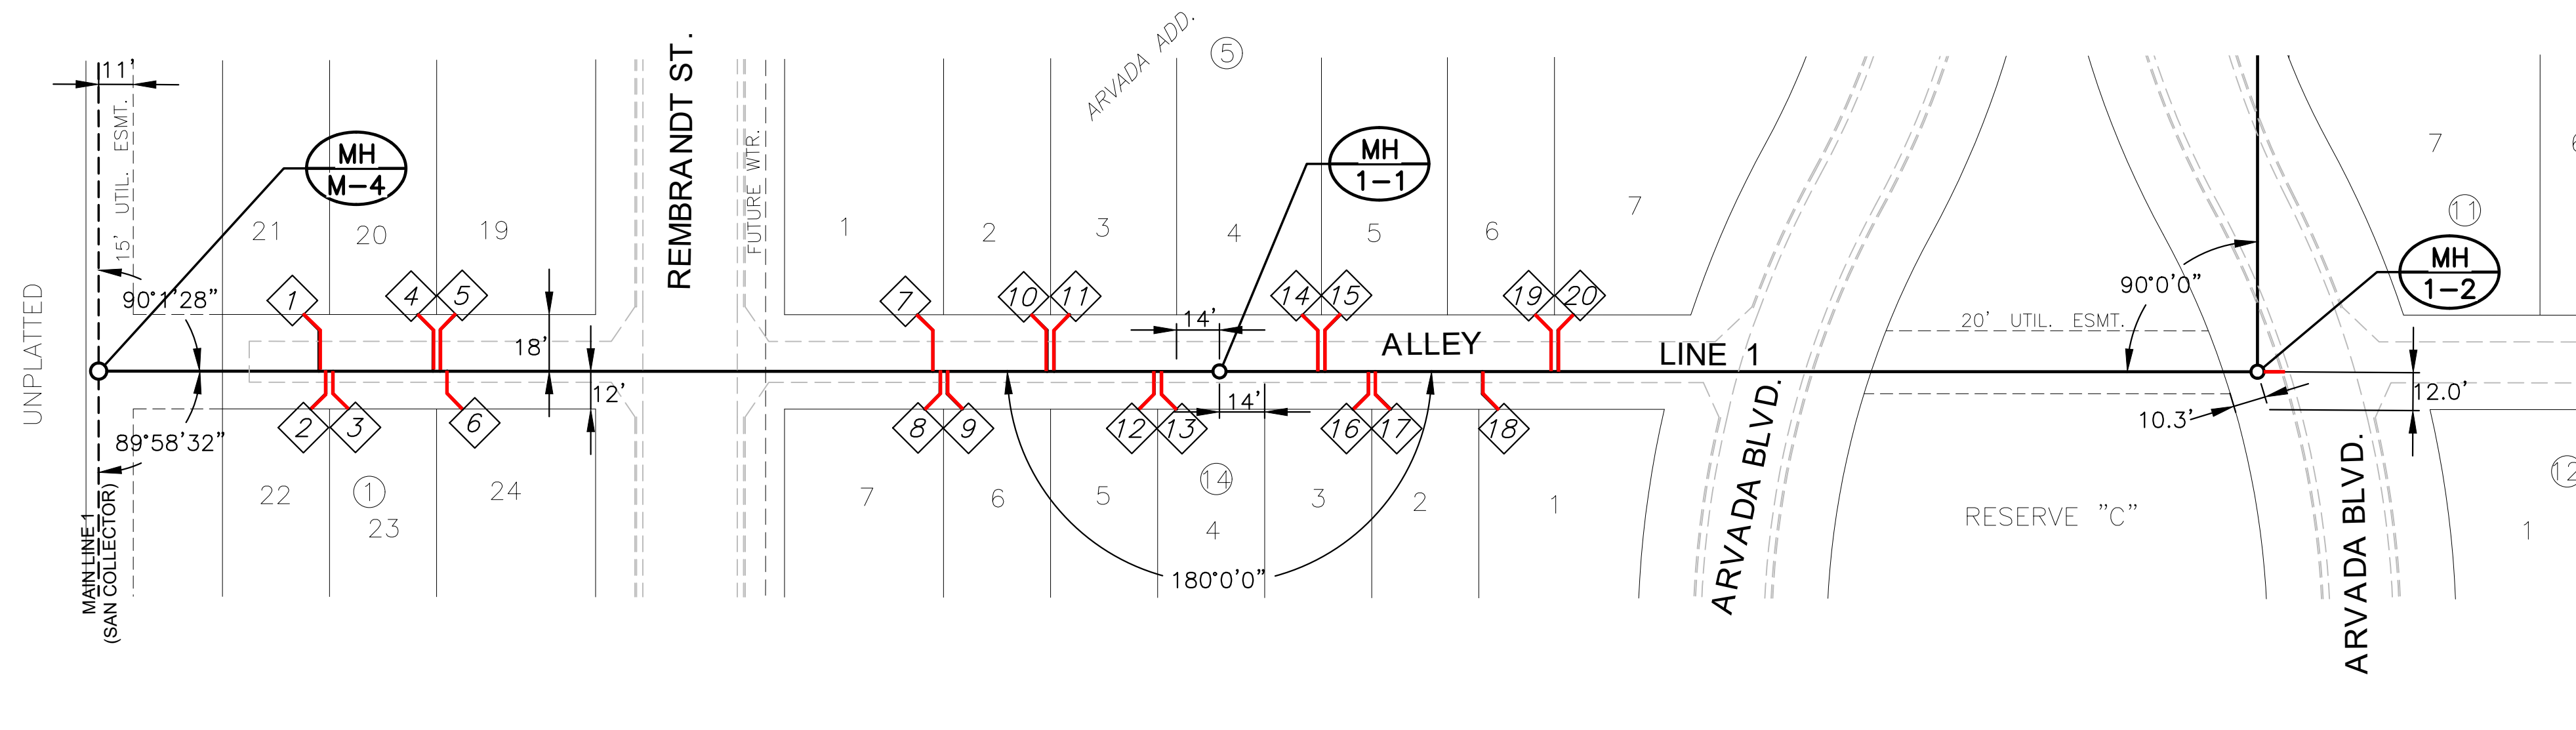

NOTE:
CONTRACTOR TO VERIFY THE DEPTH AND LOCATION OF EXISTING UTILITIES PRIOR TO CONSTRUCTION.

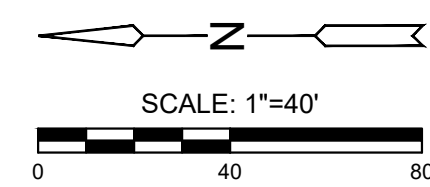



PLAN SS PH1 LINE 1
PROFILE SS PH1 LINE 1

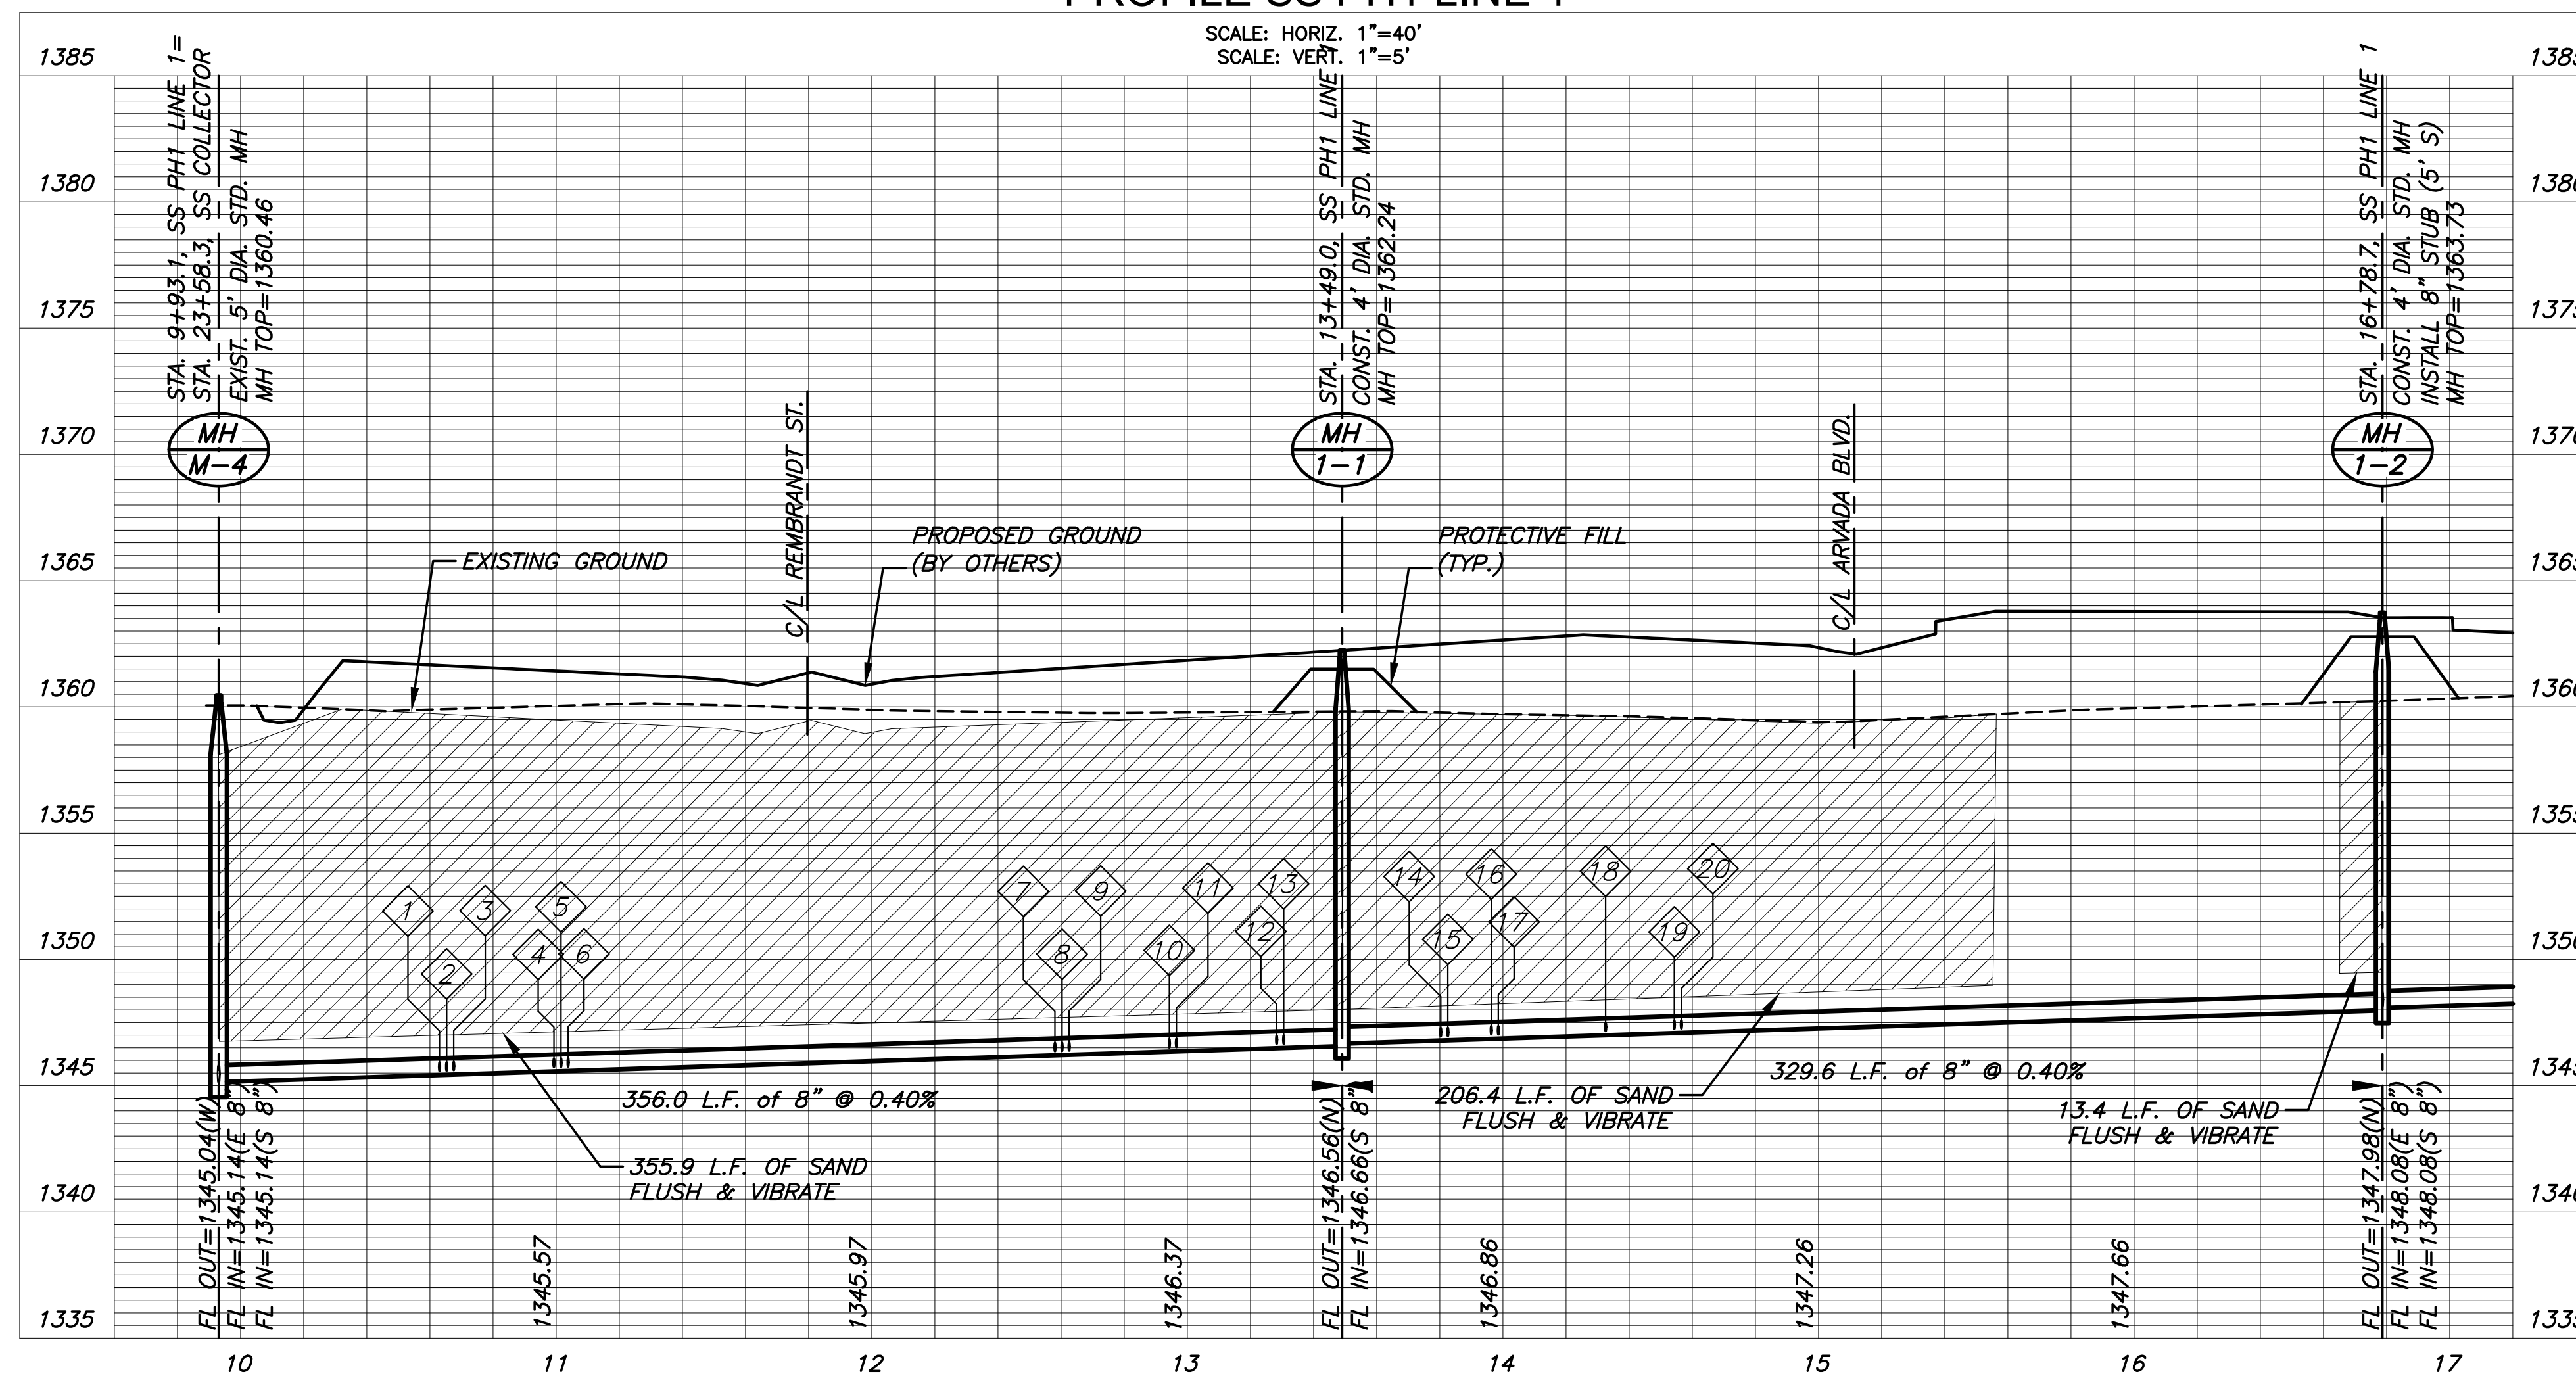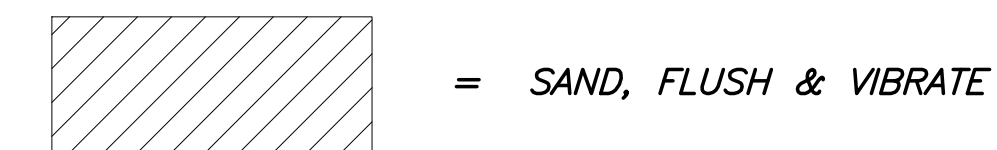


©2022 MKEC Engineering All Rights Reserved
www.mkec.com
These drawings and their contents, including, but not limited to, all concepts, designs, & ideas are the exclusive property of MKEC Engineering (MKEC), and may not be used or reproduced in any way without the express consent of MKEC.

LINE 1	
PROJECT NO.	468-2022-024784
DATE	NOV 2022
SCALE	1"=40'
DESIGNED	DFL
DRAWN	LAL
CHECKED	SPE
NO.	REVISION
NO.	DATE
SHEET NO. 05 OF 17	

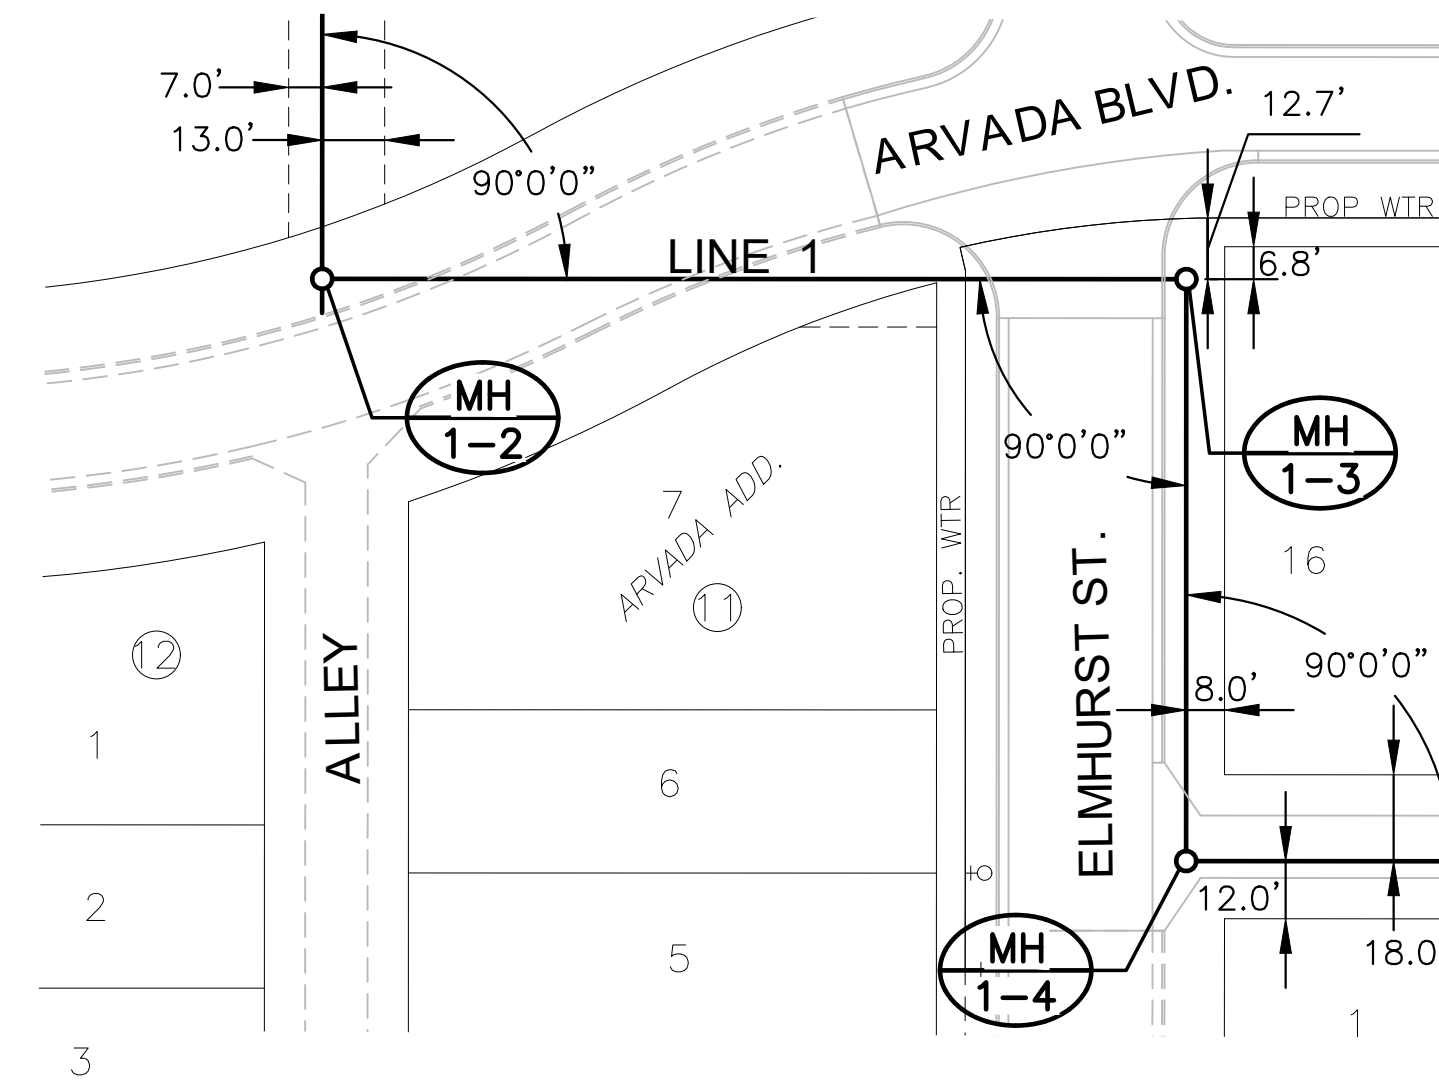


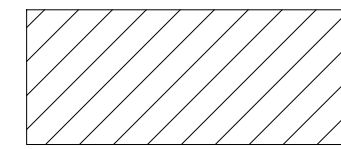 = SAND, FLUSH & VIBRATE

NOTE:
CONTRACTOR TO VERIFY THE
DEPTH AND LOCATION OF EXISTING
UTILITIES PRIOR TO CONSTRUCTION.

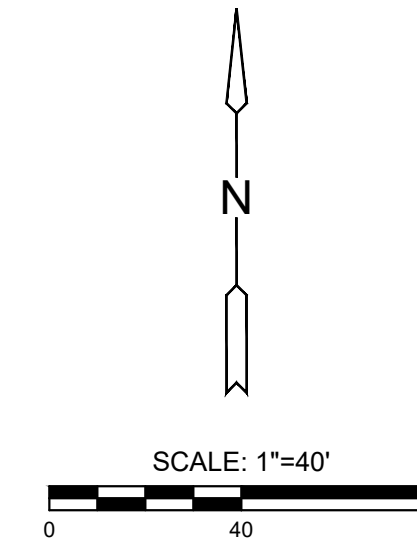

PLAN SS PH1 LINE 1 (CONT. 1)
PROFILE SS PH1 LINE 1 (CONT. 1)

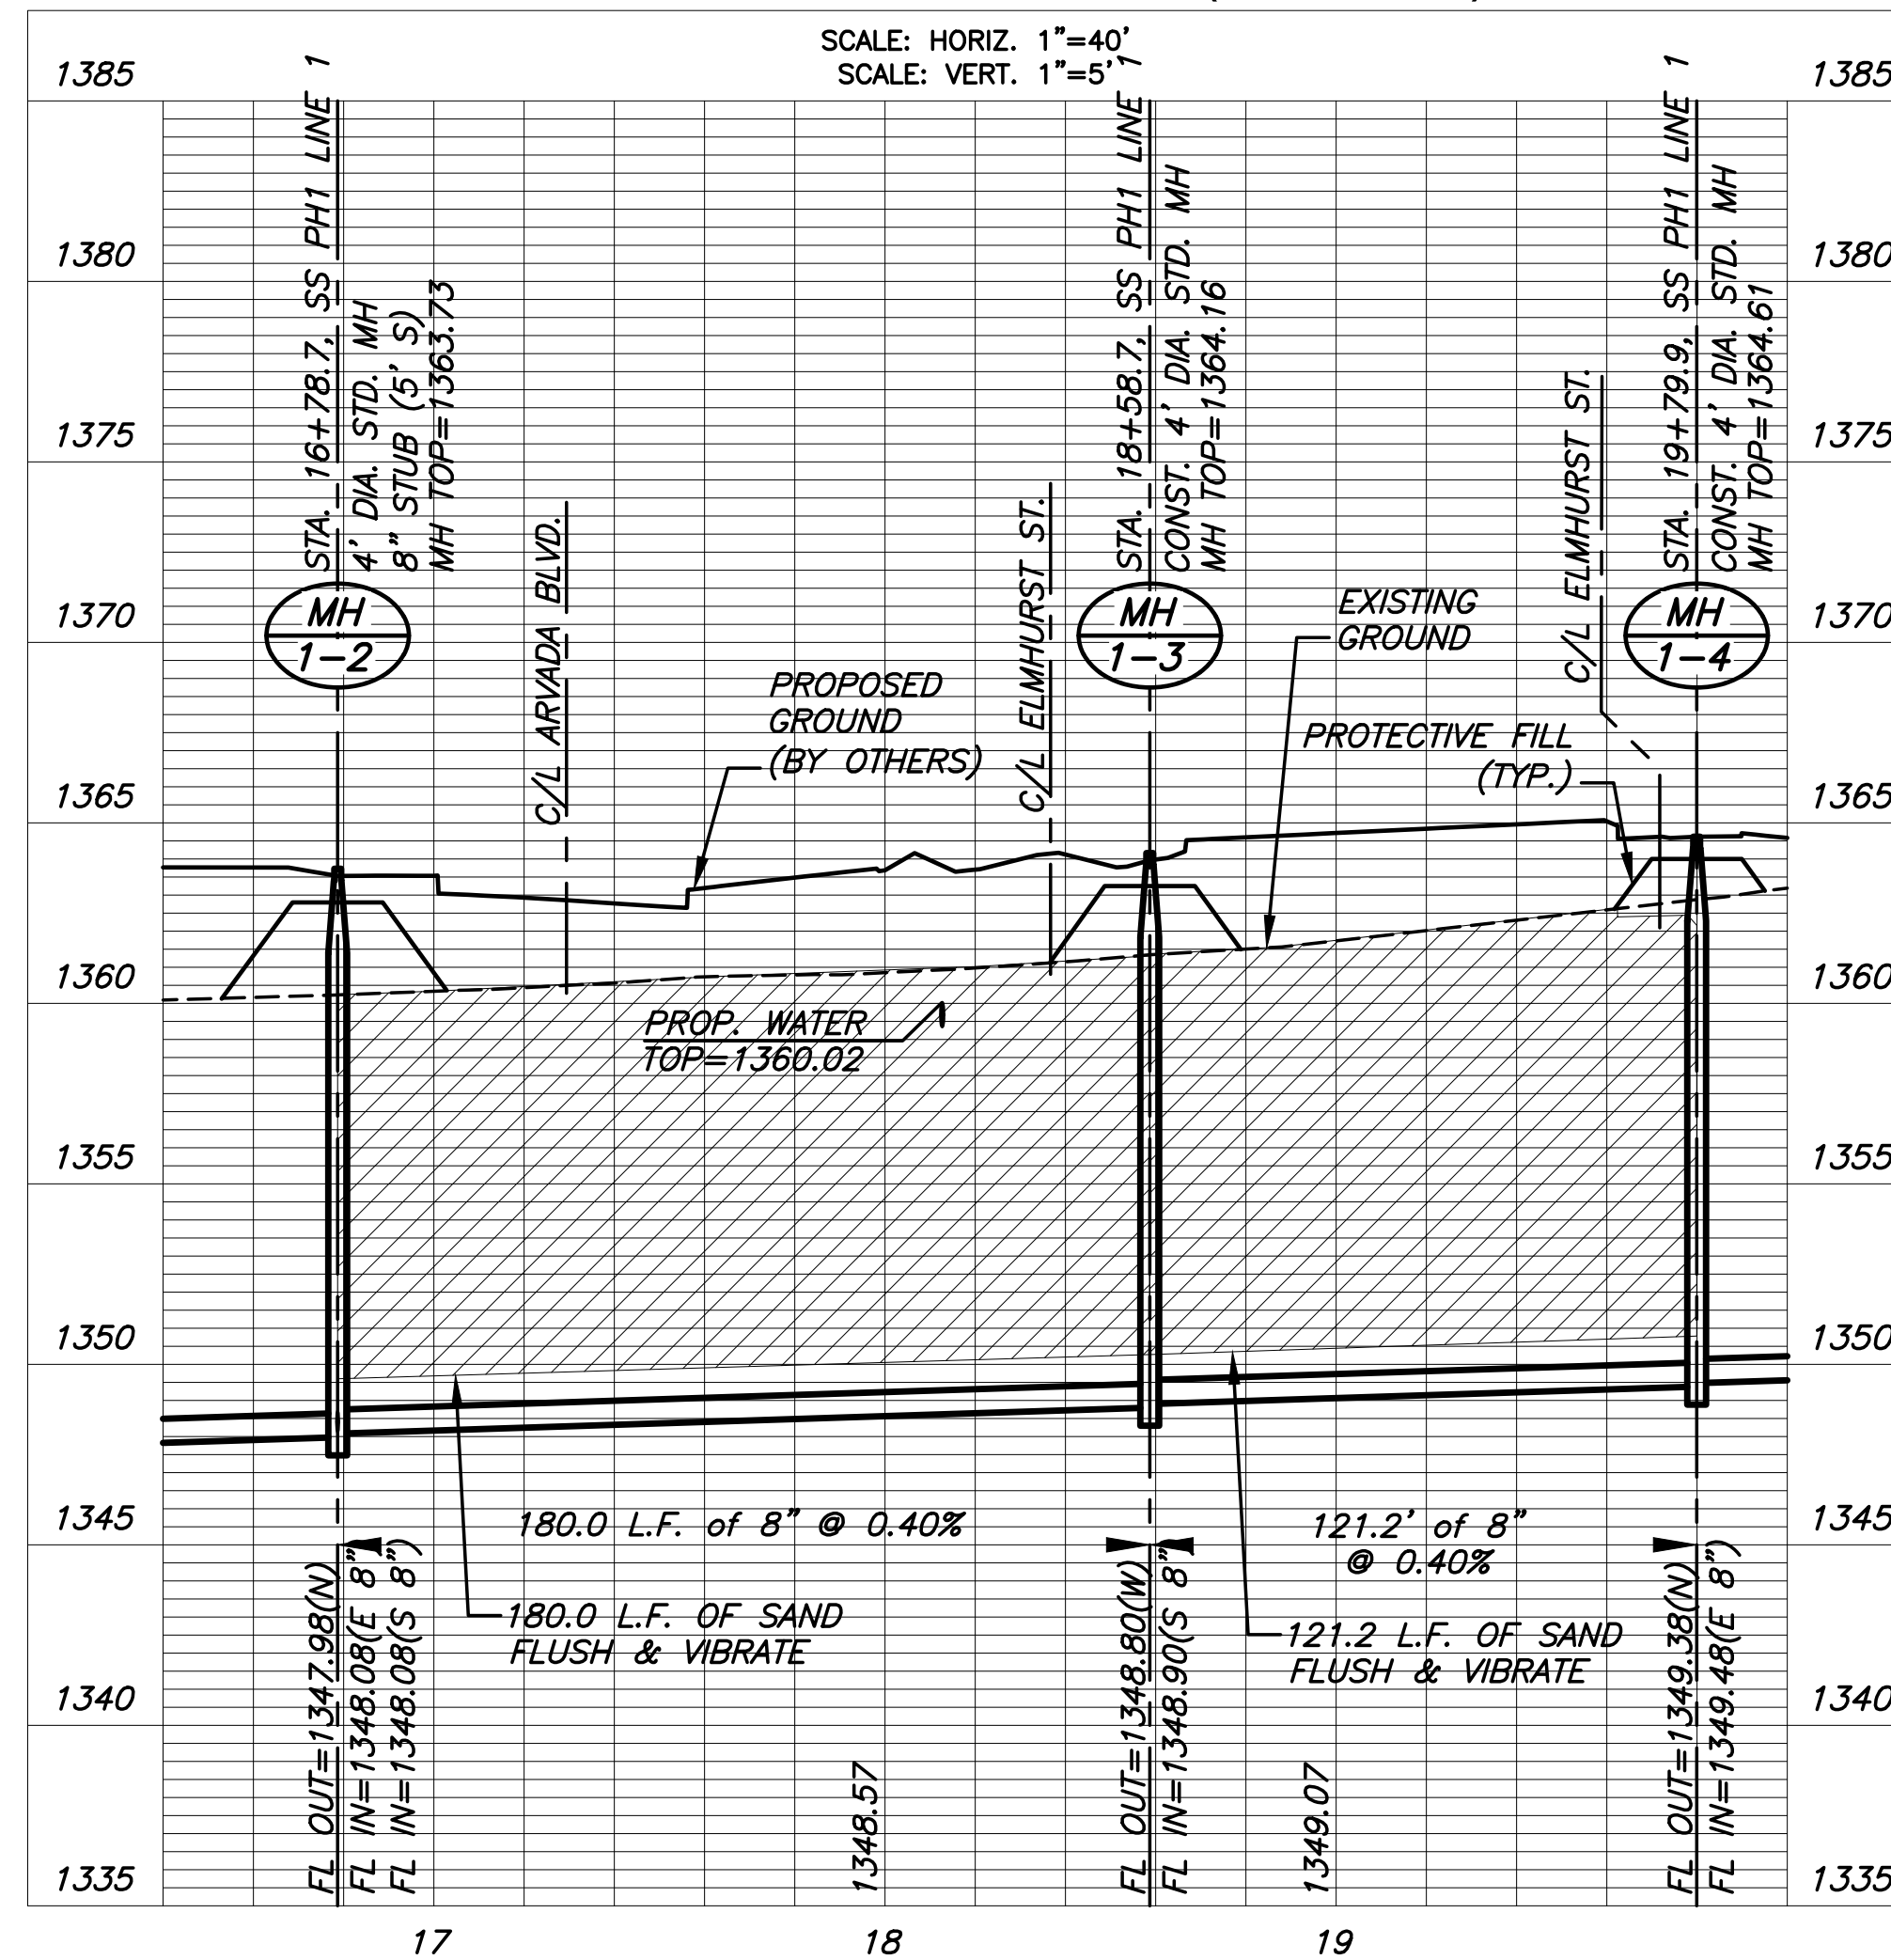

©2022
MKEC Engineering
All Rights Reserved
www.mkec.com
These drawings and their contents, including, but not limited to, all concepts, designs, & ideas are the exclusive property of MKEC Engineering (MKEC), and may not be used or reproduced in any way without the express consent of MKEC.

LINE 1 (CONT. 1)

PROJECT NO.	468-2022-024784	
DATE	NOV 2022	
SCALE	1"=40'	
DESIGNED	DRAWN	CHECKED
DFL	LAL	SPE

NO.	REVISION	DATE

©2022
MKEC Engineering
All Rights Reserved
www.mkec.com
These drawings and their contents, including, but not limited to, all concepts, designs, & ideas are the exclusive property of MKEC Engineering (MKEC), and may not be used or reproduced in any way without the express consent of MKEC.


LINE 1 (CONT. 2)

PROJECT NO.	468-2022-024784	
DATE	NOV 2022	
SCALE	1"=40'	
DESIGNED	DRAWN	CHECKED
DFL	LAL	SPE



NO.	REVISION	DATE

SHEET NO.


J:\PROJECTS\2020\01\0708_MPH_1\19THHAND37THDEVELOPMENT\SERVICES\00\02788 CAD\SH\1505 CIVIL\SANISAN PH 1\202008-05-2201 PH1.DWG
 PLOTTED: Friday, November 04, 2022 @ 08:23AM

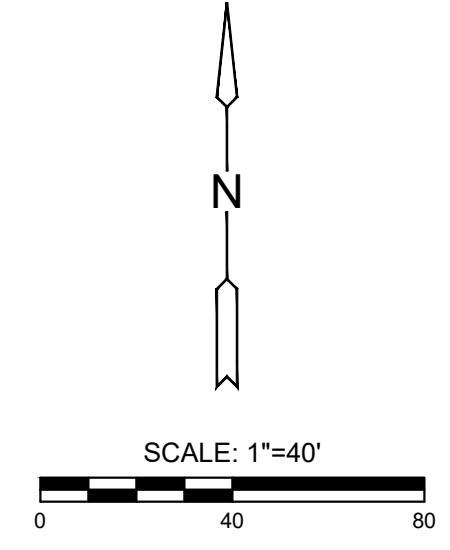


NOTE:
CONTRACTOR TO VERIFY THE DEPTH AND LOCATION OF EXISTING UTILITIES PRIOR TO CONSTRUCTION.

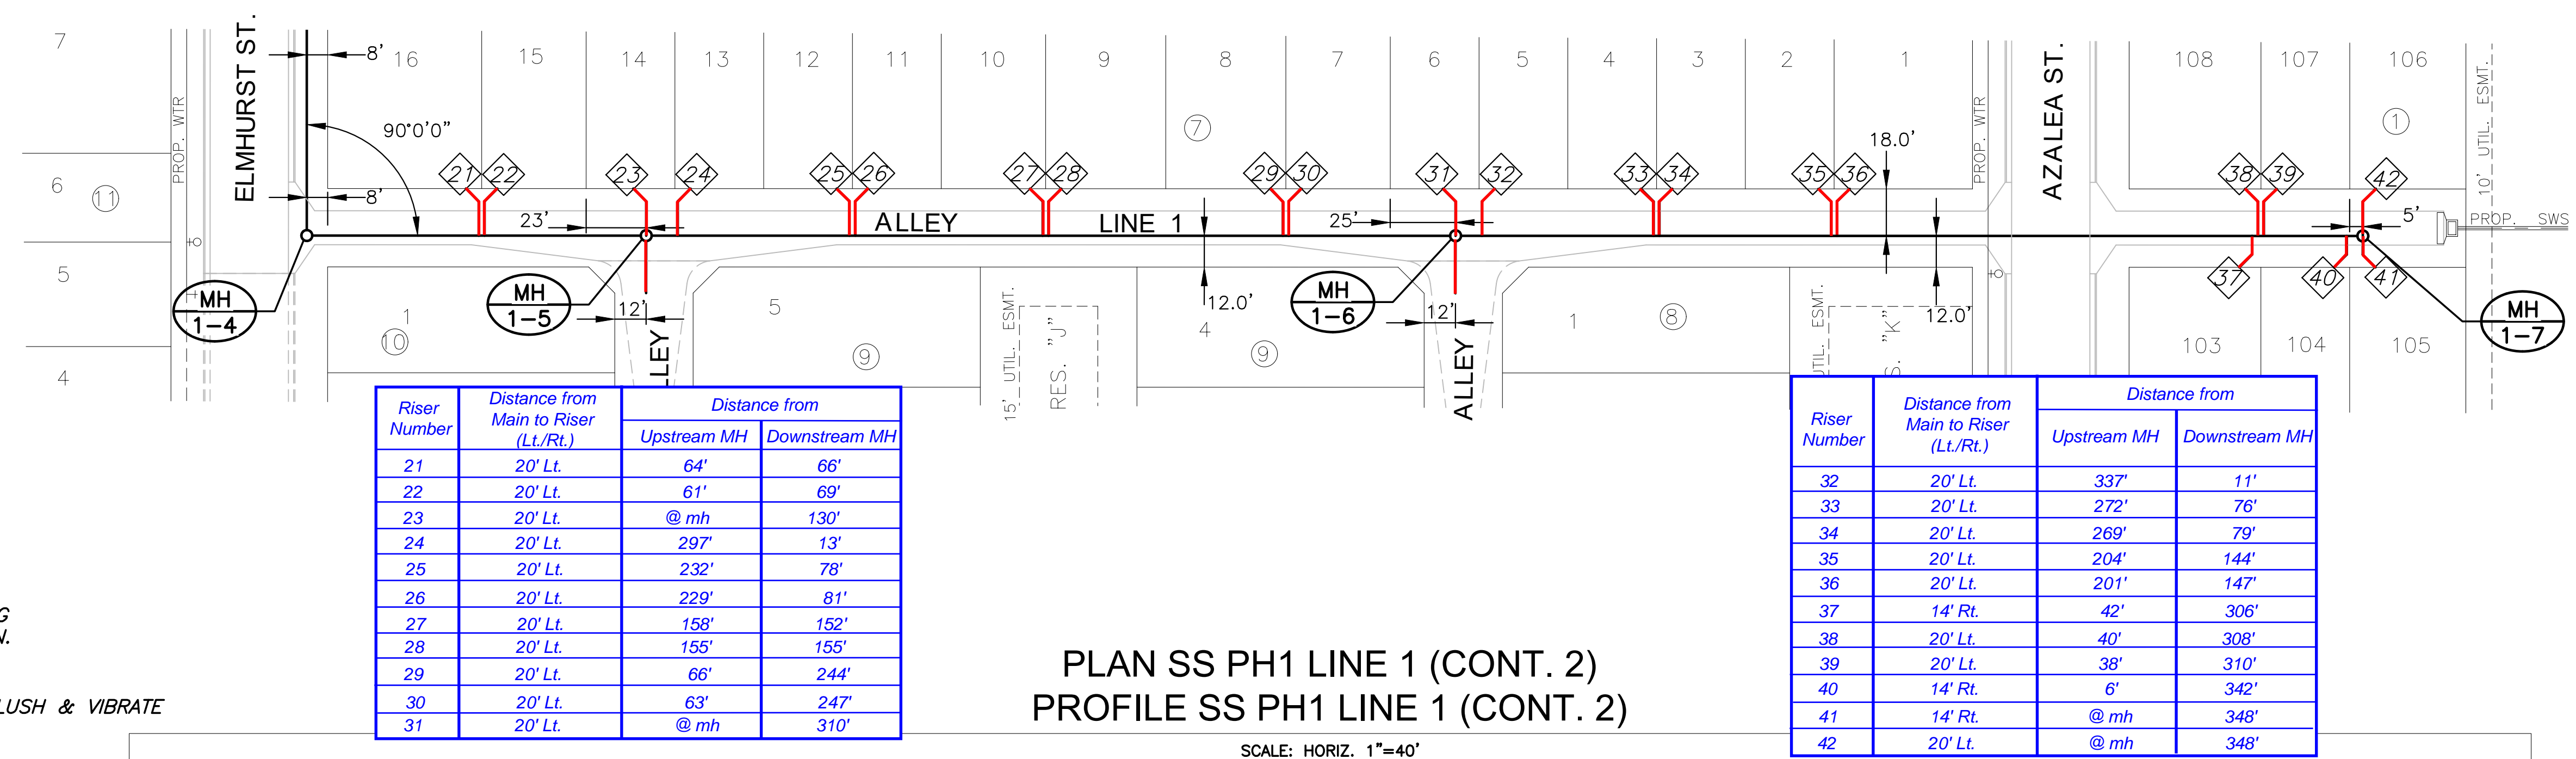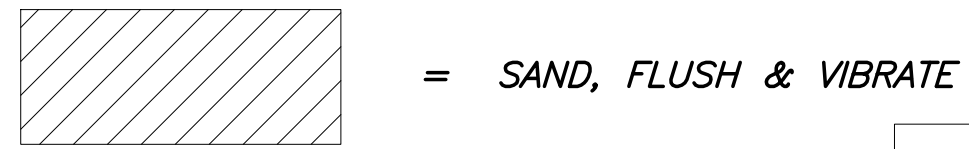


PLAN SS PH1 LINE 1 (CONT. 2)
PROFILE SS PH1 LINE 1 (CONT. 2)

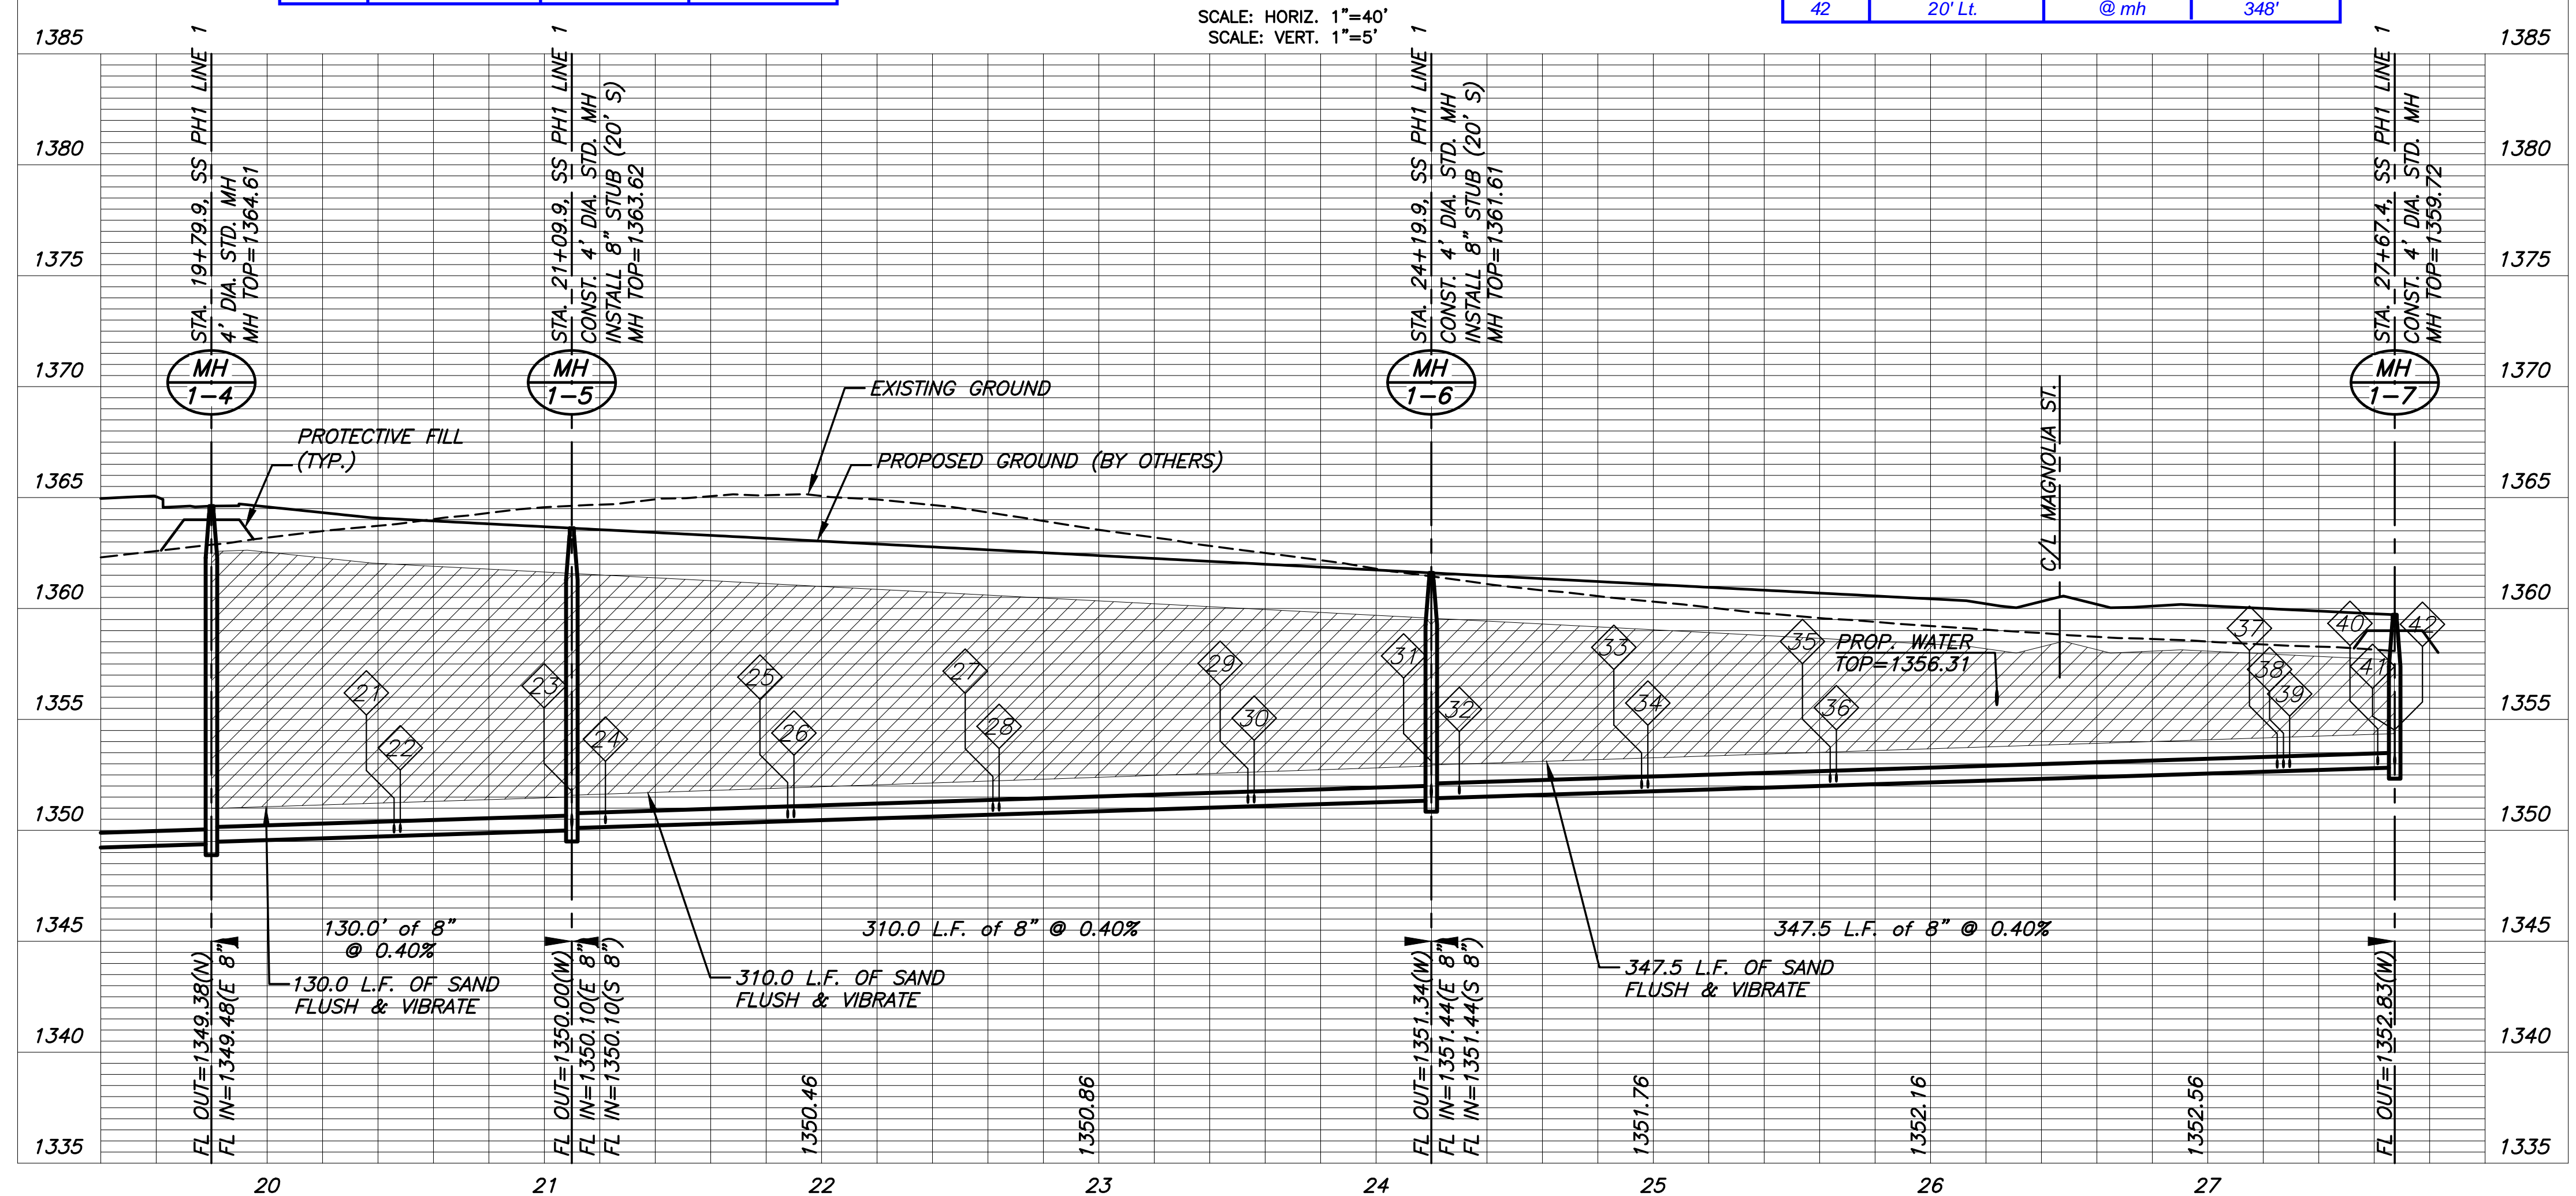

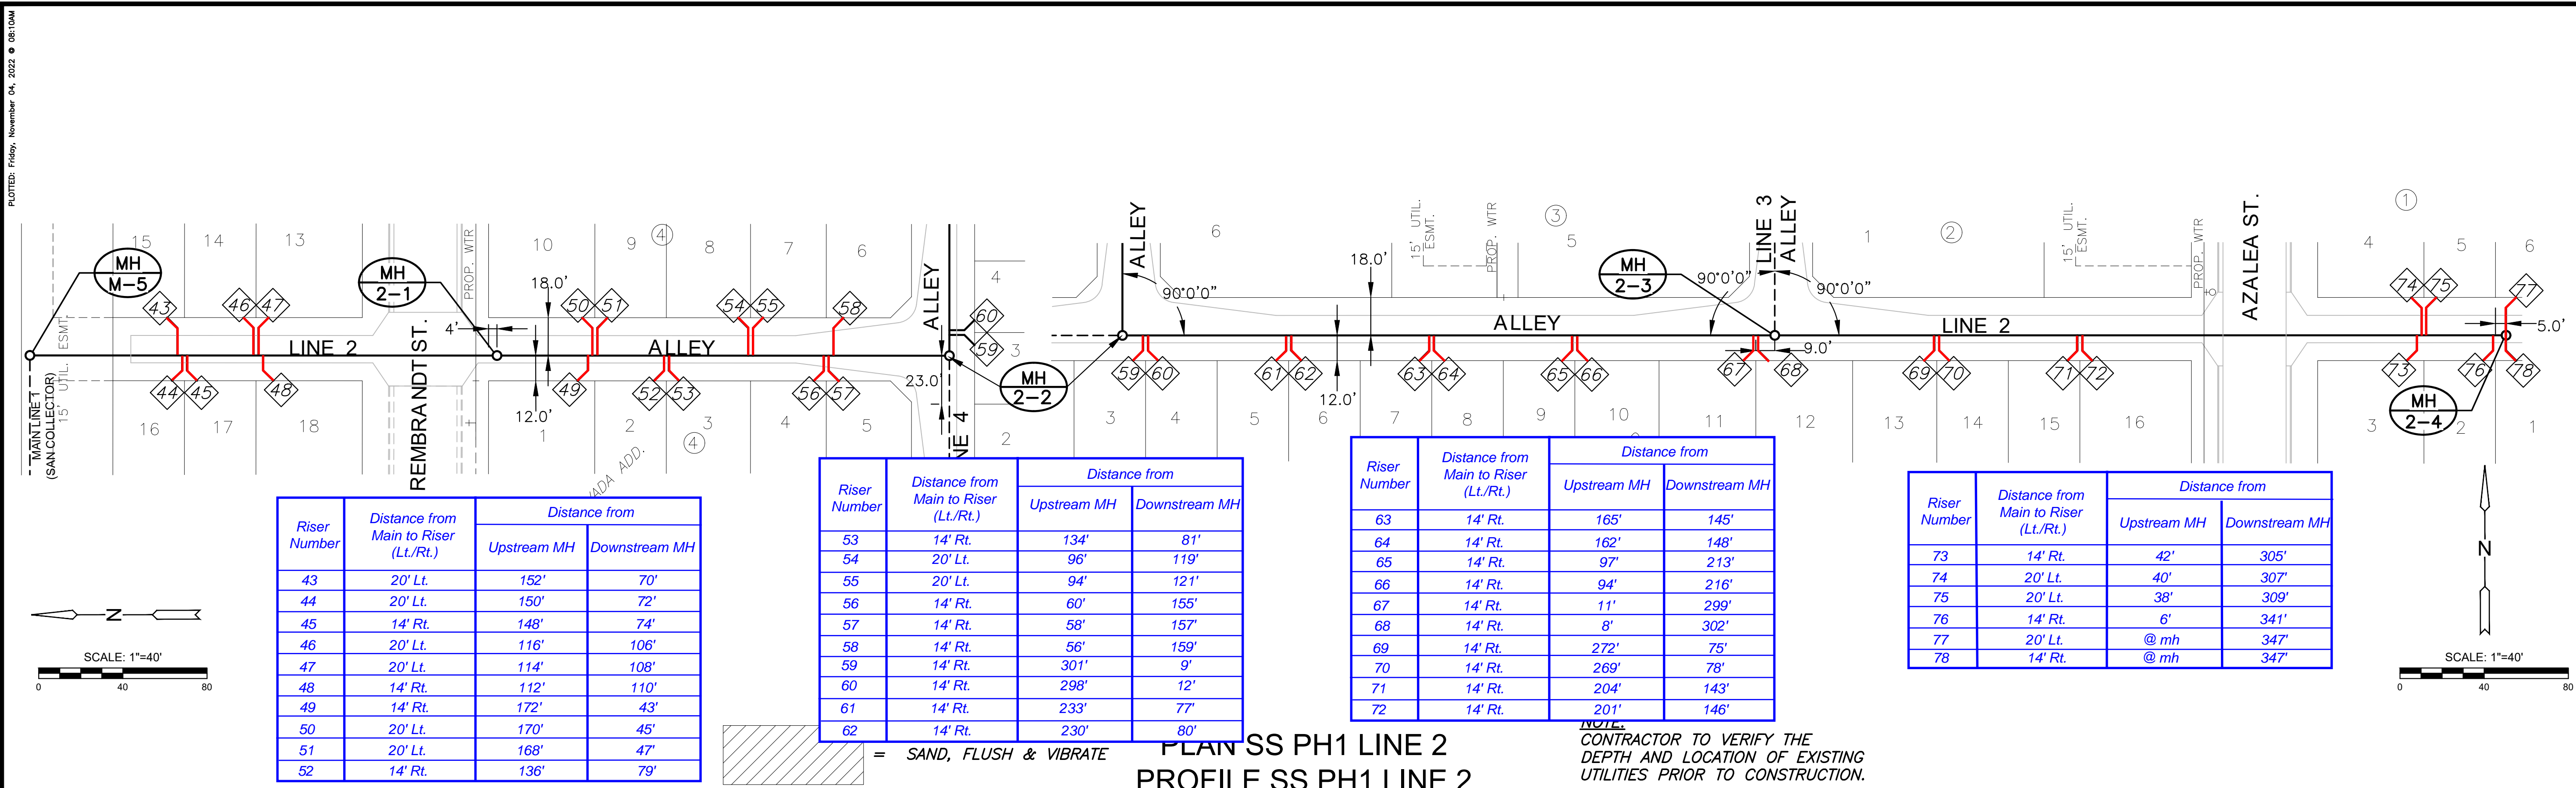

NOTE: CONTRACTOR TO VERIFY THE DEPTH AND LOCATION OF EXISTING UTILITIES PRIOR TO CONSTRUCTION.

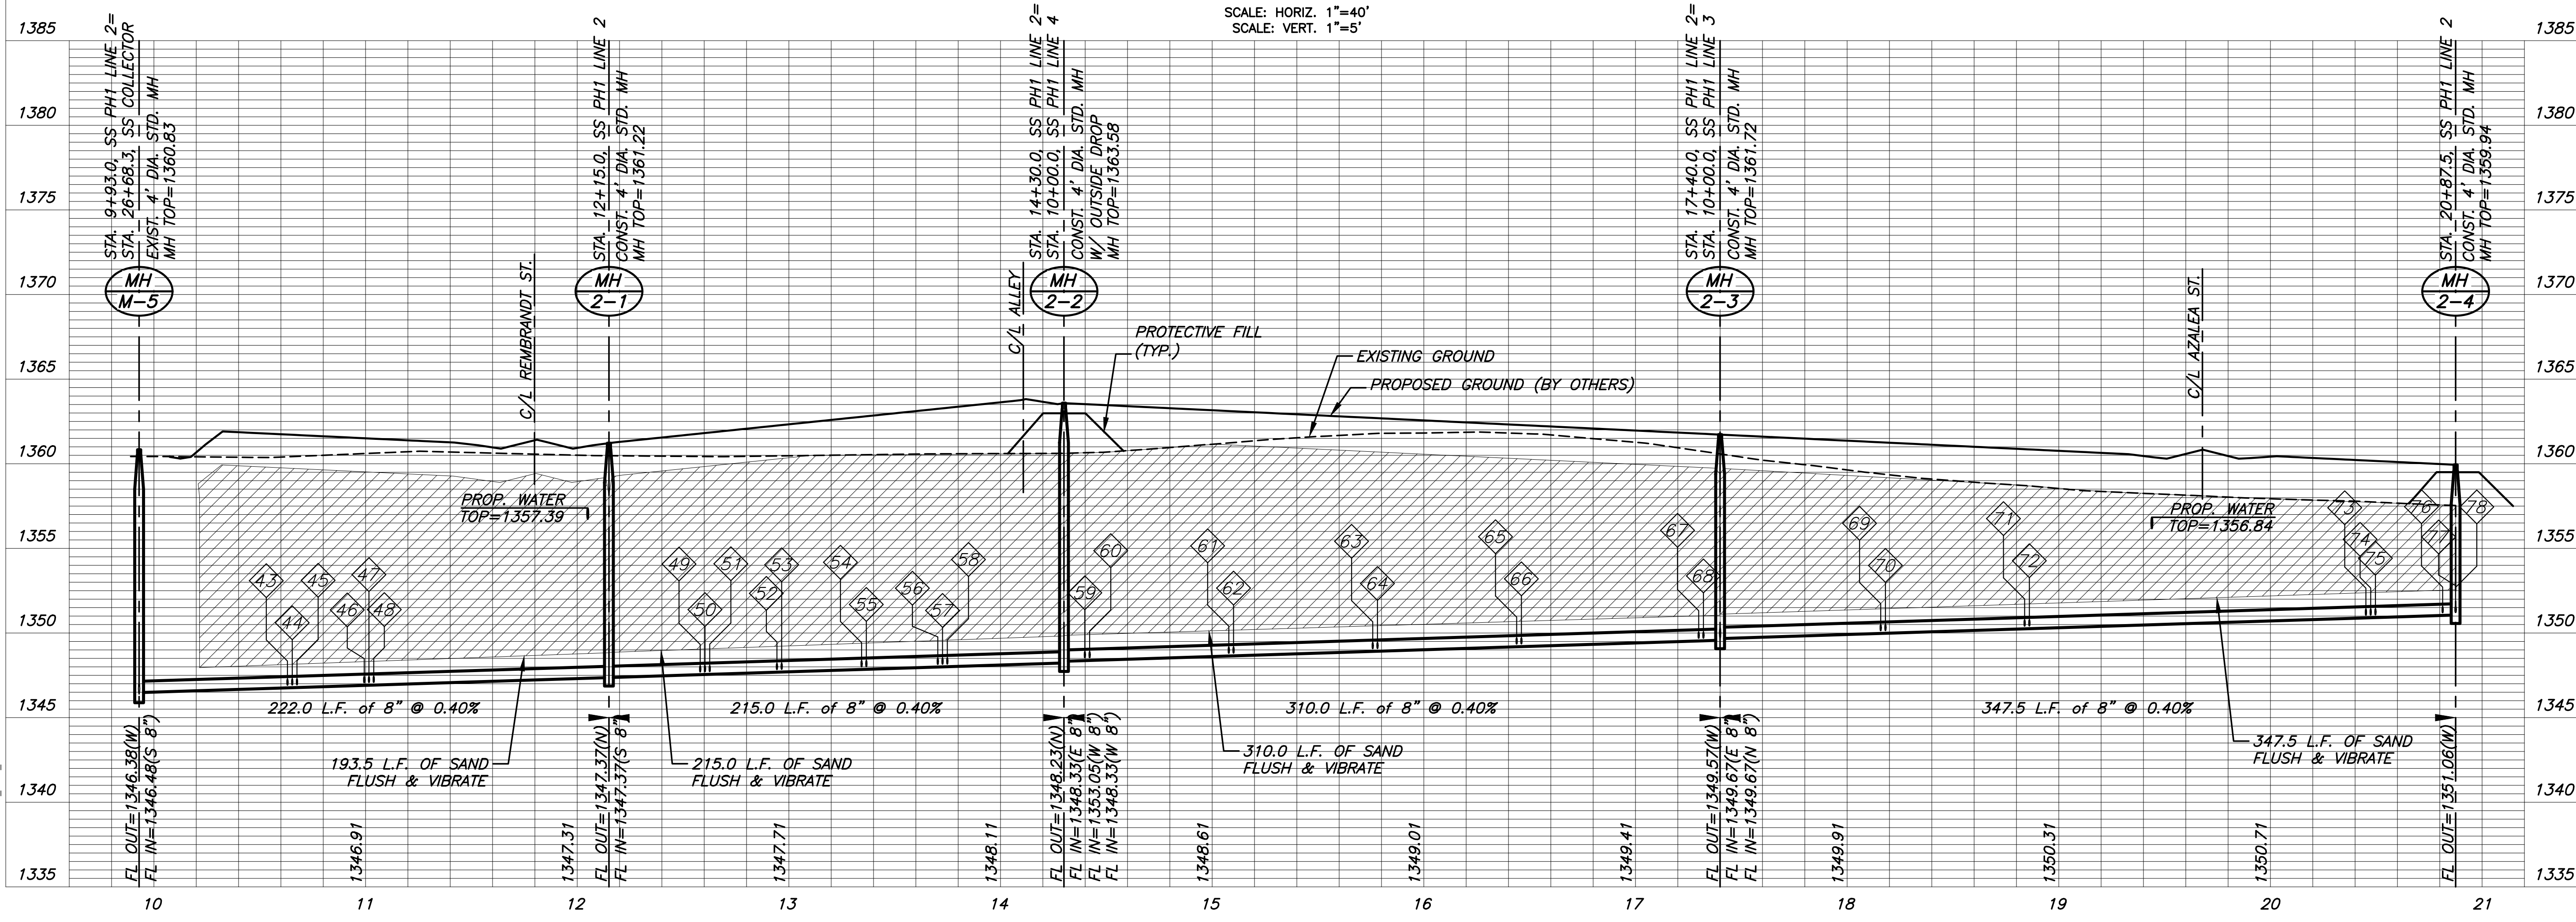

©2022 MKEC Engineering All Rights Reserved www.mkec.com
These drawings and their contents, including, but not limited to, all concepts, designs, & ideas are the exclusive property of MKEC Engineering (MKEC), and may not be used or reproduced in any way without the express consent of MKEC.

LINE 2	
PROJECT NO.	468-2022-024784
DATE	NOV 2022
SCALE	1"=40'
DESIGNED	DRAWN
DFL	LAL
CHECKED	SPE
NO.	REVISION
DATE	
SHEET NO. 08 OF 17	


©2022
MKEC Engineering
All Rights Reserved
www.mkec.com
These drawings and their contents, including, but not limited to, all concepts, designs, & ideas are the exclusive property of MKEC Engineering (MKEC), and may not be used or reproduced in any way without the express consent of MKEC.

LINES 3 & 4


PROJECT NO.	468-2022-024784	
DATE	NOV 2022	
SCALE	1"=40'	
DESIGNED	DRAWN	CHECKED
DFL	LAL	SPE

NO.	REVISION	DATE




J:\PROJECTS\2022\01\10708_MPH_1197\HAND37TH DEVELOPMENT SERV\ICES\00 02788 CAD\SH15\05 CIVIL\SANITARY PH 1\202708-05-2023 PH1.DWG
 PLOTTED: Friday, November 04, 2022 @ 08:11 AM

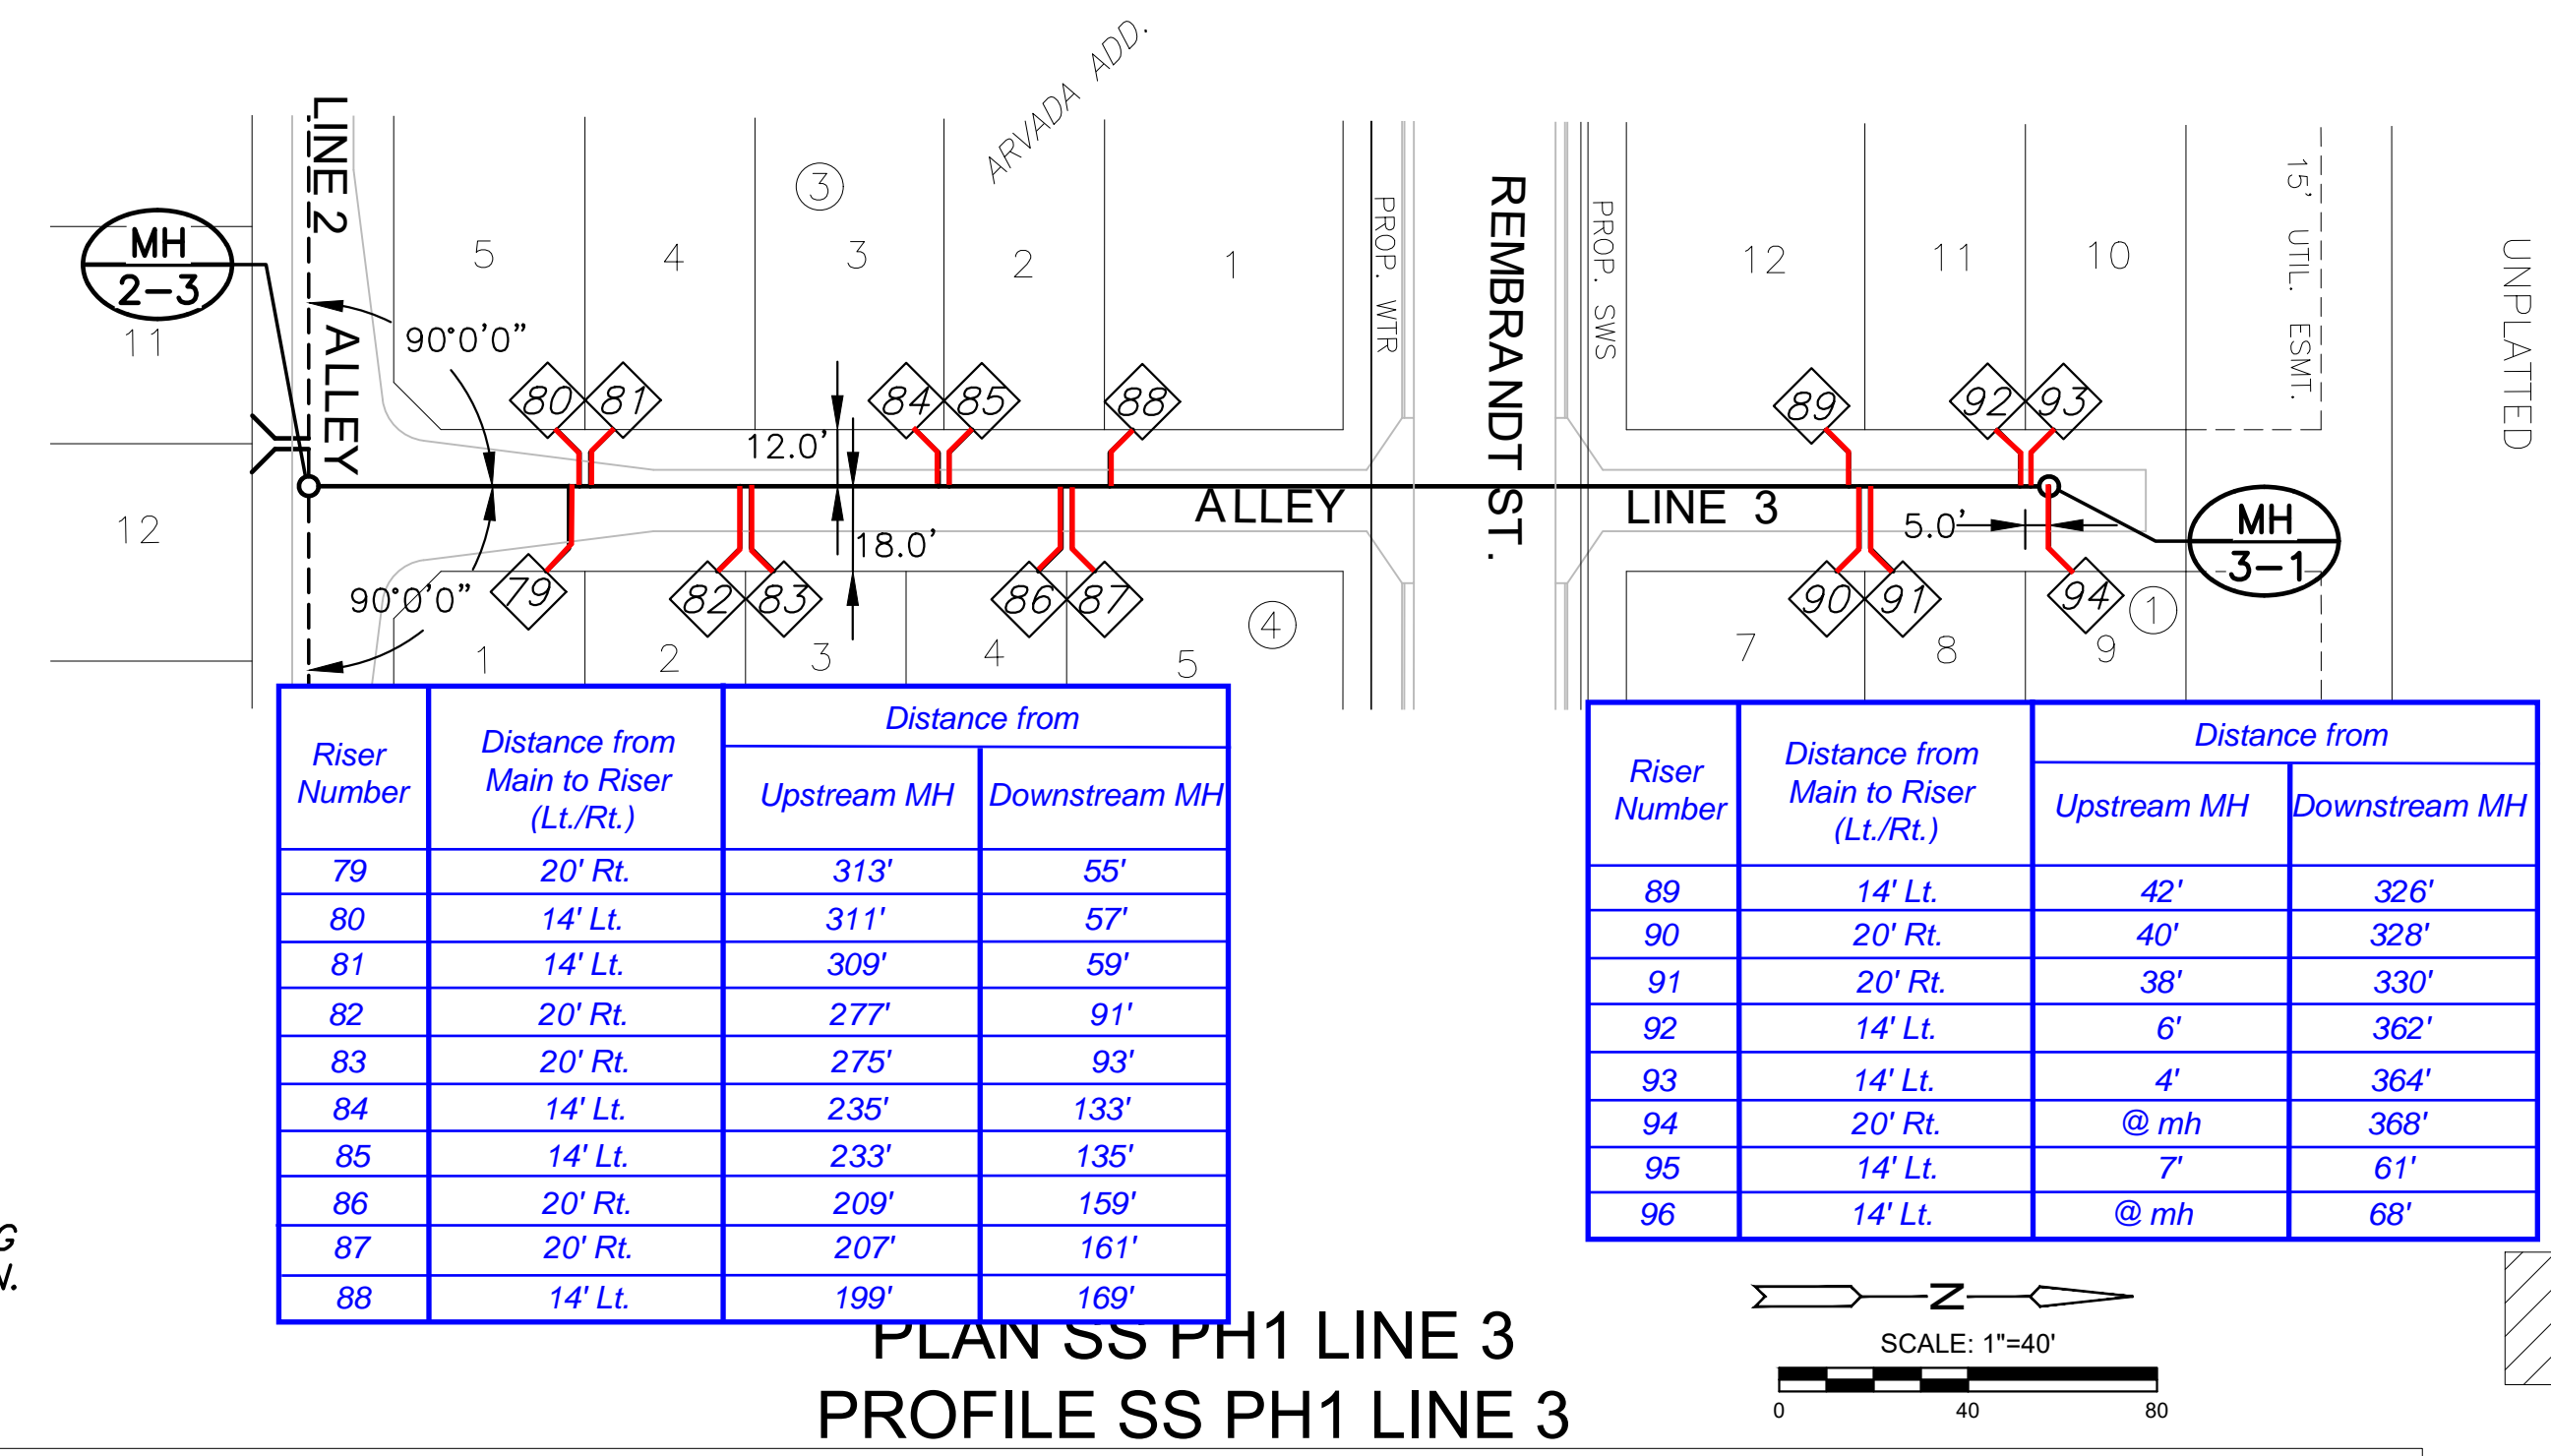

NOTE:
CONTRACTOR TO VERIFY THE DEPTH AND LOCATION OF EXISTING UTILITIES PRIOR TO CONSTRUCTION.

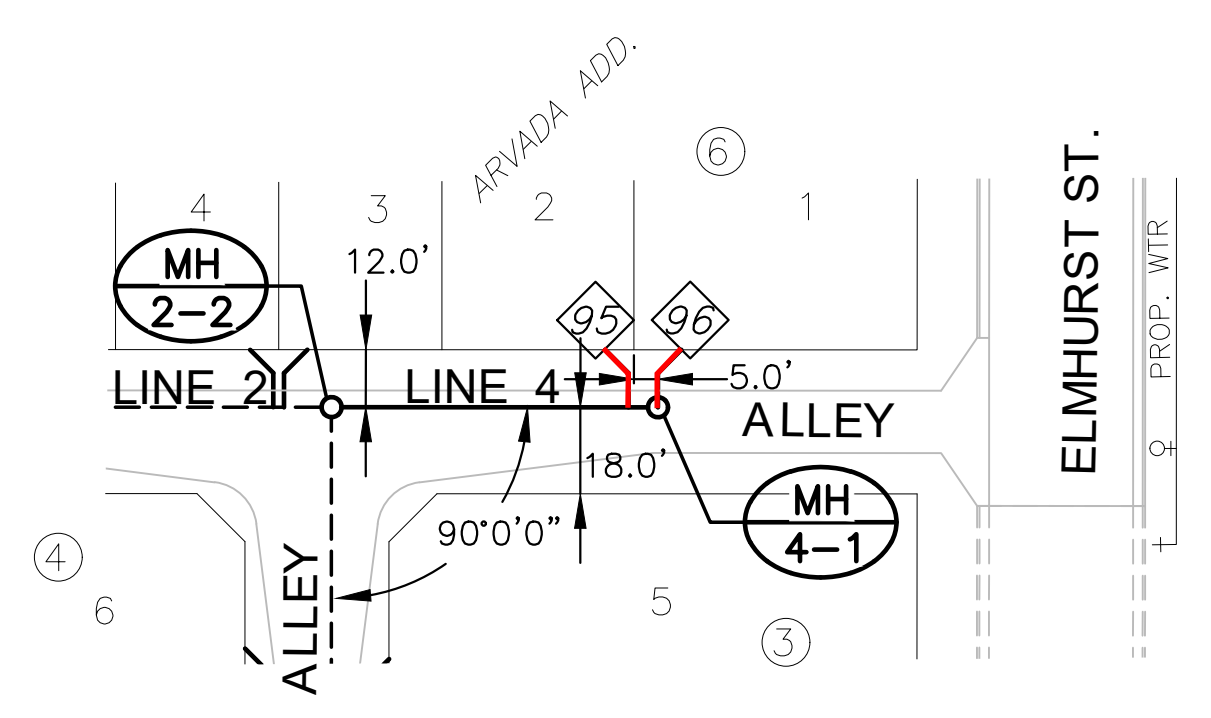


**PLAN SS PH1 LINE 4
PROFILE SS PH1 LINE 4**

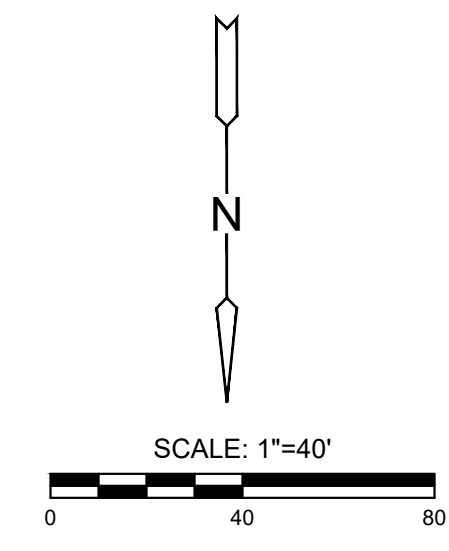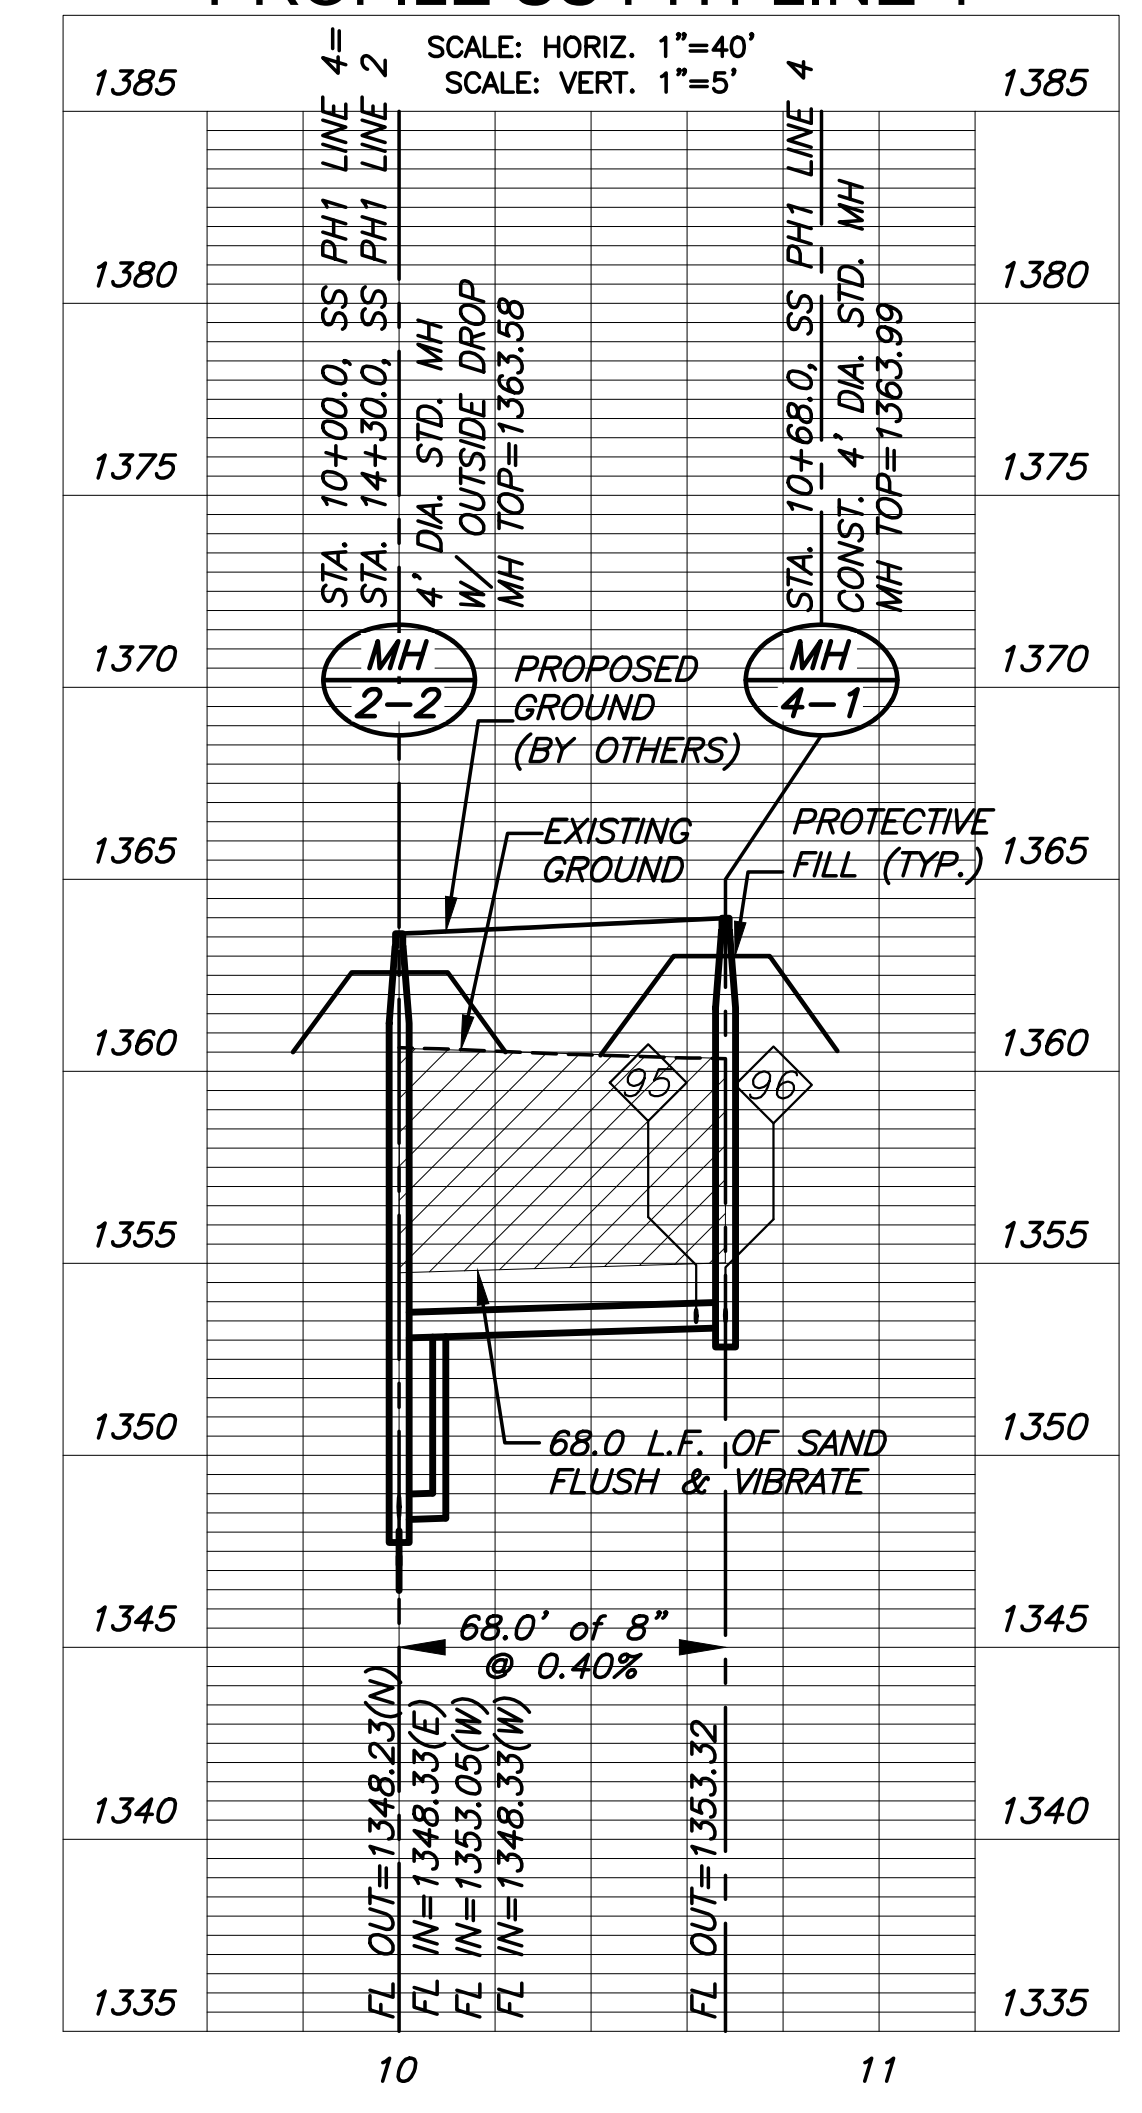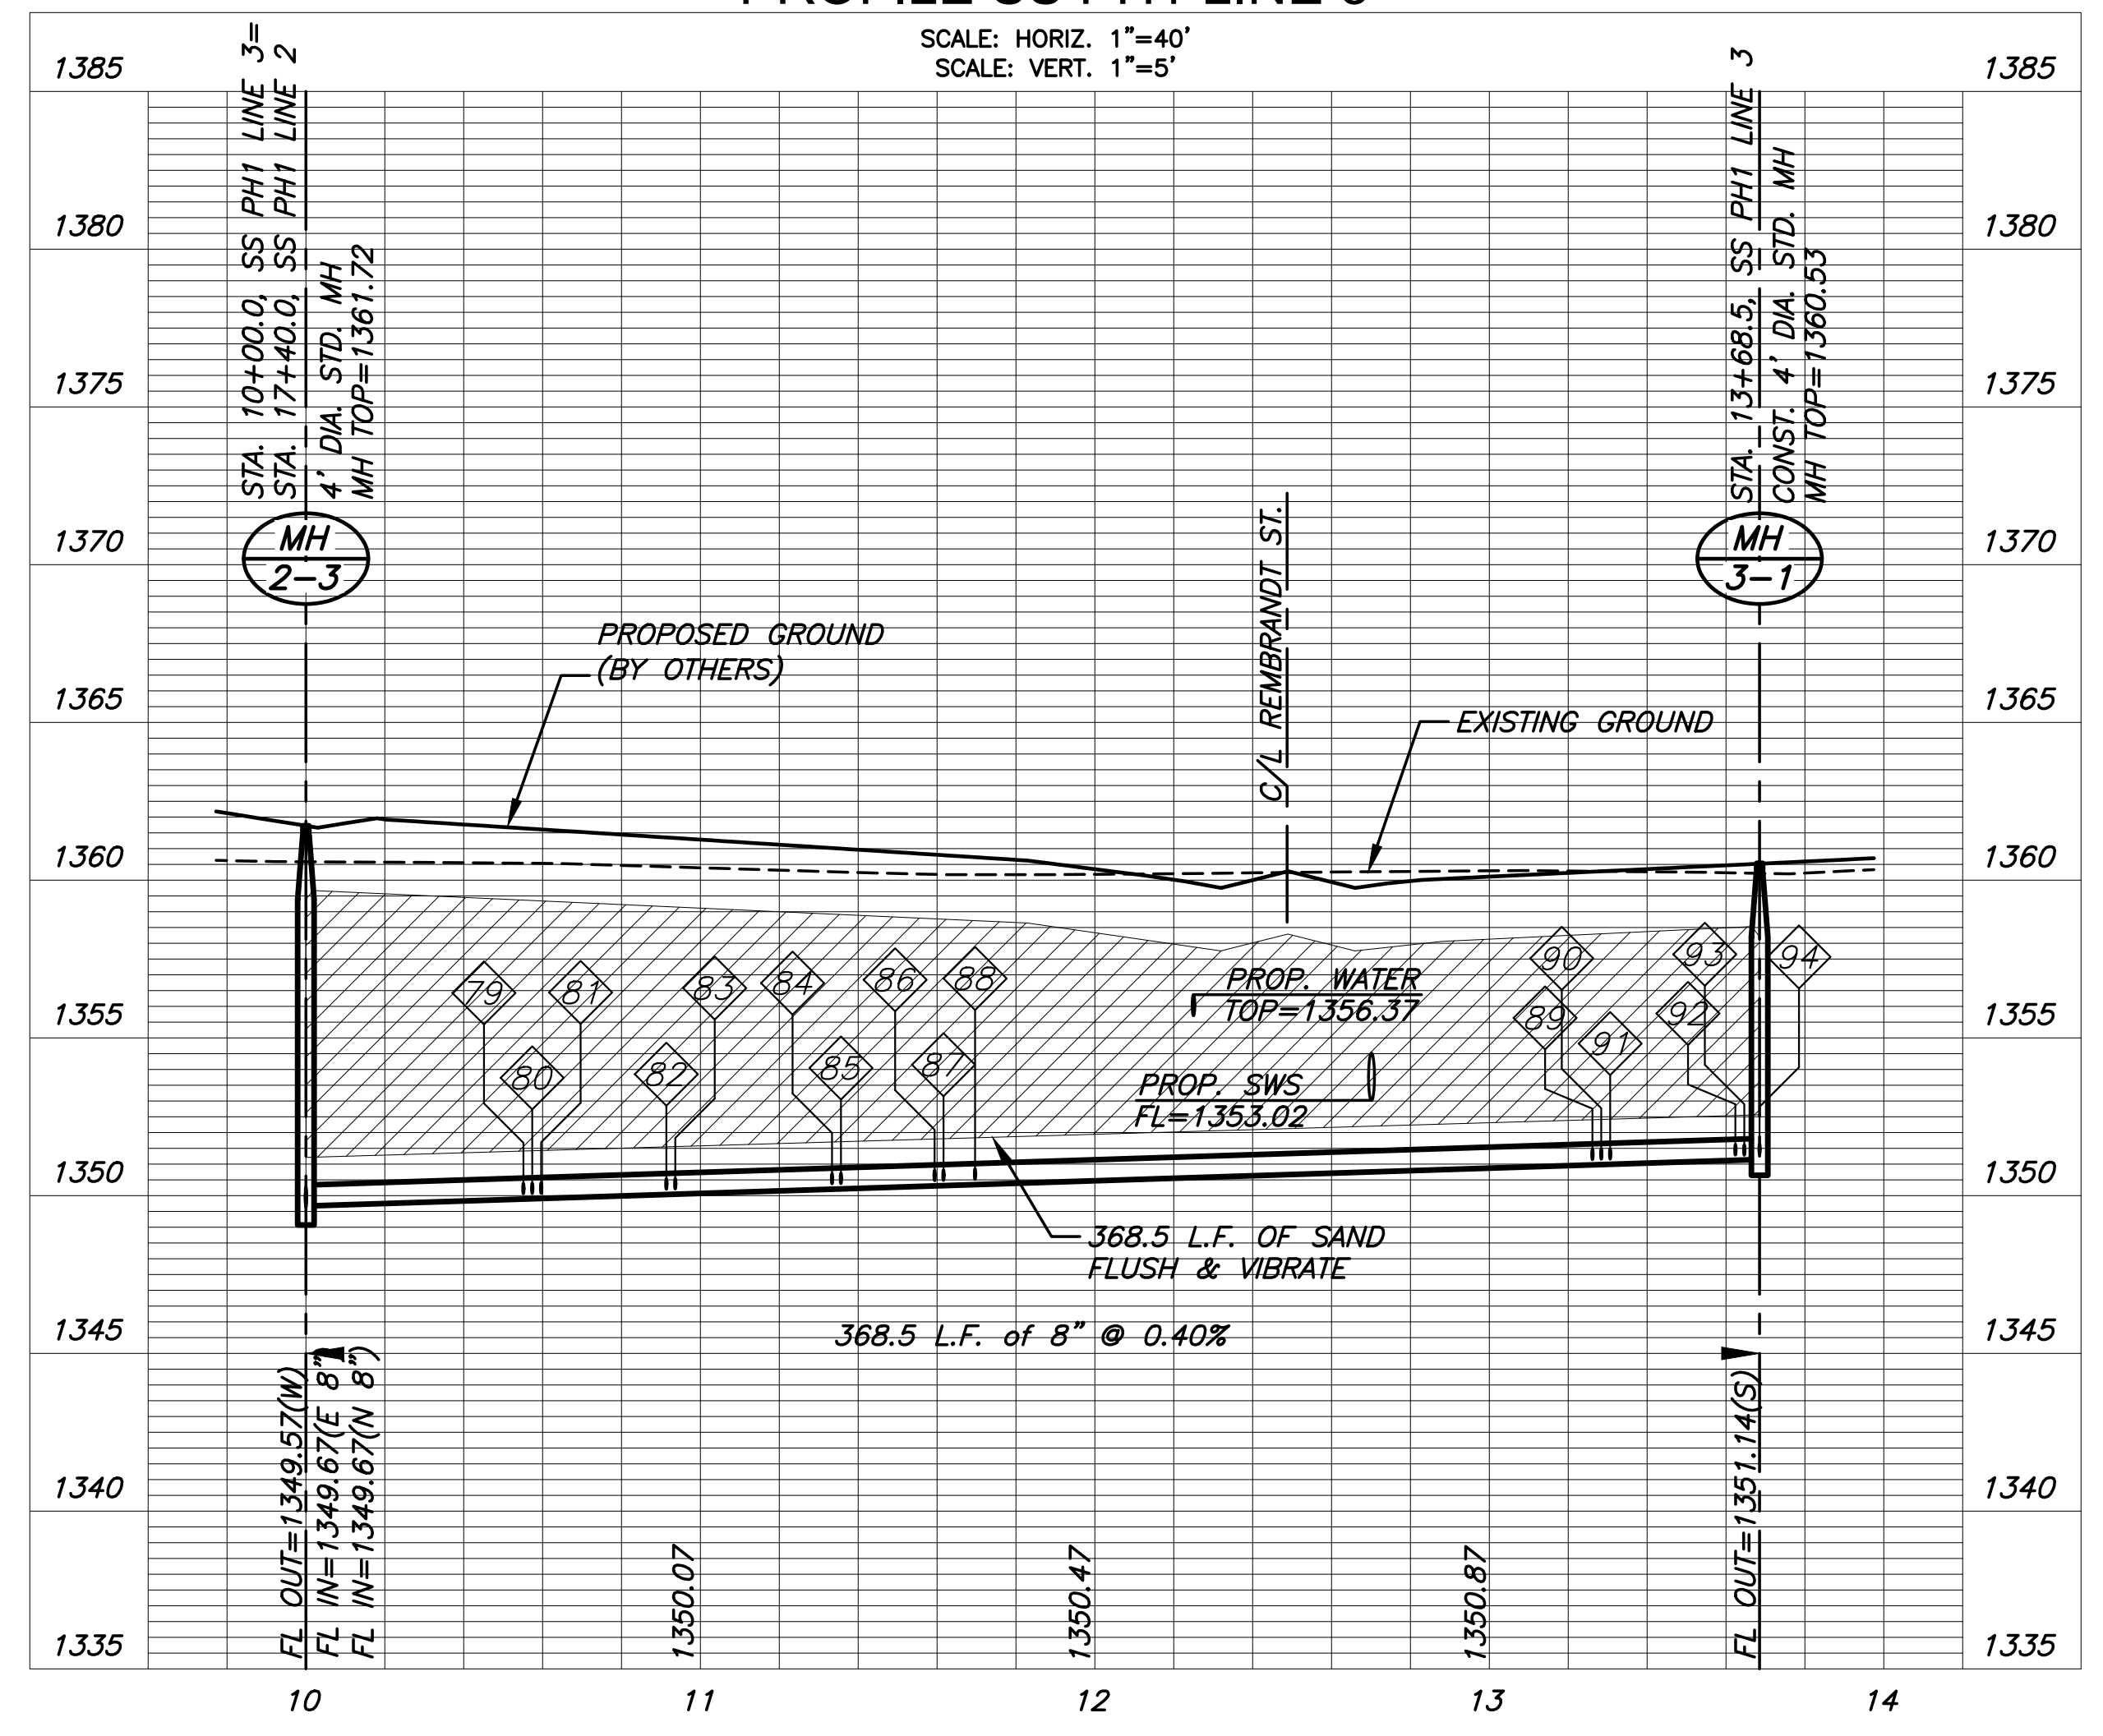

J:\PROJECTS\2020\20201010708_MPH_119TH\HAND37TH DEVELOPMENT SERVICES\00 02708 CAD\SHS\05 CIVIL\ANSAN PH 120708-05-201 PH I.DWG
 PLOTTED: Friday, November 04, 2022 @ 08:17 AM

SEWER SERVICE RISER TABLE						FOR INFORMATION ONLY		
NO.	TYPE	LOCATION			STATION	DIRECTION	APPROXIMATE LENGTH	
		LOT NO.	BLOCK NO.	LINE NO.			VERTICAL (FT)	HORIZONTAL (FT)
1	4" TEE	21	1	1	10+63.03	LT	15.7'	20'
2	4" TEE	22	1	1	10+65.28	RT	15.7'	14'
3	4" TEE	23	1	1	10+67.53	RT	15.7'	14'
4	4" TEE	20	1	1	10+99.28	LT	15.4'	20'
5	4" TEE	19	1	1	11+01.53	LT	15.3'	20'
6	4" TEE	24	1	1	11+03.78	RT	15.3'	14'
7	4" TEE	1	5	1	12+58.03	LT	14.8'	20'
8	4" TEE	7	14	1	12+60.28	RT	14.8'	14'
9	4" TEE	6	14	1	12+62.53	RT	14.8'	14'
10	4" TEE	2	5	1	12+94.28	LT	15.0'	20'
11	4" TEE	3	5	1	12+96.53	LT	15.0'	20'
12	4" TEE	5	14	1	13+28.28	RT	15.1'	14'
13	4" TEE	4	14	1	13+30.53	RT	15.1'	14'
14	4" TEE	4	5	1	13+80.28	LT	15.2'	20'
15	4" TEE	5	5	1	13+82.53	LT	15.2'	20'
16	4" TEE	3	14	1	13+96.28	RT	15.3'	14'
17	4" TEE	2	14	1	13+98.53	RT	15.3'	14'
18	4" TEE	1	14	1	14+32.53	RT	15.3'	14'
19	4" TEE	6	5	1	14+54.28	LT	15.1'	20'
20	4" TEE	7	5	1	14+56.53	LT	15.1'	20'
21	4" TEE	16	7	1	20+45.78	LT	13.8'	20'
22	4" TEE	15	7	1	20+48.03	LT	13.8'	20'
23	4" MH CONNECTION	14	7	1	21+09.91	LT	13.1'	20'
24	4" TEE	13	7	1	21+22.03	LT	12.9'	20'
25	4" TEE	12	7	1	21+87.78	LT	12.2'	20'
26	4" TEE	11	7	1	21+90.03	LT	12.2'	20'
27	4" TEE	10	7	1	22+61.78	LT	11.4'	20'
28	4" TEE	9	7	1	22+64.03	LT	11.4'	20'
29	4" TEE	8	7	1	23+53.78	LT	10.5'	20'
30	4" TEE	7	7	1	23+56.03	LT	10.5'	20'
31	4" MH CONNECTION	6	7	1	24+19.91	LT	9.7'	20'
32	4" TEE	5	7	1	24+30.03	LT	9.6'	20'
33	4" TEE	4	7	1	24+95.78	LT	8.9'	20'
34	4" TEE	3	7	1	24+98.03	LT	8.9'	20'
35	4" TEE	2	7	1	25+63.78	LT	8.2'	20'
36	4" TEE	1	7	1	25+66.03	LT	8.2'	20'
37	4" TEE	103	1	1	27+25.03	RT	6.8'	14'
38	4" TEE	108	1	1	27+27.28	LT	6.8'	20'
39	4" TEE	107	1	1	27+29.53	LT	6.8'	20'
40	4" TEE	104	1	1	27+61.28	RT	6.5'	14'
41	4" MH CONNECTION	105	1	1	27+67.41	RT	6.4'	14'
42	4" MH CONNECTION	106	1	1	27+67.41	LT	6.4'	20'
43	4" TEE	15	1	2	10+63.10	LT	14.5'	20'
44	4" TEE	16	1	2	10+65.35	RT	14.5'	14'
45	4" TEE	17	1	2	10+67.60	RT	14.5'	14'
46	4" TEE	14	1	2	10+99.35	LT	14.1'	20'
47	4" TEE	13	1	2	11+01.60	LT	14.1'	20'
48	4" TEE	18	1	2	11+03.85	RT	14.1'	14'
49	4" TEE	1	4	2	12+58.10	RT	13.8'	14'
50	4" TEE	10	3	2	12+60.35	LT	13.8'	20'
51	4" TEE	9	3	2	12+62.60	LT	13.8'	20'
52	4" TEE	2	4	2	12+94.35	RT	14.1'	14'
53	4" TEE	3	4	2	12+96.60	RT	14.1'	14'
54	4" TEE	8	3	2	13+34.35	LT	14.4'	20'
55	4" TEE	7	3	2	13+36.60	LT	14.4'	20'
56	4" TEE	4	4	2	13+70.35	RT	14.8'	14'
57	4" TEE	5	4	2	13+72.59	RT	14.8'	14'
58	4" TEE	6	3	2	13+74.85	LT	14.8'	14'
59	4" TEE	3	6	2	14+39.84	RT	14.6'	14'
60	4" TEE	4	6	2	14+42.09	RT	14.6'	14'
61	4" TEE	5	6	2	15+07.84	RT	14.0'	14'
62	4" TEE	6	6	2	15+10.09	RT	14.0'	14'
63	4" TEE	7	6	2	15+75.84	RT	12.8'	14'
64	4" TEE	8	6	2	15+78.09	RT	12.8'	14'
65	4" TEE	9	6	2	16+43.84	RT	12.6'	14'
66	4" TEE	10	6	2	16+46.09	RT	12.6'	14'
67	4" TEE	11	6	2	17+29.84	RT	11.8'	14'
68	4" MH CONNECTION	12	6	2	17+32.09	RT	11.6'	14'
69	4" TEE	13	6	2	18+15.84	RT	10.8'	14'
70	4" TEE	14	6	2	18+18.09	RT	10.8'	14'
71	4" TEE	15	6	2	18+83.84	RT	10.1'	14'
72	4" TEE	16	6	2	18+86.09	RT	10.1'	14'
73	4" TEE	3	1	2	20+45.09	RT	8.8'	14'
74	4" TEE	4	1	2	20+47.34	LT	8.8'	20'
75	4" TEE	5	1	2	20+49.59	LT	8.8'	20'
76	4" TEE	2	1	2	20+81.34	RT	8.4'	14'
77	4" MH CONNECTION	6	1	2	20+87.47	LT	8.4'	20'
78	4" MH CONNECTION	1	1	2	20+87.47	RT	8.4'	14'

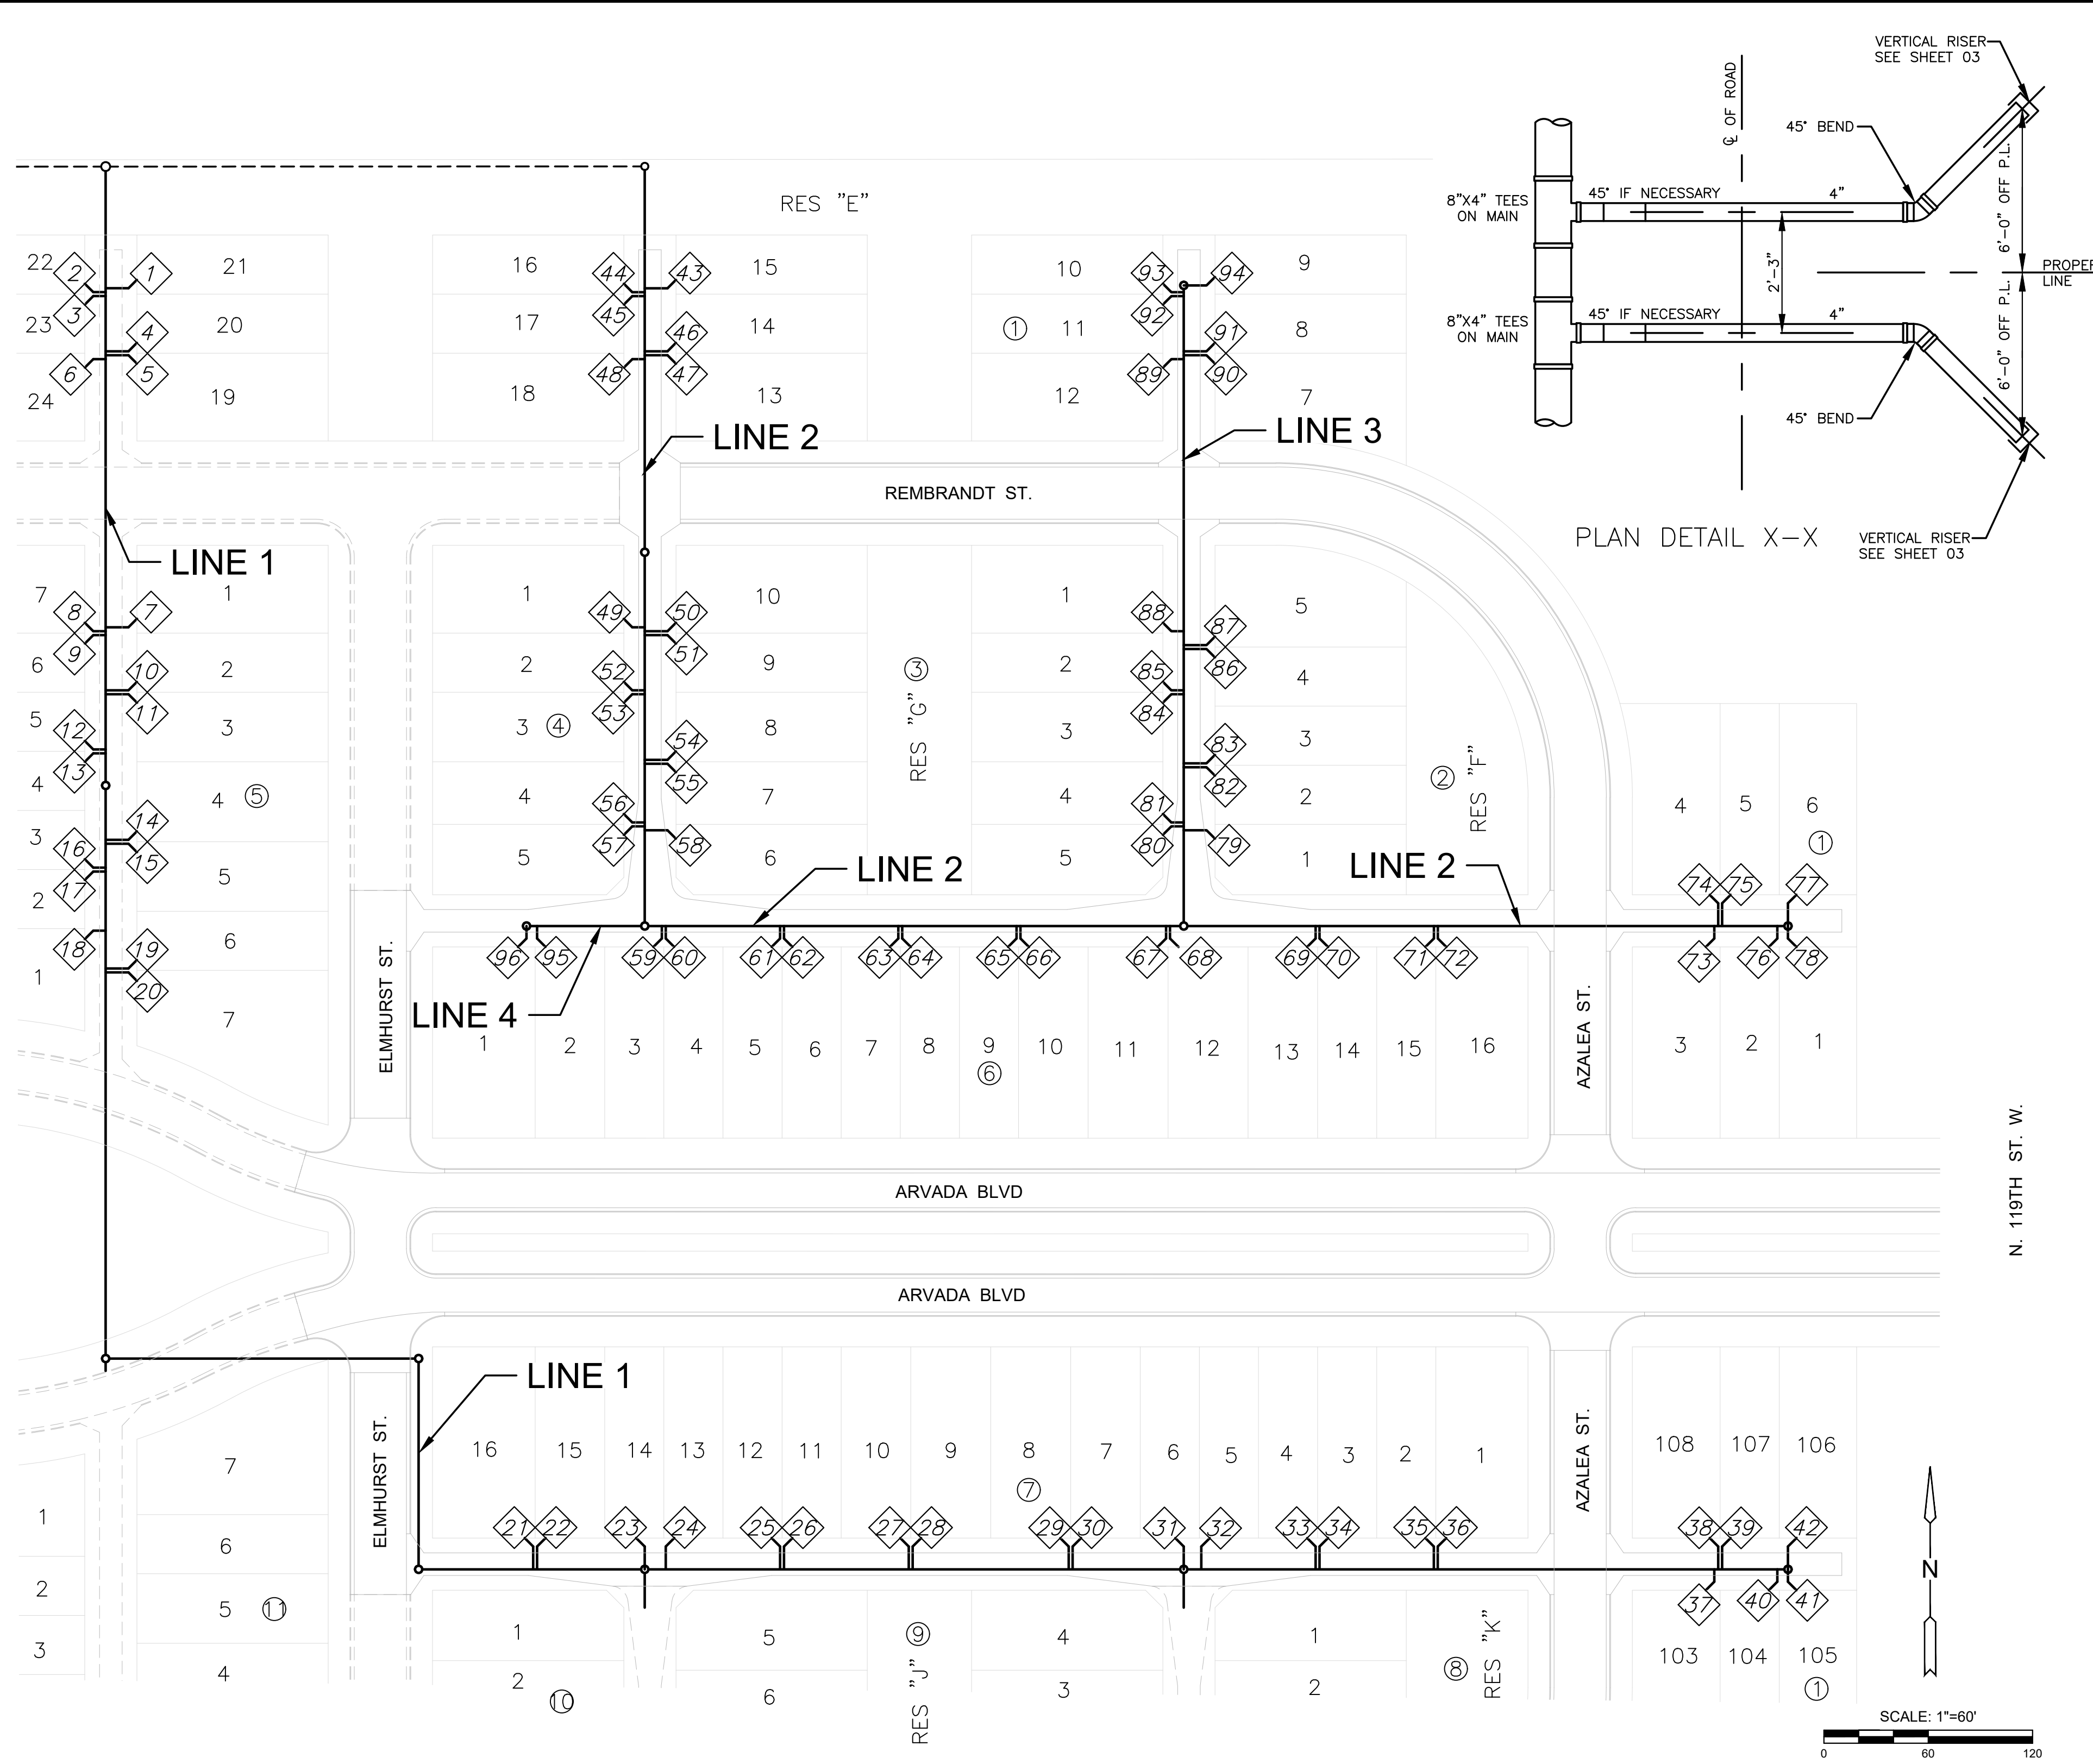

SEWER SERVICE RISER TABLE						FOR INFORMATION ONLY		
NO.	TYPE	LOCATION			STATION	DIRECTION	APPROXIMATE LENGTH	
		LOT NO.	BLOCK NO.	LINE NO.			VERTICAL (FT)	HORIZONTAL (FT)
79	4" TEE	1	2	3	10+55.12	RT	11.3'	20'
80	4" TEE	5	3	3	10+57.37	LT	11.3'	14'
81	4" TEE	4	3	3	10+59.62	LT	11.3'	14'
82	4" TEE	2	2	3	10+91.38	RT	10.8'	20'
83	4" TEE	3	2	3	10+93.63	RT	10.8'	20'
84	4" TEE	3	3	3	11+33.37	LT	10.3'	14'
85	4" TEE	2	3	3	11+35.62	LT	10.3'	14'
86	4" TEE	4	2	3	11+59.38	RT	10.0'	20'
87	4" TEE	5	2	3	11+61.63	RT	10.0'	20'

SEWER SERVICE RISER TABLE						FOR INFORMATION ONLY		
NO.	TYPE	LOCATION			STATION	DIRECTION	APPROXIMATE LENGTH	
		LOT NO.	BLOCK NO.	LINE NO.			VERTICAL (FT)	HORIZONTAL (FT)
88	4" TEE	1	3	3	11+69.62	LT	9.9'	14'
89	4" TEE	12	1	3	13+26.12	LT	8.8'	14'
90	4" TEE	7	1	3	13+28.38	RT	8.8'	20'
91	4" TEE	8	1	3	13+30.63	RT	8.8'	20'
92	4" TEE	11	1	3	13+62.37	LT	8.9'	14'
93	4" TEE	10	1	3	13+64.62	LT	8.9'	14'
94	4" MH CONNECTION	9	1	3	13+68.50	RT	8.9'	20'
95	4" TEE	2	6	4	10+61.88	LT	10.2'	14'
96	4" MH CONNECTION	1	6	4	10+68.00	LT	10.2'	14'




SANITARY SEWER PLANS FOR
ARVADA ADDITION
 PHASE 1


©2022 MKEC Engineering
 All Rights Reserved
 www.mkec.com
 These drawings and their contents, including, but not limited to, all concepts, designs, & ideas are the exclusive property of MKEC Engineering (MKEC), and may not be used or reproduced in any way without the express consent of MKEC.

RISER MAP		
PROJECT NO.	468-2022-024784	
DATE	NOV 2022	
SCALE	1"=60'	
DESIGNED	DRAWN	CHECKED
DFL	LAL	SPE
NO.	REVISION	DATE
SHEET NO.		
10 OF 17		

SANITARY SEWER PLANS FOR
ARVADA ADDITION
 PHASE 1

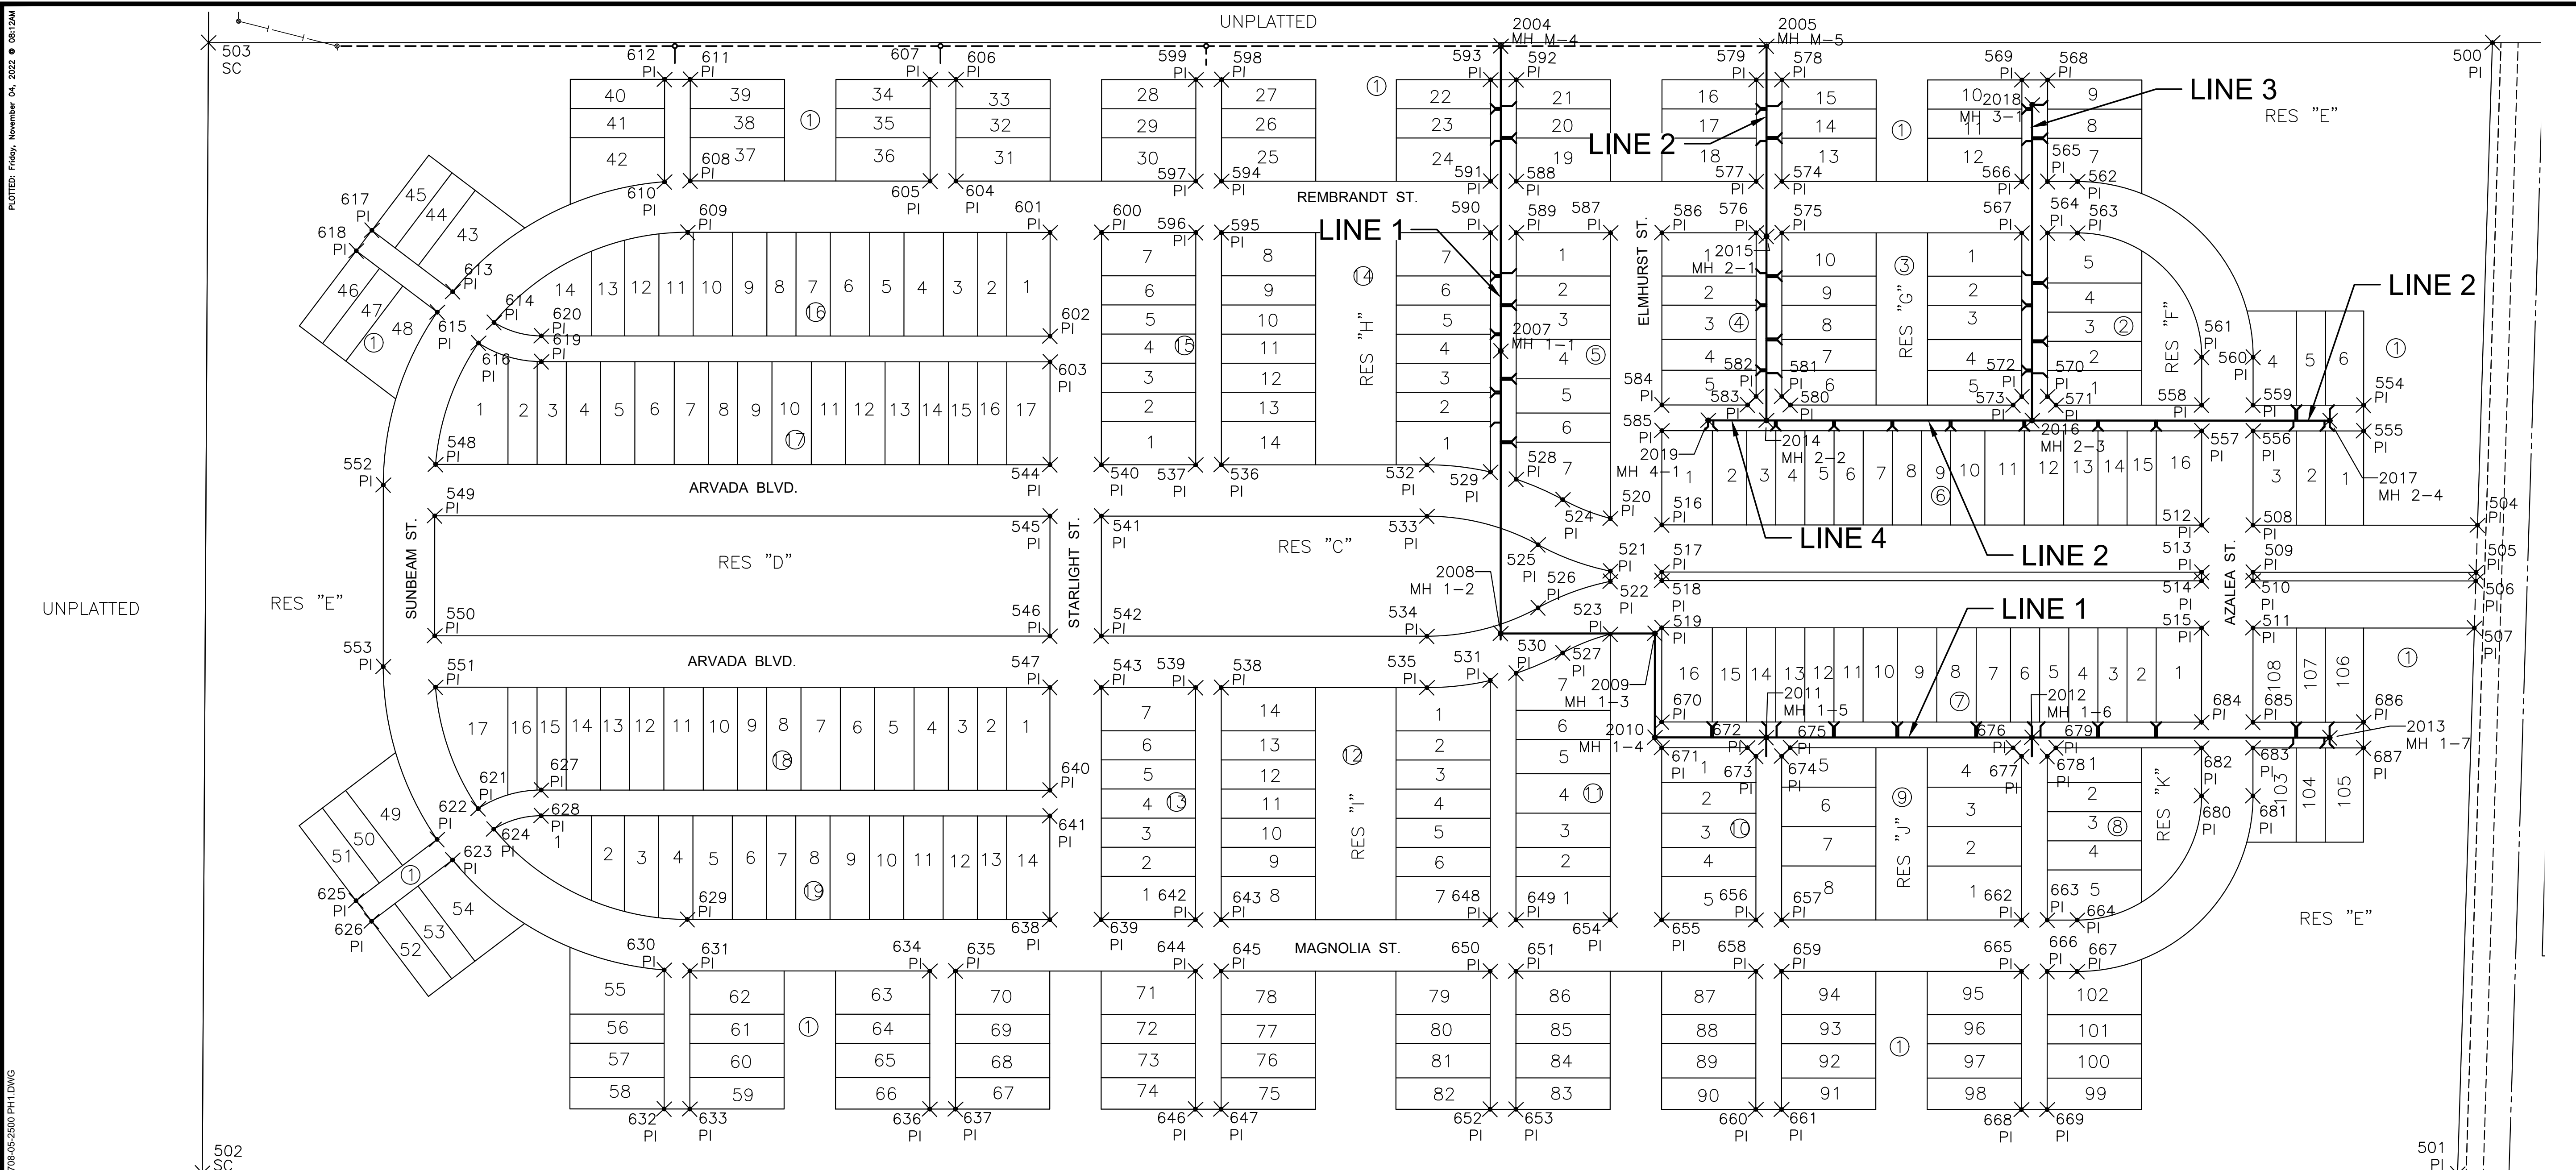

PAVING POINTS				PAVING POINTS				PAVING POINTS				PAVING POINTS				PAVING POINTS				PAVING POINTS				SANITARY POINTS							
Point #	Northing	Easting	Desc.	Point #	Northing	Easting	Desc.	Point #	Northing	Easting	Desc.	Point #	Northing	Easting	Desc.	Point #	Northing	Easting	Desc.	Point #	Northing	Easting	Desc.	Point #	Northing	Easting	Desc.	Point #	Northing	Easting	Desc.
500	1707812.99	1607129.21	PI	520	1707223.25	1606119.16	PI	540	1707265.92	1605523.41	PI	620	1707394.08	1604865.16	PI	640	1706884.13	1605476.09	PI	660	1706539.56	1606312.02	PI	680	1706922.86	1606819.55	PI	2004	1707769.99	1605972.88	MH M-4
501	1706491.86	1607133.05	PI	521	1707161.74	1606121.21	PI	541	1707205.95	1605525.41	PI	621	1706840.22	1604810.13	PI	641	1706854.15	1605477.09	PI	661	1706540.56	1606342.01	PI	681	1706924.86	1606879.52	PI	2005	1707780.44	1606282.71	MH M-5
502	1706404.27	1604502.55	SC	522	1707149.77	1606121.61	PI	542	1707066.03	1605530.07	PI	622	1706802.67	1604763.27	PI	642	1706738.87	1605651.03	PI	662	1706770.95	1606614.49	PI	682	1706978.83	1606817.69	PI	2007	1707414.21	1605984.73	MH 1-1
503	1707723.15	1604465.29	SC	523	1707088.26	1606123.66	PI	543	1707006.06	1605532.07	PI	623	1706779.34	1604782.13	PI	643	1706739.87	1605681.01	PI	663	1706771.95	1606644.48	PI	683	1706980.83	1606877.65	PI	2008	1707084.76	1605995.71	MH 1-2
504	1707249.40	1607130.84	PI	524	1707243.33	1606062.88	PI	544	1707263.92	1605463.45	PI	624	1706816.83	1604829.08	PI	644	1706678.90	1605653.02	PI	664	1706773.12	1606679.46	PI	684	1707008.82	1606816.69	PI	2009	1707090.75	1606175.61	MH 1-3
505	1707194.38	1607131.00	PI	525	1707189.77	1606035.84	PI	545	1707203.95	1605465.44	PI	625	1706727.96	1604671.21	PI	645	1706679.90	1605683.01	PI	665	1706710.99	1606616.49	PI	685	1707010.81	1606876.65	PI	2010	1706969.59	1606179.64	MH 1-4
506	1707184.37	1607131.03	PI	526	1707116.13	1606038.29	PI	546	1707064.03	1605470.10	PI	626	1706704.67	1604690.12	PI	646	1706517.80	1605658.39	PI	666	1706711.99	1606646.47	PI	686	1707015.10	1607005.58	PI	2011	1706973.92	1606309.57	MH 1-5
507	1707129.35	1607131.19	PI	527	1707064.48	1606068.83	PI	547	1707004.06	1605472.10	PI	627	1706864.37	1604882.80	PI	647	1706518.79	1605688.37	PI	667	1706713.15	1606681.45	PI	687	1706985.12	1607006.58	PI	2012	1706984.24	1606619.40	MH 1-6
508	1707240.68	1606869.00	PI	528	1707265.21	1606007.71	PI	548	1707240.06	1604746.82	PI	628	1706834.39	1604883.80	PI	648	1706750.32	1605994.84	PI	668	1706549.88	1606621.85	PI		2013	1706995.80	1606966.70	MH 1-7			
509	1707185.71	1606870.83	PI	529	1707272.62	1605977.44	PI	549	1707180.06	1604747.84	PI	629	1706719.14	1605058.35	PI	649	1706751.32	1606024.82	PI	669	1706550.88	1606651.84	PI		2014	1707343.71	1606297.25	MH 2-2			
510	1707175.72	1606871.16	PI	530	1707038.99	1606015.24	PI	550	1707040.14	1604752.50	PI	630	1706659.30	1605033.33	PI	650	1706690.35	1605996.83	PI	670	1706987.85	1606187.04	PI		2015	1707558.58	1606290.10	MH 2-1			
511	1707120.75	1606872.99	PI	531	1707029.58	1605985.54	PI	551	1706980.20	1604755.48	PI	631	1706659.27	1605063.35	PI	651	1706691.35	1606026.82	PI	671	1706957.86	1606188.03	PI		2016	1707354.03	1606607.08	MH 2-3			
512	1707238.69	1606809.03	PI	532	1707278.56	1605903.17	PI	552	1707214.04	1604686.68	PI	632	1706497.16	1605038.73	PI	652	1706529.24	1606002.20	PI	672	1706961.19	1606287.98	PI		2017	1707365.60	1606954.39	MH 2-4			
513	1707183.72	1606810.86	PI	533	1707218.60	1605905.17	PI	553	1707002.16	1604693.73	PI	633	1706498.16	1605068.71	PI	653	1706530.24	1606032.18	PI	673	1706951.53	1606298.31	PI		2018	1707722.33	1606594.82	MH 3-1			
514	1707173.72	1606811.20	PI	534	1707078.67	1605909.83	PI	554	1707384.90	1606993.27	PI	634	1706668.59	1605343.19	PI	654	1706754.98	1606134.76	PI	674	1706952.53	1606328.29	PI		2019	1707341.45	1606229.29	MH 4-1			
515	1707118.75	1606813.03	PI	535	1707018.71	1605911.82	PI	555	1707354.92	1606994.27	PI	635	1706669.59	1605373.18	PI	655	1706756.98	1606194.72	PI	675	1706962.86	1606337.95	PI								
516	1707217.72	1606179.38	PI	536	1707270.58	1605663.34	PI	556	1707350.62	1606865.34	PI	636	1706507.48	1605348.56	PI	656	1706760.64	1606304.66	PI	676	1706971.51	1606597.81	PI								
517	1707162.75	1606181.21	PI	537	1707269.58	1605633.35	PI	557	1707348.63	1606805.37	PI	637	1706508.48	1605378.54	PI	657	1706761.64	1606334.65	PI	677	1706961.85	1606608.14	PI								
518	1707152.76	1606181.55	PI	538	1707010.72	1605671.99	PI	558	1707378.61	1606804.37	PI	638	1706733.21	1605481.12	PI	658	1706700.67	1606306.66	PI	678	1706962.85	1606638.12	PI								
519	1707097.79	1606183.38	PI	539	1707009.72	1605642.01	PI	559	1707380.61	1606864.34	PI	639	1706735.21	1605541.09	PI	659	1706701.67	1606336.64	PI	679	1706973.17	1606647.78	PI								

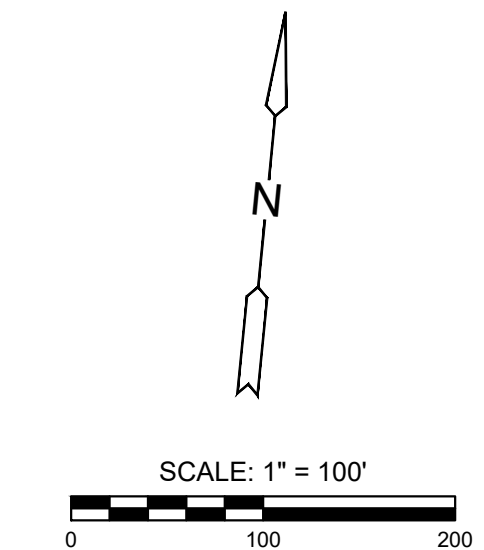

J:\PROJECTS\2020\20201010708_MPH_119THAND37THDEVELOPMENT\SERVICES\02708 CAD\SHS\05 CIVIL\ANSAN PH 1\202008-05-2500 PH1.DWG
 PLOTTED: Friday, November 04, 2022 @ 08:12AM

©2022
 MKEC Engineering
 All Rights Reserved
 www.mkec.com
 These drawings and their contents, including, but not limited to, all concepts, designs, & ideas are the exclusive property of MKEC Engineering (MKEC), and may not be used or reproduced in any way without the express consent of MKEC.

BUBBLE MAP

PROJECT NO.	468-2022-024784	
DATE	NOV 2022	
SCALE	1"=100'	
DESIGNED	DRAWN	CHECKED
DFL	LAL	SPE
NO.	REVISION	DATE
SHEET NO.		
11 OF 17		