


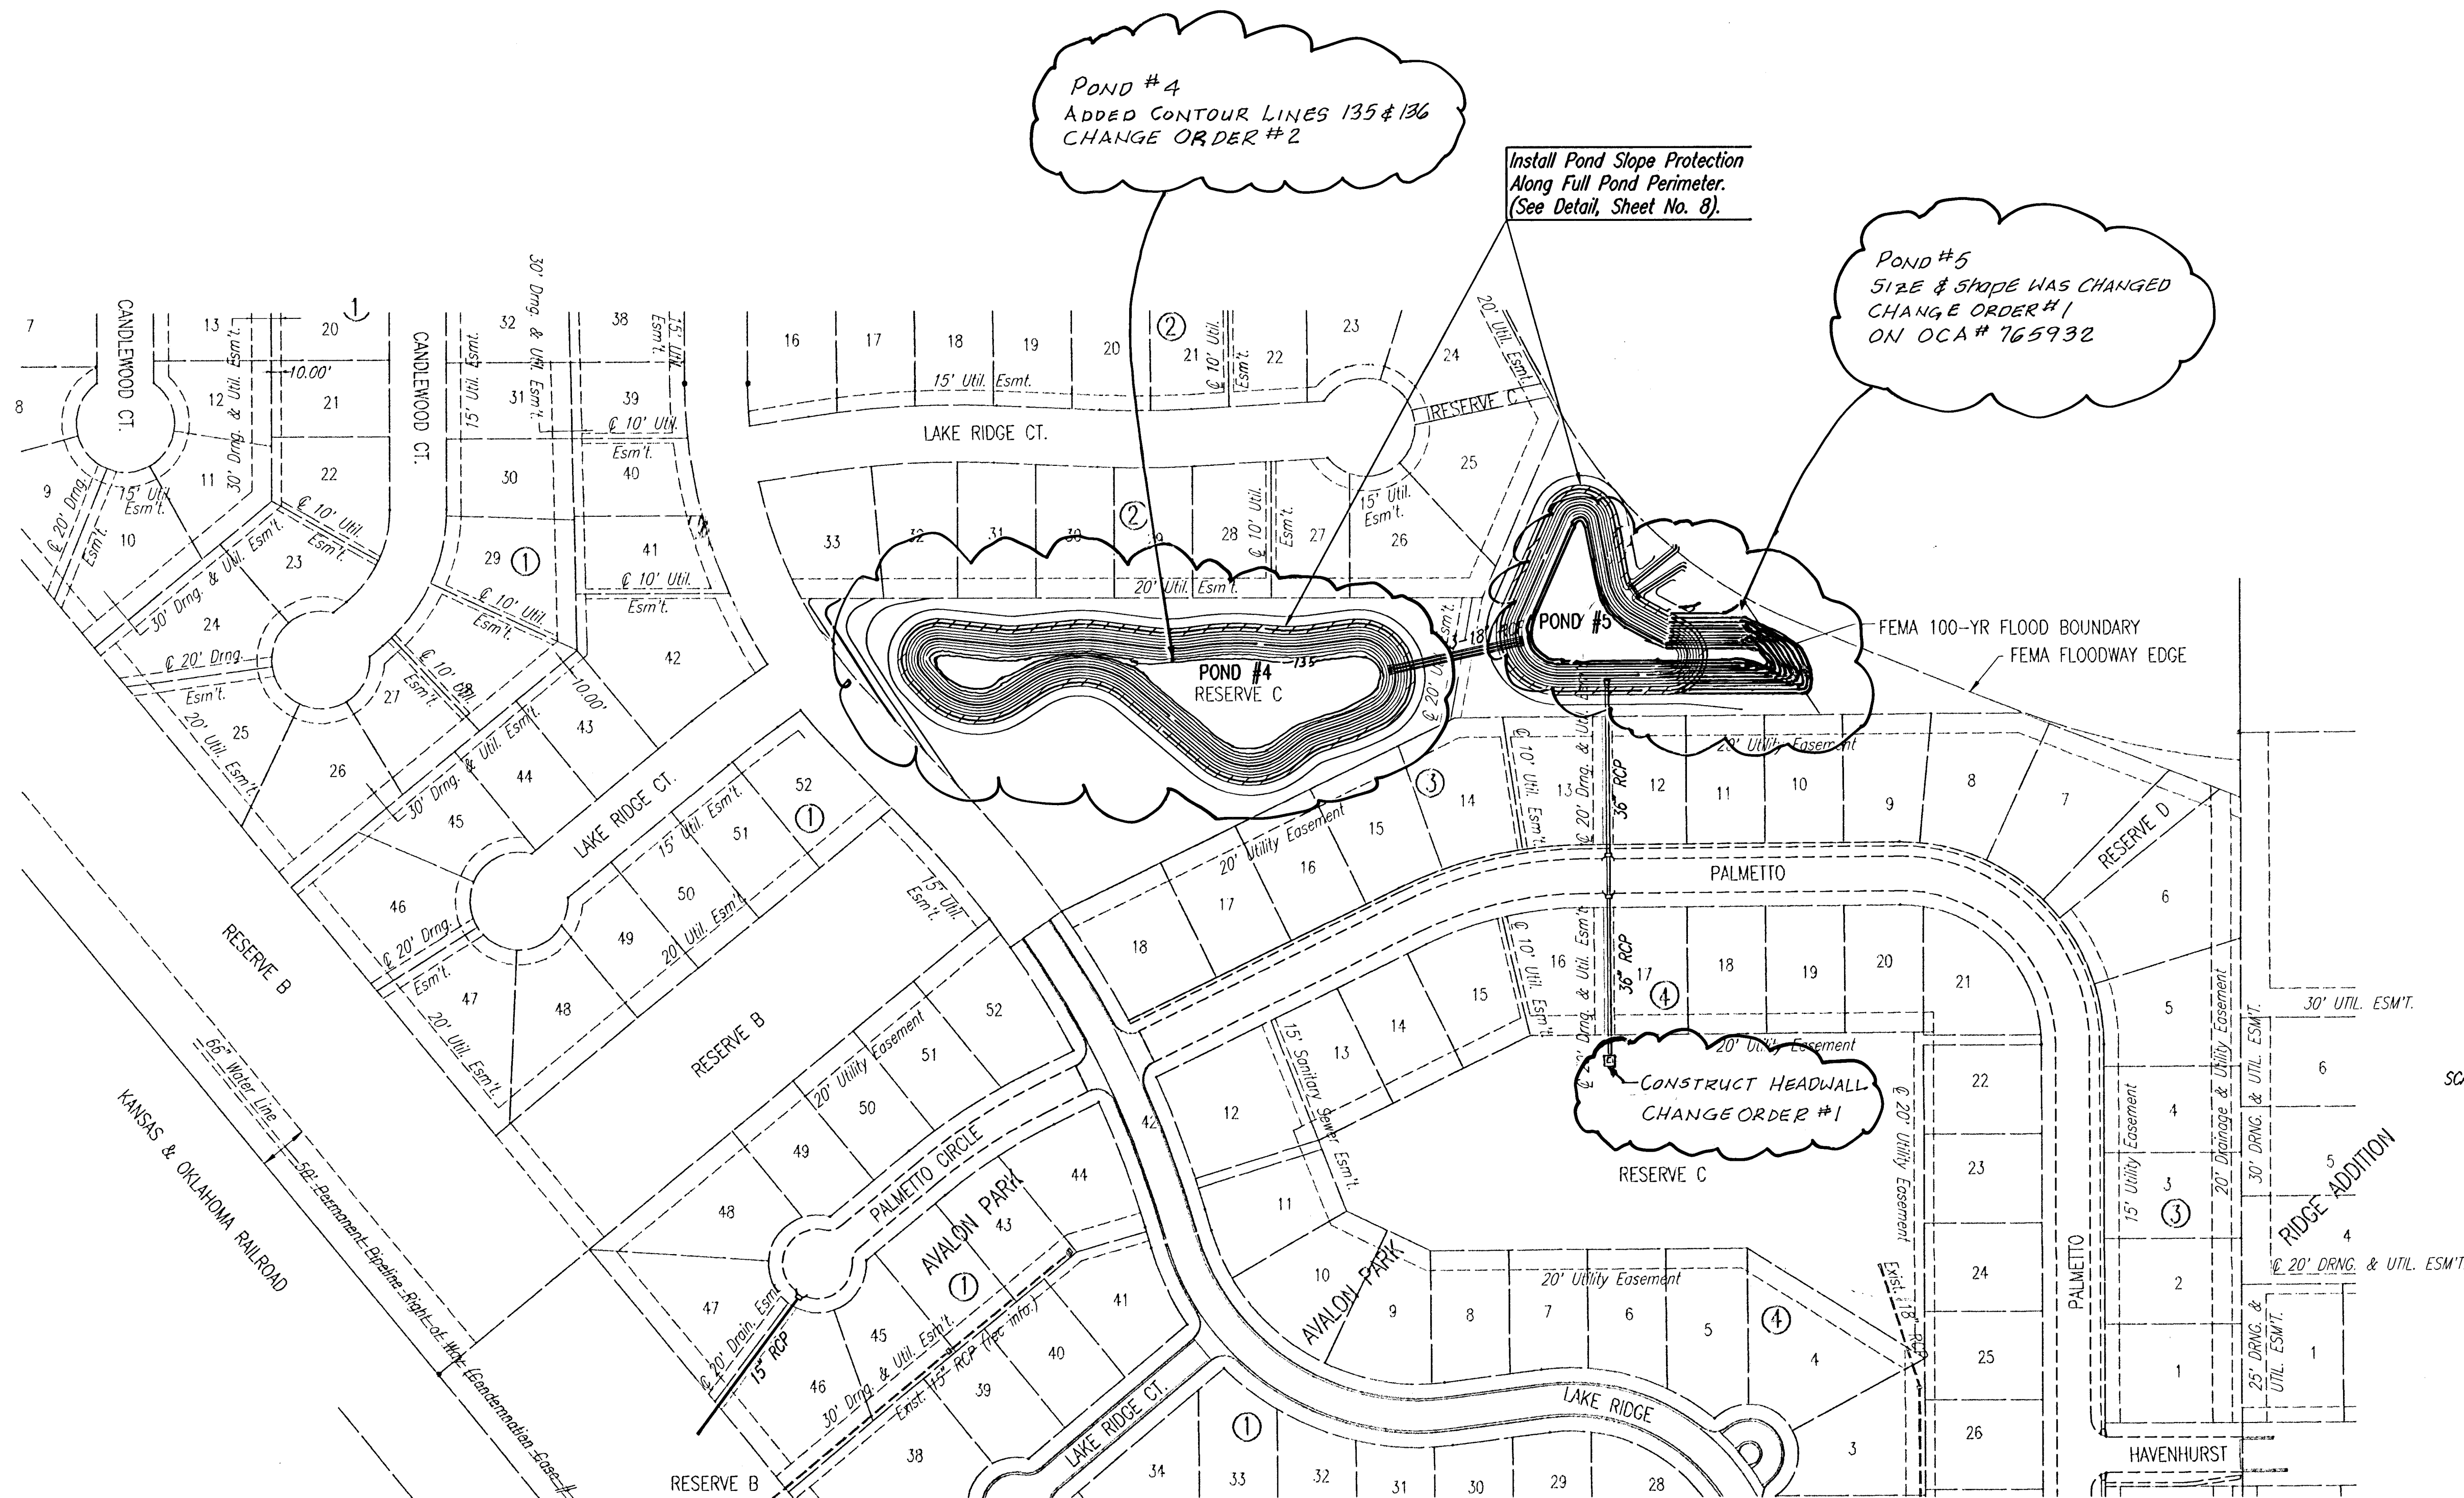

James L. Armour
02.02.06
RECORD DRAWING

	No.		Revision		By	Date
	AVALON PARK 3RD STORM WATER DRAIN NO. 264					
	EROSION CONTROL (BMP) PLAN					
	JAMES L. ARMOUR, P.E.-CITY ENGINEER CITY OF WICHITA PROJECT NO. 468-84011 Professional Engineering Consultants, P.A. 303 S. TOPEKA • WICHITA, KANSAS 67202 316-262-2691 • FAX 316-262-3003					
Designed by	BDB, BLB		Job No.	35-05257		
Drawn by	BJS		Date	February 2005		
			Sht.		12 of 31	