

DATE  
BY  
CHECKED  
PLAN

DATE  
BY  
CHECKED  
PROFILE

DSNR: BLB OPER: BUS SCALE: 1"=20.00  
C:\2005\05258\05258-C-SWSLINE1.DWG-16-2005 10:52:35 am

8+99  
Sta. ~~8+99.7~~ SWS Line No. 1  
Begin 36" RCP Construction  
Install 104.9 L.F. 36" RCP (S)  
(Including End Section)  
101 L.F. (100)

Sta. 10+00.0 SWS Line No. 1=  
@ Lake Ridge Sta. 30+58.00, 20.67' Rt.  
Const. Std. Type 1A Curb Inlet (3)  
L=11'-0", W=3'-0"  
Top Elev.=147.60  
Install 41.3 L.F. 36" RCP (SW)  
See Sheet No.

Sta. 10+41.3 SWS Line No. 1=  
@ Lake Ridge Sta. 30+58.00, 20.67' Lt.  
Const. Std. Type 1A Curb Inlet (3)  
L=11'-0", W=3'-0"  
Top Elev.=147.60  
Install 68.4 L.F. 36" RCP (SW)  
See Sheet No.

11+09.3  
Sta. ~~11+09.7~~ SWS Line No. 1  
End 36" RCP Construction  
(Install End Section)  
(103)

CHANGE ORDER #2  
ADD CONTOUR LINES

CHANGE ORDER #1  
ADD CONTOUR LINES


See Special Provisions

(3) Omit Center Wall.  
See Reinf. Lid Details,  
See Sheet No. 15.

POINT	NORTH	EAST
100	11,695.1412	11,357.4317
101	11,590.7241	11,347.3648
102	11,562.4357	11,317.2191
103	11,511.2270	11,271.8734

(100) = COORDINATE POINT NO.  
SEE SHEET NO. 3 FOR PLAT COORDINATES

RECORD DRAWING  
6-15-05  
Professional Engineer  
BRIAN D. BOUTWELL  
LICENSED  
10889  
020706

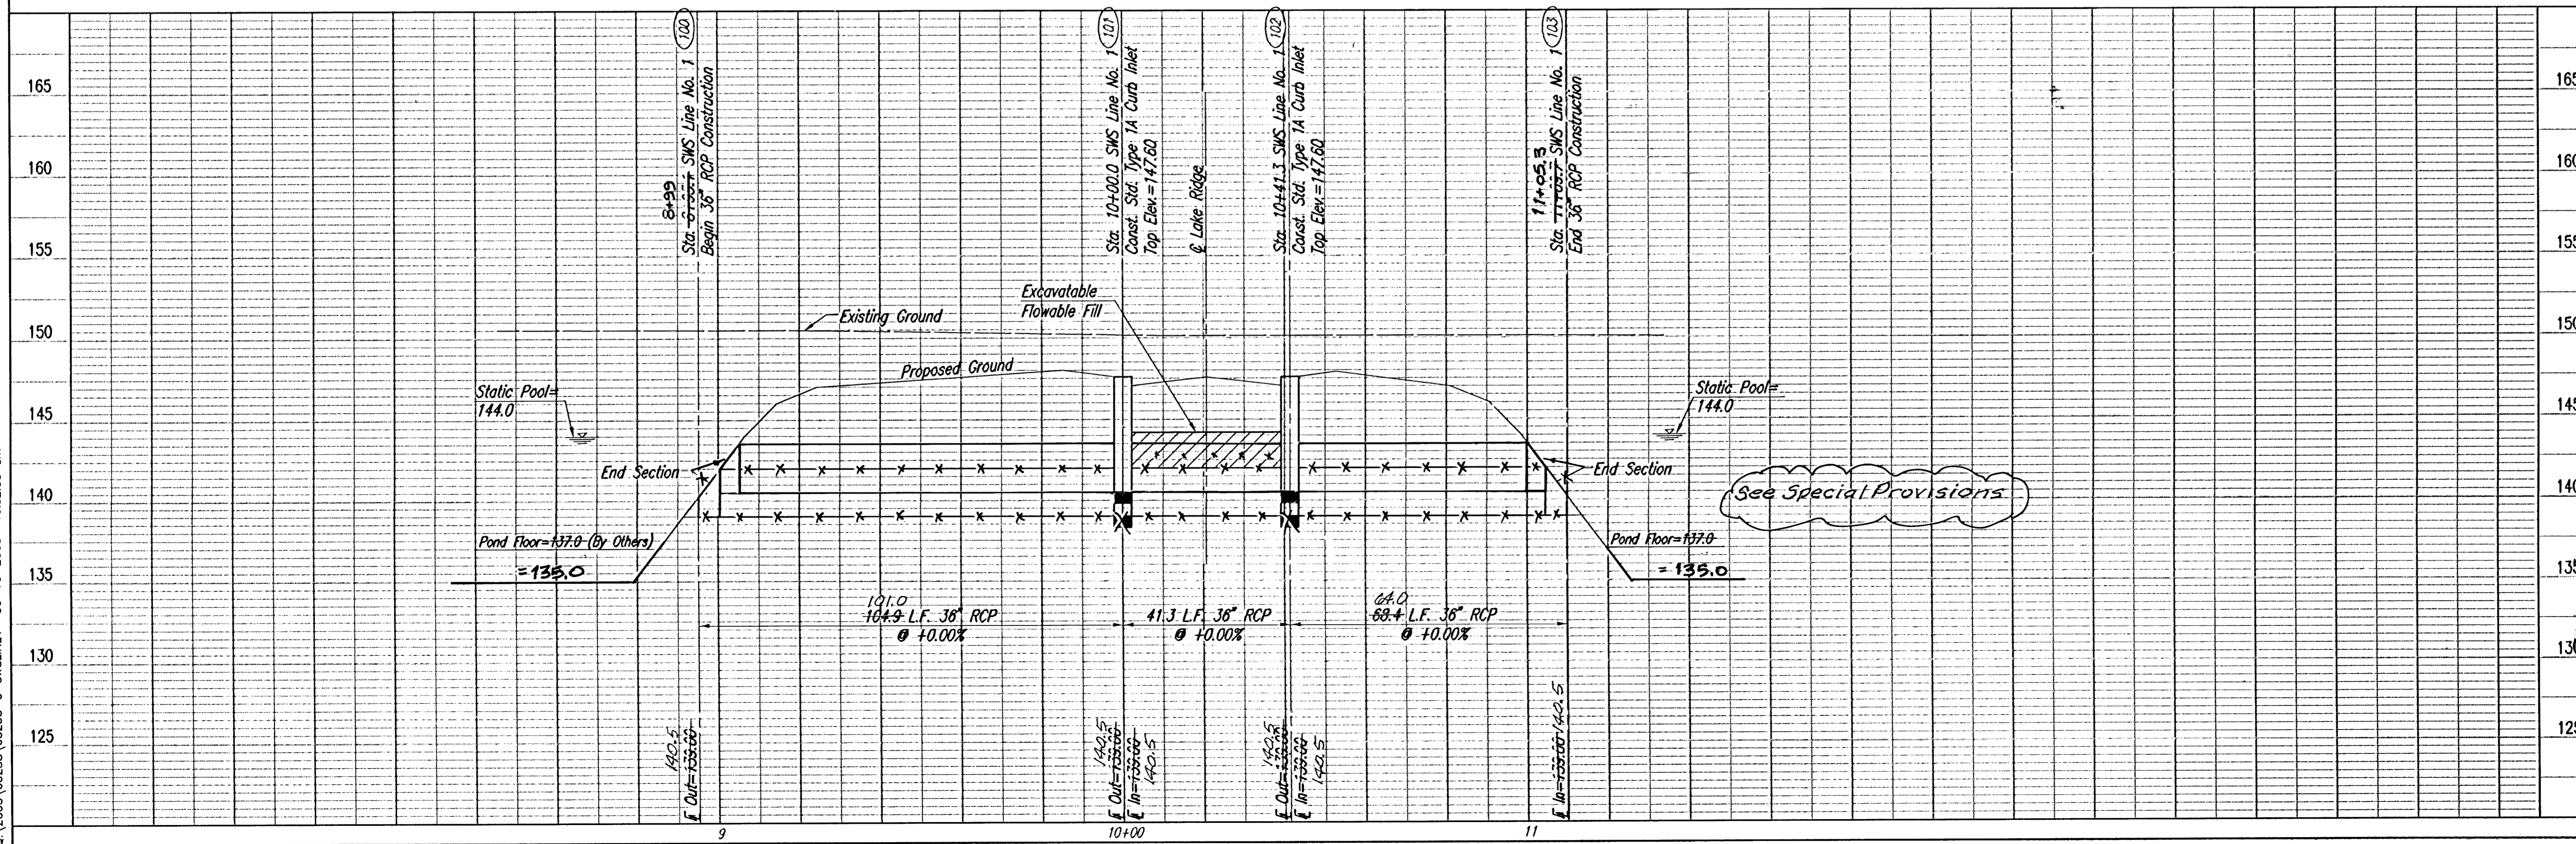

See Special Provisions

Professional Engineering Consultants, P.A.  
303 S. TOPEKA • WICHITA, KANSAS 67202  
316-262-2691 • FAX 316-262-3003  
Designed By: BDB, BLB  
Checked By: BUS  
Job No.: 35-05258  
Date: February, 2005  
AVALON PARK JRD  
STORM WATER DRAIN NO. 265  
SWS LINE NO. 1  
JAMES L. ARMOUR, P.E.-CITY ENGINEER  
CITY OF WICHITA PROJECT NO. 488-8402