


PLAN	CHECKED	CHECKED
BY		
DATE		

PROFILE	CHECKED	CHECKED
BY		
DATE		

DSNR: BLB OPER: BUS SCALE: 1"=20.00
 G:\2005\05258\05258-C-SWSLINE2-06-16-2005 10:53:17 am

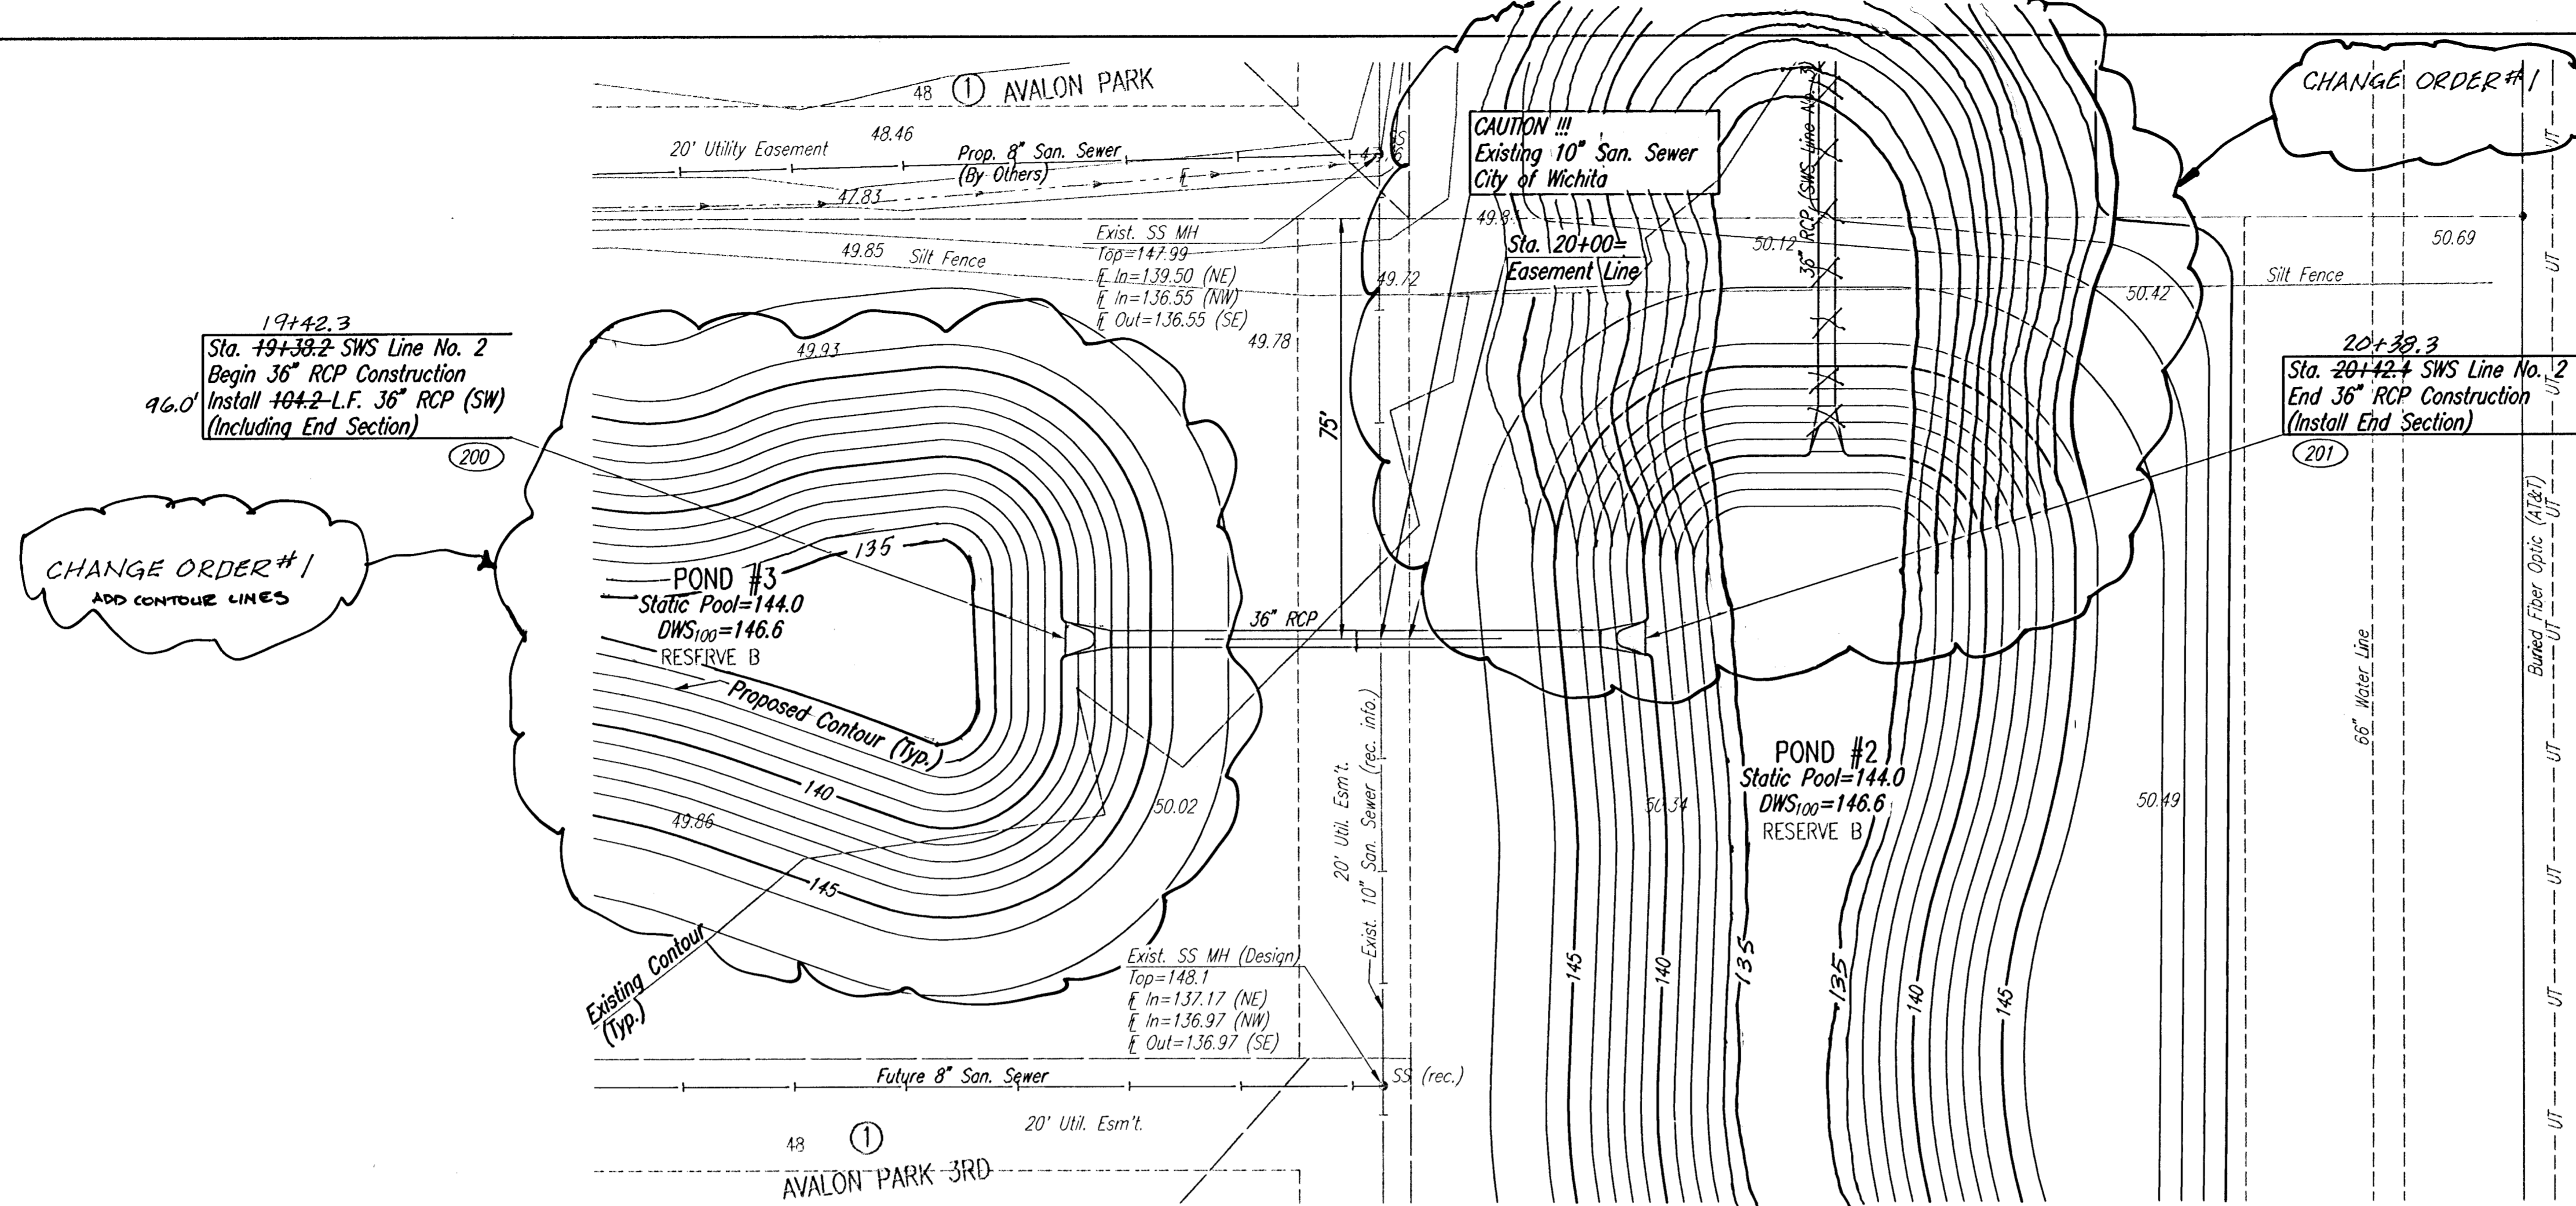


SCALE: 1"=20'

See Special Provisions

RECORD DRAWING

BRAND BOUTWELL
 10889
 PROFESSIONAL ENGINEER
 6-15-05

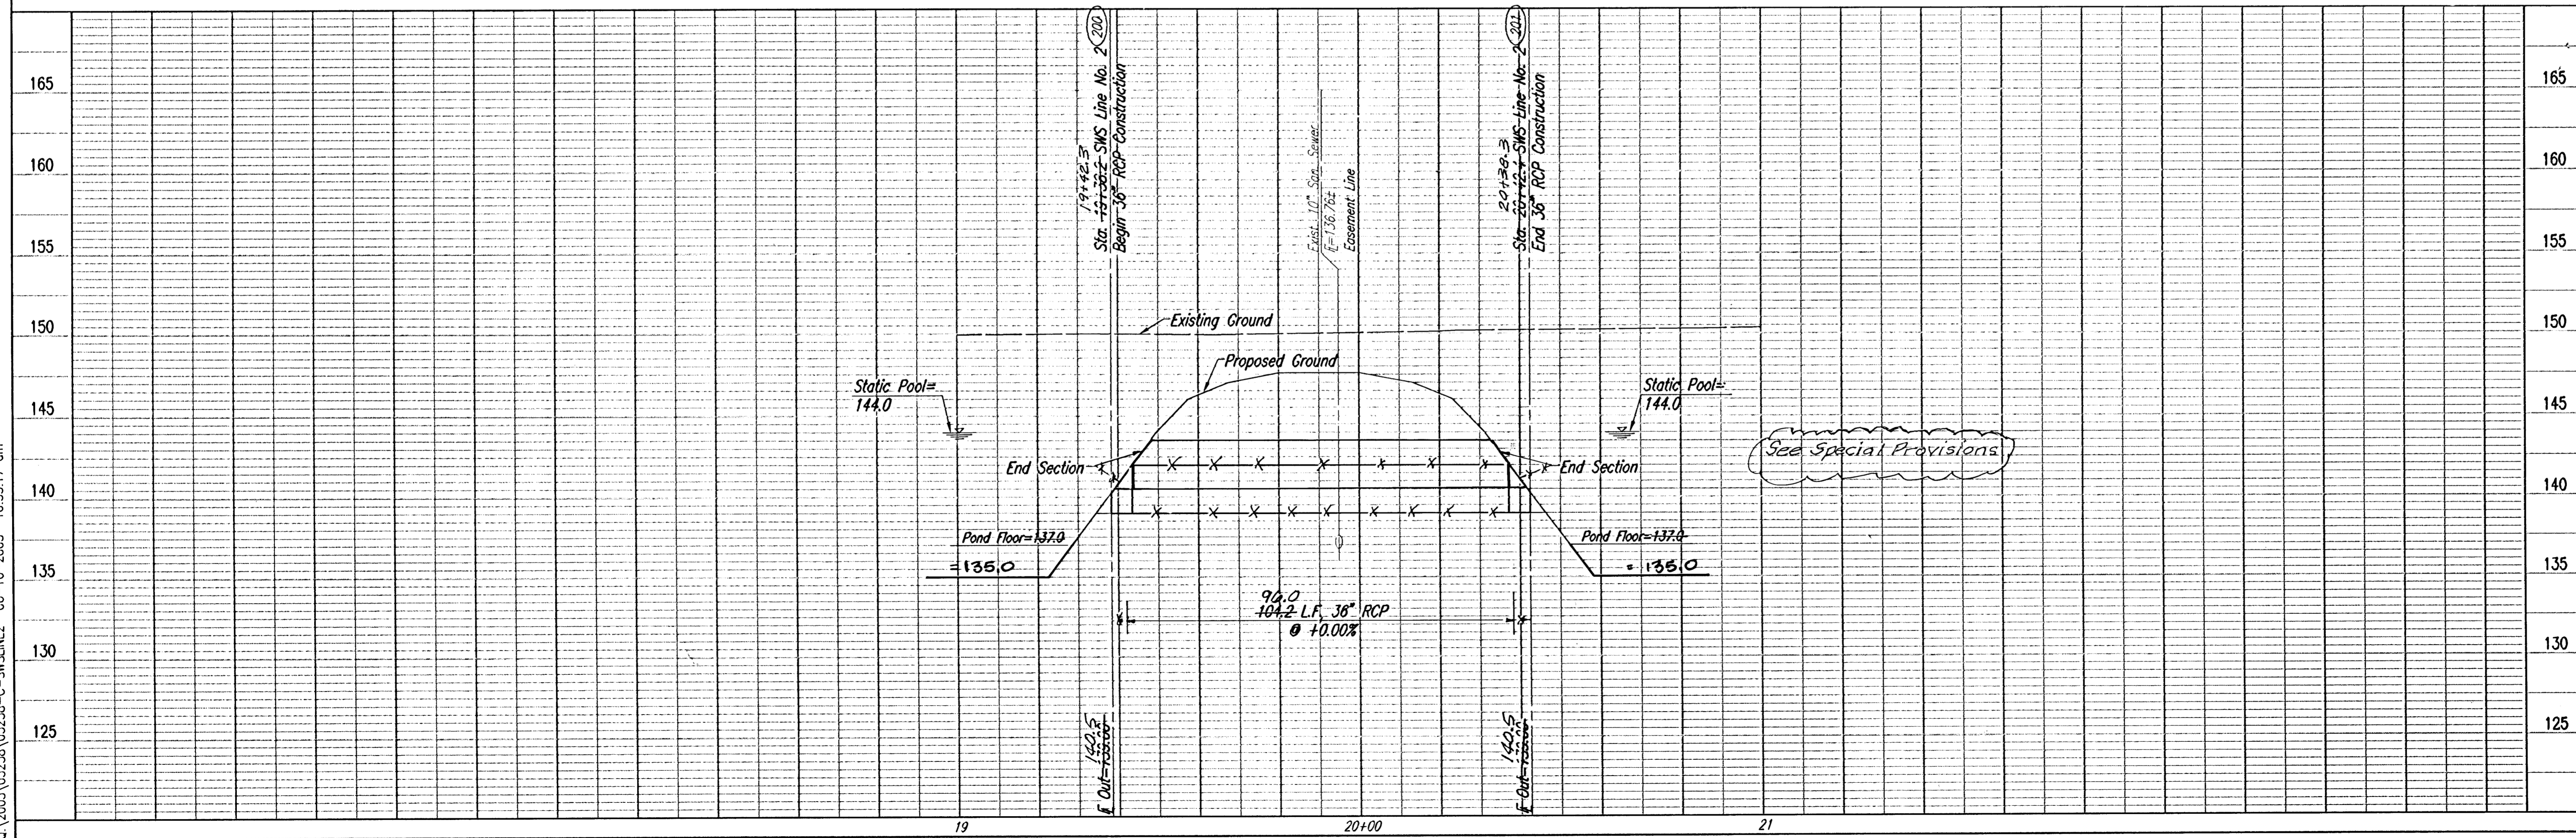

Professional Engineering Consultants, P.A.
 303 S. TOPEKA • WICHITA, KANSAS 67202
 316-266-2491 • FAX 316-262-5003

Designed By: BDR, BLB
 Job No.: 35-05258
 Date: February 2005

Professional Engineer
 10889
 JAMES L. ARMOUR, P.E. - CITY ENGINEER
 CITY OF WICHITA PROJECT NO. 488-8402