


| | | |
|------|---------|------|
| PLAN | CHECKED | DATE |
| | CHECKED | |

| | | |
|---------|---------|------|
| PROFILE | CHECKED | DATE |
| | CHECKED | |

DSNR: BLB OPER: BUS SCALE: 1"=20.00
 01/2005 05258 05258-C-SWSLINE3 06-16-2005 10:54:03 am

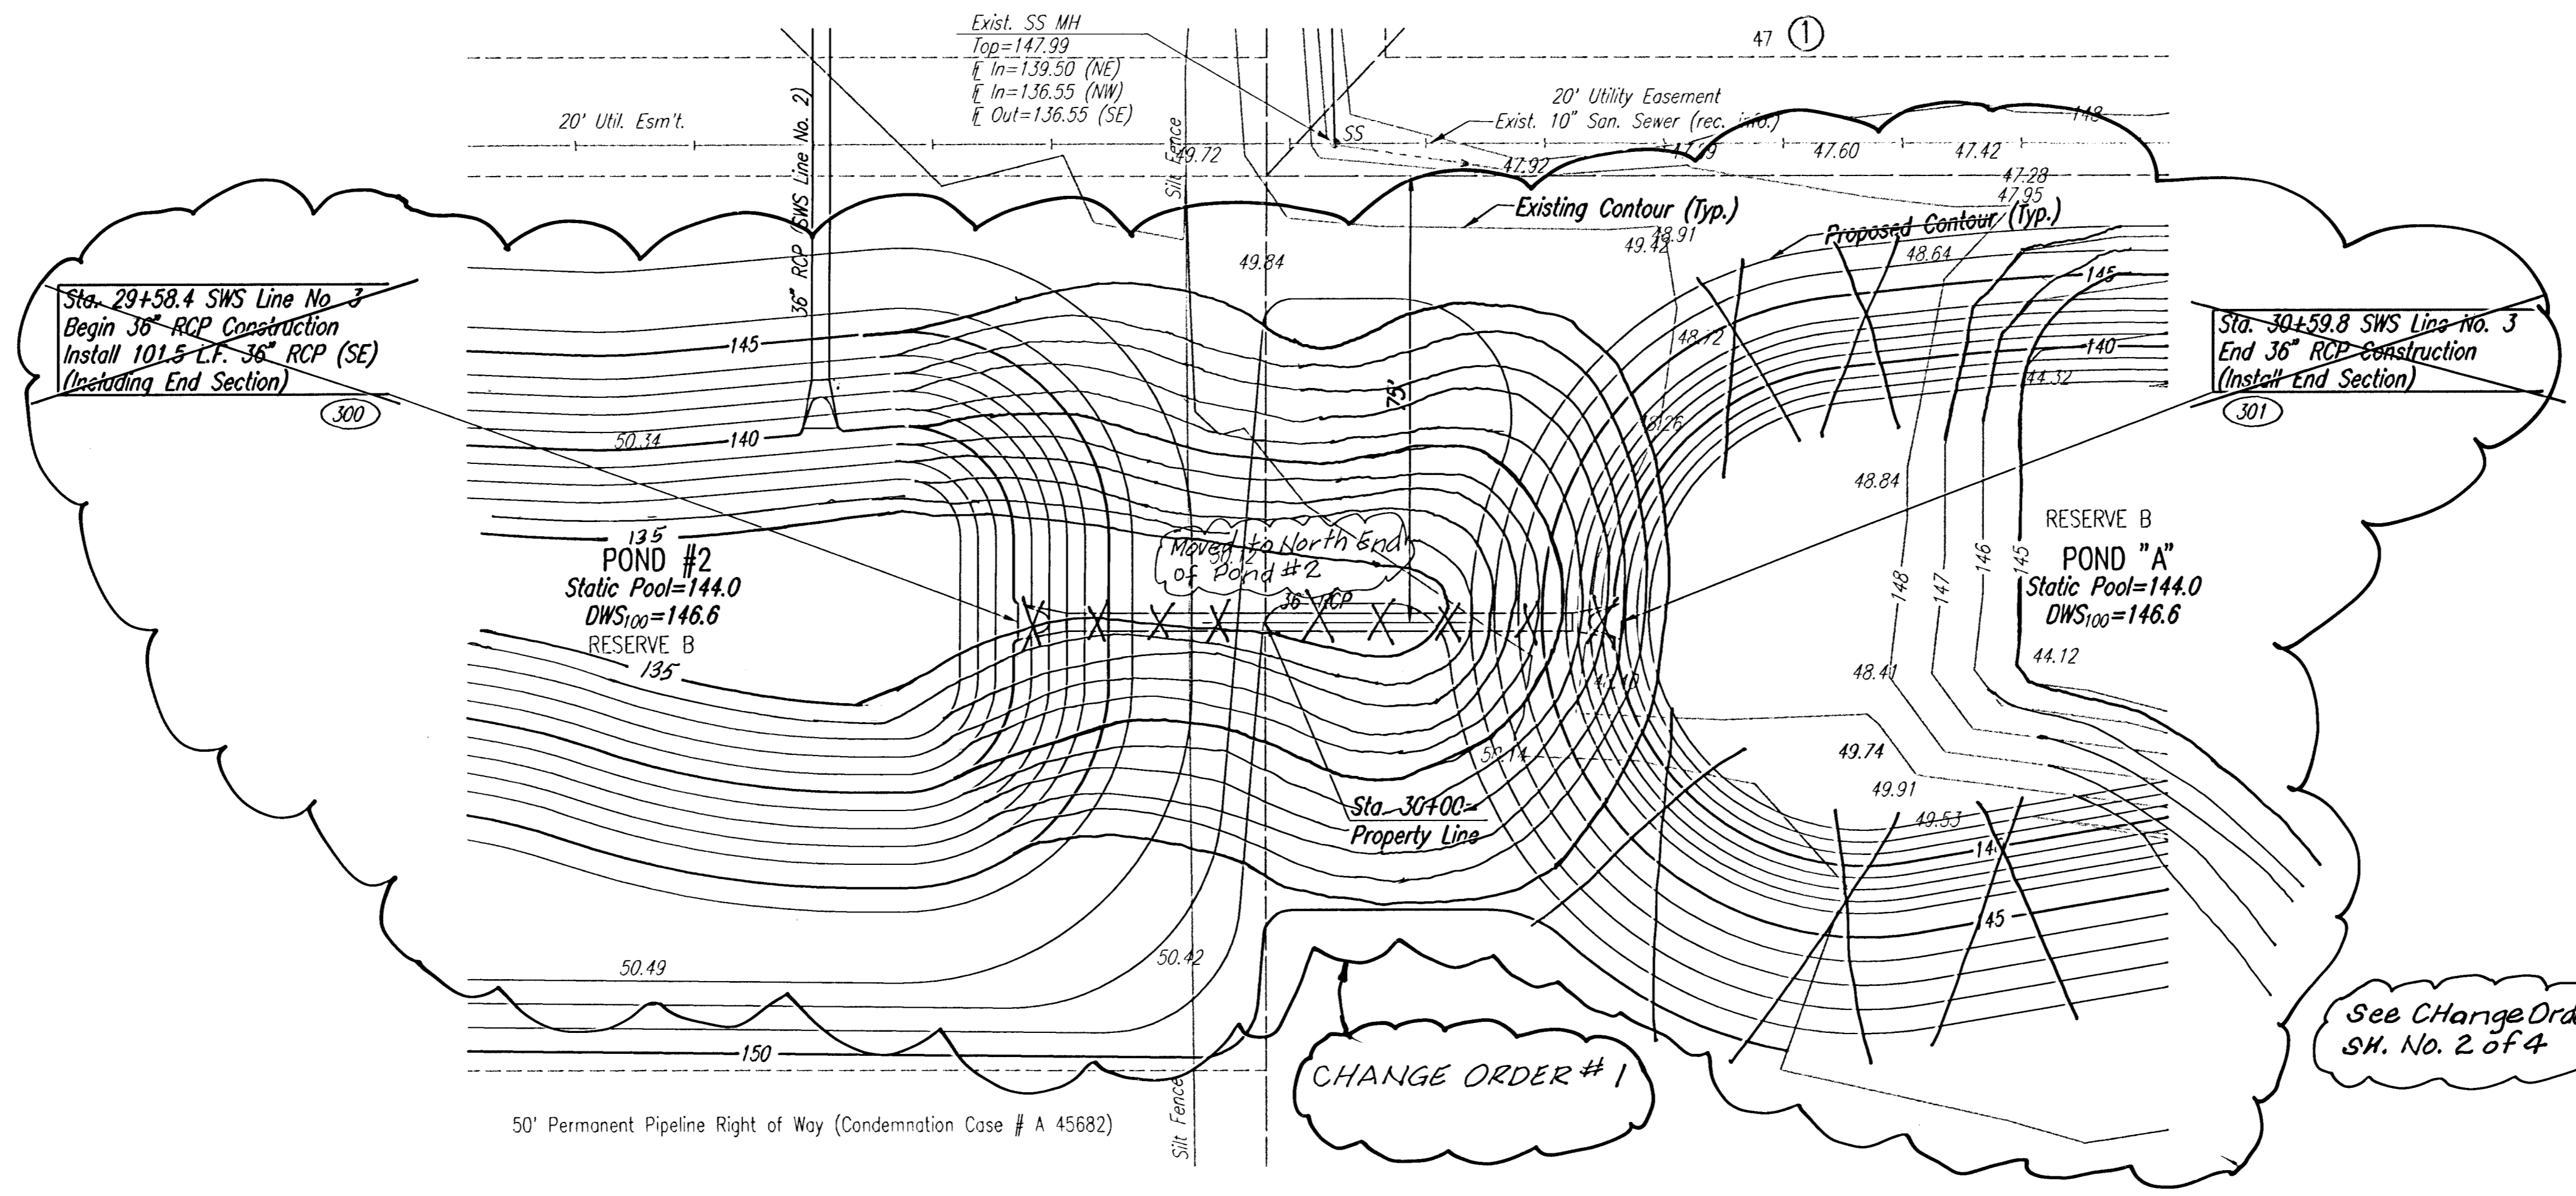

SCALE: 1"=20'



| COORDINATE LIST | | |
|-----------------|-------------|-------------|
| POINT | NORTH | EAST |
| 300 | 11,127.5271 | 10,880.7774 |
| 301 | 11,049.0691 | 10,945.1556 |

300 = COORDINATE POINT NO.
 SEE SHEET NO. 3 FOR PLAT COORDINATES

CHANGE ORDER #1

See Change Order #1
 SH. No. 2 of 4

RECORD DRAWING
 6-15-05

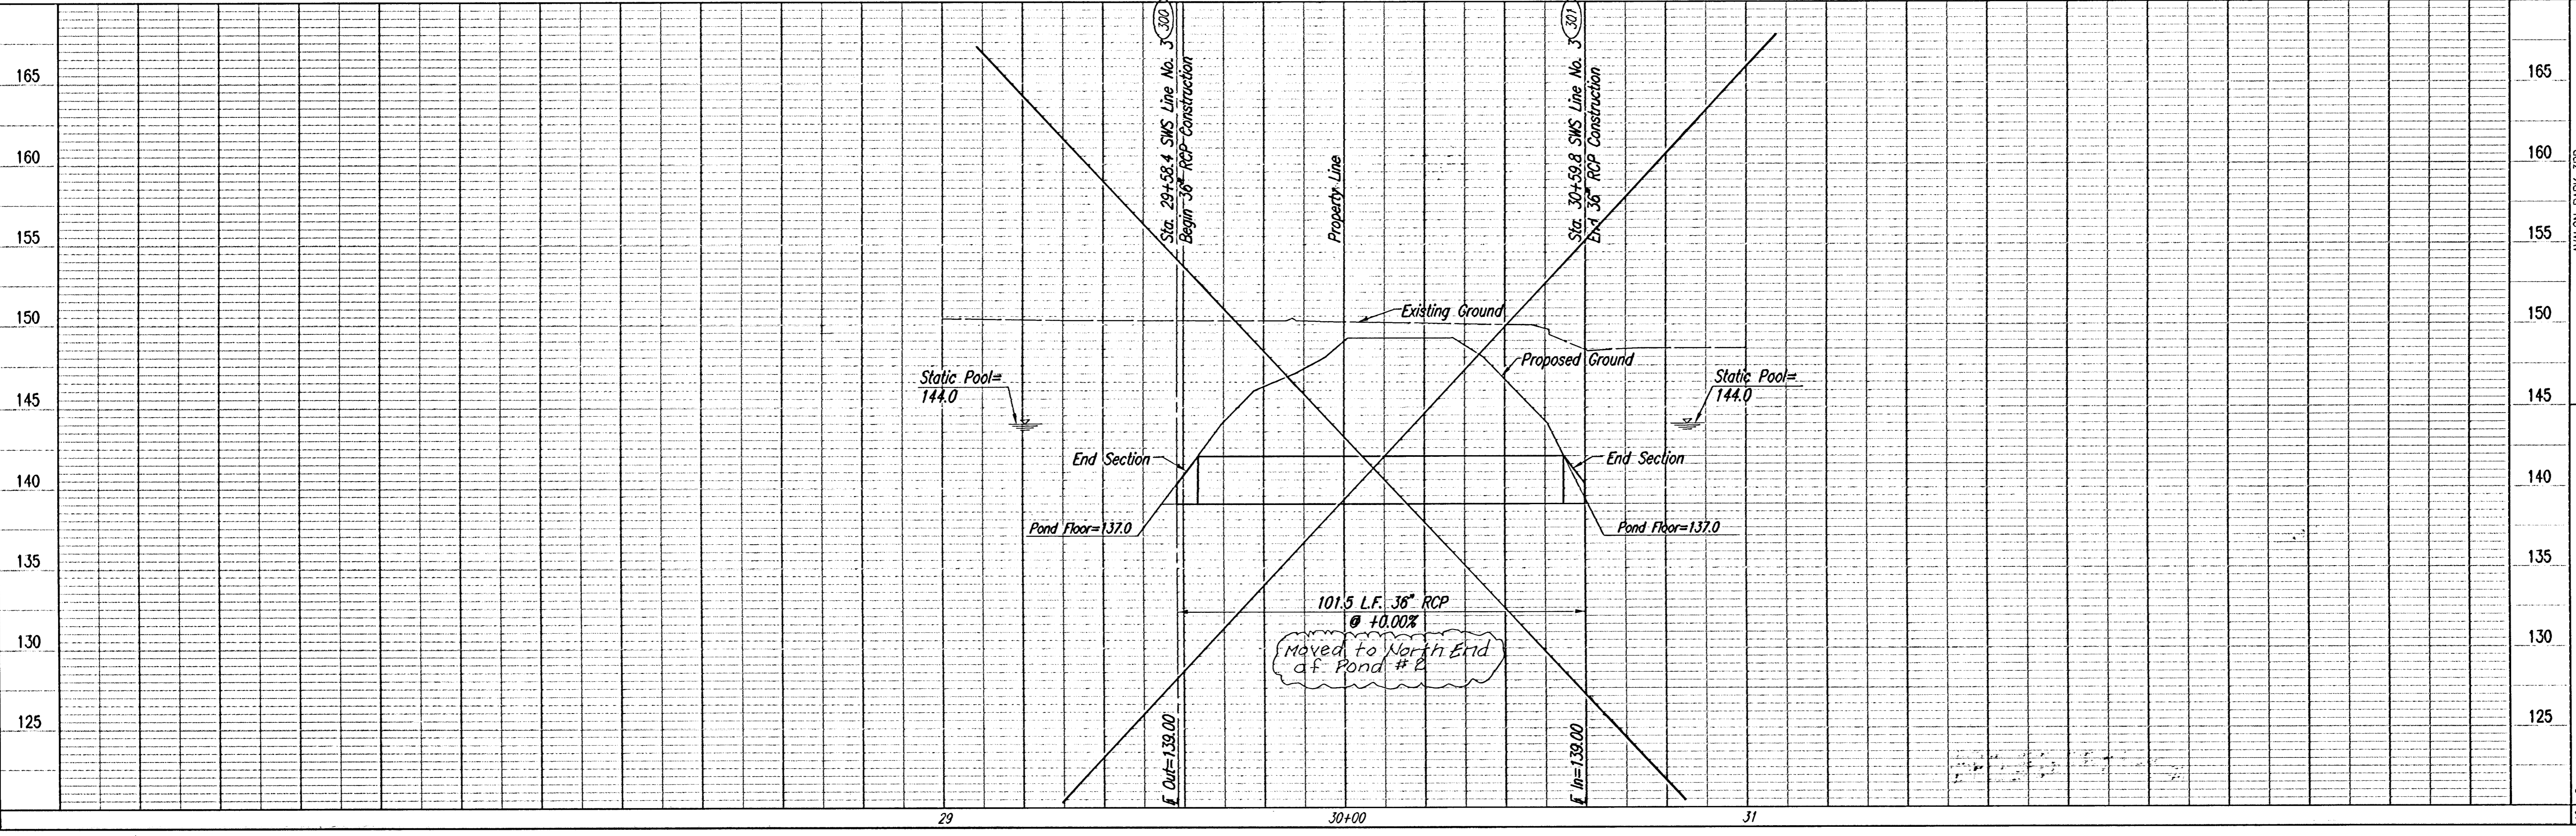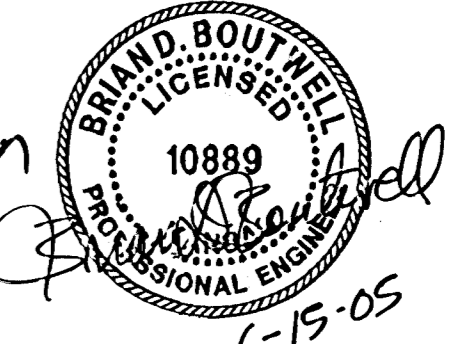

Professional Engineering Consultants, P.A.
 303 S. TOPKA • WICHITA, KANSAS 67202
 316-262-2691 • FAX 316-262-3003

Designed By: BLB, BUS
 Drawn By: BUS

Job No.: 05-0258
 Date: February 2005

Professional Engineer
 10889
 Brian D. Boutwell
 State of Kansas

6-15-05

Sheet 12 of 35