


PROJECT NO.	YEAR	SHEET NO.	TOTAL SHEETS
35-05258-000		21	35

NO.	DATE	DESCRIPTION

DSNR: BLB OPER: BUS SCALE: 1"=1.00
 G:\2005\05258\X-SECS\swd ph2 sta 0 to 760\05258-C-s001 06-16-2005 10:59:08 am

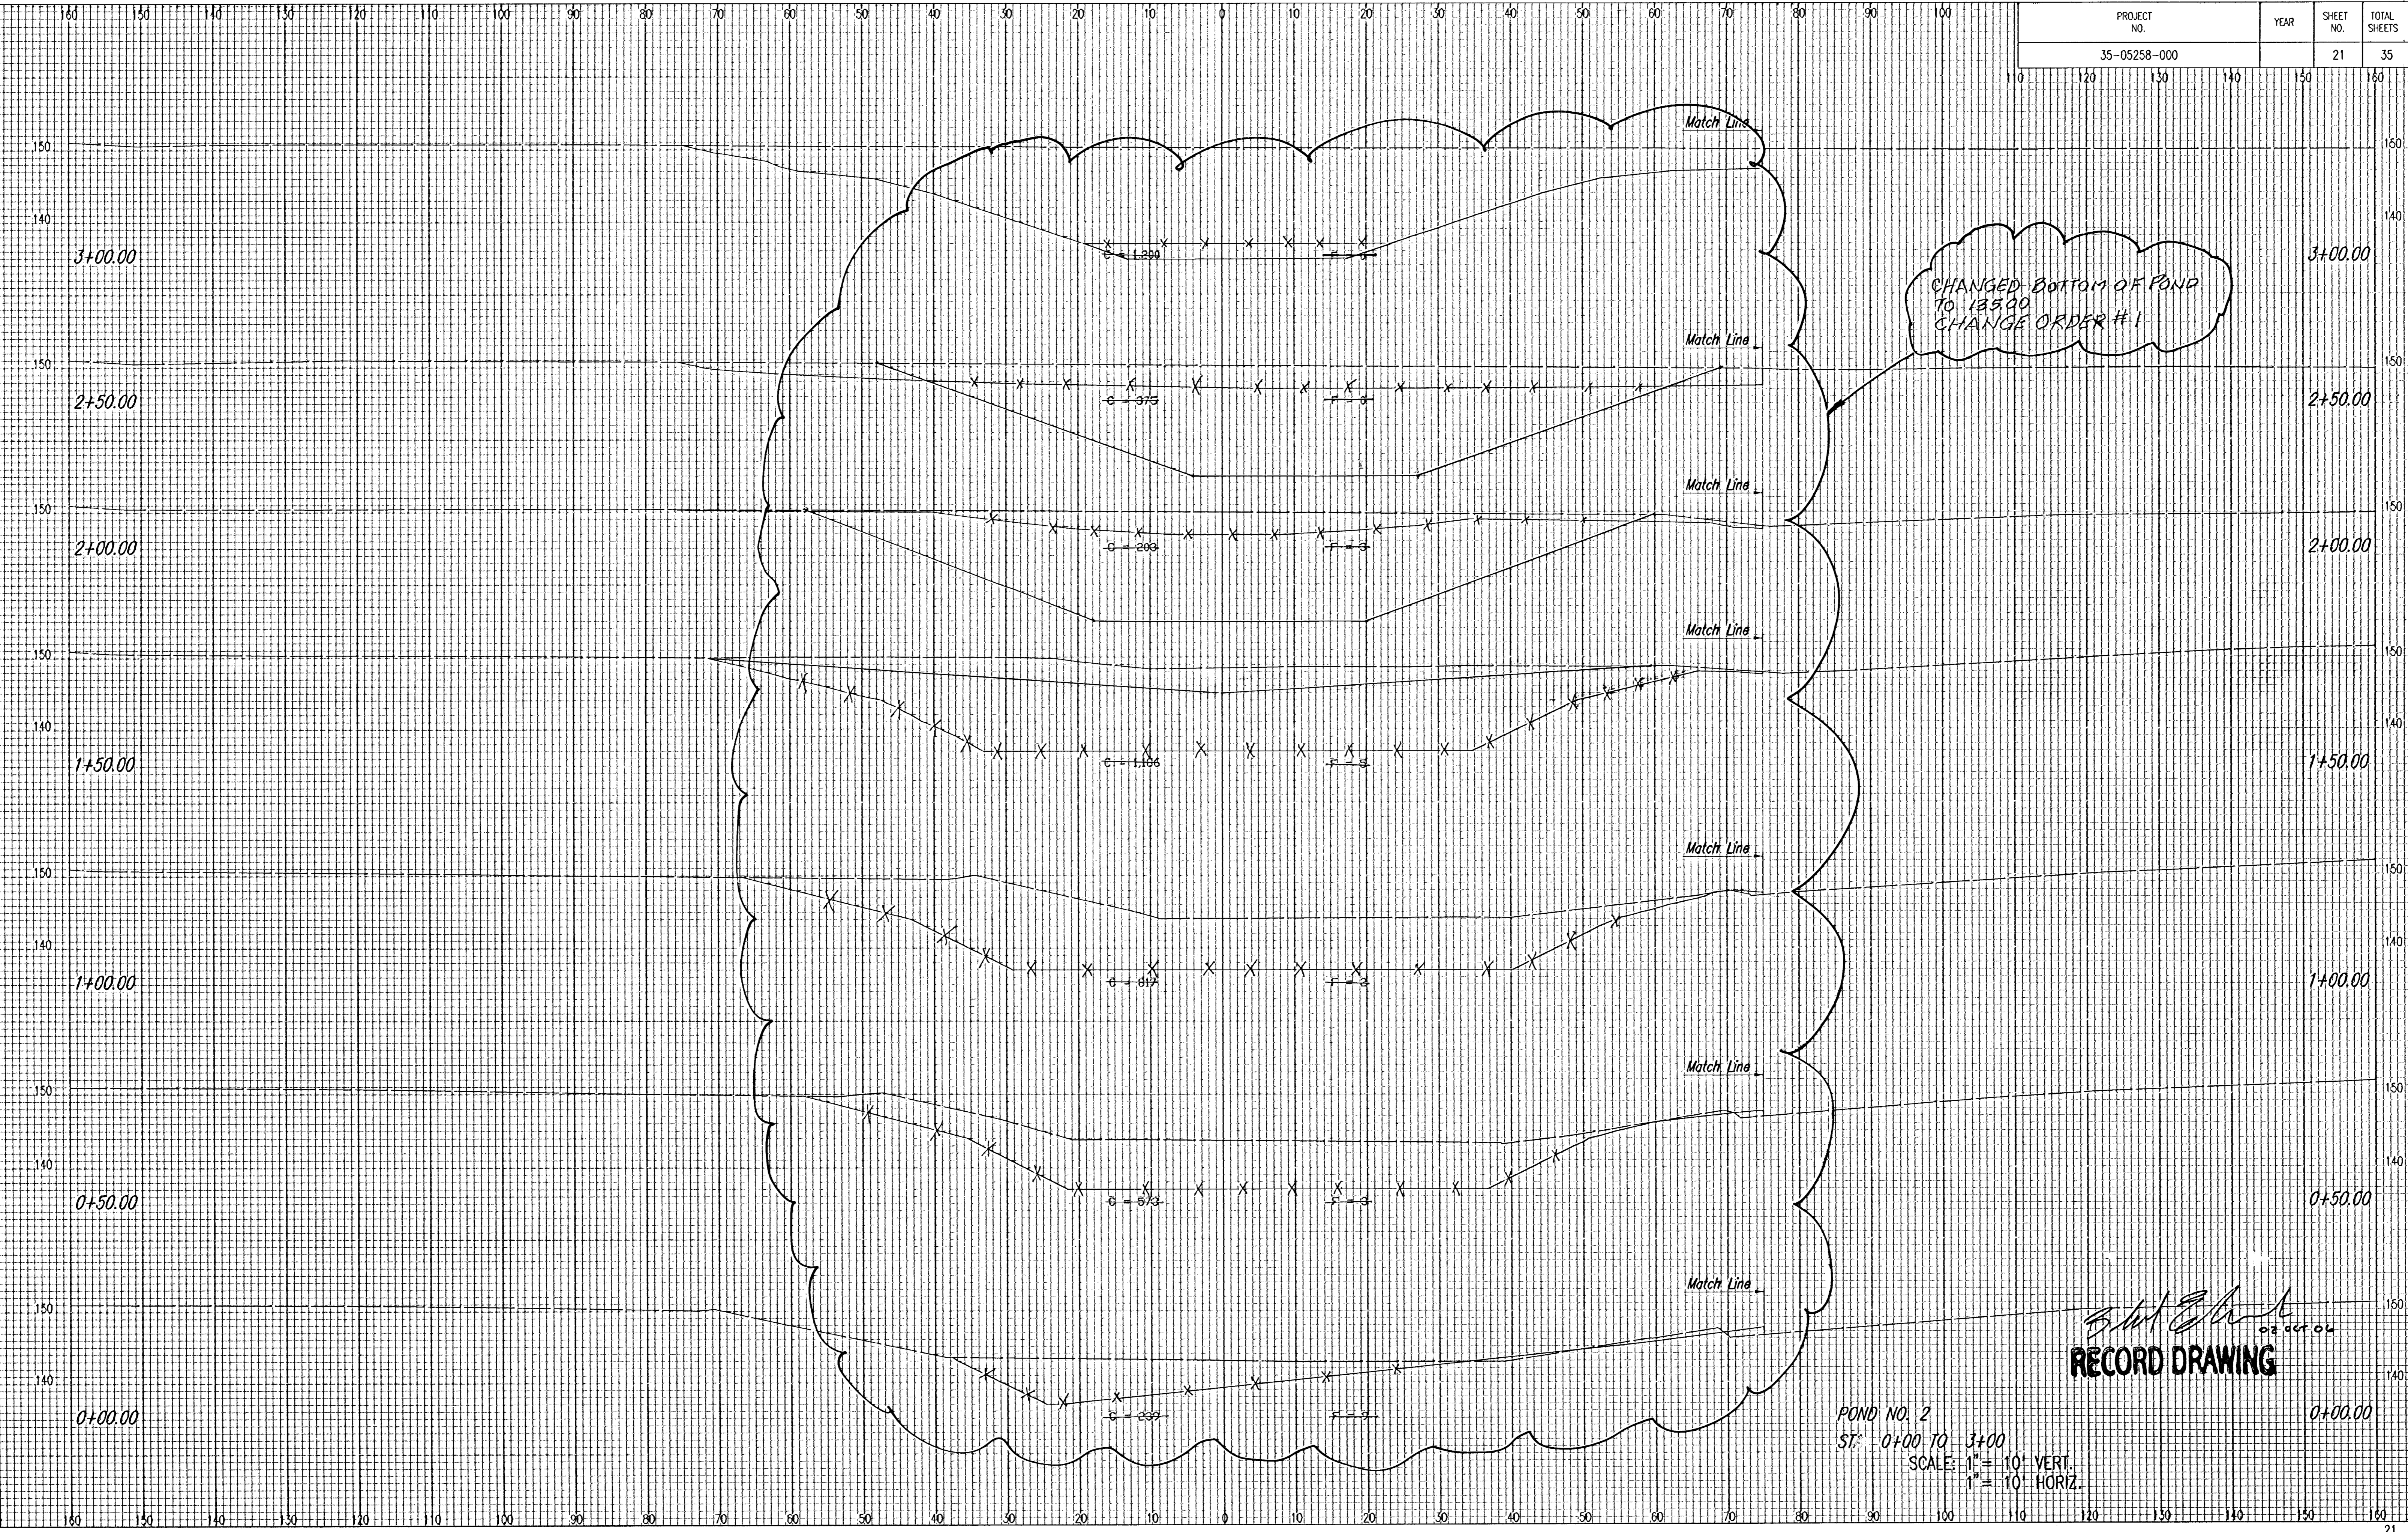

CHANGED BOTTOM OF POND
 TO 135.00
 CHANGE ORDER #1

POND NO. 2
 ST. 0+00 TO 3+00
 SCALE: 1" = 10' VERT.
 1" = 10' HORIZ.

Blat E...
 02 OCT 04
RECORD DRAWING