


PROJECT NO.	YEAR	SHEET NO.	TOTAL SHEETS
35-05258-000		27	35

NOTE BOOK	TEMPLATE	AREAS	AREAS CHECKED
NO.			

DSWR, BLS OPER, BUS SCALE: 1"=1.00
 C:\2005\05258\1-SECS\pnd bnf2 sta 2000 to 2592\05258-C-s001 06-16-2005 11:01:34 am

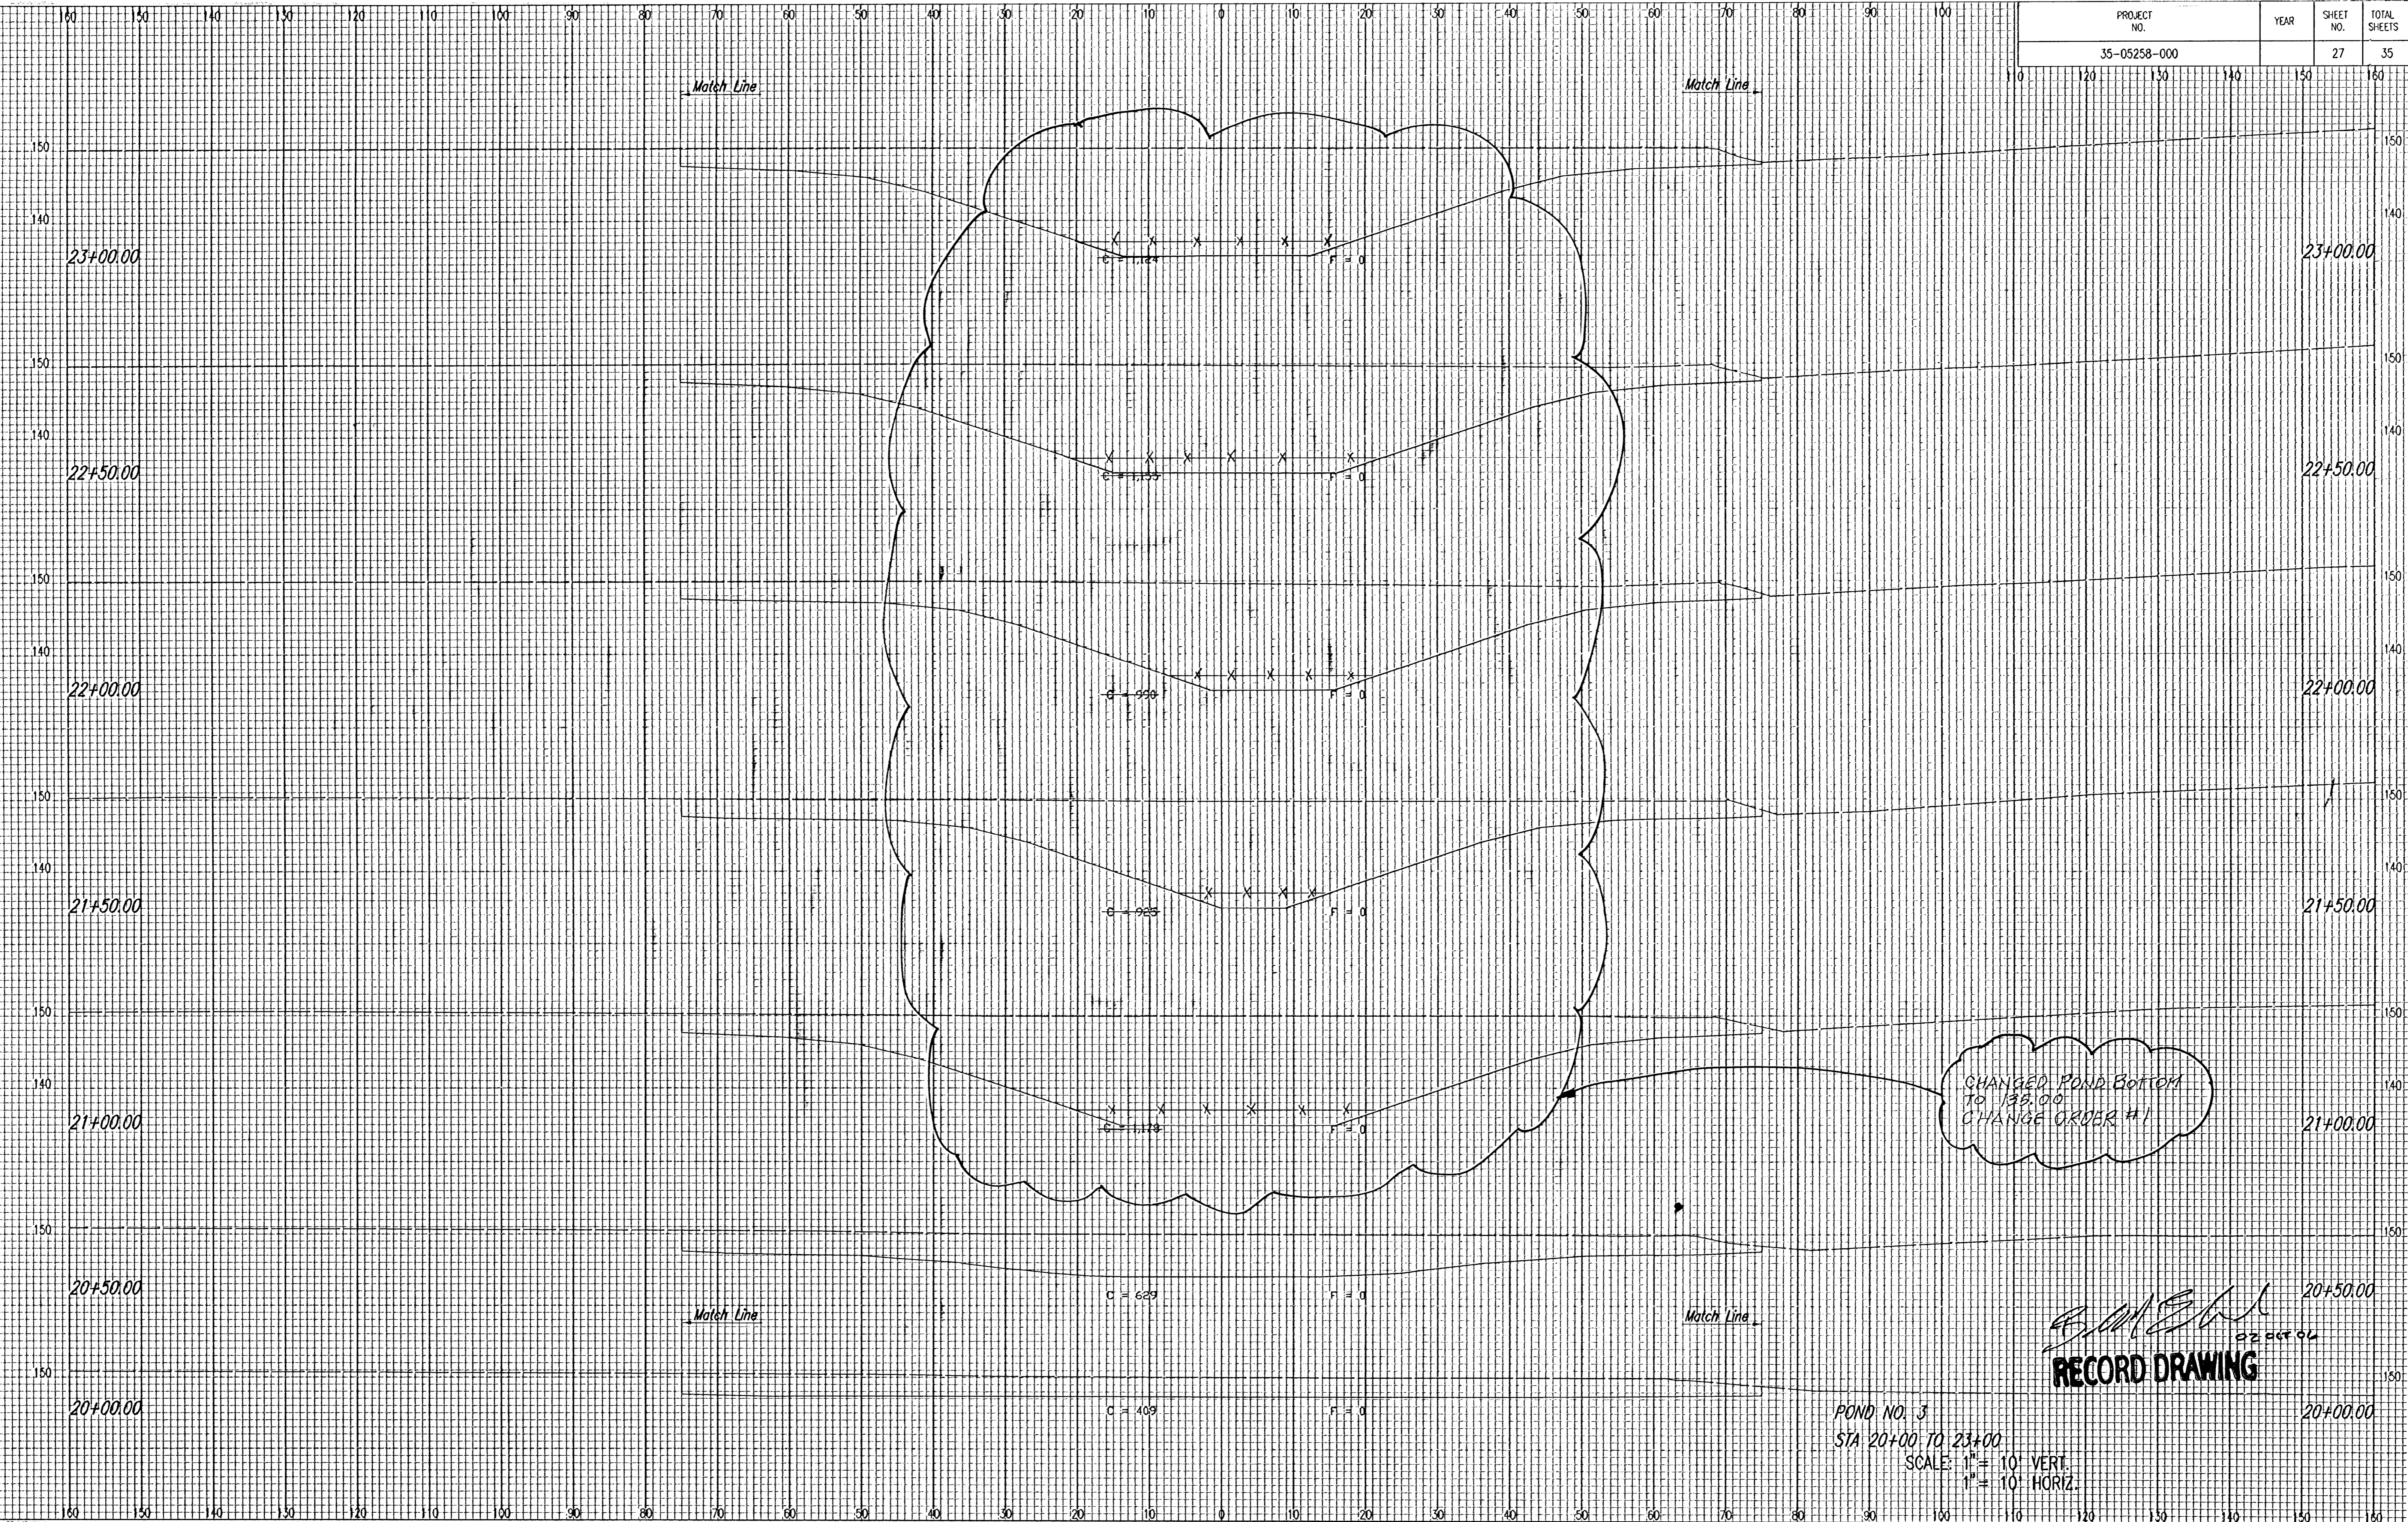

CHANGED POND BOTTOM TO 135.00
 CHANGE ORDER #1

B. M. G. H.
 02 27 04
RECORD DRAWING

POND NO. 3
 STA 20+00 TO 23+00
 SCALE: 1" = 10' VERT.
 1" = 10' HORIZ.