


BENCHMARK:
 R.R. SPIKE IN HLP, 150' E. & 30'
 S. OF THE S.W. COR., S.E. 1/4,
 SEC. 12-26-1W.
 ELEV. = 1338.96 M.S.L.
 ELEV. = 151.56 City Datum

"O" IN OPEN, TOP FLANGE OF
 FIRE HYDRANT AT THE S.W.
 CORNER OF 61ST. ST. N. &
 MERIDIAN AVE.
 ELEV. = 1339.16 M.S.L.
 ELEV. = 151.76 City Datum

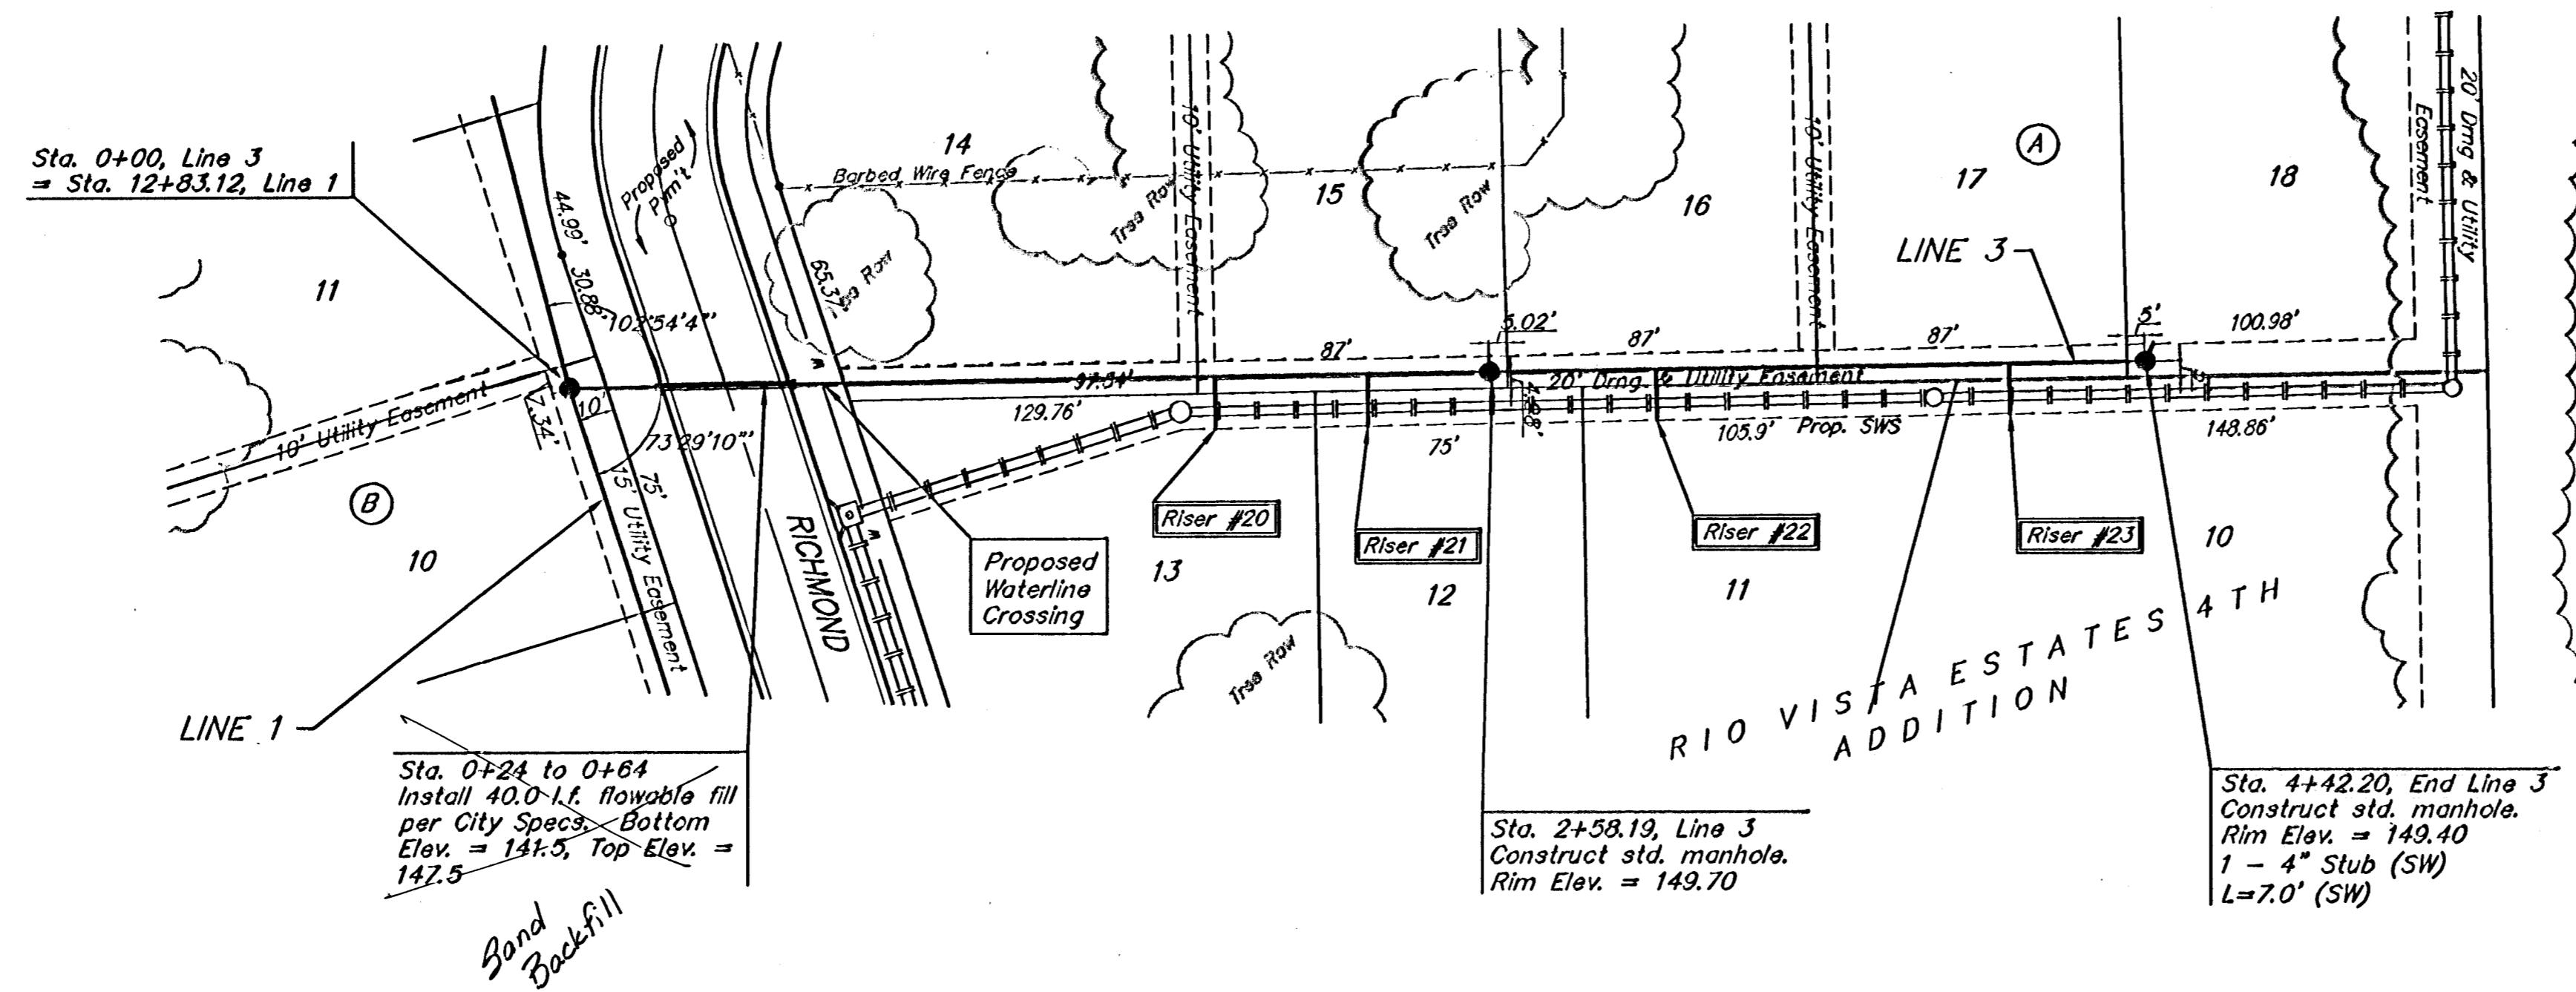


Scale: 1" = 40' Horizontal
 1" = 5' Vertical
 • = Iron

WILSON, JAMES A. ETUX
 6414 N. SHERIDAN
 WICHITA, KS 67204
 ZONED "SF-20"

⊗ Denotes Trees to be
 Removed by the
 Sanitary Sewer Contractor

SEWER SERVICE TABLE - See Sheet 6

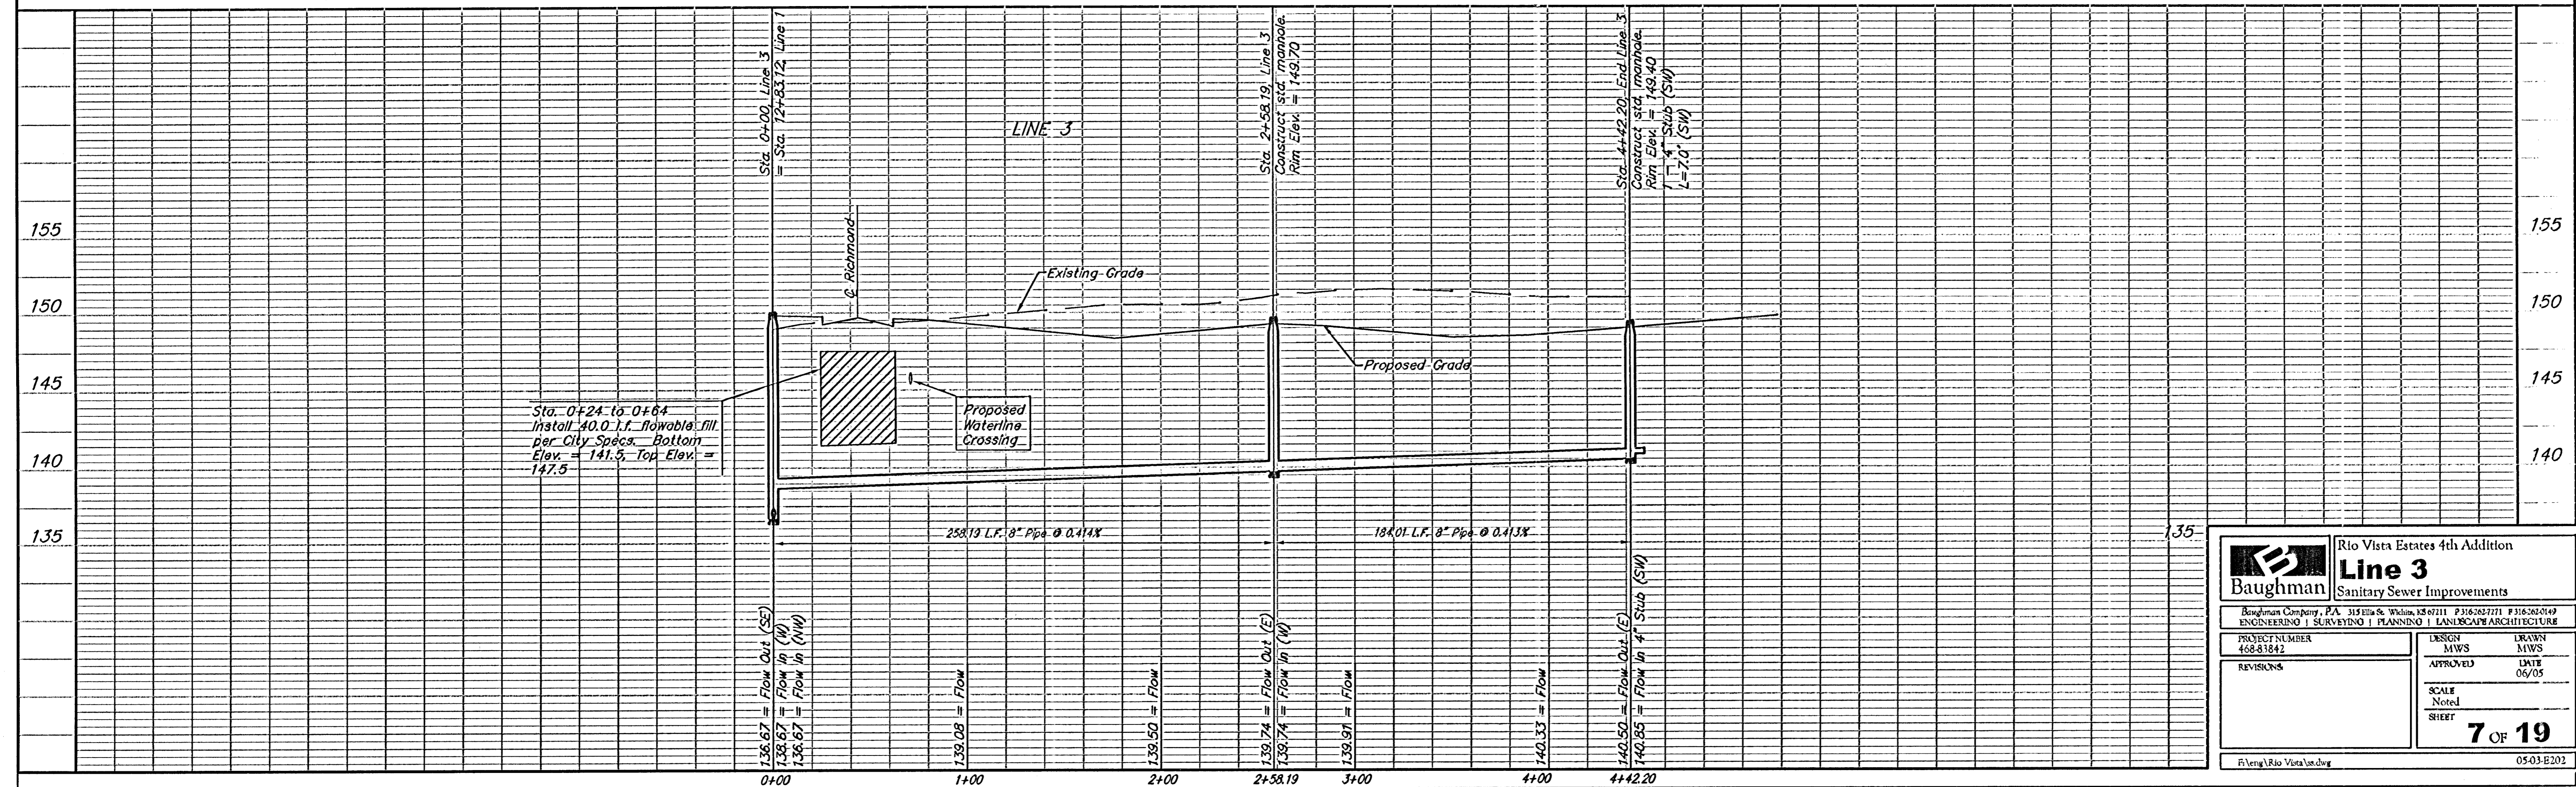

Rio Vista Estates 4th Addition Line 3 Sanitary Sewer Improvements	
Baughman Company, P.A. 315 Ellis St. Wichita, KS 67211 P 316-262-7771 F 316-262-0149 ENGINEERING SURVEYING PLANNING LANDSCAPE ARCHITECTURE	
PROJECT NUMBER 458-83842	DESIGN MWS APPROVED DATE 06/05
REVISIONS	SCALE Noted SHEET 7 OF 19
File: Rio Vista Sewer.dwg 05-03-2021	