
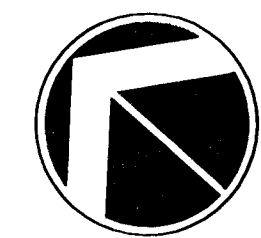


KEY

EARTHWORK SUMMARY

PHASE 3	
EXCAVATION	135,500 C.Y.
COMPACTED FILL (90% DENSITY)	116,100 C.Y.
COMPACTED FILL (95% DENSITY)	21,100 C.Y.
DITCH EXCAVATION	1,700 C.Y.

NOTE: 20% HAS BEEN ADDED TO FILL QUANTITIES TO ALLOW FOR COMPACTION.

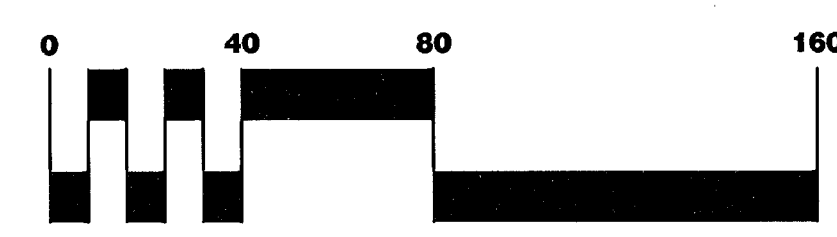

LEGEND

- WATER LINE
- SAN. SEWER LINE
- EXIST. CONTOURS
- PROP. CONTOURS
- LIMITS OF POND GRADING
- ADD ALTERNATE #1

1 REVISED - SEPTEMBER 15, 2004

REVISED POND GRADES REFLECT THE ORIGINAL EARTHWORK QUANTITY AS SET AT BID. POND CONTOURS REVISED WITH A REDUCE DEPTH OF POND BY 2 FEET. NEW POND DEPTH SHALL BE ELEV.=150.00

G:\CIVIL\99118\dwg\Grad\Ph-3\LAKE\LAK_GRD_2a.dwg 09/15/2004 10:47:01 AM CST



FOX RIDGE		
PROJECT NAME		
PHASE 3 LAKE GRADING - PONDS		
SHEET TITLE		
SRS/DG DESIGN BY:	DM DRAWN BY:	GJA CHECKED BY:
MAY 2004 DATE	LAK_GRD_2 JOB NO.	6 / 16 SHEET/OF