
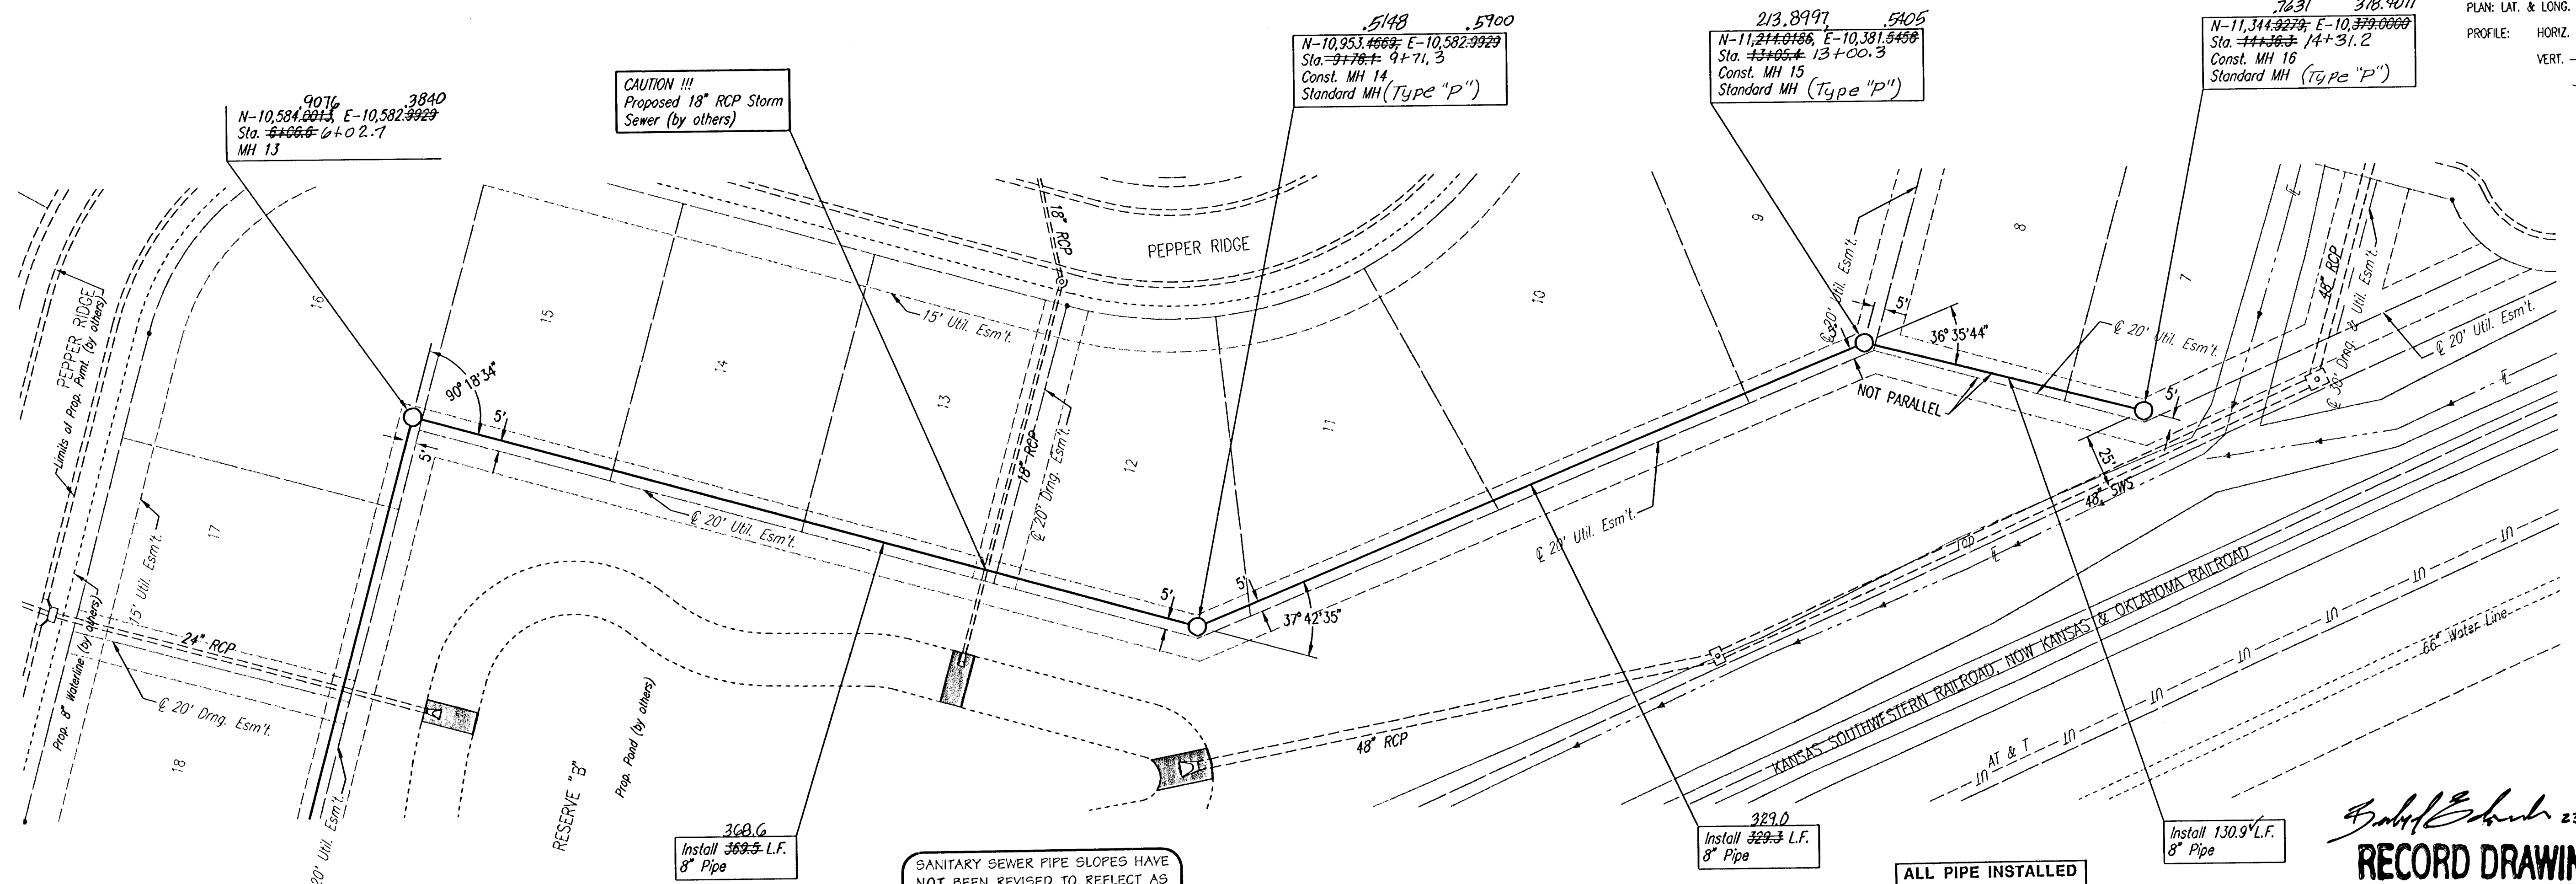


PLAN	CHECKED	DATE

PROFILE	CHECKED	DATE

DSNR: OPER. I.S. SCALE: 1"=40.00
 C:\2004\0442\001\sspp06 08-27-2004 02:29:57 pm

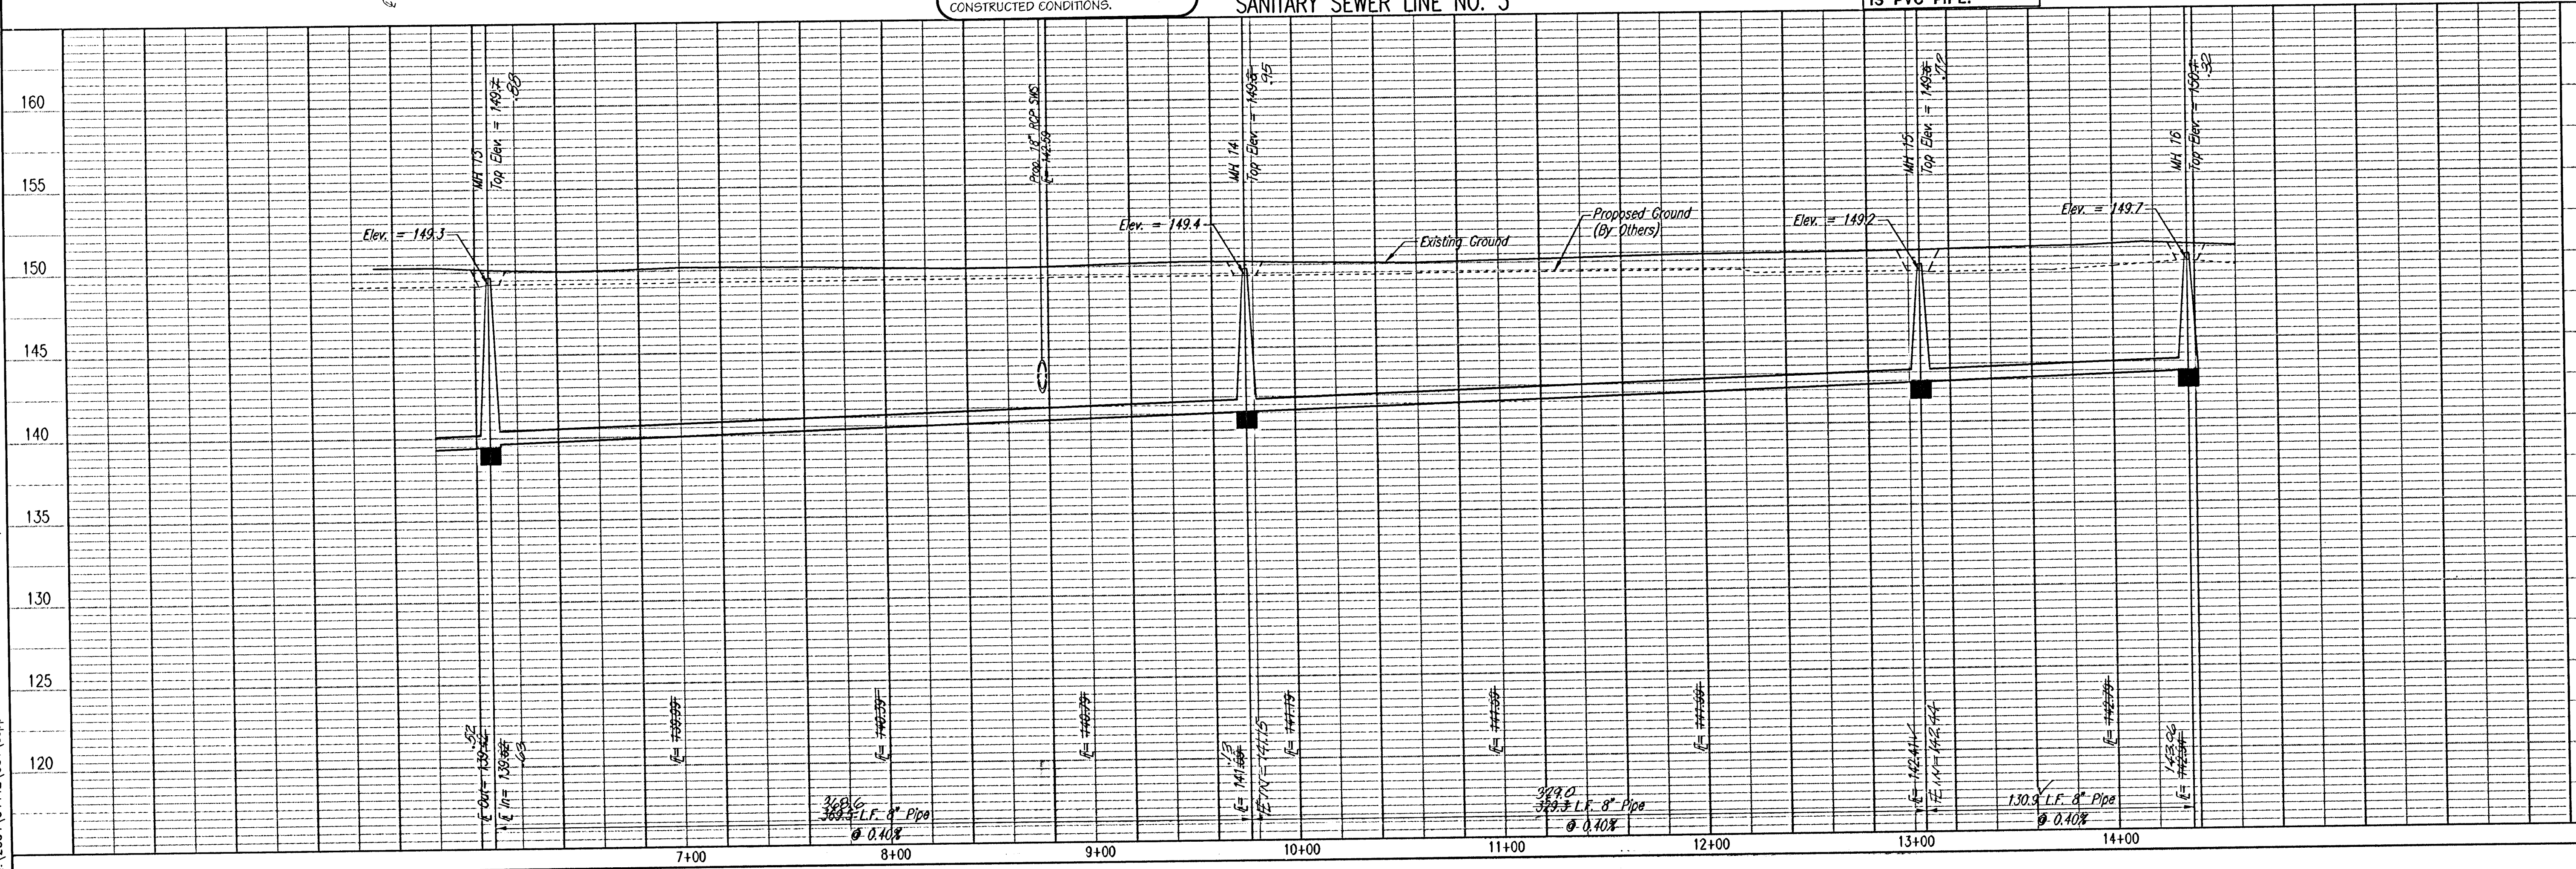

PLAN: LAT. & LONG. 0 40 80
 PROFILE: HORIZ. SAME AS ABOVE
 VERT. 0 5




CAUTION !!!
 Proposed 18" RCP Storm
 Sewer (by others)

SANITARY SEWER PIPE SLOPES HAVE
 NOT BEEN REVISED TO REFLECT AS
 CONSTRUCTED CONDITIONS.

SANITARY SEWER LINE NO. 3

ALL PIPE INSTALLED
 IS PVC PIPE.

RECORD DRAWING
 23 JUL 05

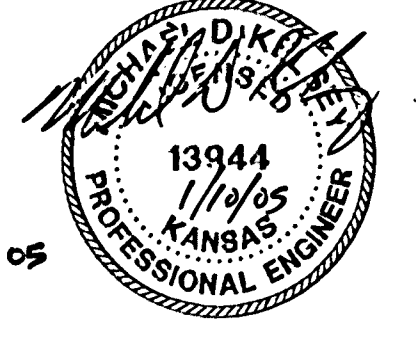

LATERAL 16, MAIN 19 OF THE
 SOUTHWEST INTERCEPTOR SEWER
SANITARY SEWER LINE NO. 3
 JAMES L. ARMOUR, P.E. - ACTING CITY ENGINEER
 CITY OF WICHITA PROJECT NO. 488-8748

Professional Engineering Consultants, P.A.
 303 S. TOPICKA - WICHITA, KANSAS 67202
 316-262-2691 • FAX 316-262-3669

Designed By: MJK
 Drawn By: JCA
 Job No.: 35-04442-001-042
 Date: July 2004