

LATERAL 6, MAIN 26 OF THE WAR INDUSTRIES SEWER IN THE CITY OF WICHITA

83895

OCA NO. 744094
CITY OF WICHITA PROJECT NO. 468-83895
JAMES L. ARMOUR, P.E. - ACTING CITY ENGINEER

WB Carter Construction Co., Inc. - Contractor


Thom, City - Inspector

Released 5/10/05

As-Built

Risers + Stubs

.pdf by JDL 7/21/05

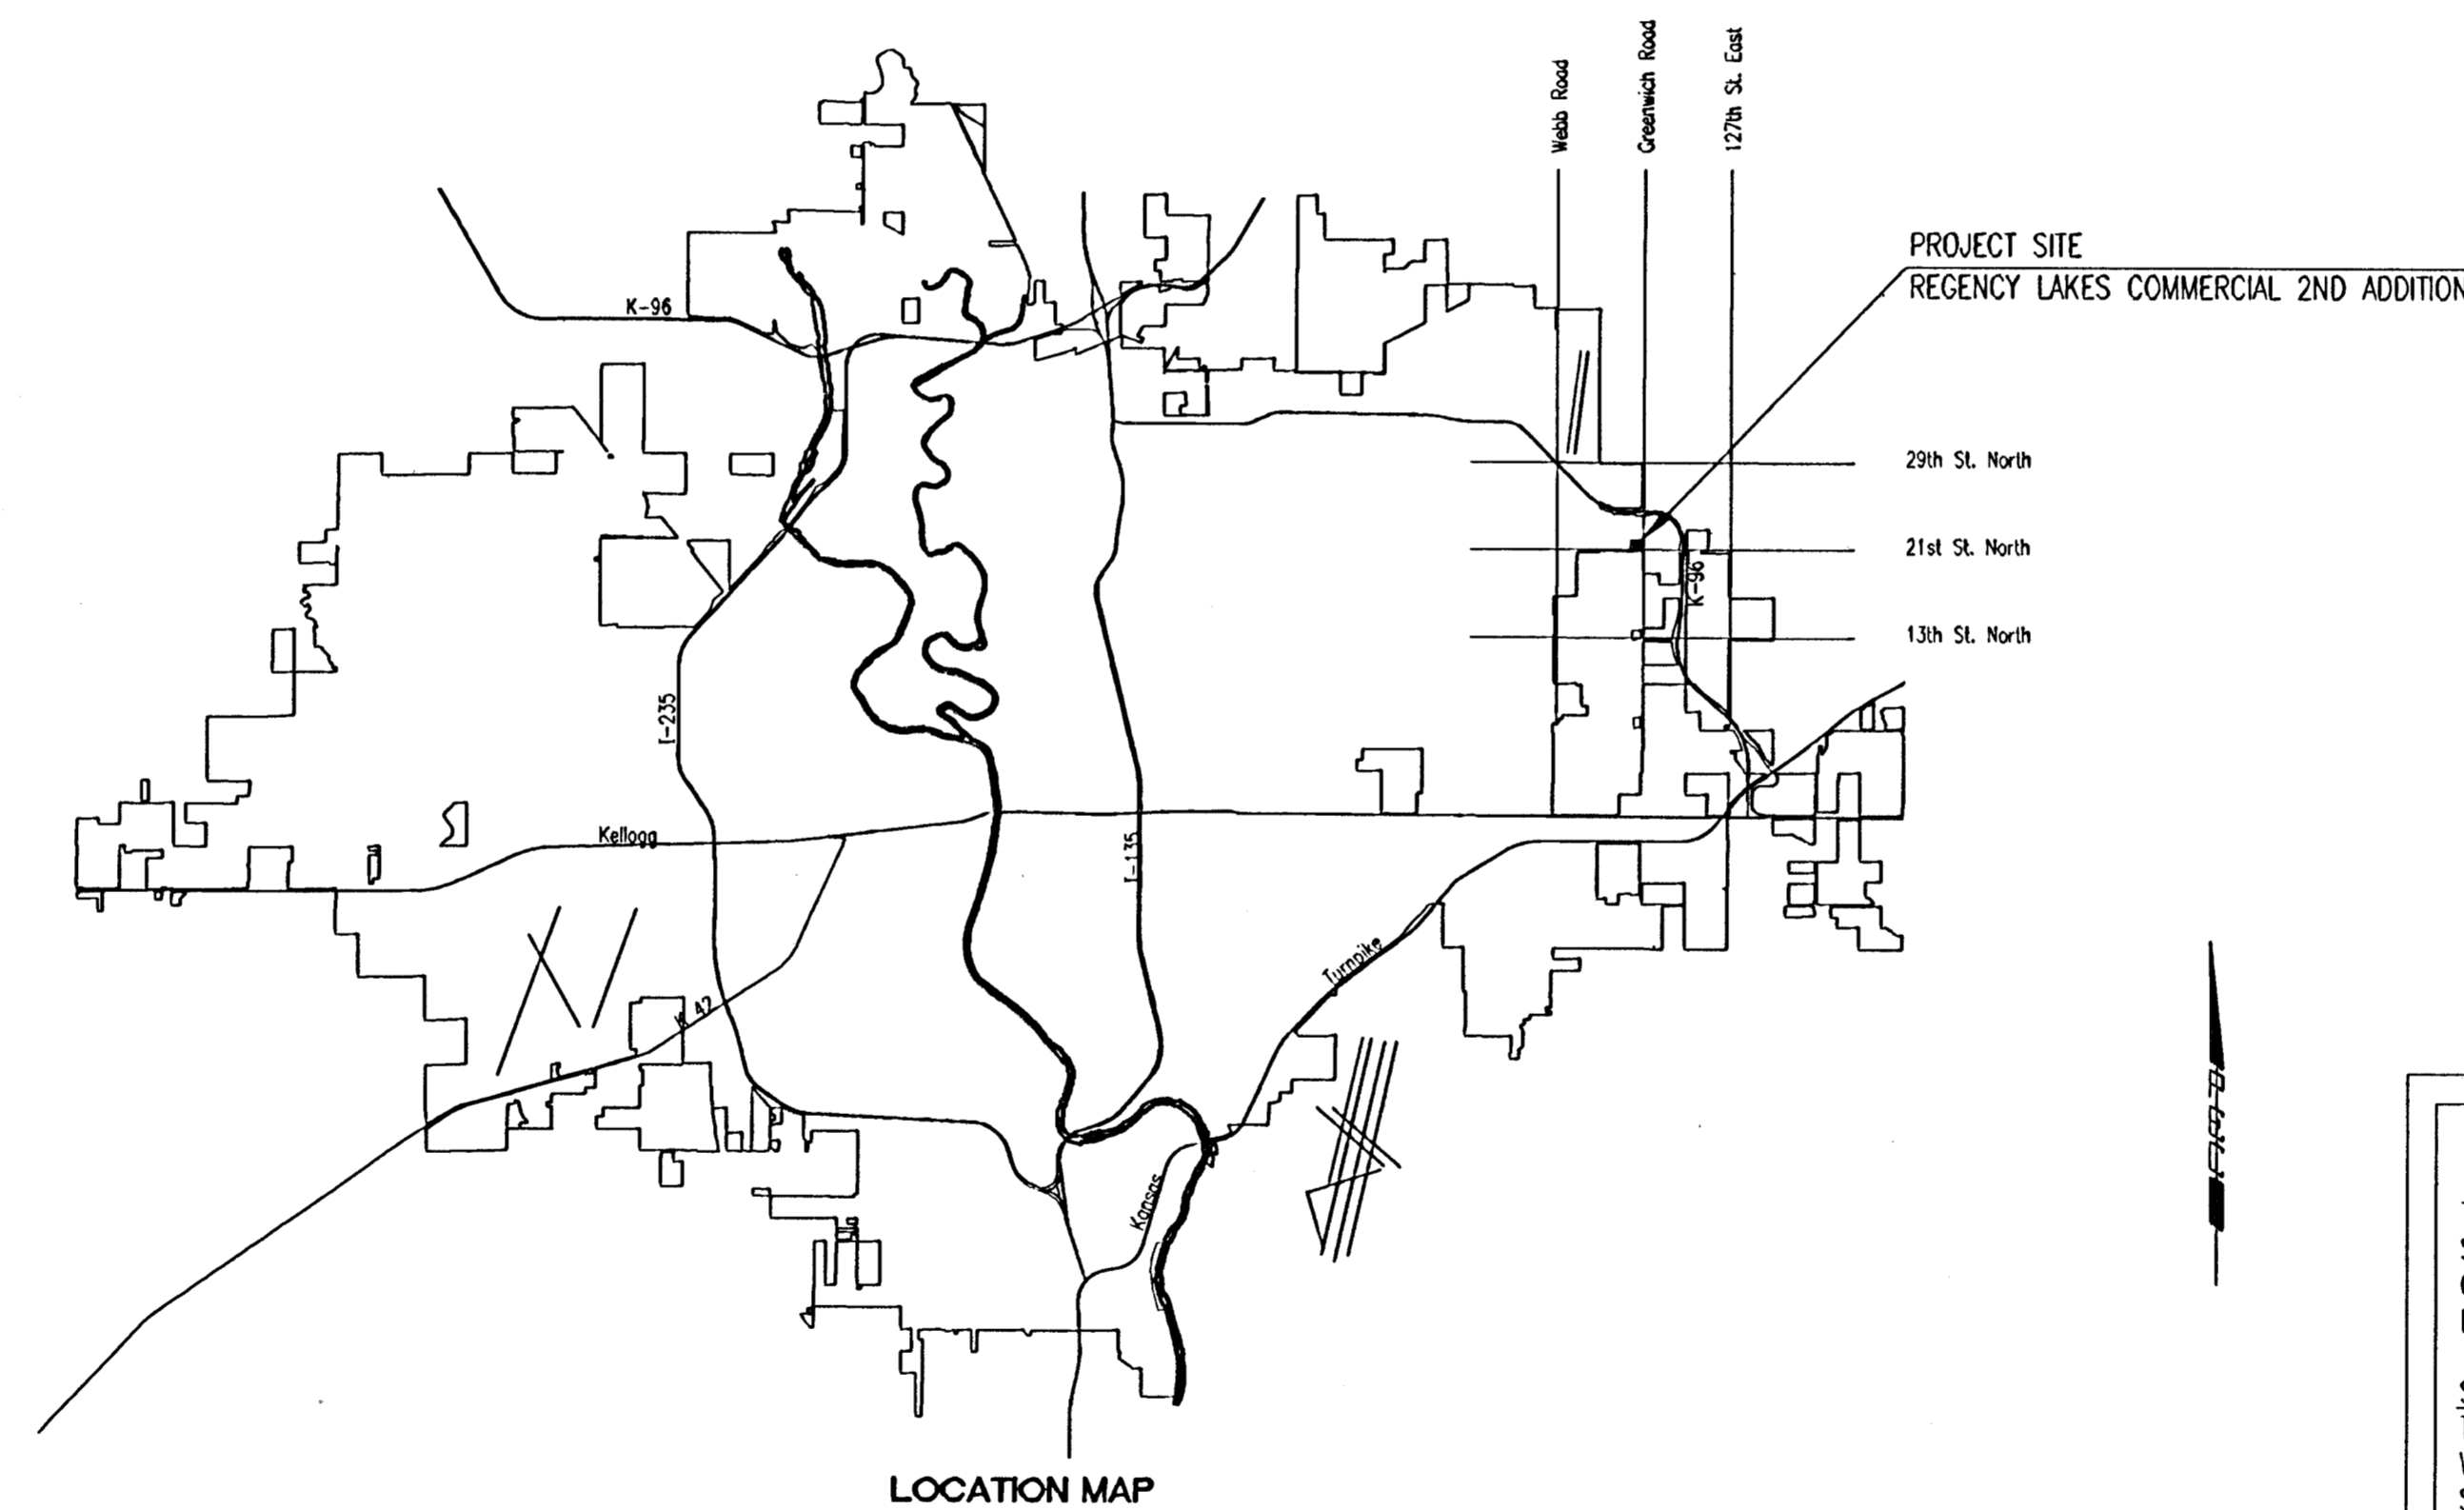

INDEX OF SHEETS

| | |
|-----------------|----------------------------|
| SHEET NO. 1 | TITLE SHEET |
| SHEET NO. 2 | KEY MAP AND GENERAL NOTES |
| SHEET NO. 3 | PLAT |
| SHEET NO. 4-5 | PLAN/PROFILE |
| SHEET NO. 6 | TYPE "P" MANHOLE DETAILS |
| SHEET NO. 7 | FRAME & COVER DETAILS |
| SHEET NO. 8 | RISER DETAILS |
| SHEET NO. 9 | MANHOLE ADJUSTMENT DETAILS |
| SHEET NO. 10-13 | SOIL EROSION BMP DETAILS |

CONSTRUCTION SCHEDULE/SEQUENCE

THE CONTRACTOR FOR EACH OF THE FOLLOWING REGENCY LAKES COMMERCIAL 2ND ADDITION PROJECTS SHALL COORDINATE THEIR EFFORTS WITH OTHER CONTRACTORS WORKING ON-SITE SUCH THAT CONSTRUCTION CAN PROCEED CONCURRENTLY WHENEVER POSSIBLE TO PREVENT UNDUE DELAYS SO THAT EACH PROJECT CAN BE COMPLETED WITHIN THE TIME FRAME NOTED.

SANITARY SEWER (468-83895)

THE CONTRACTOR SHALL CONSTRUCT SANITARY SEWER LINE NO. 1 AND LINE NO. 2 PRIOR TO COMMENCING WORK ON OTHER PORTIONS OF THE PROJECT. ALL WORK ON THE REGENCY LAKES COMMERCIAL 2ND ADDITION SANITARY SEWER IMPROVEMENTS SHALL BE COMPLETED BY FEBRUARY 04, 2005.

WATER DISTRIBUTION SYSTEM (448-90006)

THE CONTRACTOR SHALL COMPLETE ALL WORK ON THE REGENCY LAKES COMMERCIAL 2ND ADDITION WATER DISTRIBUTION SYSTEM IMPROVEMENTS BY FEBRUARY 18, 2005.

NOVEMBER 2004

PLANS PREPARED BY
PROFESSIONAL ENGINEERING CONSULTANTS, P.A.
ENGINEERS
WICHITA, KANSAS

