

MAIN 17, FOUR MILE CREEK CRESTVIEW SEWER - PHASE 1

IN

THE CITY OF WICHITA

OCA NO. 624078


CITY OF WICHITA PROJECT NO. 468-83903
JAMES L. ARMOUR, P.E. - ACTING CITY ENGINEER

Wildcat Construction Co., Inc. - Contractor
Strothman, City - Inspector
Released 6/6/05
As-Built
.pdf by JDL 8/1/06

CONSTRUCTION SEQUENCE:

THE CONTRACTOR SHALL COMMENCE WITH CONSTRUCTION ON LINE NO. 1 FROM MH 1 TO MH 9, AND LINE NO. 2 AND LINE NO. 3 IN ITS ENTIRETY PRIOR TO PROCEEDING WITH PIPE LAYING OPERATIONS FOR THE REMAINDER OF LINE NO. 1. ALL CART PATHS REMOVED AS PART OF THIS WORK SHALL BE PERMANENTLY REPLACED ALONG WITH RESTORATION OF ALL OTHER ITEMS AND FINAL GRADING AND CLEAN UP OF THIS PORTION OF THE PROJECT. ALSO THE CONTRACTOR WILL BE REQUIRED TO COMPLETE ALL TESTING OF THESE LINES PRIOR TO PROCEEDING WITH THE REMAINDER OF THE WORK. ONCE THESE ARE COMPLETED AND TESTED, ACCESS ALONG THIS AREA WILL BE LIMITED ONLY TO THE LANDSCAPING SUBCONTRACTOR FOR SODDING OF DISTURBED AREAS. IN ADDITION, THE CONTRACTOR WILL BE REQUIRED TO TEST ALL LINES AND MANHOLES WHEN THE FOLLOWING PORTIONS OF THE PROJECT ARE COMPLETED:

1. LINE NO. 1 MH 1 TO MH 4
2. LINE NO. 2 AND LINE NO. 2A
3. LINE NO. 1 MH 4 TO MH 9 AND LINE NO. 3
4. LINE NO. 1 MH 9 TO MH 14
5. LINE NO. 1 MH 14 TO MH 17
6. LINE NO. 1 MH 17 TO MH 23
7. LINE NO. 1 MH 23 TO CRESTVIEW PUMP STATION

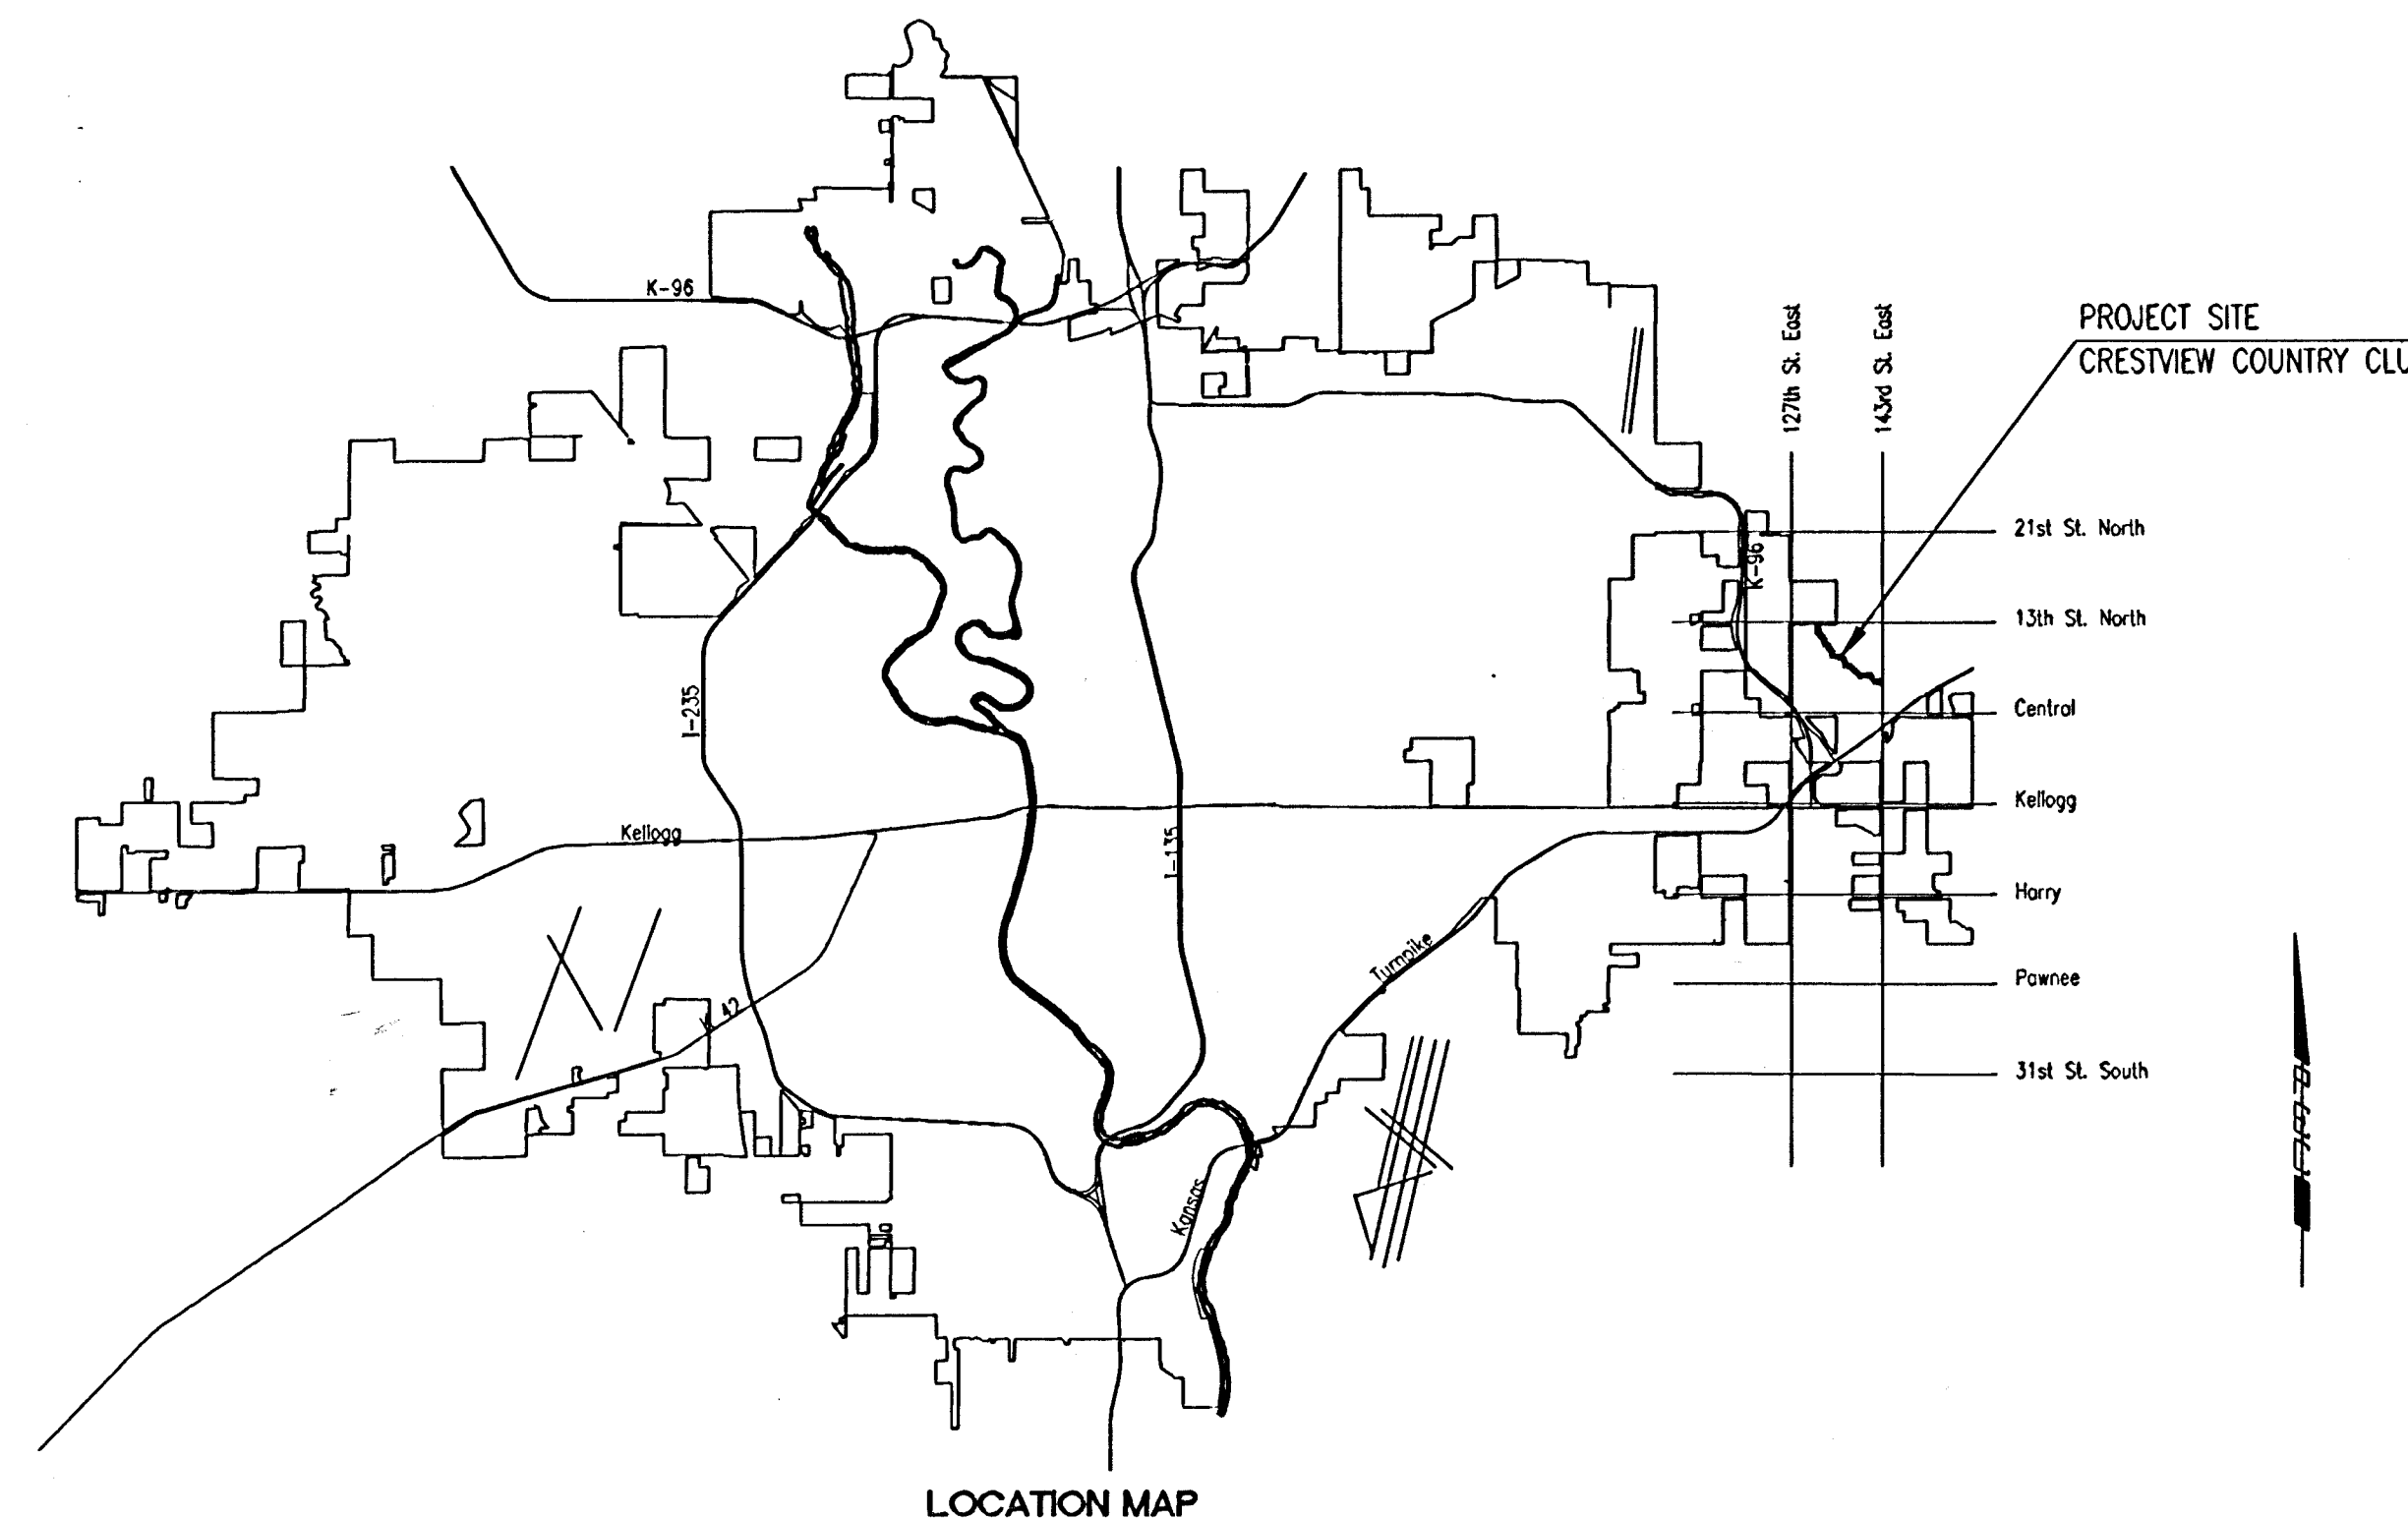


INDEX OF SHEETS


SHEET NO. 1	TITLE SHEET
SHEET NO. 2	KEY MAP AND GENERAL NOTES
SHEET NO. 3	HORIZONTAL AND VERTICAL CONTROL
SHEET NO. 4-11	PLAN/PROFILE
SHEET NO. 12	PUMP STATION ABANDONMENT PLAN
SHEET NO. 13	FORCE MAIN ABANDONMENT AND MISCELLANEOUS DETAILS
SHEET NO. 14	GOLF COURSE IRRIGATION PLAN - NORTH PORTION
SHEET NO. 15	GOLF COURSE IRRIGATION PLAN - SOUTH PORTION
SHEET NO. 16	TYPE "P" MANHOLE DETAILS
SHEET NO. 17	FRAME & COVER DETAILS
SHEET NO. 18	POND GRADING
SHEET NO. 19	CART PATH BRIDGE REMOVAL/RESETTING
SHEET NO. 20-23	SOIL EROSION BMP DETAILS

SEPTEMBER 2004

PLANS PREPARED BY

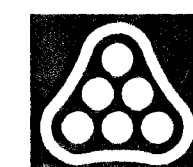

Professional Engineering Consultants, P.A.
303 S. TOPEKA • WICHITA, KANSAS 67202 • 316-262-2691 • FAX 316-262-3003
www.pec1.com

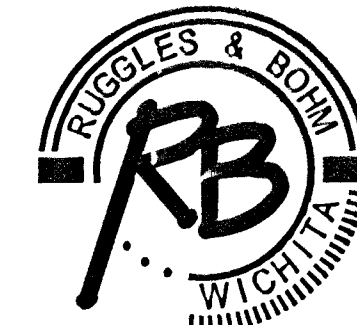

Ruggles & Bohm, P.A.
Engineering, Surveying, Land Planning
924 North Main (316) 264-8008
Wichita, Kansas 67203 (316) 264-4621 fax
www.rbkansas.com E-mail: info@rbkansas.com

