


PROJECT NO.	YEAR	SHEET NO.	TOTAL SHEETS
35-05257-000		24	31

ROUTE BOOK	TEMPLATE	AREAS	CHECKED
NO.			

DSNR: BUB OPER: BUS SCALE: 1"=100'
 C:\2005\05257\X-SECS\wd ph1 sta 2000 to 2150\05257-C-s001 06-16-2005 01:08:30 pm

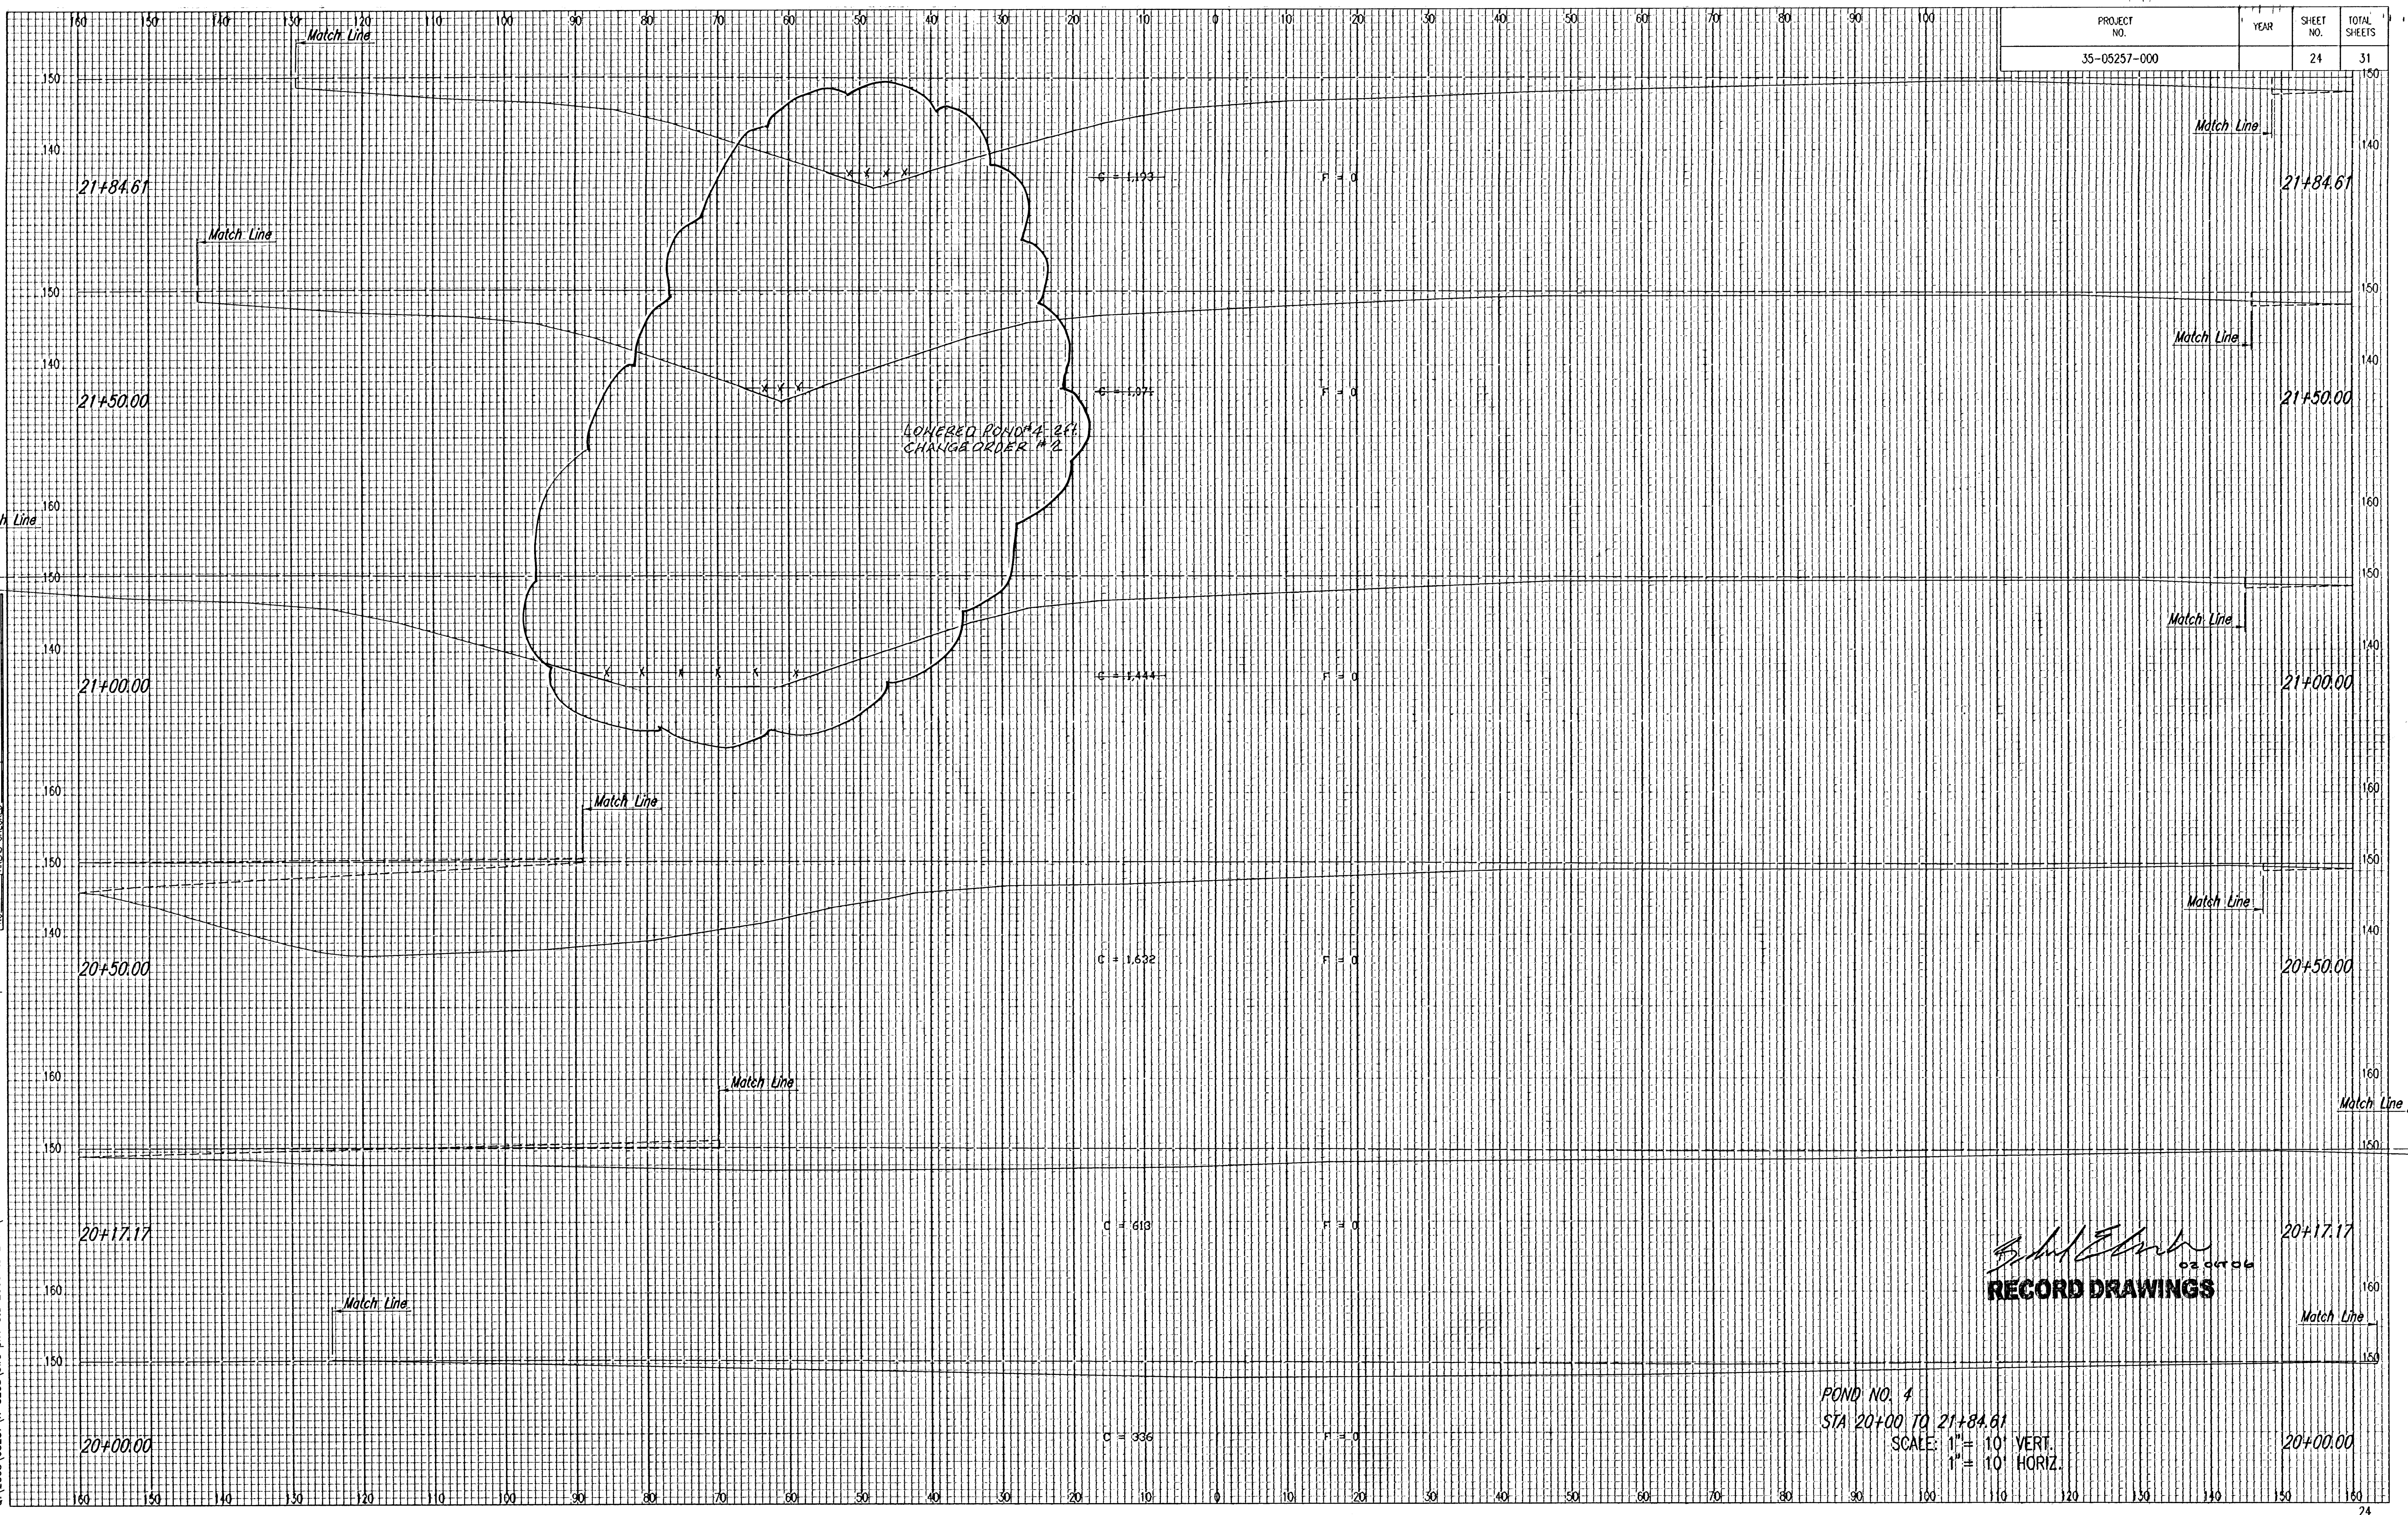

[Signature]
 02 OCT 06
RECORD DRAWINGS

POND NO. 4
 STA 20+00 TO 21+84.61
 SCALE: 1" = 10' VERT.
 1" = 10' HORIZ.