
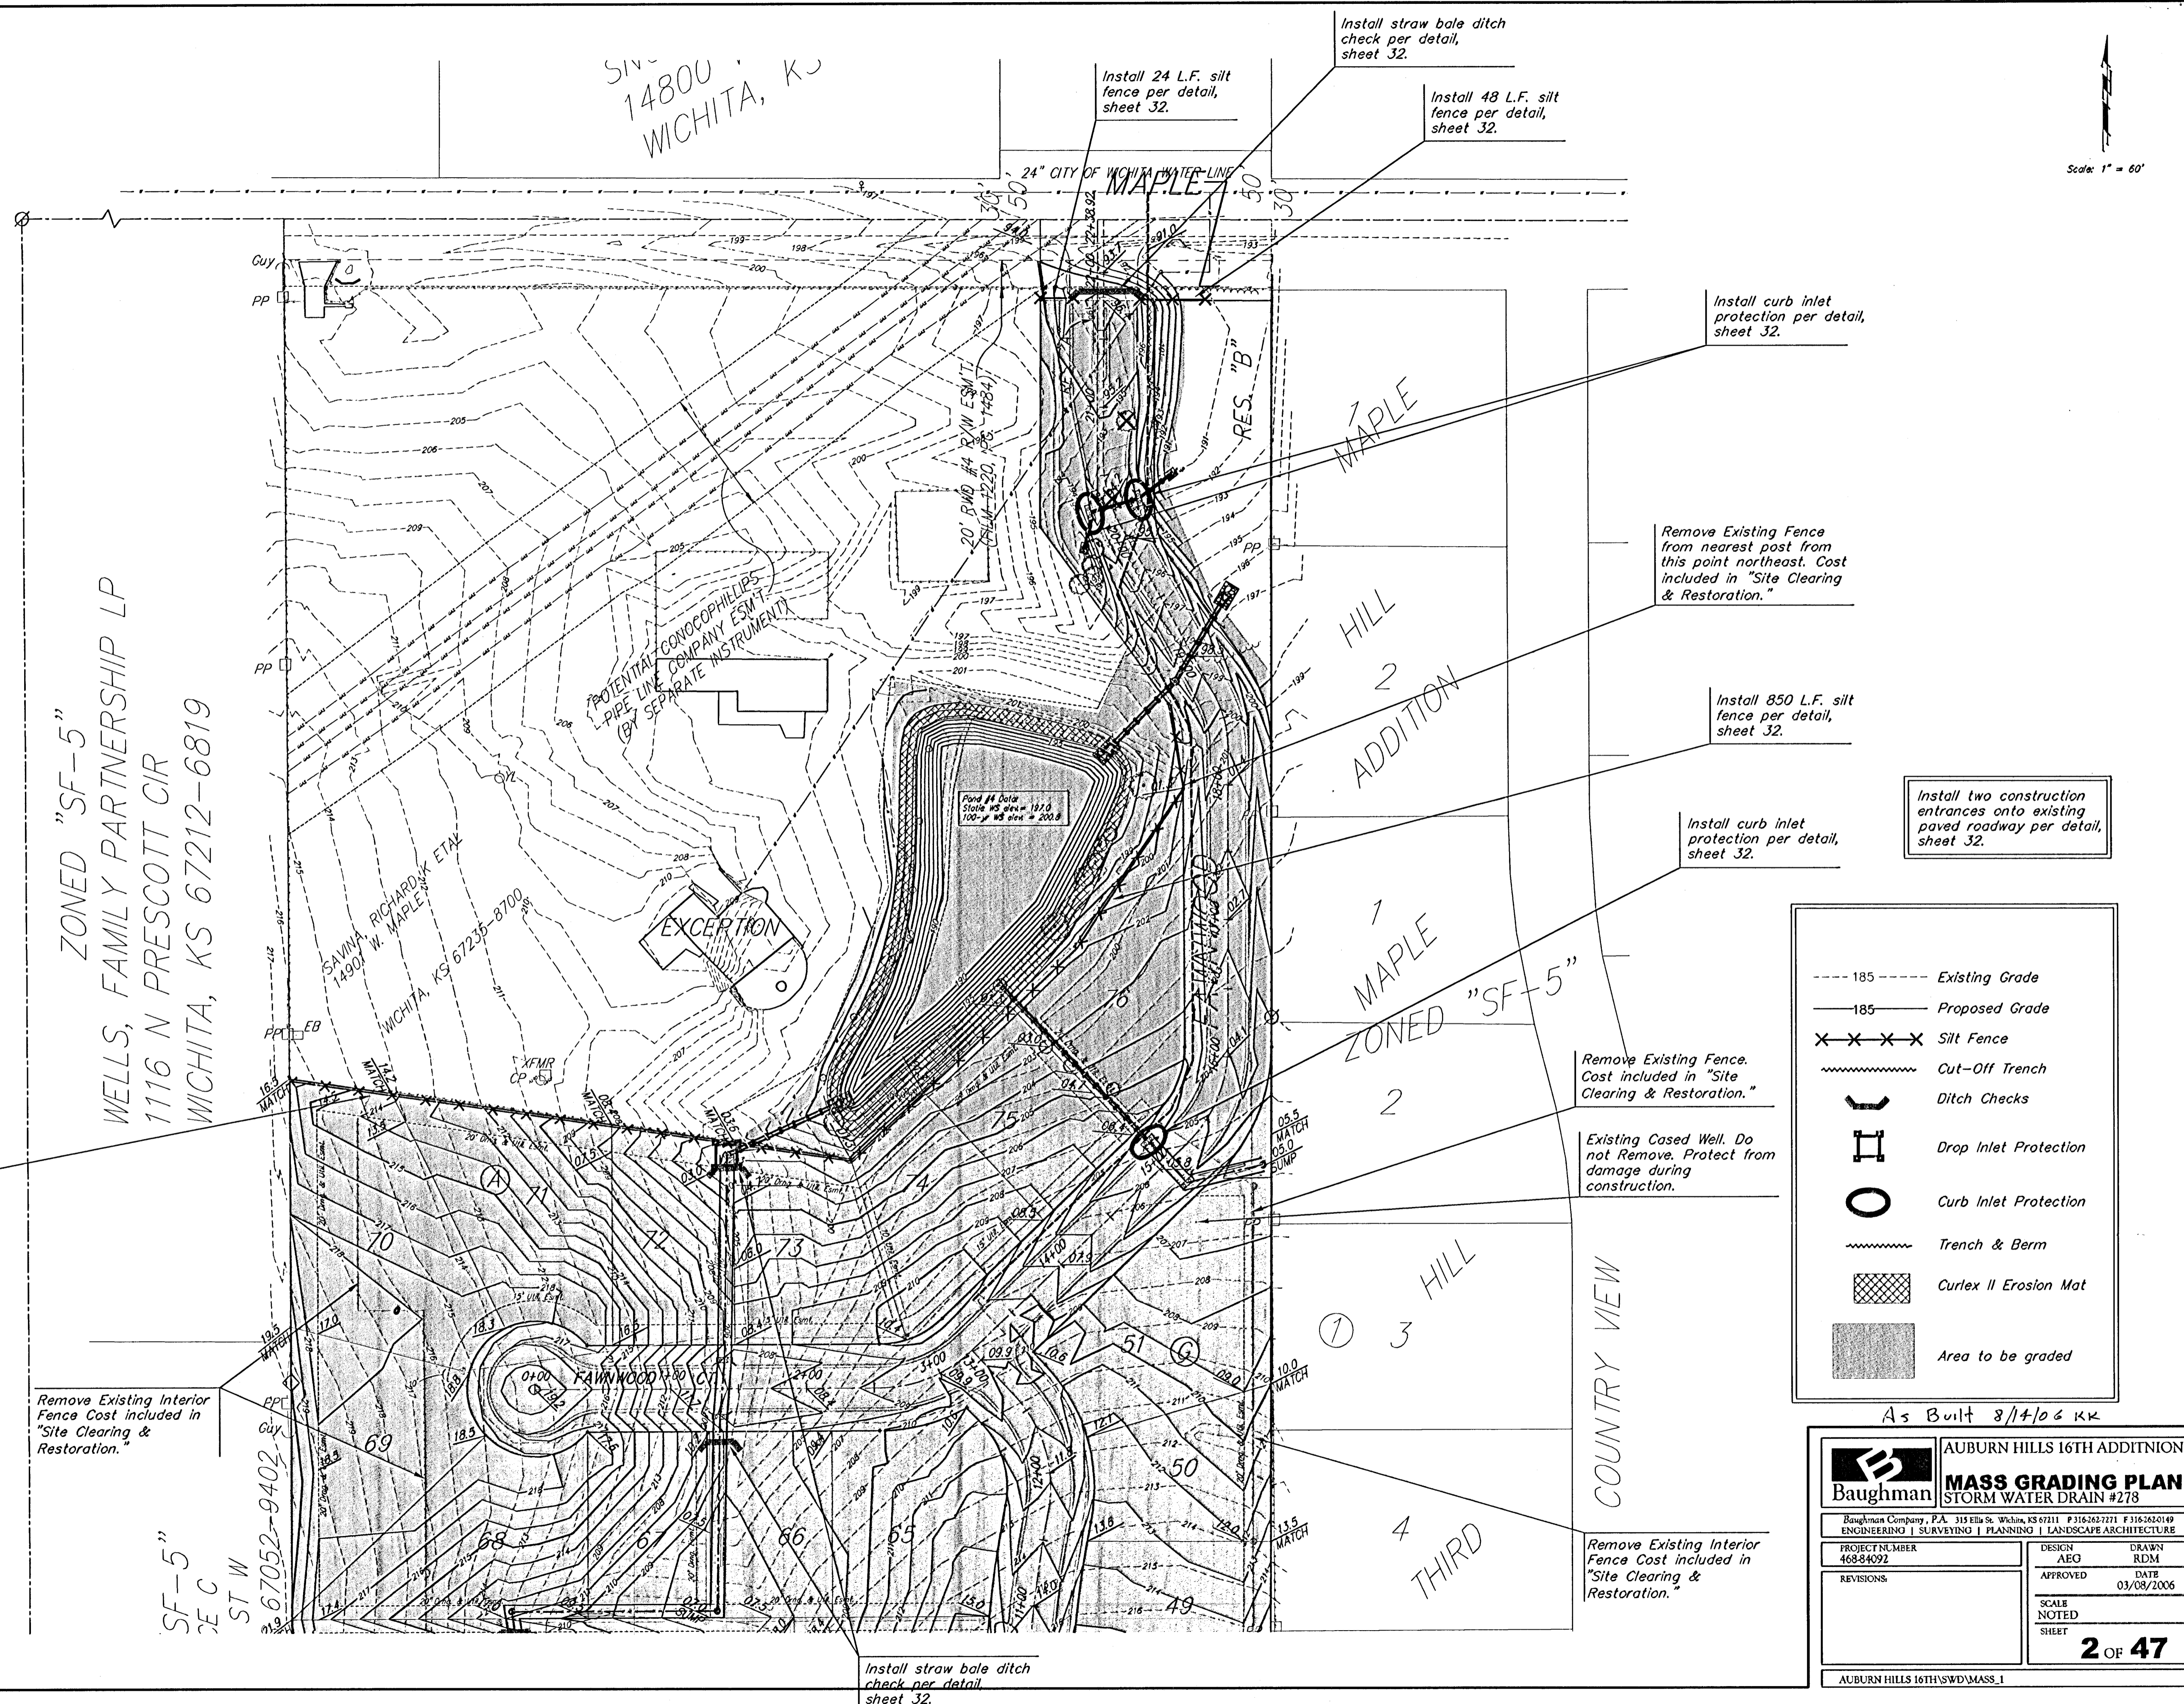


BM #1
 "C" Cut on Top of Curb at West Line of Lot 7, Block A, Auburn Hills 5th Addition.
 Elevation = 207.73 (City Datum)

BM #2
 Disc in Back of Curb, North of Front Corner Common to Lots 23 and 24, Block D, Auburn Hills 12th Addition.
 Elevation = 191.84 (City Datum)

BM #3
 "C" Cut in Middle of Curb Inlet Top Adjacent to the South Corner of Lot 15, Block B.
 Elevation = 196.44 (City Datum)

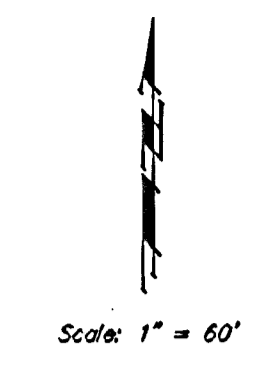

Remove Existing Fence from nearest post from this point south. Cost included in "Site Clearing & Restoration."

Remove Existing Interior Fence Cost included in "Site Clearing & Restoration."

Remove Existing Fence. Cost included in "Site Clearing & Restoration."

Existing Cased Well. Do not Remove. Protect from damage during construction.

Remove Existing Interior Fence Cost included in "Site Clearing & Restoration."

EROSION CONTROL MEASURE	UNITS	QUANTITY
SILT FENCE	L.F.	3,995
DROP INLET BARRIER	EA.	4
CURB INLET BARRIER	EA.	9
STRAW BALE BARRIER	EA.	27
EROSION CONTROL BERM	L.F.	3,417
CURLEX II	S.Y.	8,664
CONSTRUCTION ENTRANCE	EA.	2

QUANTITIES ARE FOR INFORMATION ONLY. CONTRACTOR SHALL VERIFY QUANTITIES PER FINAL BID QUANTITY SHEET.

--- 185 ---	Existing Grade
— 185 —	Proposed Grade
X X X X	Silt Fence
~~~~~	Cut-Off Trench
U	Ditch Checks
H	Drop Inlet Protection
O	Curb Inlet Protection
~~~~~	Trench & Berm
[Cross-hatched]	Curlex II Erosion Mat
[Stippled]	Area to be graded

As Built 8/14/06 KK

Baughman AUBURN HILLS 16TH ADDITION
MASS GRADING PLAN
 STORM WATER DRAIN #278

Baughman Company, P.A. 315 Ellis St. Wichita, KS 67211 P 316-262-7271 F 316-262-0149
 ENGINEERING | SURVEYING | PLANNING | LANDSCAPE ARCHITECTURE

PROJECT NUMBER 468-84092	DESIGN AEG	DRAWN RDM
REVISIONS:	APPROVED	DATE 03/09/2006
	SCALE NOTED	SHEET 2 OF 47

AUBURN HILLS 16TH SWD/MASS.1