

BENCHMARK:
 "□" CUT ON TOP OF CURB
 AT WEST LINE OF LOT 7,
 BLOCK A, AUBURN HILLS 5TH
 ADD.
 ELEV. = 1395.13 NGVD29


DISC IN BACK OF CURB,
 NORTH OF FRONT CORNER
 COMMON TO LOTS 23 AND 24,
 BLOCK D, AUBURN HILLS 12TH
 ADD.
 ELEV. = 1379.24 NGVD29

"□" CUT ON CENTER OF
 CATCH BASIN, NORTH OF LOT
 CORNER COMMON TO LOTS 1
 AND 15, BLOCK B, AUBURN
 HILLS 14TH ADD.
 ELEV. = 1381.05 NGVD29


Pond Data:
 Static WS elev. = 202.0
 100-yr WS elev. = 204.3

Sta 0+04, Begin Line 5
 Begin construction of
 36" RCP
 1 - 36" Headwall
 19 S.Y. heavy stone rip-rap

Sta 1+64.8, End Line 5
 Construct std. type 1A
 inlet (10'x3')
 1 - 36" Stub (N) w/ plug
 Top Elev. = 209.50

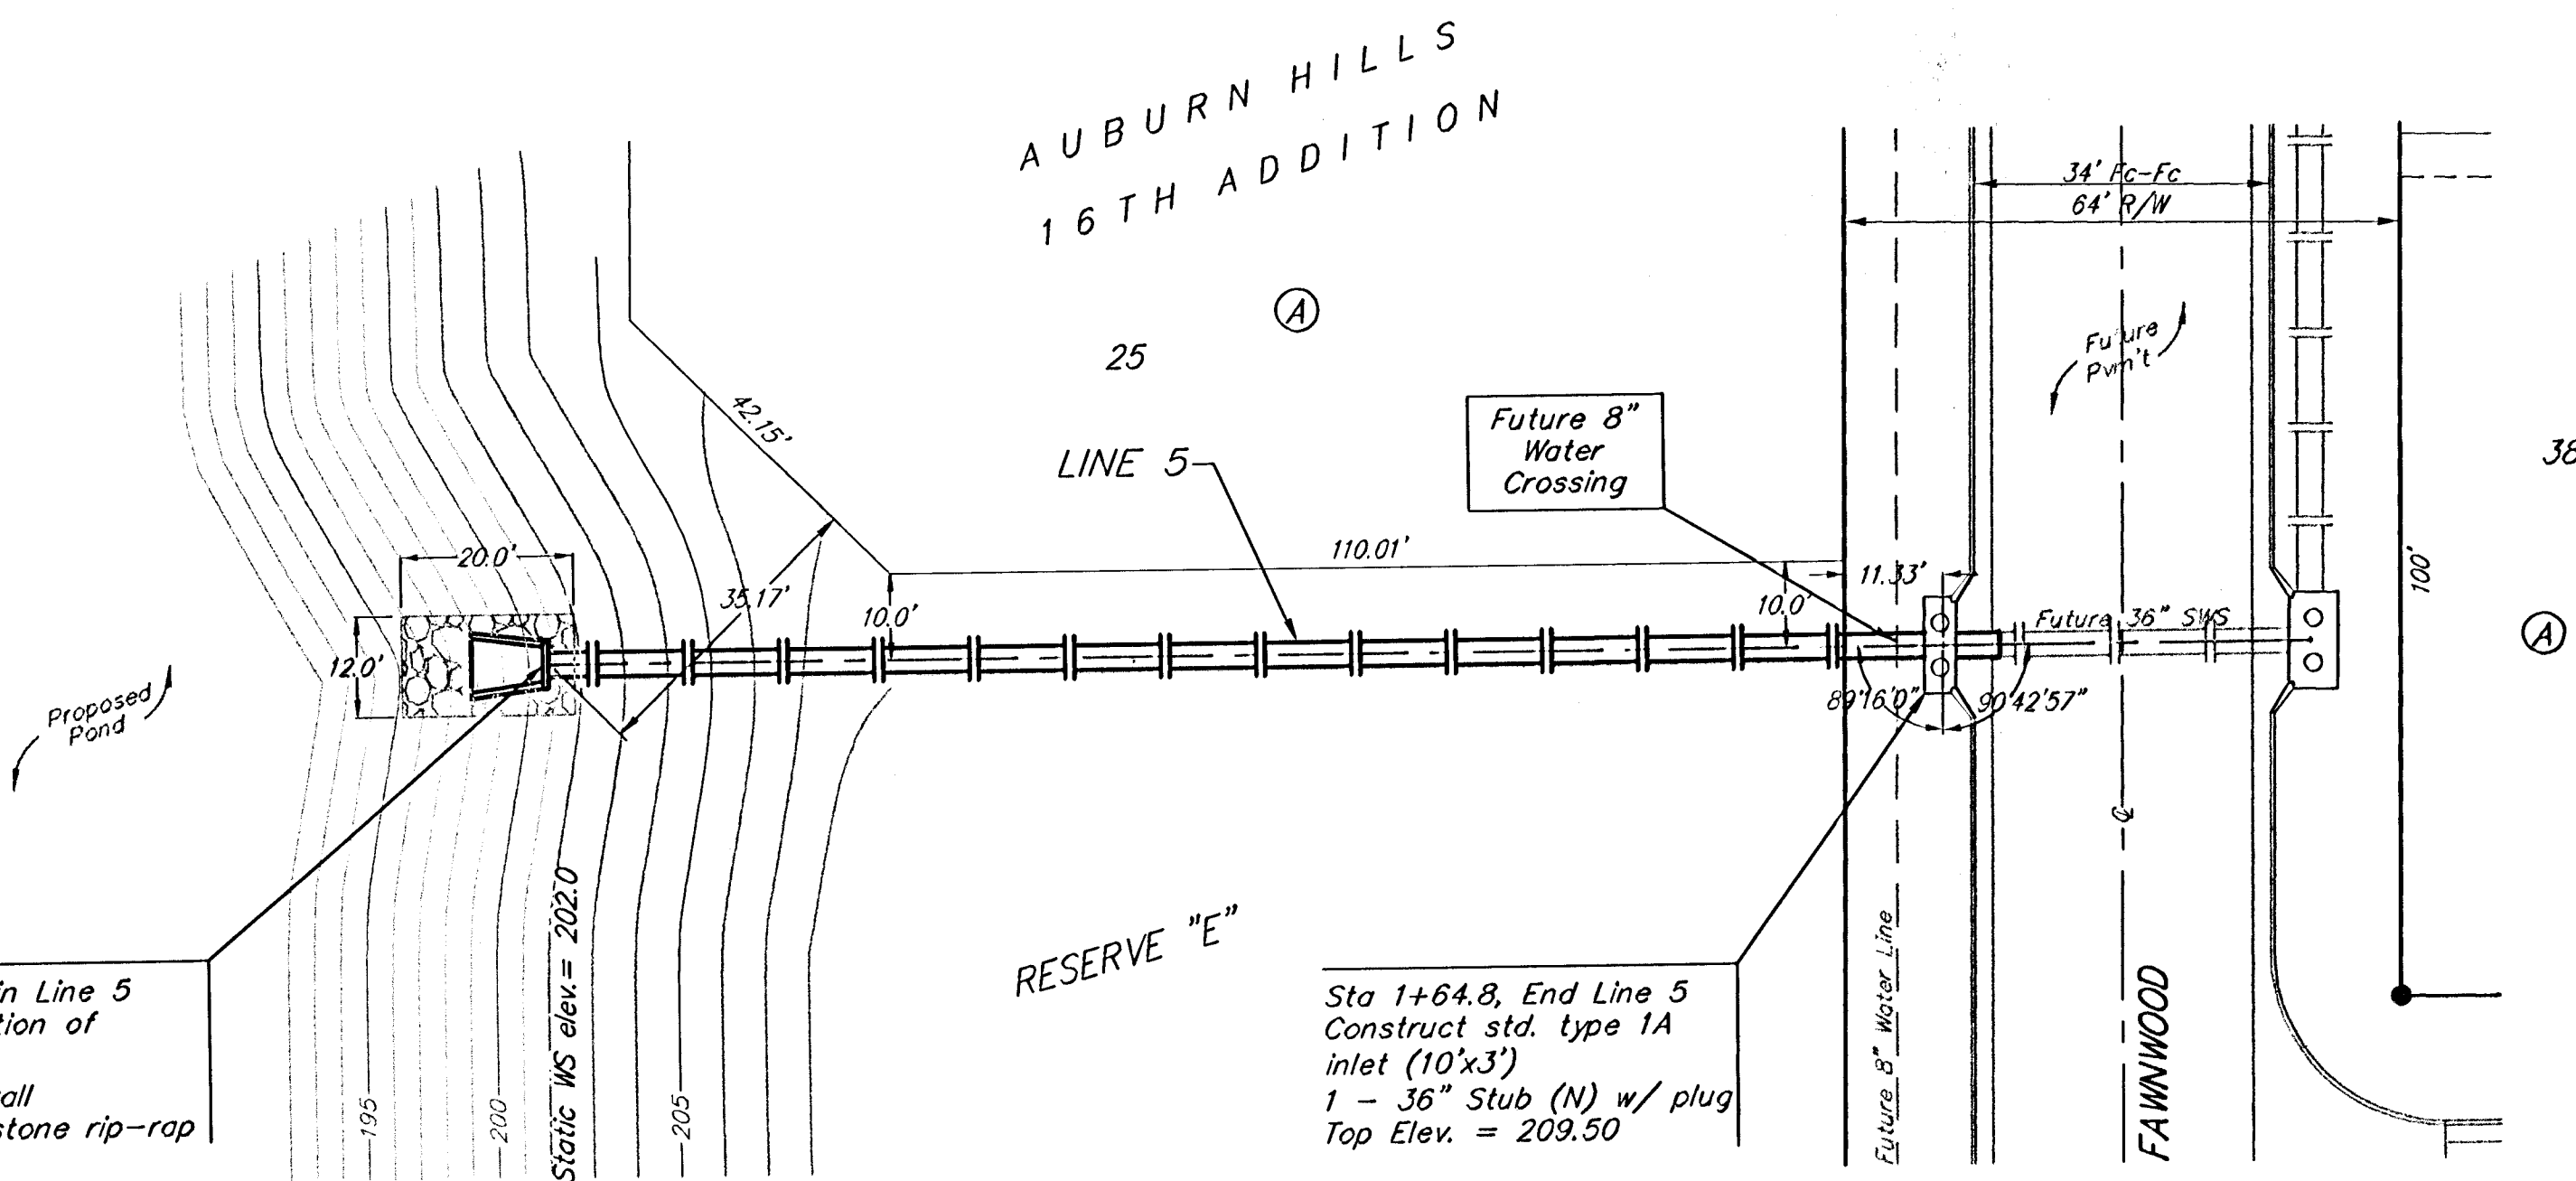

Scale: 1" = 20' Horizontal
 1" = 5' Vertical
 • = Iron

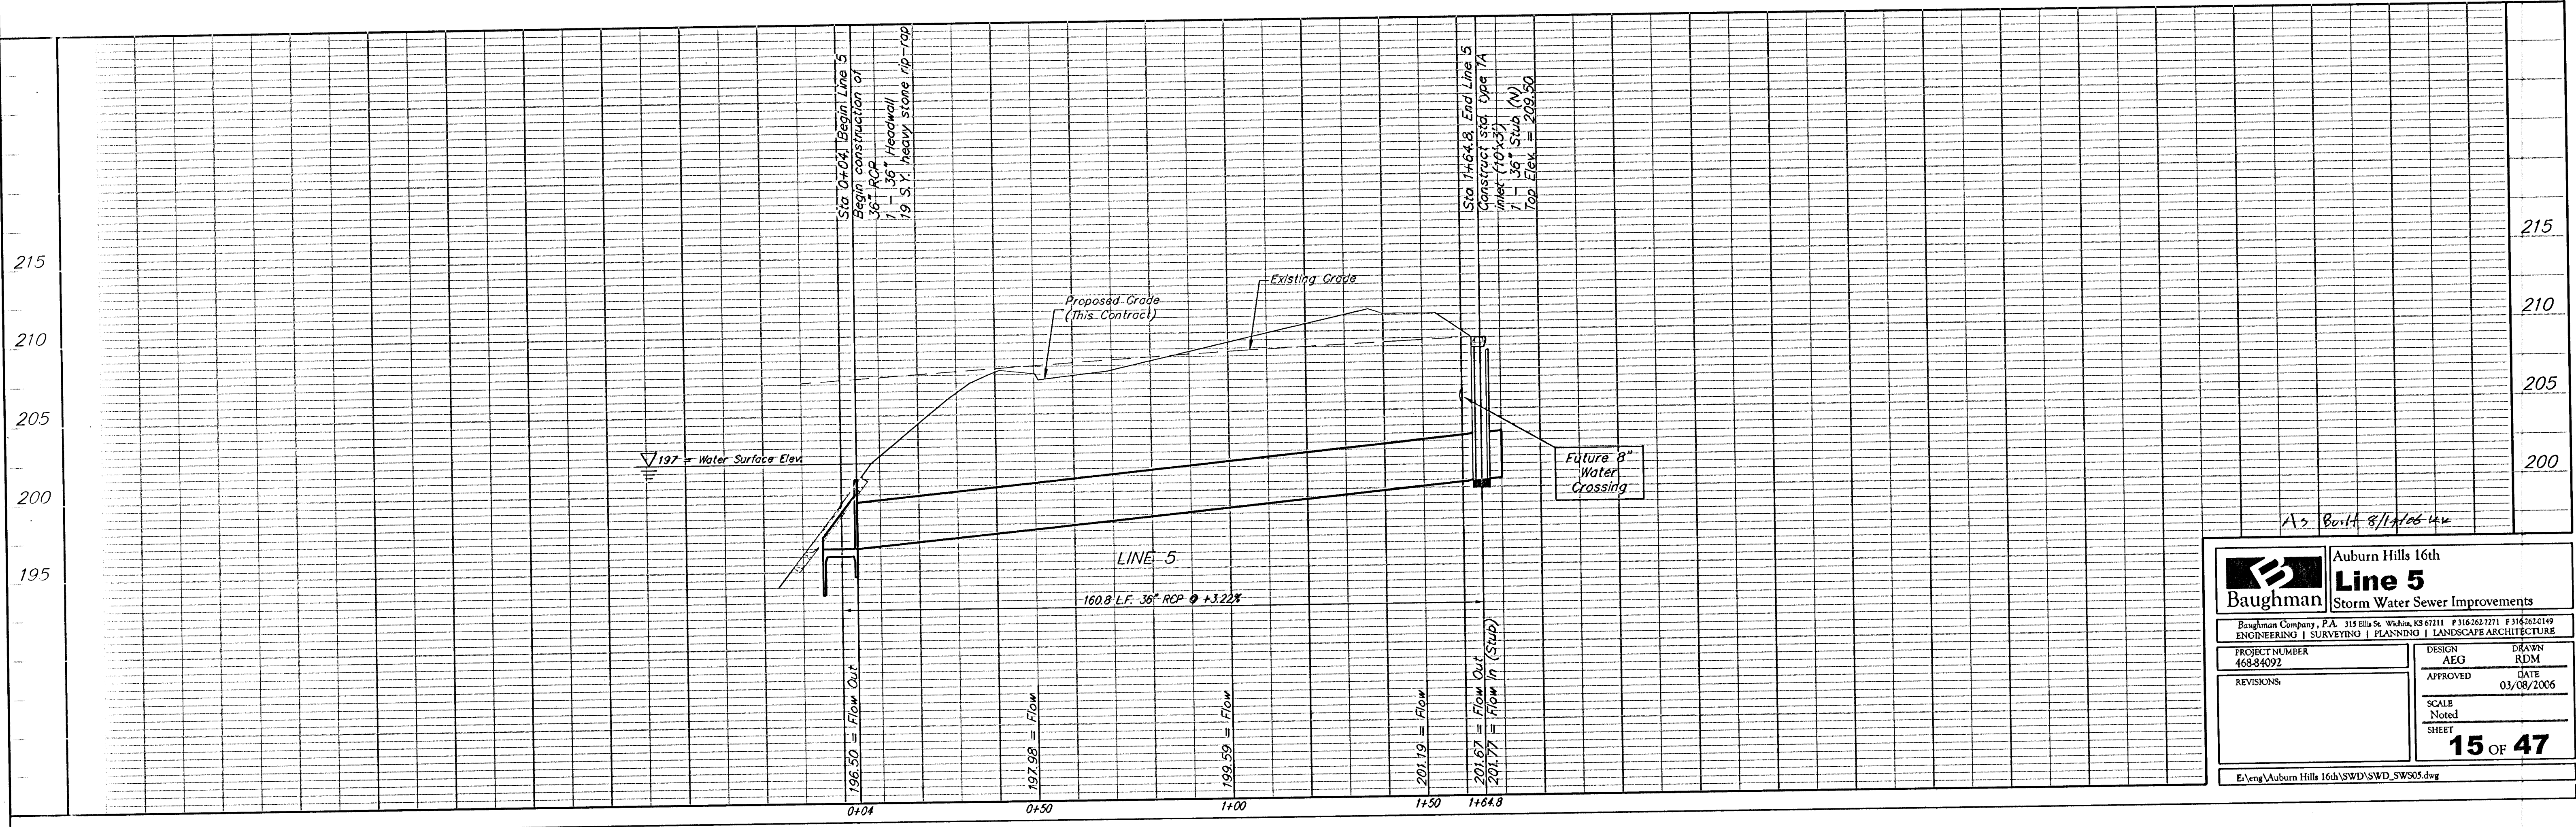

As Built 8/1/06 Use

		Auburn Hills 16th Line 5 Storm Water Sewer Improvements	
<small>Baughman Company, P.A. 315 Ellis St. Woburn, MA 01897 P 316-262-7771 F 316-262-0149 ENGINEERING SURVEYING PLANNING LANDSCAPE ARCHITECTURE</small>			
PROJECT NUMBER 468-84092	DESIGN AEG	DRAWN RDM	DATE 03/08/2006
REVISIONS:	APPROVED	SCALE Noted	SHEET
			15 OF 47
<small>E:\eng\Auburn Hills 16th\SWD\SWD_SW505.dwg</small>			