

BENCHMARK:  
 "□" CUT ON TOP OF CURB  
 AT WEST LINE OF LOT 7,  
 BLOCK A, AUBURN HILLS 5TH  
 ADD.  
 ELEV. = 1395.13 NGVD29


DISC IN BACK OF CURB,  
 NORTH OF FRONT CORNER  
 COMMON TO LOTS 23 AND 24,  
 BLOCK D, AUBURN HILLS 12TH  
 ADD.  
 ELEV. = 1379.24 NGVD29

"□" CUT ON CENTER OF  
 CATCH BASIN, NORTH OF LOT  
 CORNER COMMON TO LOTS 1  
 AND 15, BLOCK B, AUBURN  
 HILLS 14TH ADD.  
 ELEV. = 1381.05 NGVD29


Sta 0+44.2, Line 8  
 Construct std. manhole  
 (5' dia.)  
 1 - 24" Stub (S) w/ plug  
 Top Elev. = 197.50

Sta 0+00, Begin Line 8  
 Begin construction of 30" RCP  
 1 - 30" RC headwall  
 17.5 S.Y. heavy stone rip-rop

Pond #2 Data:  
 Static WS elev. = 191.0  
 100-yr WS elev. = 193.0

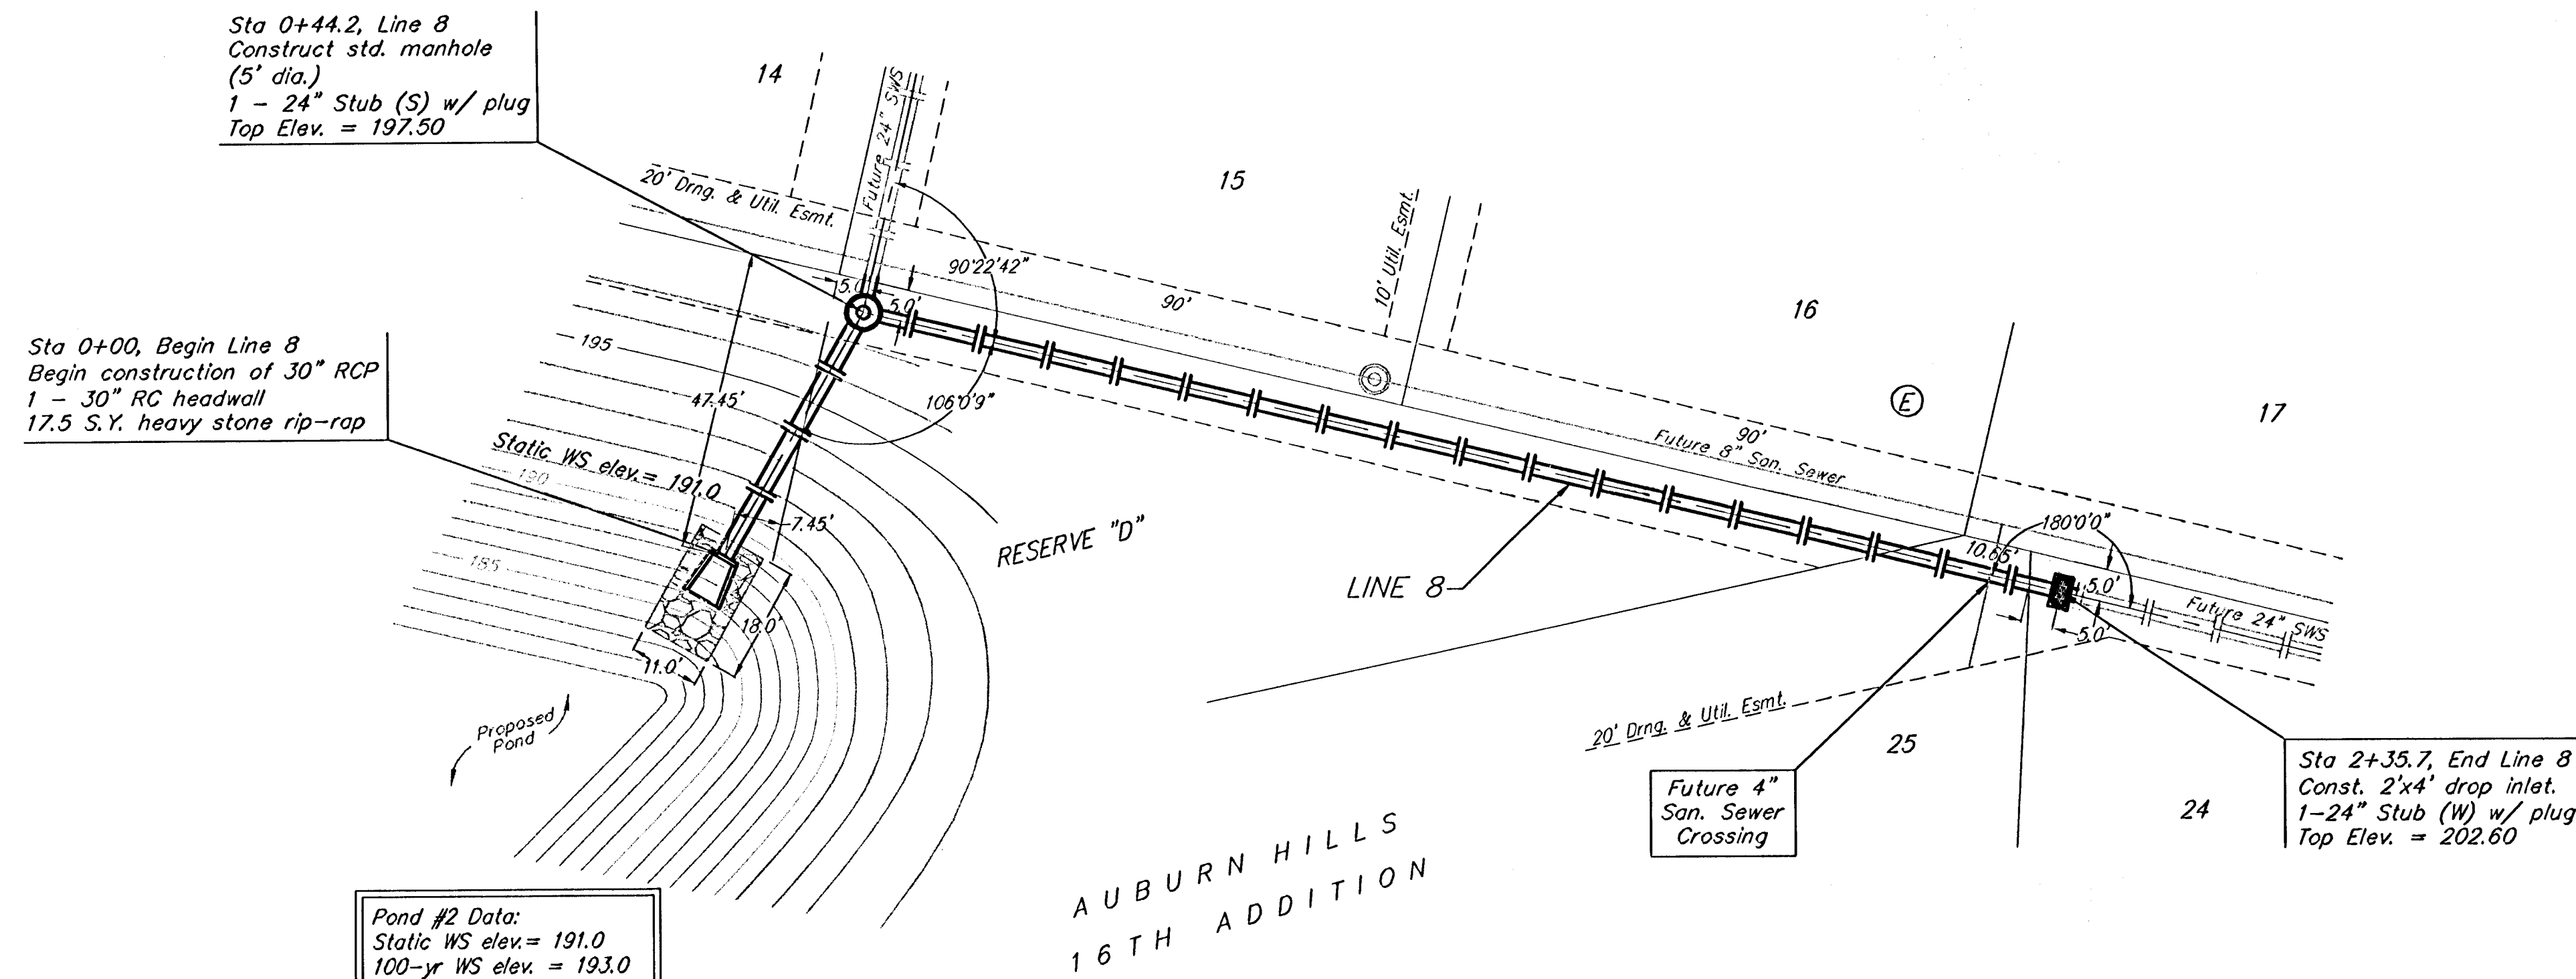

Scale: 1" = 20' Horizontal  
 1" = 5' Vertical  
 • = Iron

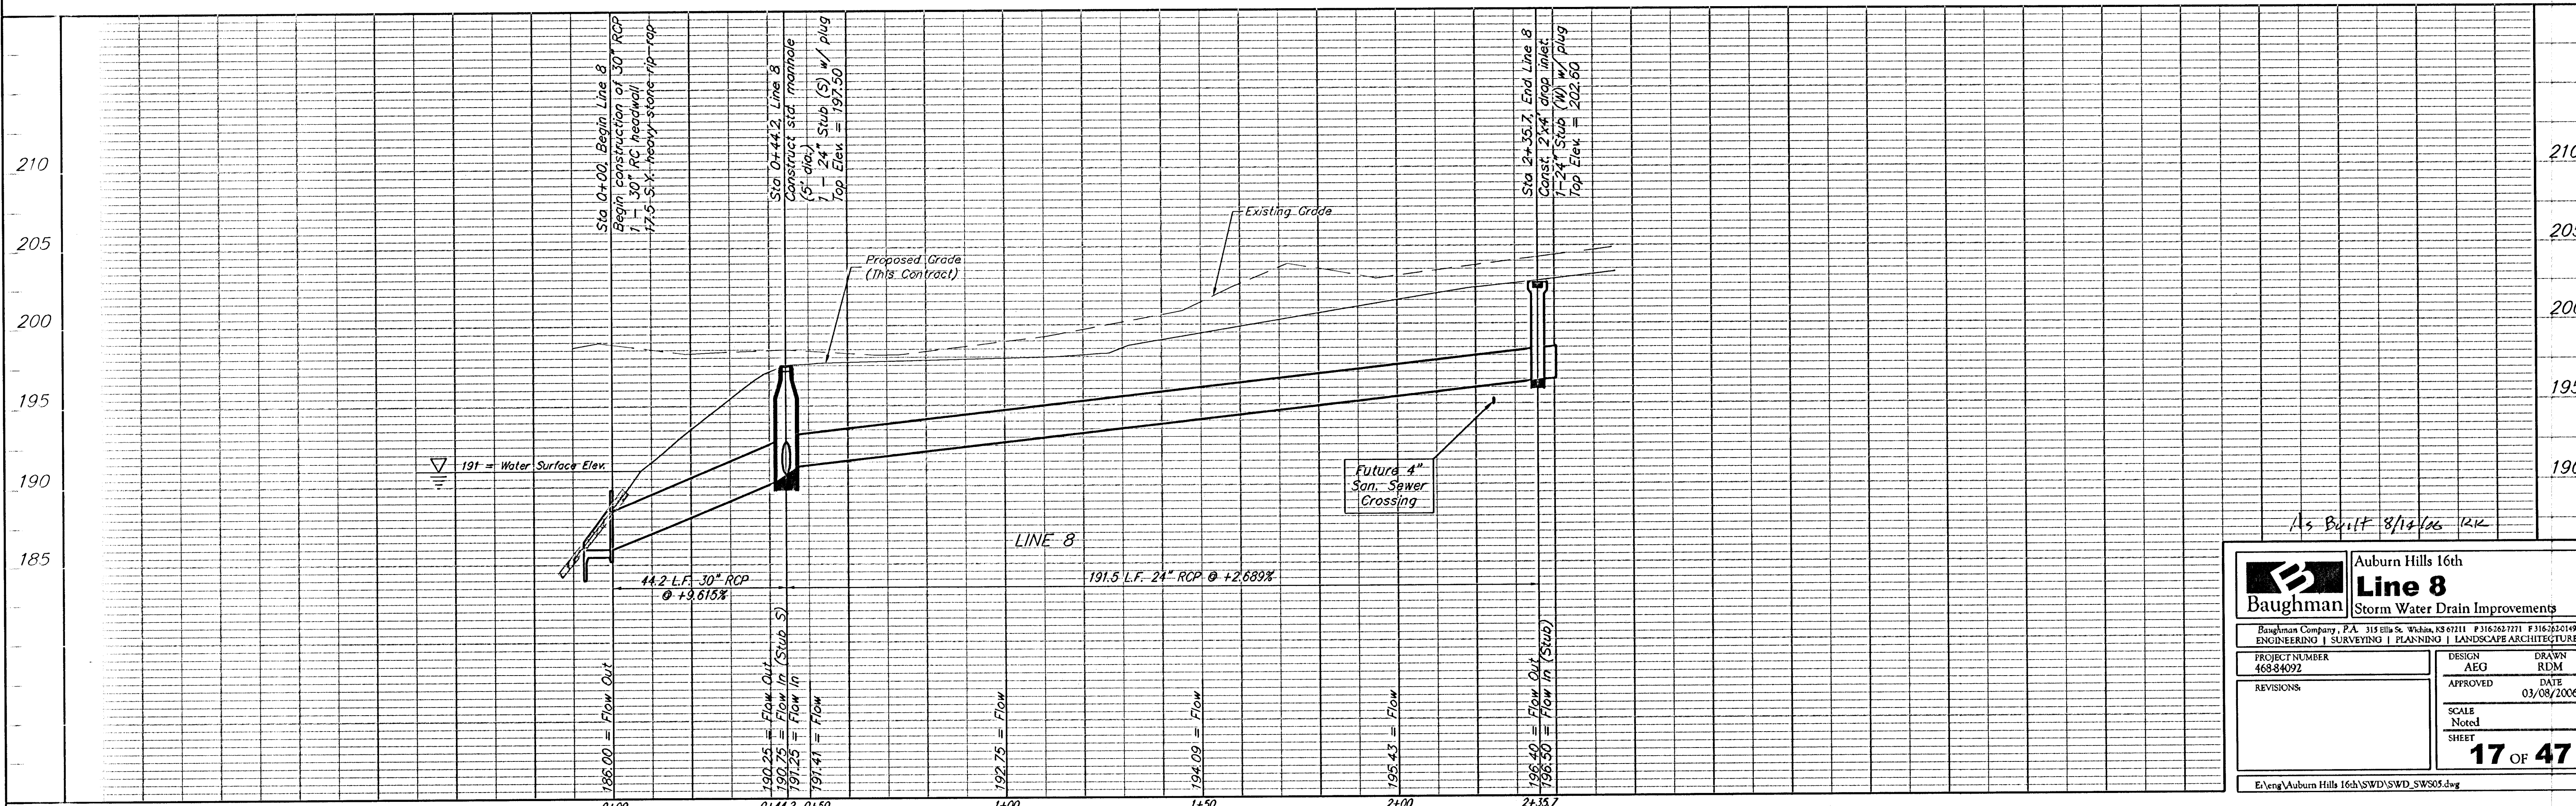

As Built 8/15/06 RJK

<b>Baughman</b>		Auburn Hills 16th	
		<b>Line 8</b>	
		Storm Water Drain Improvements	
Baughman Company, P.A. 315 Ellis St. Wexford, PA 15090-0711 F316262019			
ENGINEERING   SURVEYING   PLANNING   LANDSCAPE ARCHITECTURE			
PROJECT NUMBER 468-84092	DESIGN AEG	DRAWN RDM	
REVISIONS	APPROVED	DATE 03/08/2006	
	SCALE Noted	SHEET <b>17 OF 47</b>	
E:\eng\Auburn Hills 16th\SWD\SWD_SWS05.dwg			