

# SANITARY SEWER EXTENSION LATERAL 1, Main 22, FOUR MILE CREEK SEWER BRENTWOOD SOUTH PHASE 4

PROJECT NO. 468-84263  
OCA # 744205

## BENCH MARK

BENCHMARK: USGS BRASS PLUG 28' S. & 520' W.  
OF CENTERLINE INTERSECTION OF CAPRI & PAWNEE.  
ELEV: 1386.25 NGVD

BENCHMARK: CITY OF WICHITA STD. DISC 20.8' W.  
& 54.5' S. OF CENTERLINE INTERSECTION DALTON 7  
PAWNEE.  
ELEV = 1379.60

## GENERAL NOTES

1. Contractor will be required to provide a minimum advance notice of seventy-two (72) hours to utility companies prior to starting any excavation as follows:

Kansas One-Call 687-2470

2. The Contractor must notify the following in case of an emergency:

Cox Communications 262-0661  
Kansas Gas Service 383-8600  
Westar 383-8600  
Aquila 1-800-303-0357  
SBC 1-800-286-8313  
City of Wichita Water Department 262-6000  
City of Wichita Sewer Maintenance 262-6000

3. Underground utility service lines and overhead utility pole lines are to be adjusted as necessary by others prior to construction unless the plans specifically call for their adjustment by the Contractor or unless the plans specifically identify a utility to be adjusted by its owner during construction. Existing utilities and their location, as shown on the plans, represent the best information obtainable for design. Location information has been obtained from the various utility companies and is either from company record drawings or company-provided field locations. The Contractor will be required to work around existing utilities within the right-of-way which do not conflict with proposed construction.


4. Rubble from the removal of miscellaneous structures and excess excavation which is to be wasted shall be disposed of on sites to be provided by the Contractor. These sites shall be approved by the Engineer as to suitability, appearance and site location. Locations that, in the opinion of the Engineer, will leave an unsightly appearance will not be approved.

5. All disposal sites must be approved by the Kansas Department of Health and Environment. Material either stockpiled or disposed of in a flood plain would require a Kansas State Board of Agriculture permit. Any material dumped in waters of the United States or wetlands is subject to U.S. Corps permitting regulations. Any material buried or stockpiled beyond approved of Engineers construction limits would require additional archeological investigations unless buried in a previously approved borrow location.

6. The Contractor shall give all property owners and/or tenants of developed property directly abutting the construction of this project a minimum of ten (10) days advance notice prior to start of construction.

7. The Contractor shall be responsible for preserving property irons. The Contractor will be required to re-establish any property irons which are damaged or destroyed by his construction operations. Such irons shall be re-established by a licensed land surveyor in accordance with state laws.

8. The contractor shall remove and stockpile the topsoil throughout the project construction area prior to installation of the sanitary sewer system. The location of the topsoil stockpile will be at the backside of Lots 6 and 7, Block 1. Topsoil will be removed and stockpiled from all areas that will be disturbed by construction. Cost of this work shall be incidental to the bid item for "Site Clearing and Restoration".

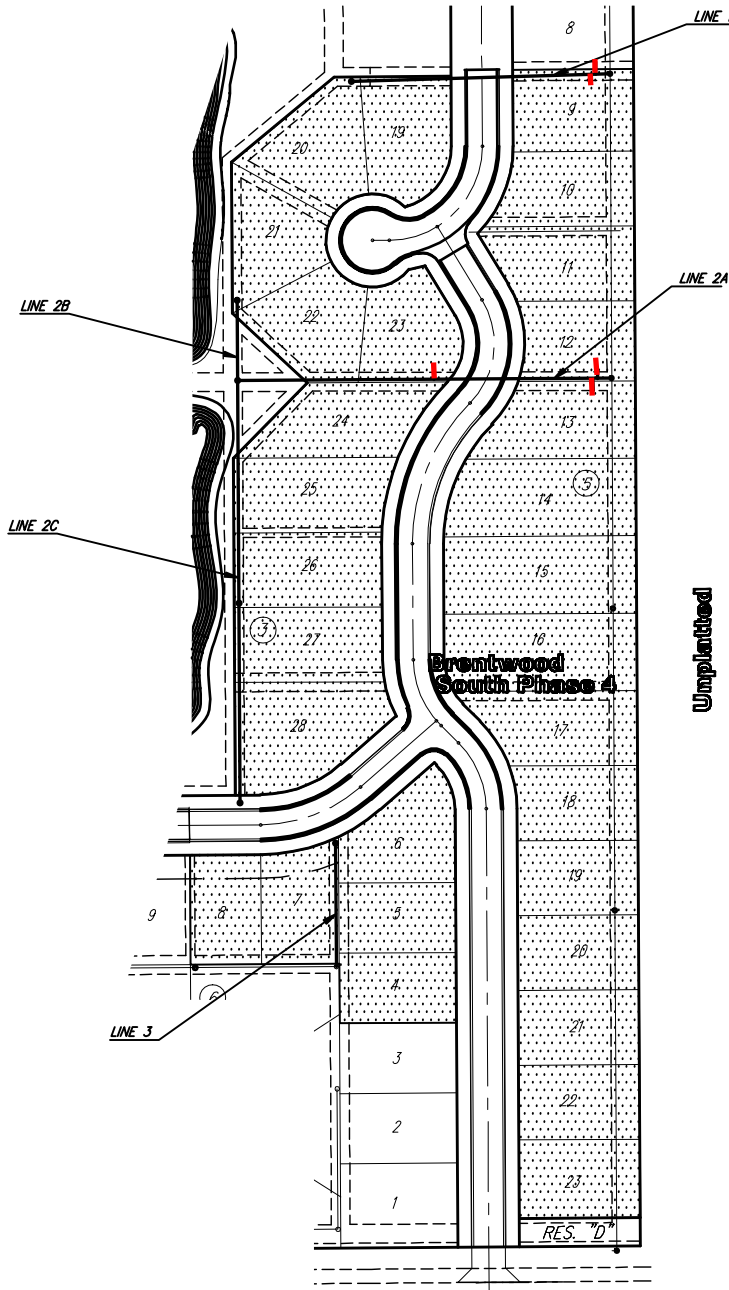


## INDEX OF SHEETS

1. TITLE SHEET
- 2-3. SANITARY SEWER PLAN/PROFILE
4. TYPE 'P' MANHOLE DETAIL
5. MANHOLE RING & COVER DETAIL
6. RISER DETAILS
7. EROSION CONTROL PLAN/ EASEMENT GRADING
- 8-12. EROSION BMP'S
13. KEY MAP
14. FINAL PLAT



Scale: 1" = 100'

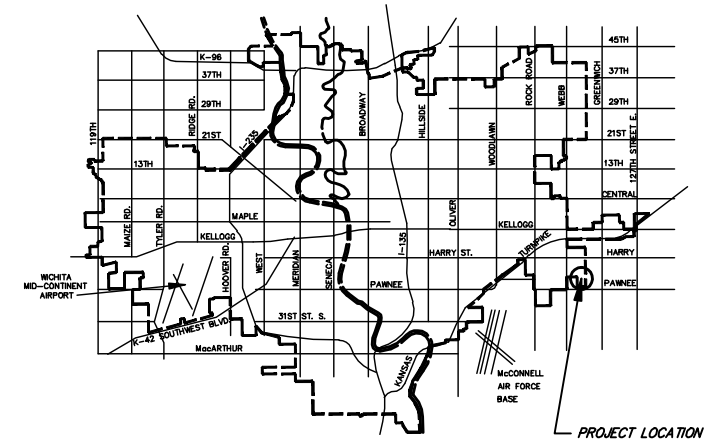

VICINITY MAP

Mies Construction, Inc. - Contractor  
Yale, City - Inspector  
Released 8/10/07  
As-Built  
Risers  
.pdf by JDL 9/10/07



**IMPROVEMENT DISTRICT**  
**CITY OF WICHITA, KANSAS**

**JAMES L. ARMOUR, P.E. - CITY ENGINEER**



**BENEFIT DISTRICT**



**Ruggles & Bohm, P.A.**  
Engineering, Surveying, Land Planning  
924 North Main (316) 264-8008  
Wichita, Kansas 67203 (316) 264-4621 fax  
www.rbkansas.com E-mail: info@rbkansas.com